



12+75

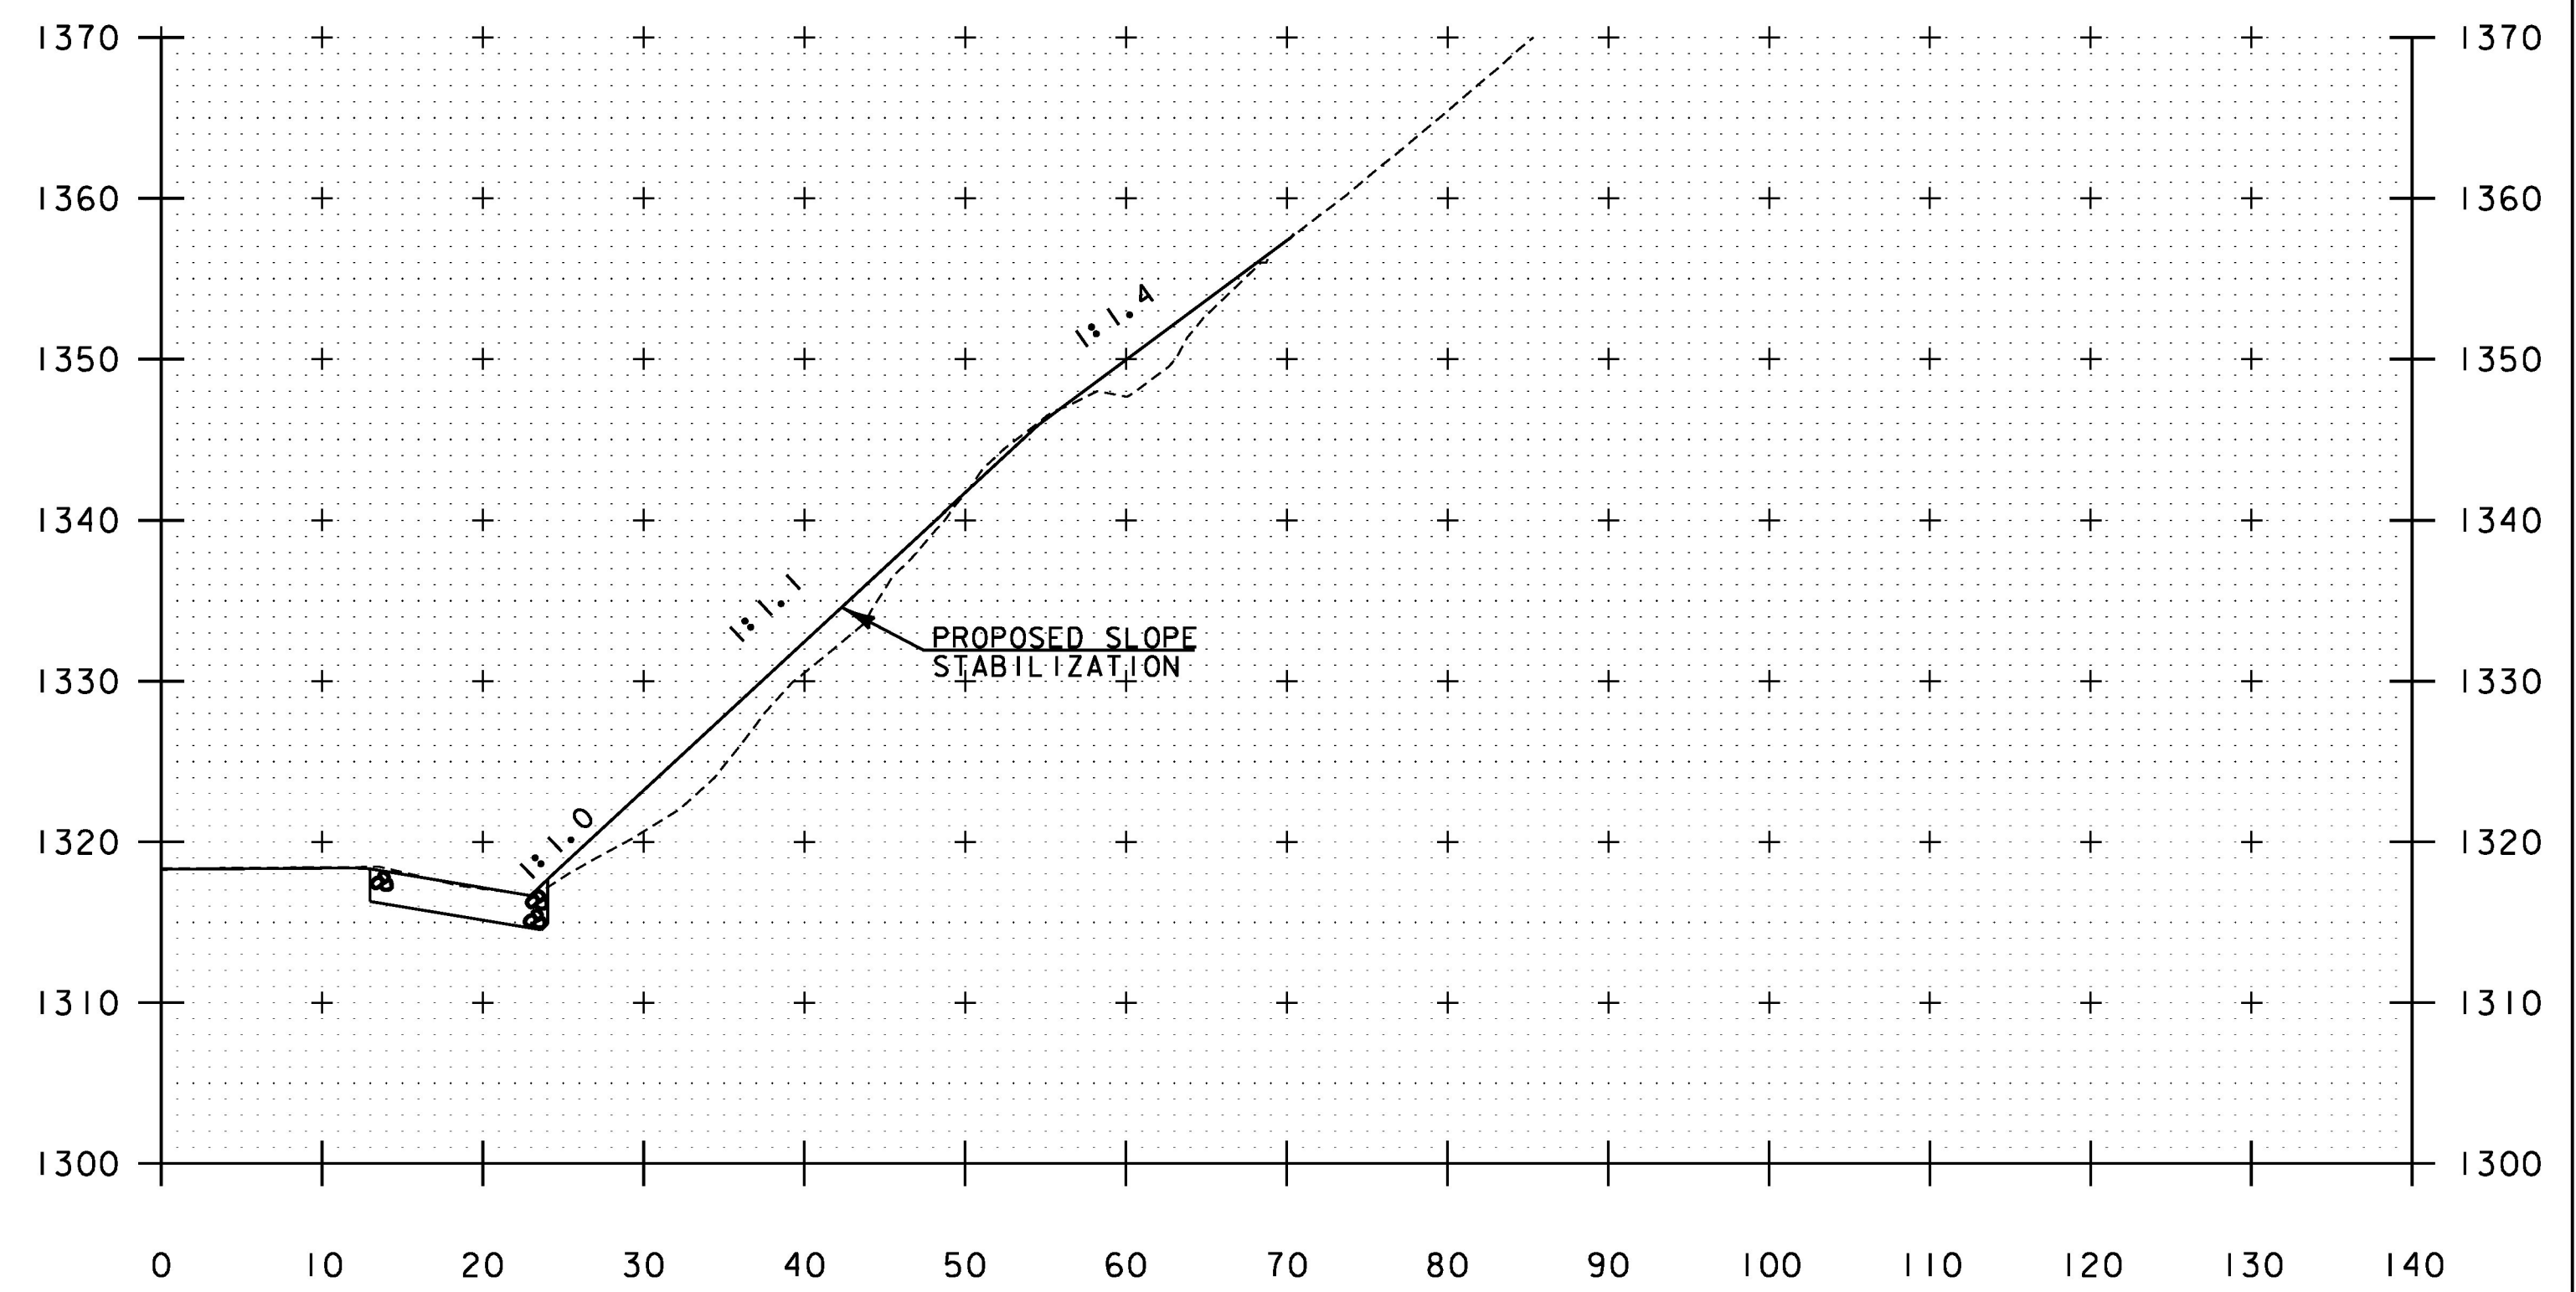

12+50

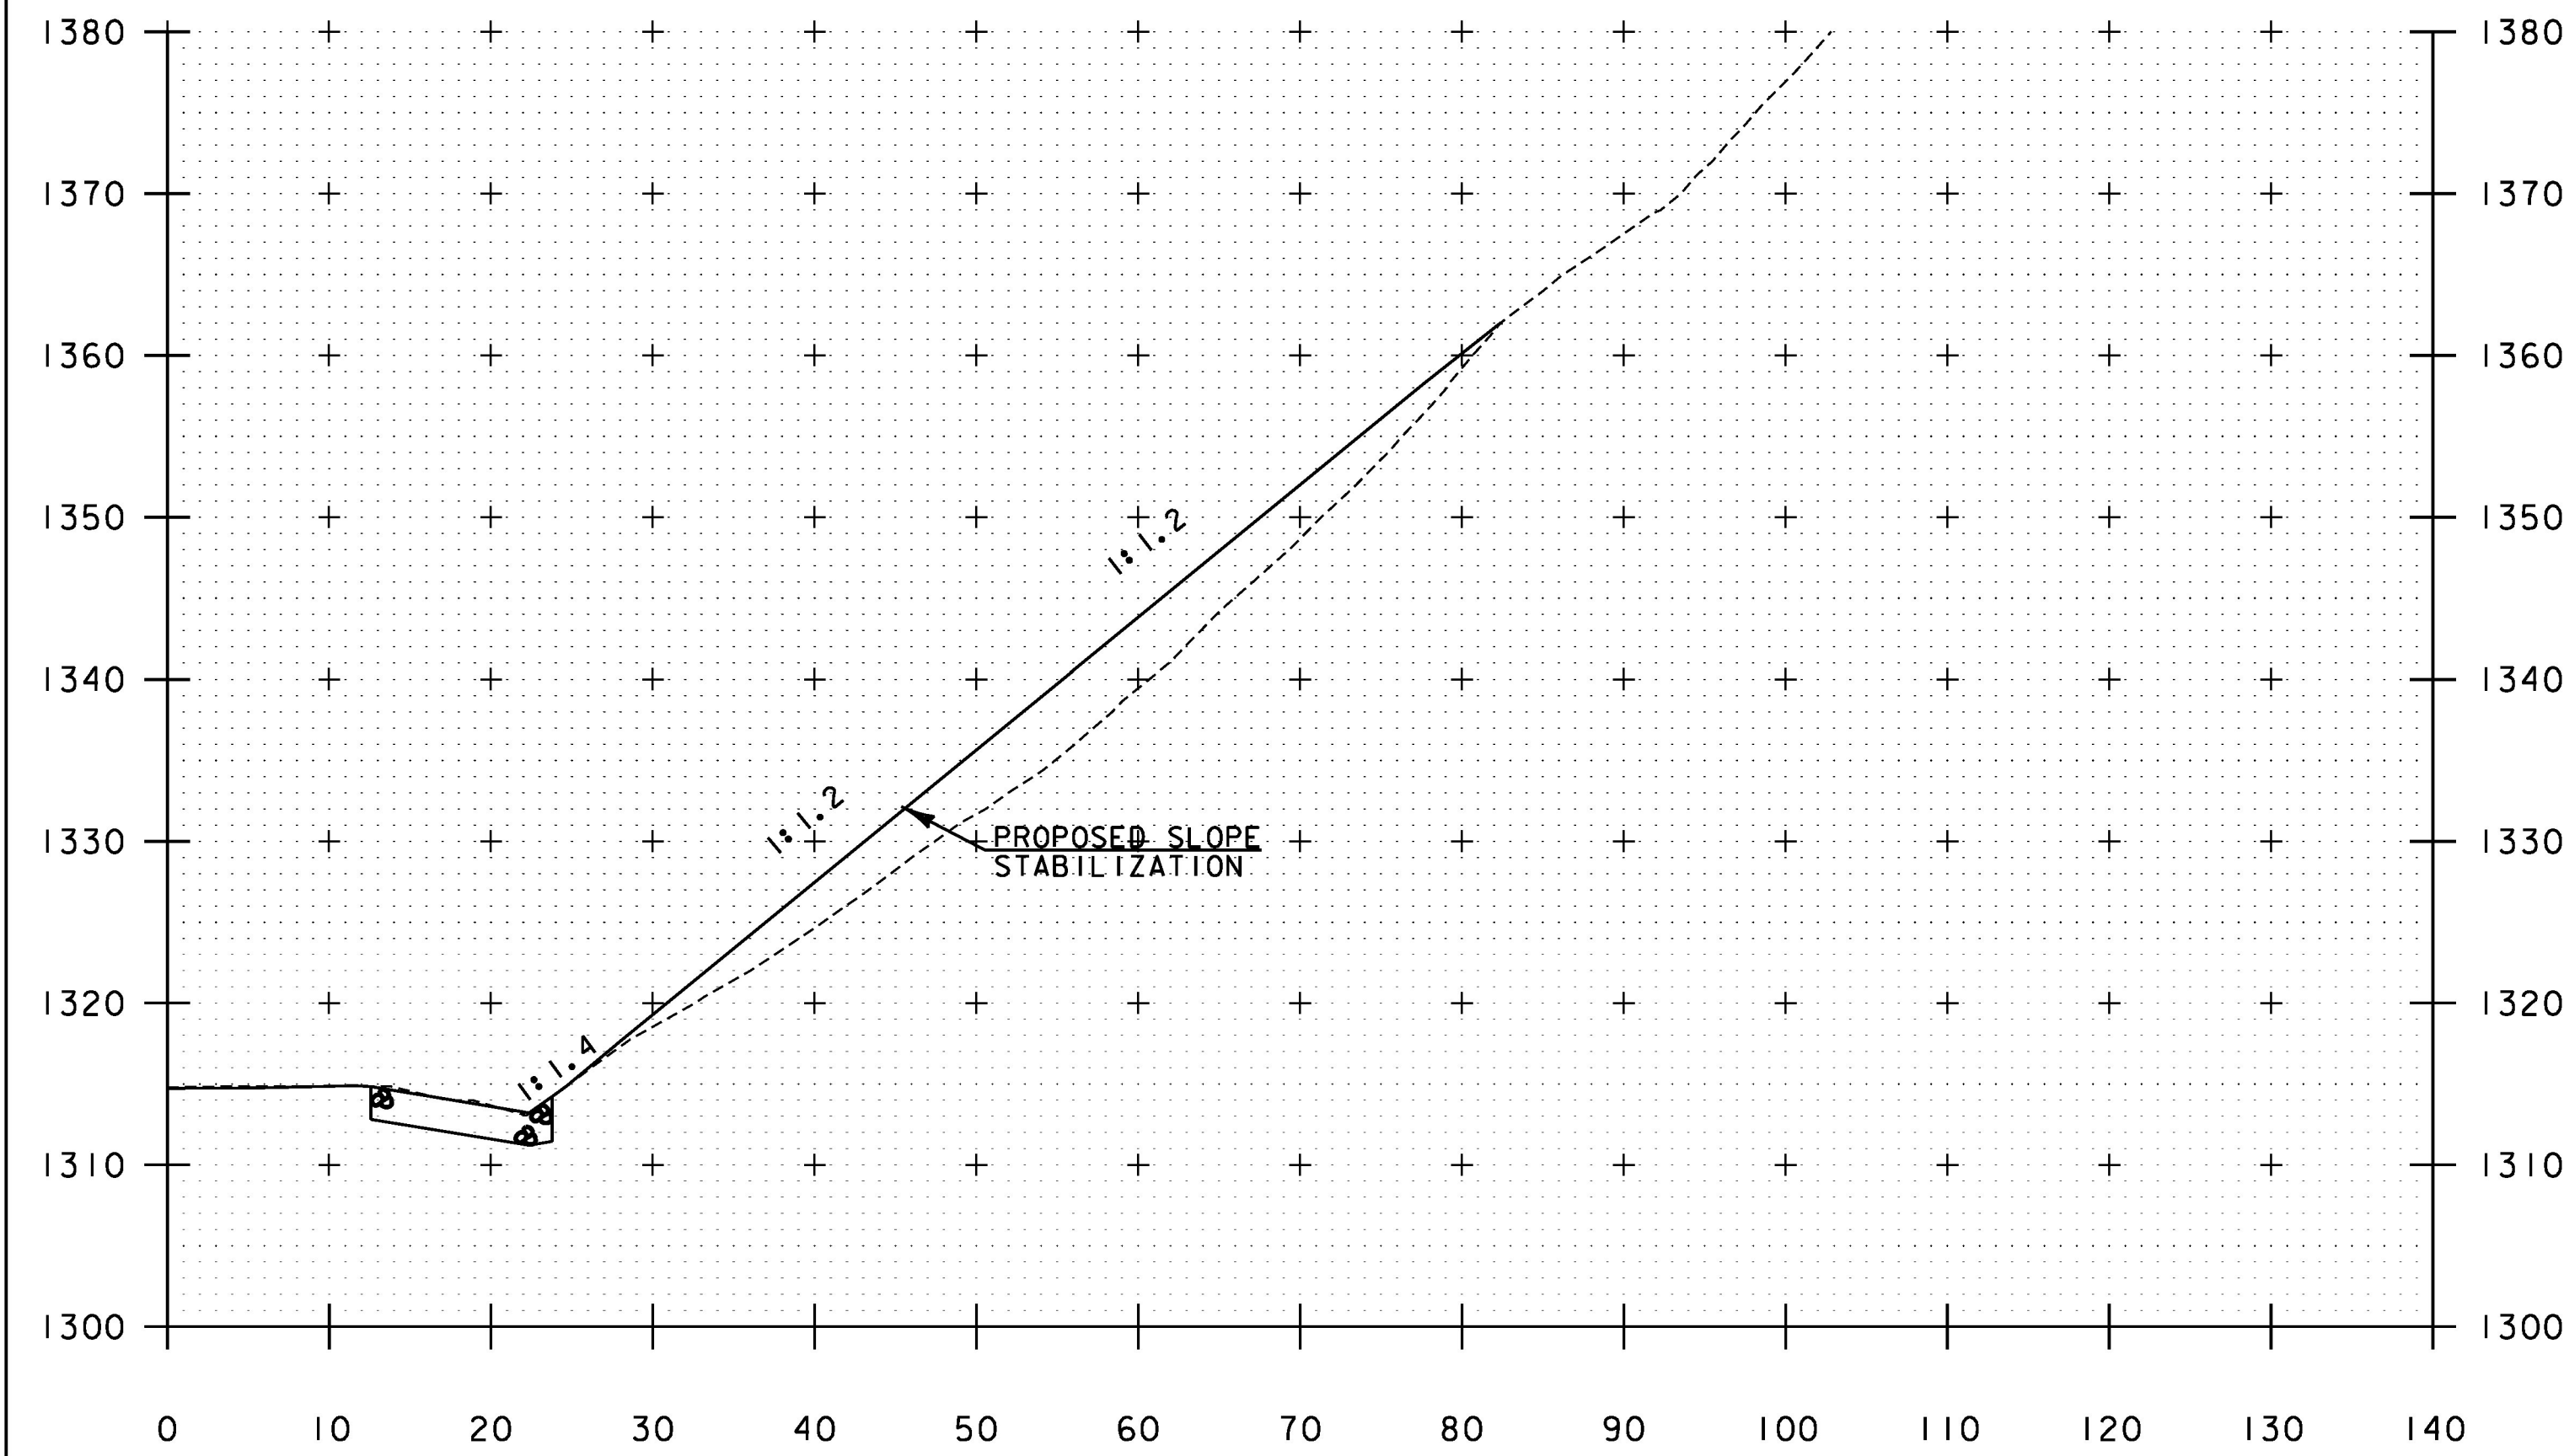

12+25

SCALE IN FEET



PROJECT NAME: PLYMOUTH	PLOT DATE: 5/17/2016
PROJECT NUMBER: ER 0149(6)	DRAWN BY: M. LOVETT
FILE NAME: z13c318xsl.dgn	CHECKED BY: B. COLBURN
PROJECT LEADER: J. SANTACRUCE	SHEET 66 OF 68
DESIGNED BY: M. HASKINS	
SLOPE STABILITY CROSS SECTIONS 5	