

RECORD PLANS

CONTRACTOR: PIKE INDUSTRIES, INC. - BERLIN, VT
 RESIDENT ENGINEER: RYAN DARLING
 CONSTRUCTION BEGAN: JULY 29, 2015
 CONSTRUCTION COMPLETE: AUGUST 3, 2016
 RECORD PLANS BY: RYAN DARLING & KEVIN KING

I HEREBY CERTIFY THAT ALL THE CONSTRUCTION REQUIRED BY THIS SET OF DRAWINGS HAS BEEN ACCOMPLISHED AS INDICATED HEREIN.


BY *[Signature]* RESIDENT ENGINEER
 DATE 7/10/2017

NOTE: Any further information concerning final quantities, amounts or other details relative to this project may be found by contacting Vtrans Records Management.

STATE OF VERMONT
 AGENCY OF TRANSPORTATION



PROPOSED IMPROVEMENT
 TOWNS OF CHESTER, SPRINGFIELD, ROCKINGHAM, AND WINDSOR
 CLASS I TOWN HIGHWAYS
 COUNTIES OF WINDHAM AND WINDSOR
 U.S. ROUTE 5 & VT ROUTE 44 (MAJOR COLLECTORS), VT ROUTE 11
 (MINOR ARTERIAL), & VT ROUTE 103 (PRINCIPAL ARTERIAL-NHS)

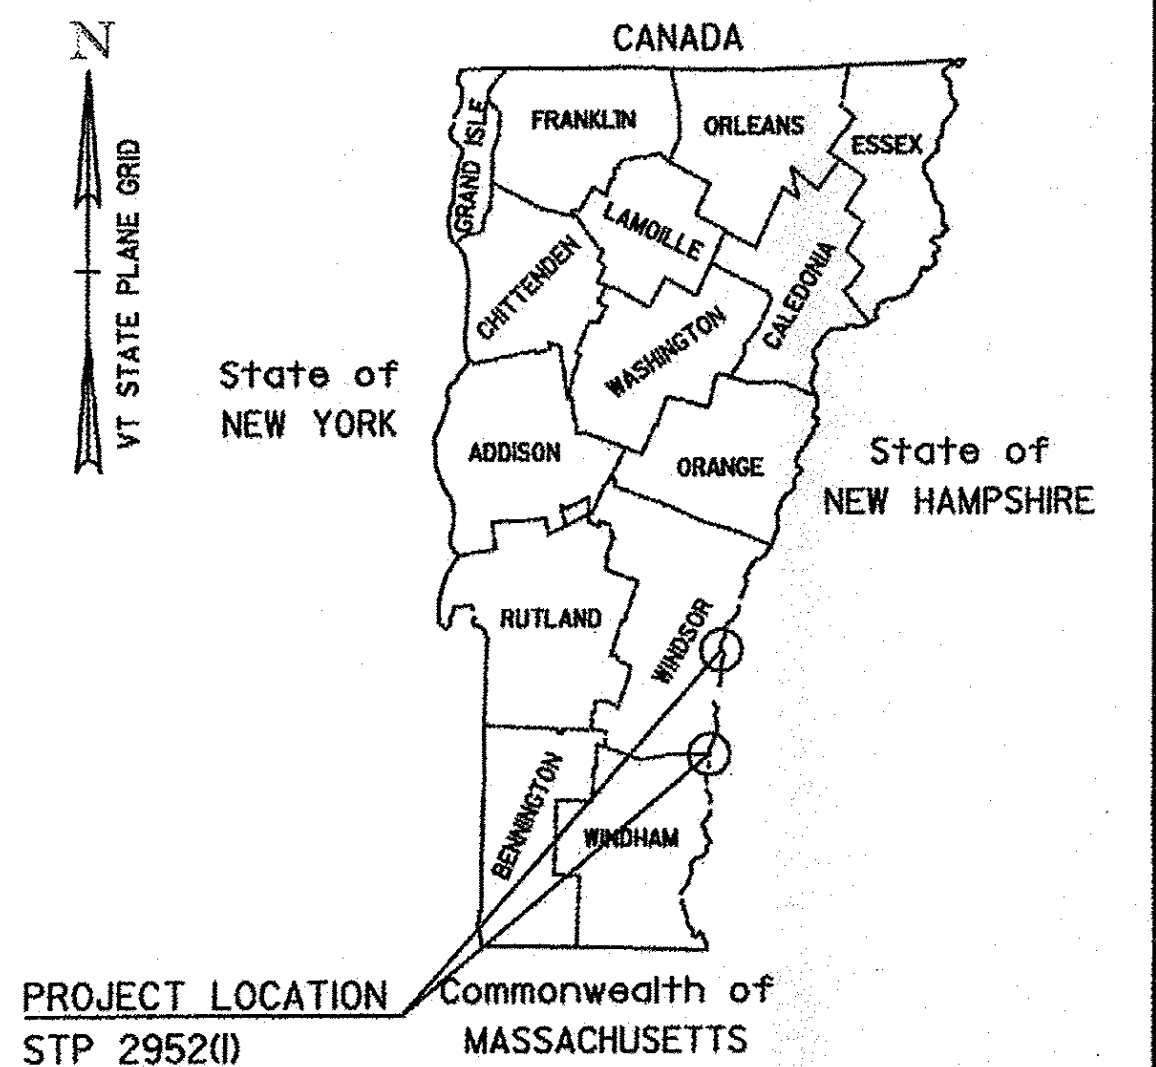

BEGINNING AT A POINT IN THE TOWN OF CHESTER ON VT ROUTE 11 AT MILE MARKER 4.369 = STA C 230+68.32 AND EXTENDING EASTERLY FOR A DISTANCE OF APPROXIMATELY 4,488.00 FEET (0.850 MILE) AND STOPPING AT A POINT IN THE TOWN OF CHESTER AT MILE MARKER 5.219 = STA C 275+56.32.
 LENGTH OF ROADWAY = 4,488.00 FT (0.850 MILE)
 LENGTH OF PROJECT = 4,488.00 FT (0.850 MILE)

ALSO, BEGINNING AT A POINT IN THE TOWN OF CHESTER ON VT ROUTE 103 AT MILE MARKER 2.603 = STA C 137+43.84 AND EXTENDING NORTHERLY FOR A DISTANCE OF APPROXIMATELY 8,796.48 FEET (1.666 MILES) AND STOPPING AT A POINT IN THE TOWN OF CHESTER AT MILE MARKER 4.269 = STA C 225+40.32.
 LENGTH OF ROADWAY = 8,796.48 FT (1.666 MILES)
 LENGTH OF PROJECT = 8,796.48 FT (1.666 MILES)

ALSO, BEGINNING AT A POINT IN THE TOWN OF CHESTER ON DEPOT STREET (NON-PARTICIPATING) AT STA D 0+00.00 AND EXTENDING NORTHERLY FOR A DISTANCE OF APPROXIMATELY 1,067.00 FEET (0.202 MILE) AND STOPPING AT A POINT IN THE TOWN OF CHESTER AT STA D 10+67.00.
 LENGTH OF ROADWAY = 1,067.00 FT (0.202 MILE)
 LENGTH OF PROJECT = 1,067.00 FT (0.202 MILE)





ALSO, BEGINNING AT A POINT IN THE TOWN OF SPRINGFIELD ON VT ROUTE 11 AT MILE MARKER 3.528 = STA S 186+27.84 AND EXTENDING EASTERLY FOR A DISTANCE OF APPROXIMATELY 15,000.48 FEET (2.841 MILES) AND STOPPING AT A POINT IN THE TOWN OF SPRINGFIELD AT MILE MARKER 6.369 = STA S 336+28.32.
 LENGTH OF ROADWAY = 15,000.48 FT (2.841 MILES)
 LENGTH OF PROJECT = 15,000.48 FT (2.841 MILES)

ALSO, BEGINNING AT A POINT IN THE TOWN OF ROCKINGHAM ON U.S. ROUTE 5 AT MILE MARKER 0.000 = STA R 0+00.00 AND EXTENDING NORTHERLY FOR A DISTANCE OF APPROXIMATELY 7,909.44 FEET (1.498 MILES) AND STOPPING AT A POINT IN THE TOWN OF ROCKINGHAM AT MILE MARKER 1.498 = STA R 79+09.44.
 LENGTH OF ROADWAY = 7,909.44 FT (1.498 MILES)
 LENGTH OF PROJECT = 7,909.44 FT (1.498 MILES)

ALSO, BEGINNING AT A POINT IN THE TOWN OF WINDSOR ON U.S. ROUTE 5 AT MILE MARKER 3.239 = STA W 171+01.92 AND EXTENDING NORTHERLY FOR A DISTANCE OF APPROXIMATELY 4,319.04 FEET (0.818 MILE) AND STOPPING AT A POINT IN THE TOWN OF WINDSOR AT MILE MARKER 4.057 = STA W 214+20.96.
 LENGTH OF ROADWAY = 4,319.04 FT (0.818 MILE)
 LENGTH OF PROJECT = 4,319.04 FT (0.818 MILE)

ALSO, BEGINNING AT A POINT IN THE TOWN OF WINDSOR ON VT ROUTE 44 AT MILE MARKER 1.588 = STA W 83+84.64 AND EXTENDING EASTERLY FOR A DISTANCE OF APPROXIMATELY 17,714.40 FEET (3.355 MILES) AND STOPPING AT A POINT IN THE TOWN OF WINDSOR AT MILE MARKER 4.943 = STA W 260+99.04.
 LENGTH OF ROADWAY = 17,714.40 FT (3.355 MILES)
 LENGTH OF PROJECT = 17,714.40 FT (3.355 MILES)
 TOTAL LENGTH OF PROJECT = 59,294.84 FT (11.230 MILES)


WORK TO BE PERFORMED UNDER THIS PROJECT INCLUDES COLD PLANING THE EXISTING HIGHWAY AND RESURFACING WITH A LEVELING COURSE AND A WEARING COURSE, WITH NEW PAVEMENT MARKINGS, GUARDRAIL, SIGNS, SIDEWALK RAMPS, DRAINAGE IMPROVEMENTS, VEHICLE STOP BAR DETECTION SYSTEMS, RAIL GRADE CROSSING REHABILITATION AND OTHER HIGHWAY RELATED ITEMS.

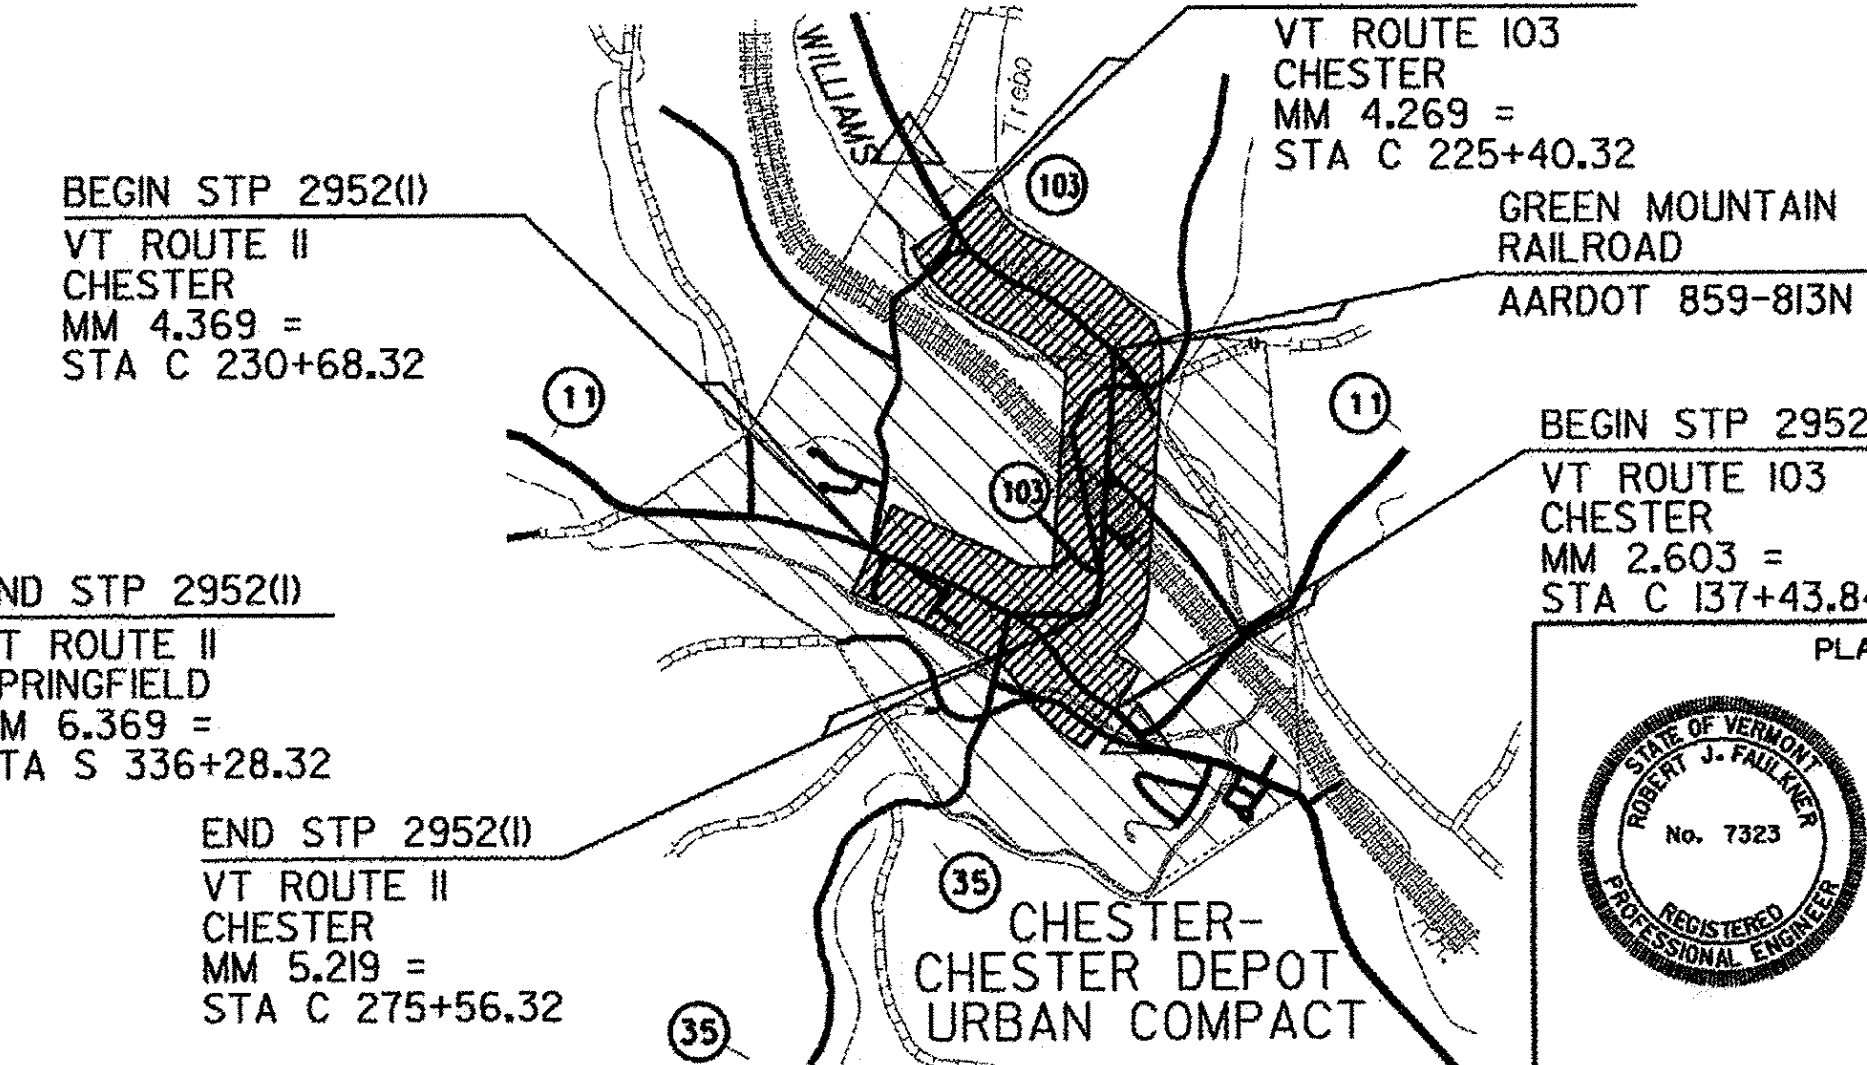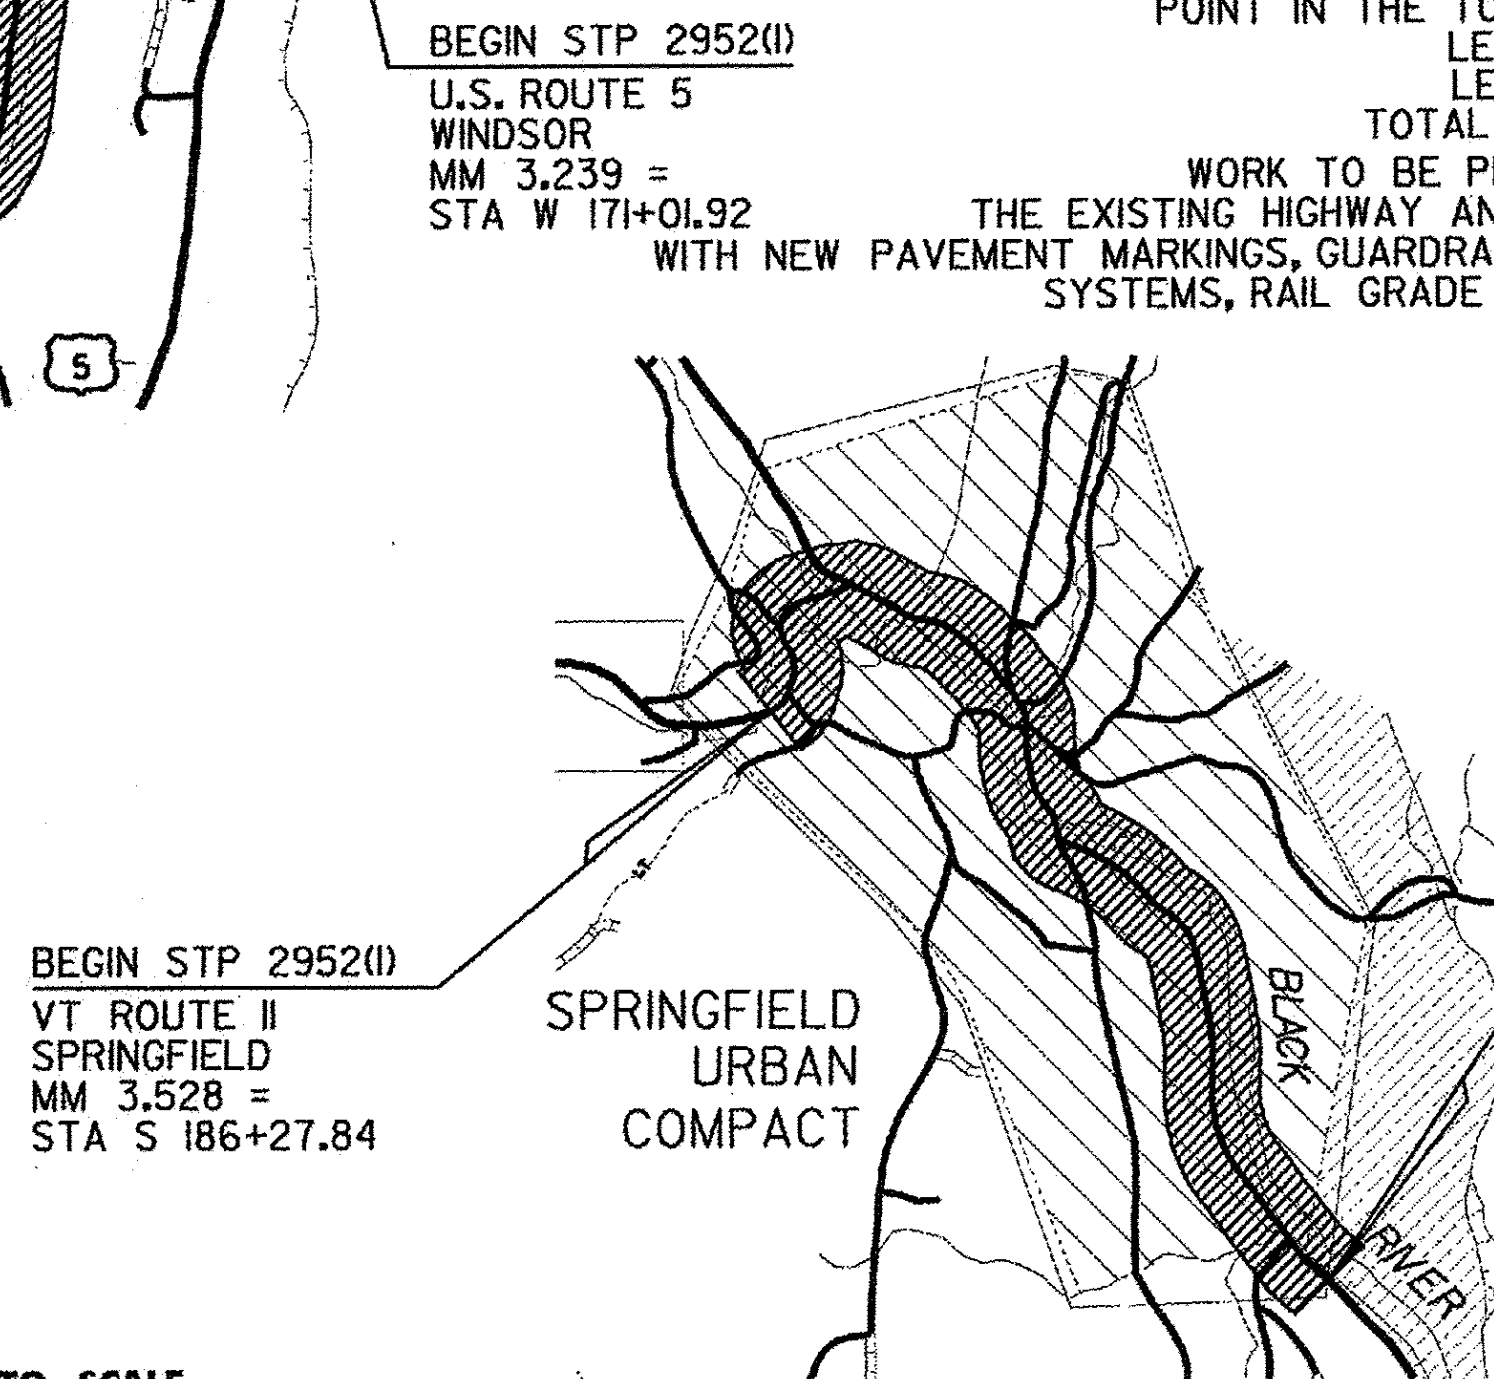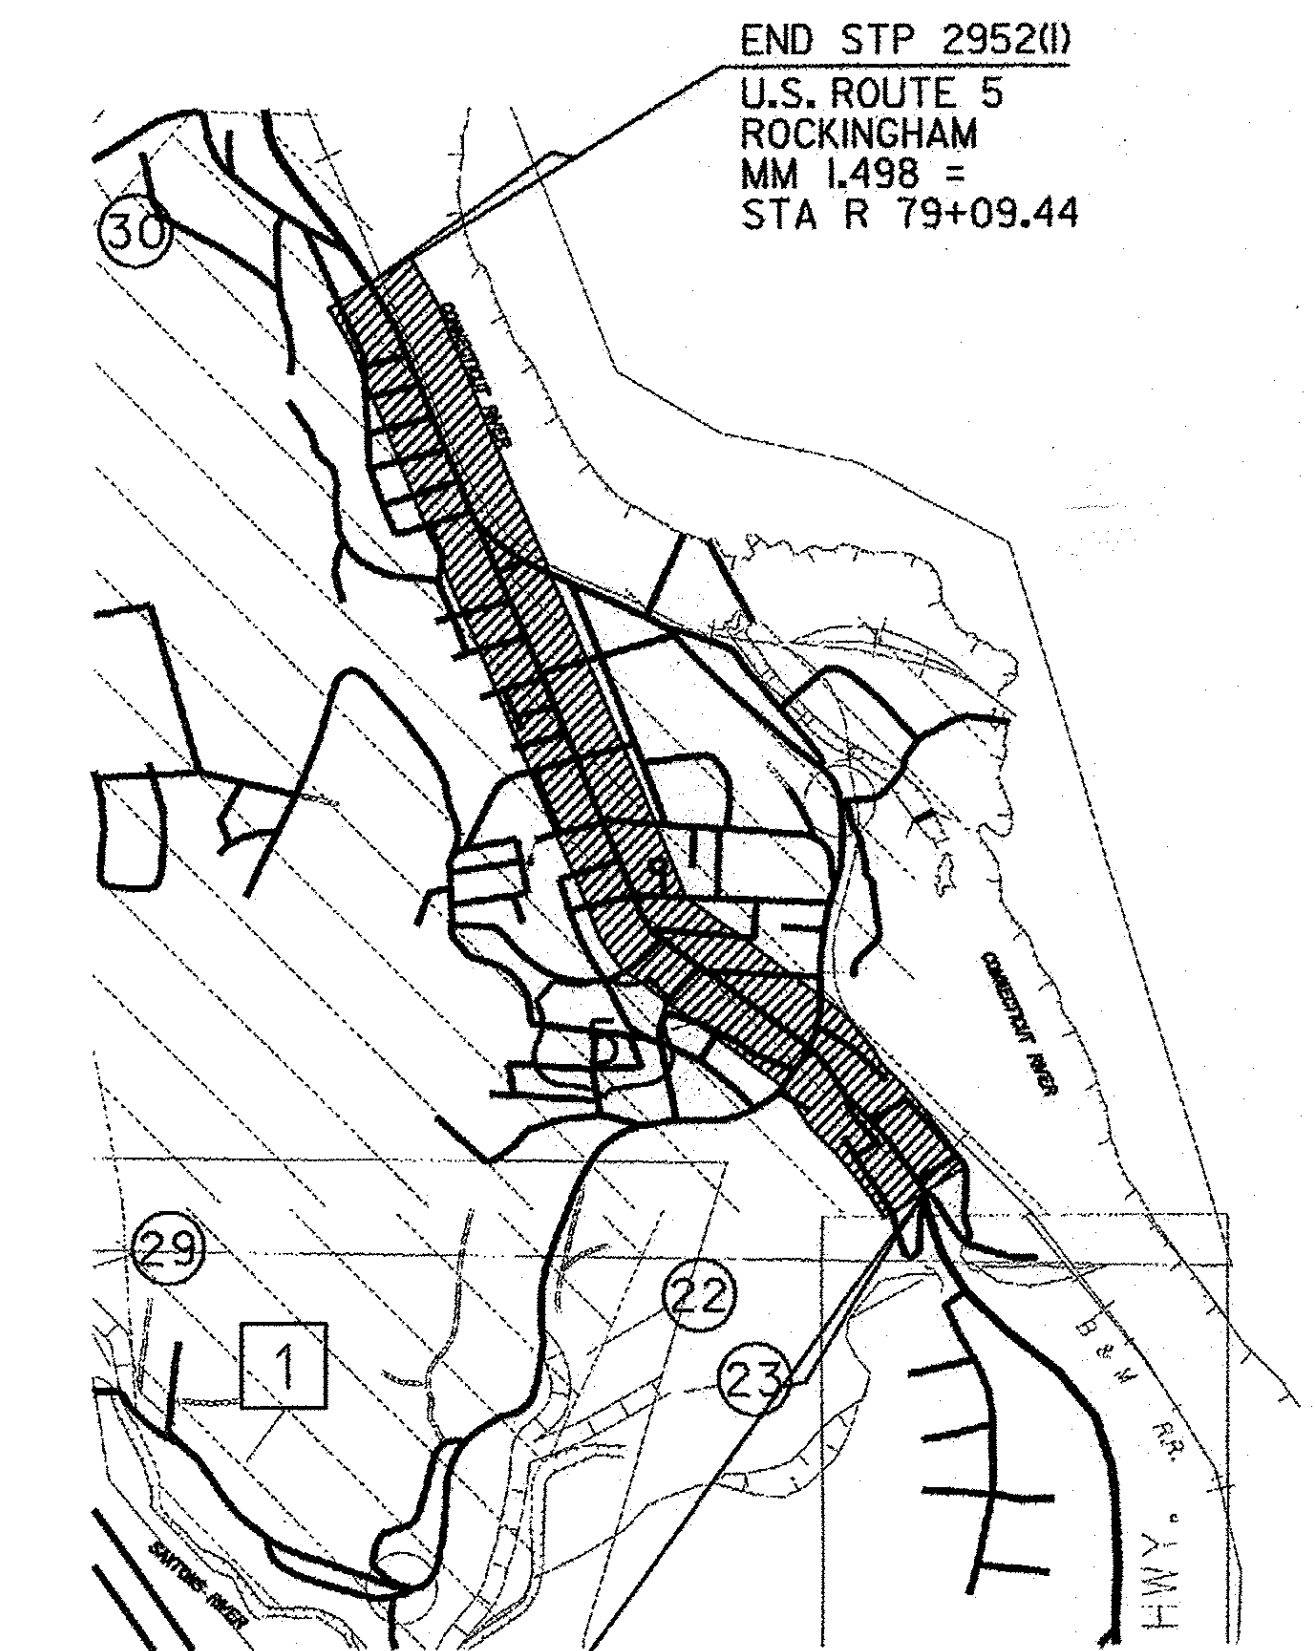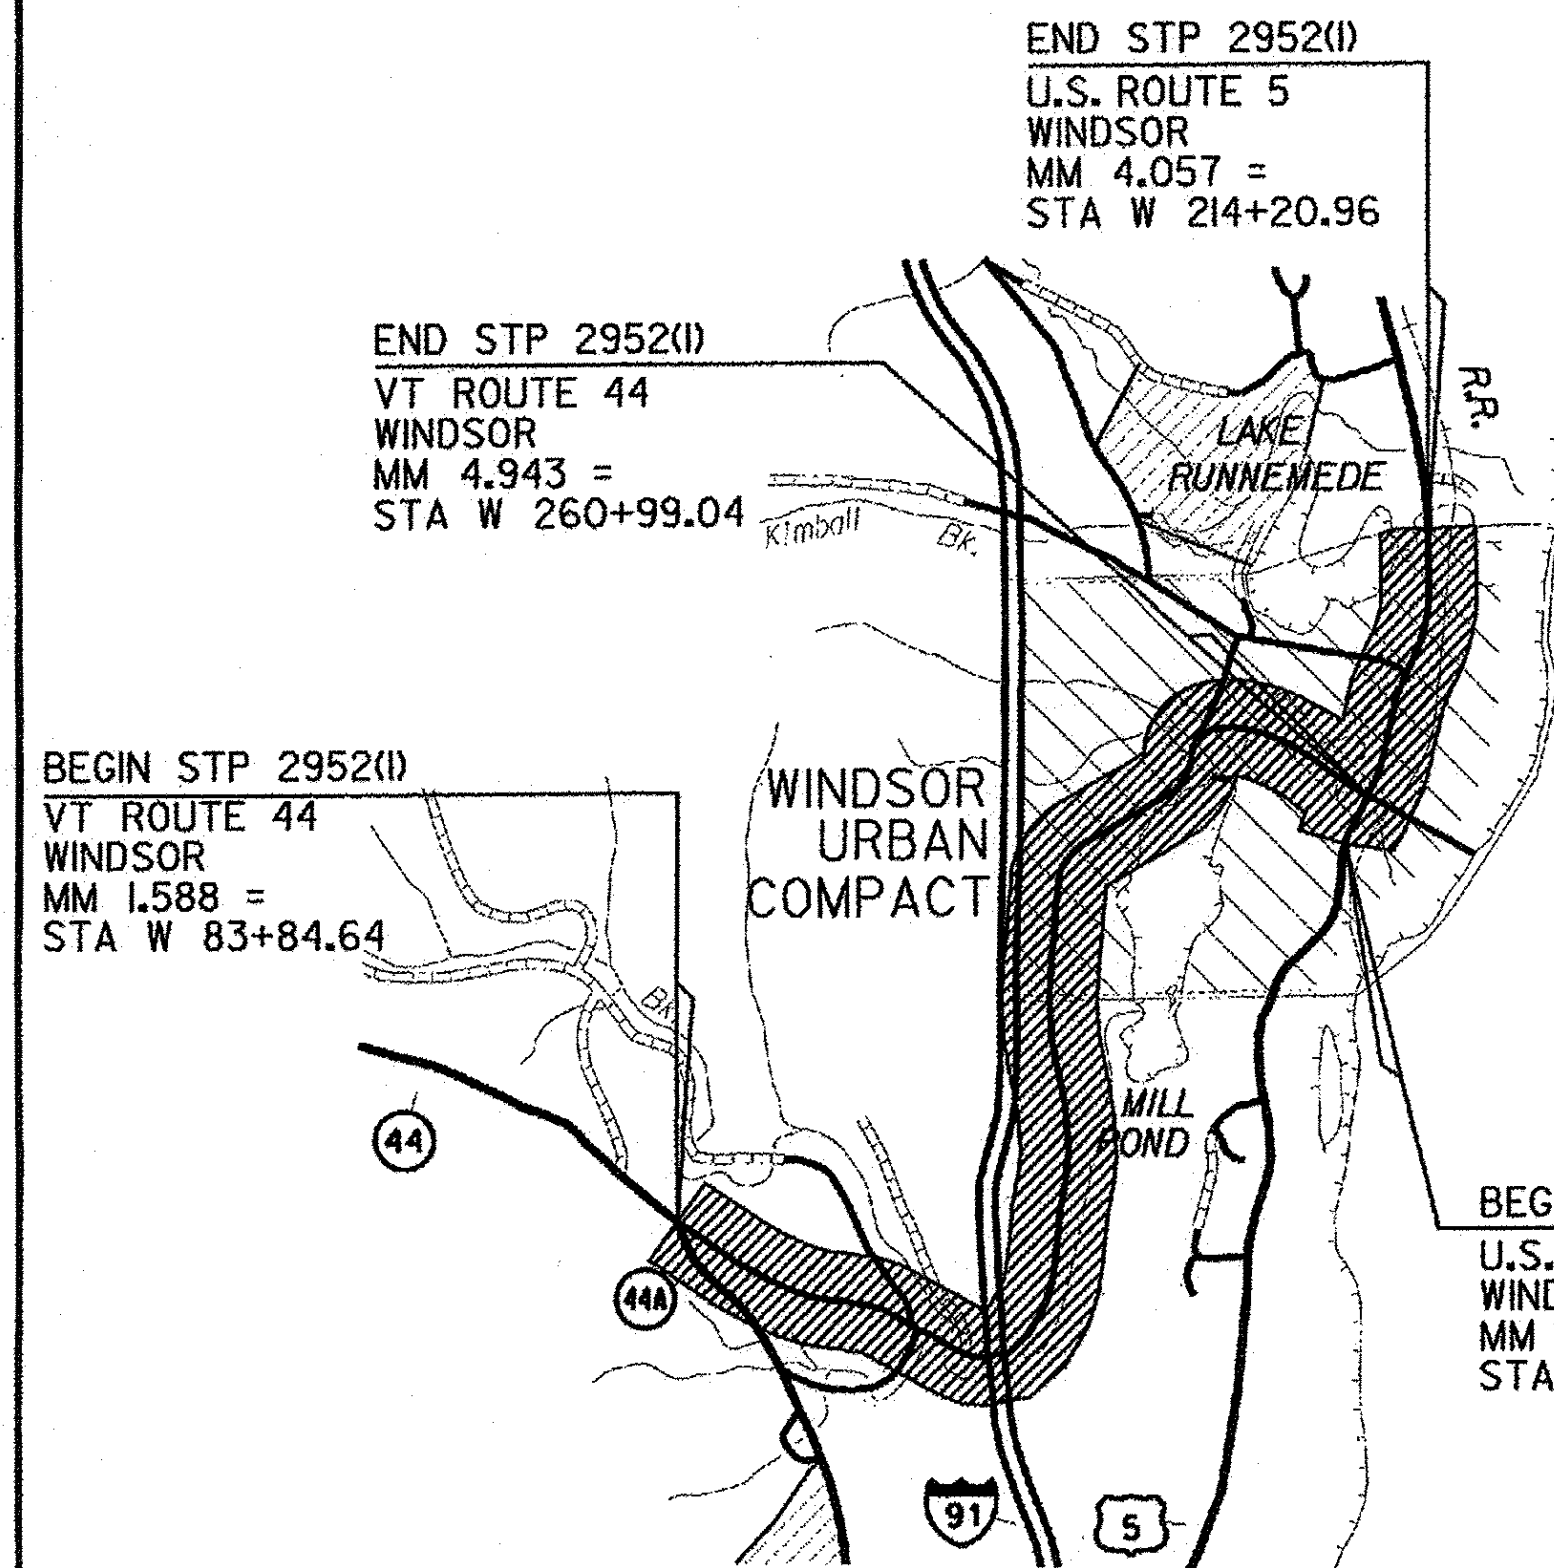

CONSTRUCTION IS TO BE CARRIED ON IN ACCORDANCE WITH THESE PLANS AND THE STANDARD SPECIFICATIONS FOR CONSTRUCTION DATED 2011, AS APPROVED BY THE FEDERAL HIGHWAY ADMINISTRATION ON JULY 20, 2011 FOR USE ON THIS PROJECT, INCLUDING ALL SUBSEQUENT REVISIONS AND SUCH REVISED SPECIFICATIONS AND SPECIAL PROVISIONS AS ARE INCORPORATED IN THESE PLANS.

QUALITY ASSURANCE PROGRAM : LEVEL 3	
SURVEYED BY :	VTRANS
SURVEYED DATE :	02/10/2013 02/14/2014
DATUM	
VERTICAL	NAVD88
HORIZONTAL	NAD83(96) NAD83(92)

NOT TO SCALE

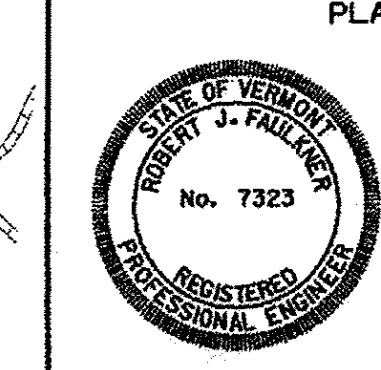

PLANS PREPARED BY
CHA
[Signature]

DIRECTOR OF PROJECT DELIVERY	APPROVED: <i>[Signature]</i> DATE 3/25/2015
PROJECT MANAGER :	MICHAEL J. FOWLER, P.E.
PROJECT NAME :	CHESTER - SPRINGFIELD - ROCKINGHAM - WINDSOR
PROJECT NUMBER :	STP 2952(I)
SHEET :	1 OF 309 SHEETS