




**PLAN  
DRIVEWAY IN  
COLD PLANE AREAS**

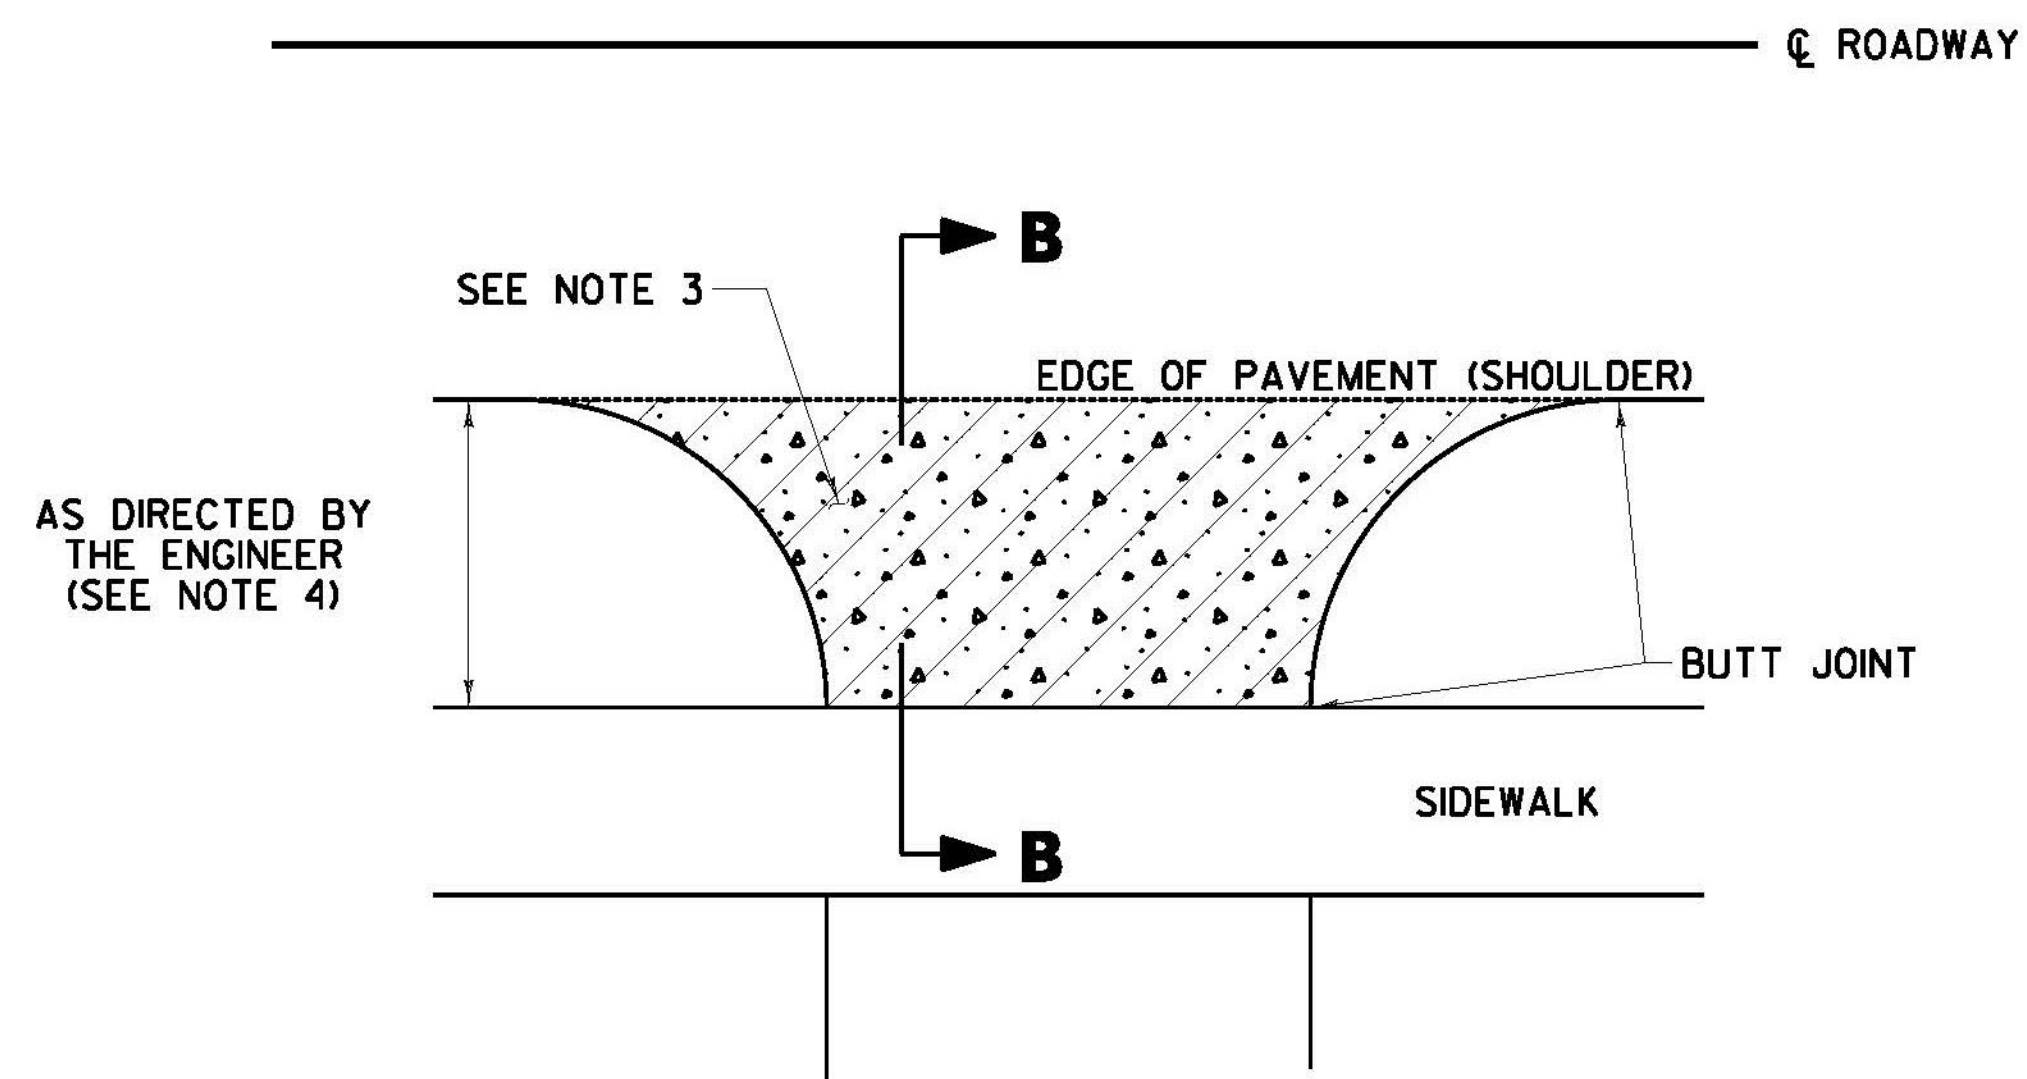


**PLAN  
DRIVEWAY WITH SIDEWALK  
IN COLD PLANE AREAS**

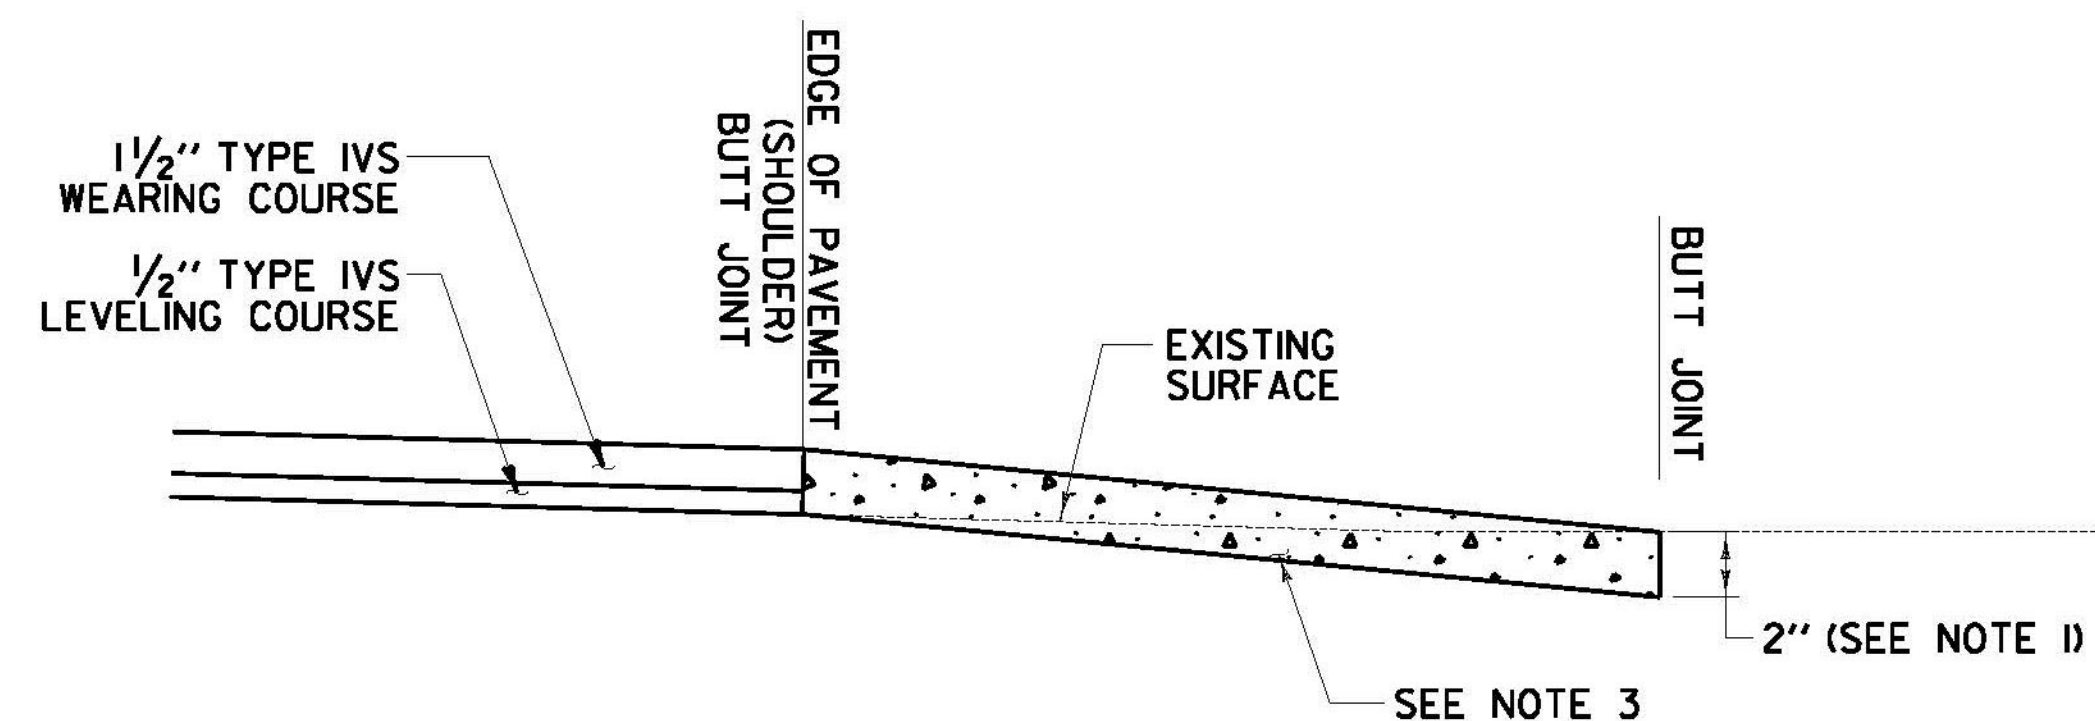

**SECTION A-A  
OVERLAY AREAS**

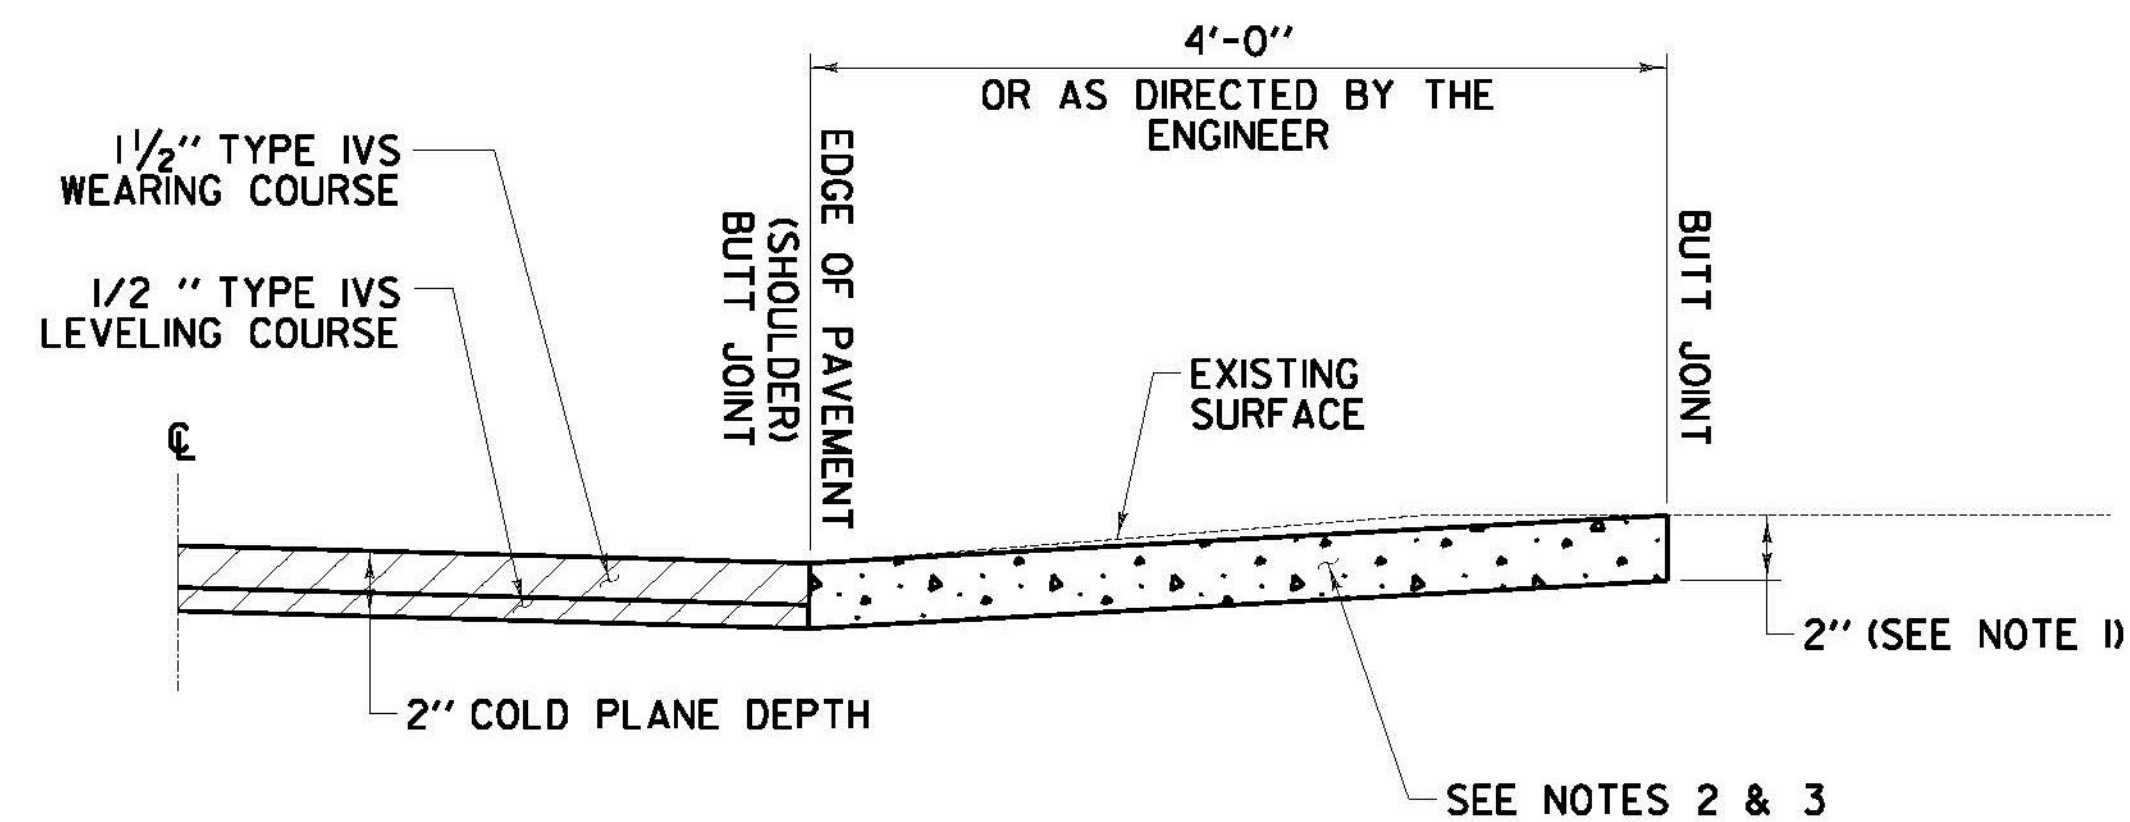

**SECTION A-A  
DRIVEWAYS IN  
COLD PLANE AREAS**

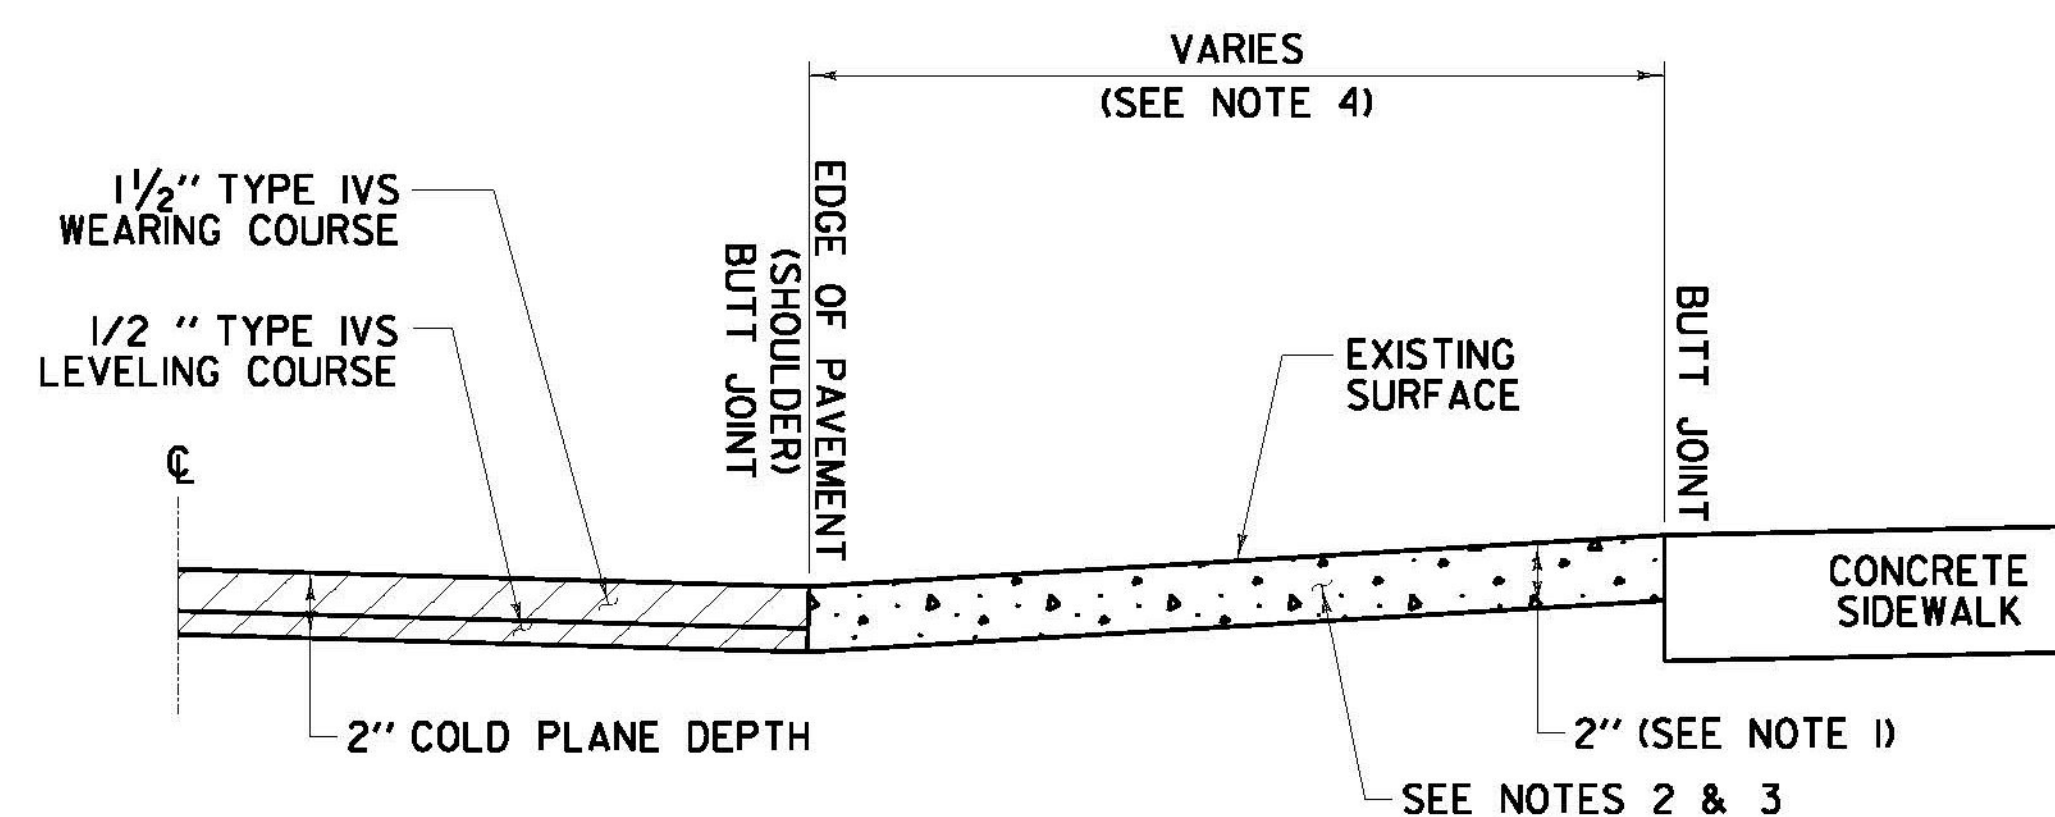


**SECTION B-B  
DRIVEWAYS IN COLD PLANE  
AREAS WITH SIDEWALK**

**NOTES:**

1. PAVING LIFT NOT TO EXCEED 2".
2. THE COST OF PLACING SUBBASE MATERIAL, CLEANING EXISTING PAVED SURFACES, EMULSIFIED ASPHALT, POWER EQUIPMENT, AND FOR FILLING JOINTS, CRACKS AND HOLES WILL BE INCLUDED IN THE UNIT PRICE BID FOR ITEM 900.675 SPECIAL PROVISION (HAND-PLACED BITUMINOUS CONCRETE MATERIAL, DRIVES).
3. EXCAVATION OR COLD PLANING NEEDED TO ACHIEVE PROPER DRIVE SLOPES WILL BE INCLUDED IN THE UNIT PRICE BID FOR ITEM 900.675 SPECIAL PROVISION (HAND-PLACED BITUMINOUS CONCRETE MATERIAL, DRIVES).
4. THE CONTRACTOR SHALL PAVE TO THE EXISTING CONCRETE SIDEWALK AS DIRECTED BY THE ENGINEER.

**LEGEND**

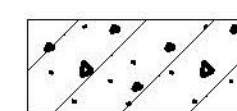

ITEM 900.675 SPECIAL PROVISION  
(HAND-PLACED BITUMINOUS  
CONCRETE MATERIAL, DRIVES)

NOT TO SCALE

**DRIVEWAY  
HANDWORK  
DETAILS  
SHEET**

PROJECT NAME: CHESTER-SPRINGFIELD-ROCKINGHAM-WINDSOR	PLOT DATE: 3/27/2015
PROJECT NUMBER: STP 295210	DRAWN BY: A. KIRBY
FILE NAME: z13c518dhd.dgn	CHECKED BY: J. SHIELDS
PROJECT LEADER: D. GOZALKOWSKI	SHEET 12 OF 309
DESIGNED BY: A. HAWKINS	