

DURABLE 24 INCH STOP BAR, TYPE A TAPE AND  
TEMPORARY 24 INCH STOP BAR, PAINT

CHESTER:  
STA C 152+35.00 LT

DURABLE LETTER OR SYMBOL, TYPE D TAPE

CHESTER:  
STA C 152+43.00 LT, "S,T,O,P" (4 EA)

TEMPORARY LETTER OR SYMBOL, PAINT

CHESTER:  
STA C 152+43.00 LT, "S,T,O,P" (8 EA)

DURABLE 4 INCH WHITE LINE, TYPE A TAPE AND  
TEMPORARY 4 INCH WHITE LINE, PAINT

(ALL LINES WILL INCLUDE EDGE LINE BREAKS AND  
RADIUS FOR TOWN HIGHWAYS)

CHESTER:  
STA C 147+50.00 - STA C 153+25.00 EDGE LINE LT & RT  
STA C 275+00.00 - STA C 275+56.32 EDGE LINE LT & RT  
STA C 275+00.00 - STA C 275+41.00 SIDEWALK DESIGNATION LINE LT

DURABLE CROSSWALK MARKING, TYPE A TAPE AND  
TEMPORARY CROSSWALK MARKING, PAINT

CHESTER:  
STA C 151+85.28 RT, VT. ROUTE 103  
STA C 275+32.00 LT/RT

DURABLE 4 INCH YELLOW LINE, TYPE A TAPE AND  
TEMPORARY 4 INCH YELLOW LINE, PAINT


(ALL LINES WILL INCLUDE C/L LINE BREAKS FOR TOWN HIGHWAYS)

CHESTER:  
STA C 147+50.00 - STA C 153+25.00 LT & RT  
STA C 275+00.00 - STA C 275+56.32 S - S

DURABLE 8 INCH WHITE LINE, TYPE A TAPE

CHESTER:  
STA C 151+00.00 - STA C 151+12.00 LT, FIRE HYDRANT, NO PARKING

REMOVING SIGNS  
AS SHOWN - 16

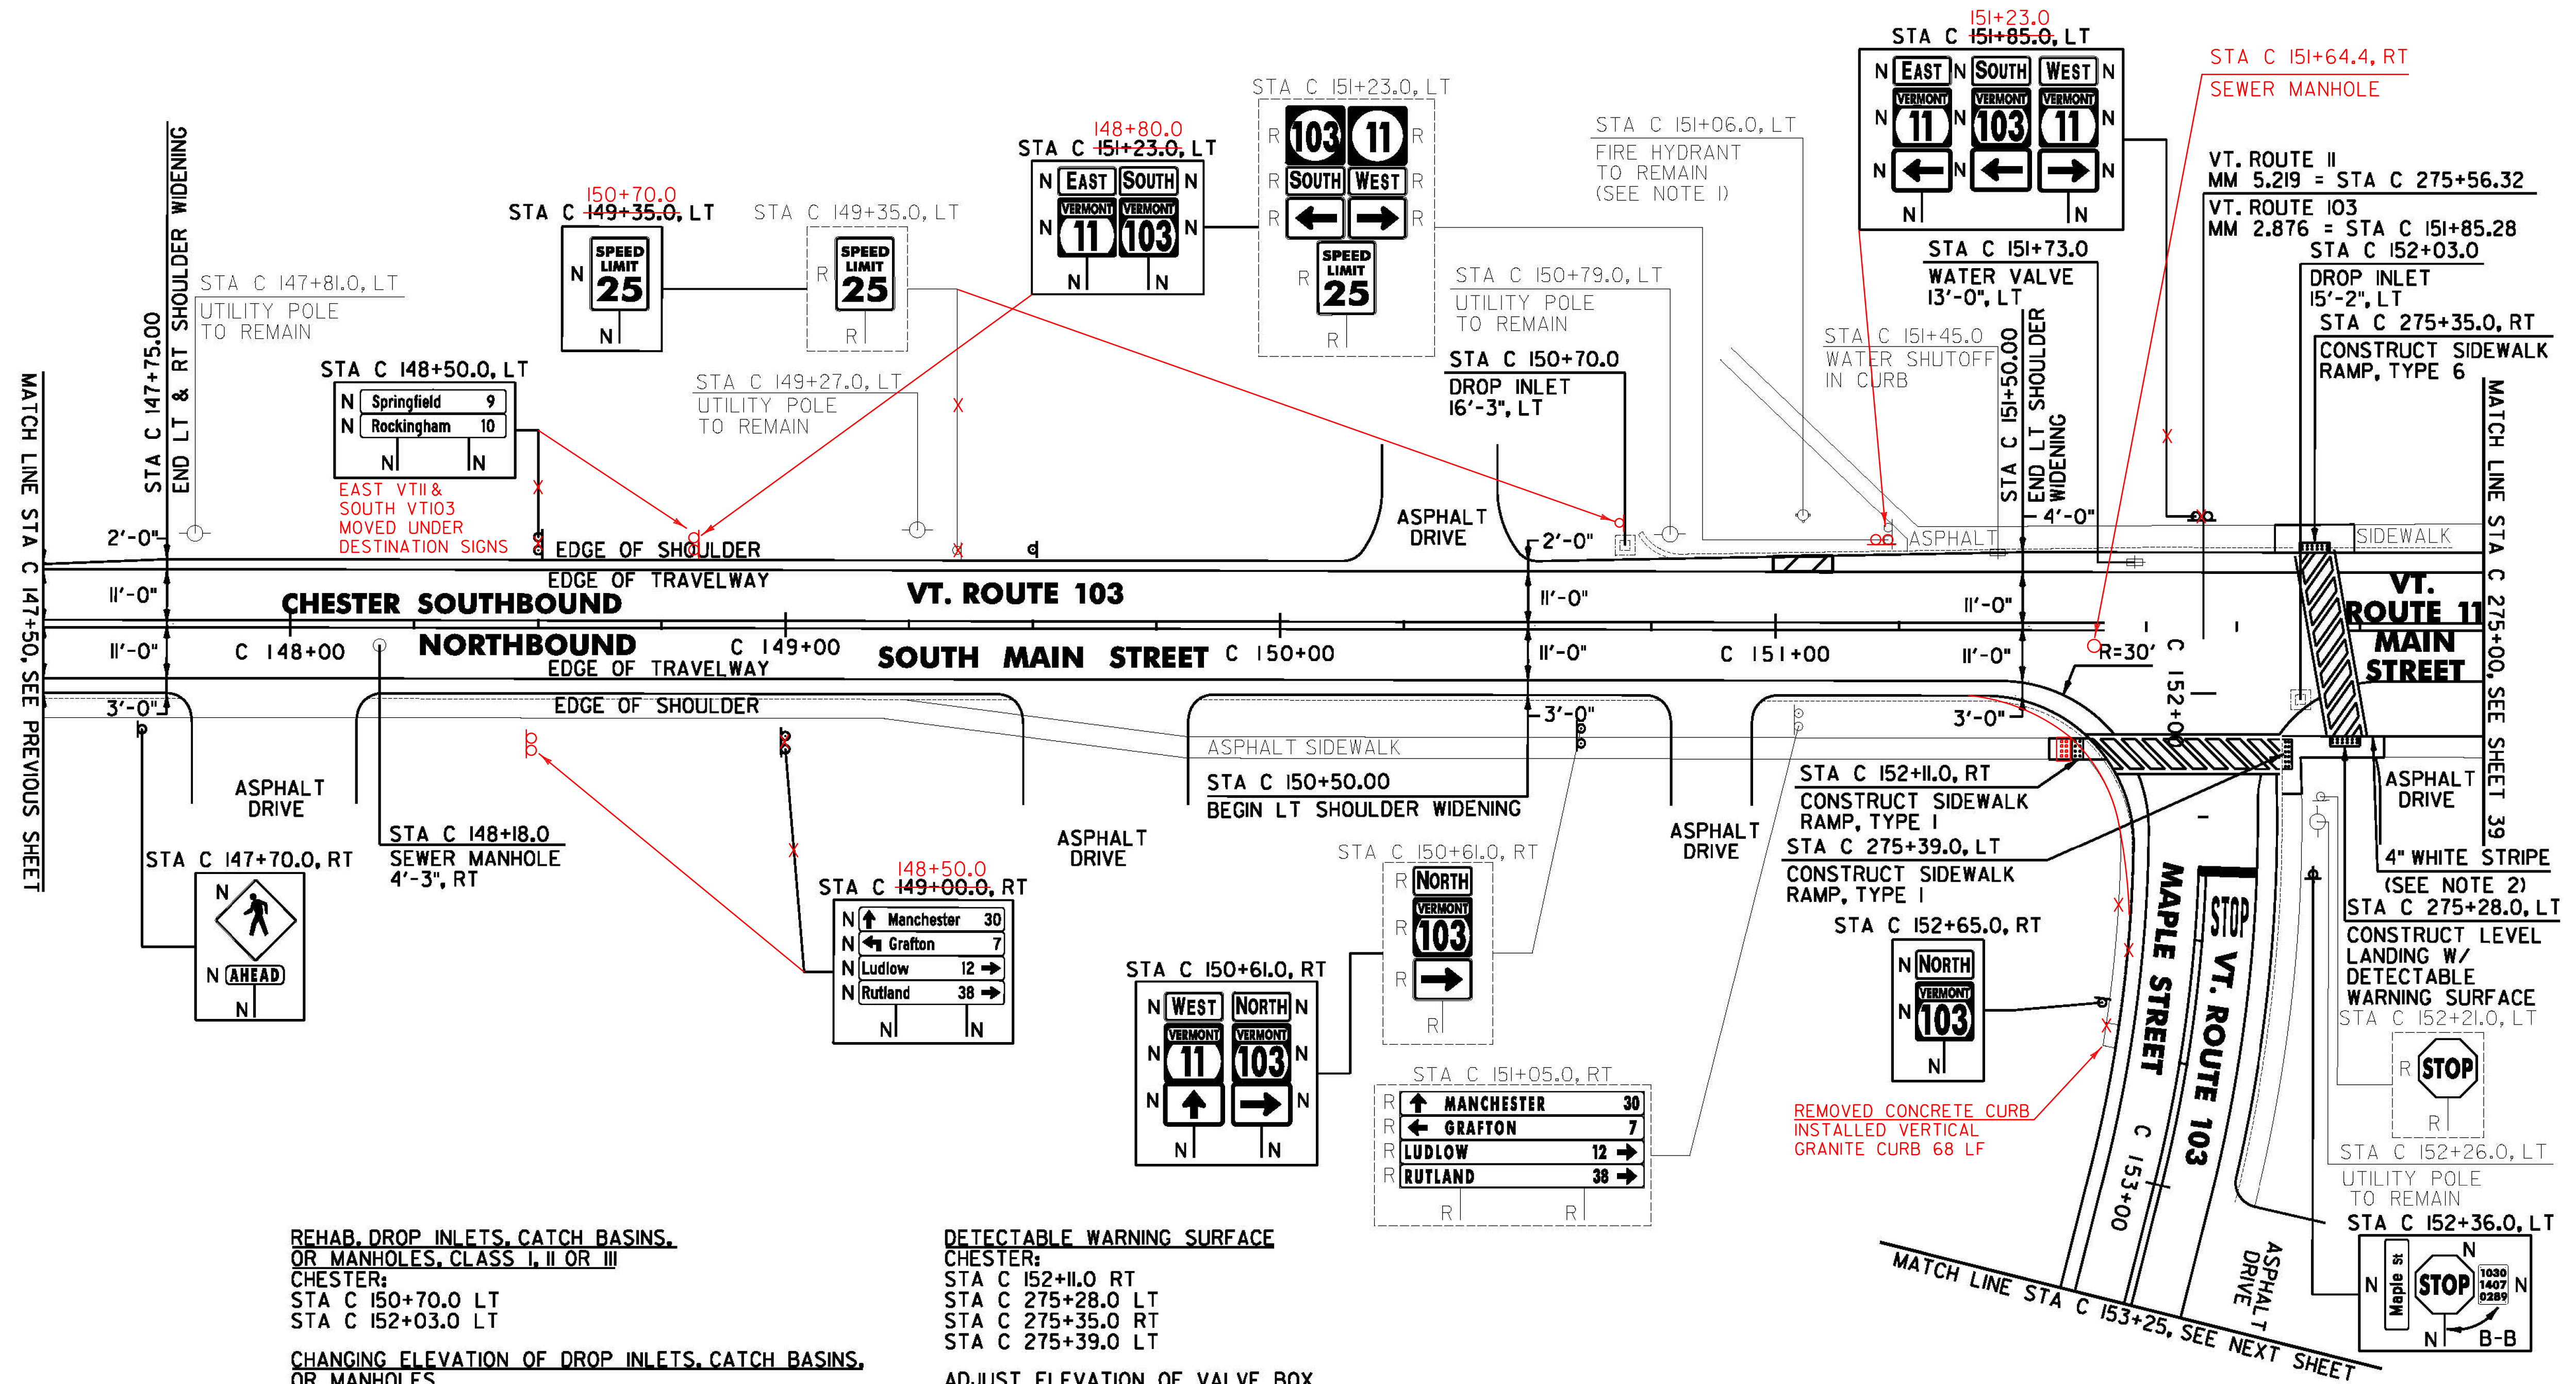

REHAB. DROP INLETS, CATCH BASINS,  
OR MANHOLES, CLASS I, II OR III  
CHESTER:  
STA C 150+70.0 LT  
STA C 152+03.0 LT

CHANGING ELEVATION OF DROP INLETS, CATCH BASINS,  
OR MANHOLES  
CHESTER:  
STA C 148+18.0 RT / STA C 151+64.4 RT  
PORTLAND CEMENT CONCRETE SIDEWALK, 5 INCH  
CHESTER:  
STA C 152+11.0 RT  
STA C 275+28.0 LT  
STA C 275+35.0 RT  
STA C 275+39.0 LT

REMOVING AND RESETTING CURB  
CHESTER:  
STA C 275+35.0 RT  
STA C 275+39.0 LT

DETECTABLE WARNING SURFACE  
CHESTER:  
STA C 152+11.0 RT  
STA C 275+28.0 LT  
STA C 275+35.0 RT  
STA C 275+39.0 LT

ADJUST ELEVATION OF VALVE BOX  
CHESTER:  
STA C 151+73.0 LT  
VERTICAL GRANITE CURB  
CHESTER:  
STA C 151+80.0 - C 152+65.0 RT 68 LF

- NOTES:
- SEE SHEET 16 FOR FIRE HYDRANT PAVEMENT MARKING DETAIL.
  - THE CONTRACTOR SHALL PROVIDE 4" WHITE LINES TO CONNECT THE SIDEWALKS ACROSS THE DRIVEWAY AND SEPARATE THE DRIVEWAY AND THE PEDESTRIAN WALKWAY.

SIGN LEGEND  
R = REMOVE  
S = SALVAGE  
N = NEW  
RET = RETAIN  
B-B = BACK TO BACK  
EXISTING = \_\_\_\_\_  
NEW = \_\_\_\_\_  
R = RETURN TO TOWN OF CHESTER

NOT TO SCALE  
**CHESTER PROJECT LAYOUT SHEET #13**

PROJECT NAME: CHESTER-SPRINGFIELD-ROCKINGHAM-WINDSOR	PLOT DATE: 3/27/2015
PROJECT NUMBER: STP 2952(1)	DRAWN BY: A. KIRBY
FILE NAME: z13c518bdr_seg01.dgn	CHECKED BY: J. SHIELDS
PROJECT LEADER: D. GOZALKOWSKI	SHEET 43 OF 309
DESIGNED BY: A. HAWKINS	