
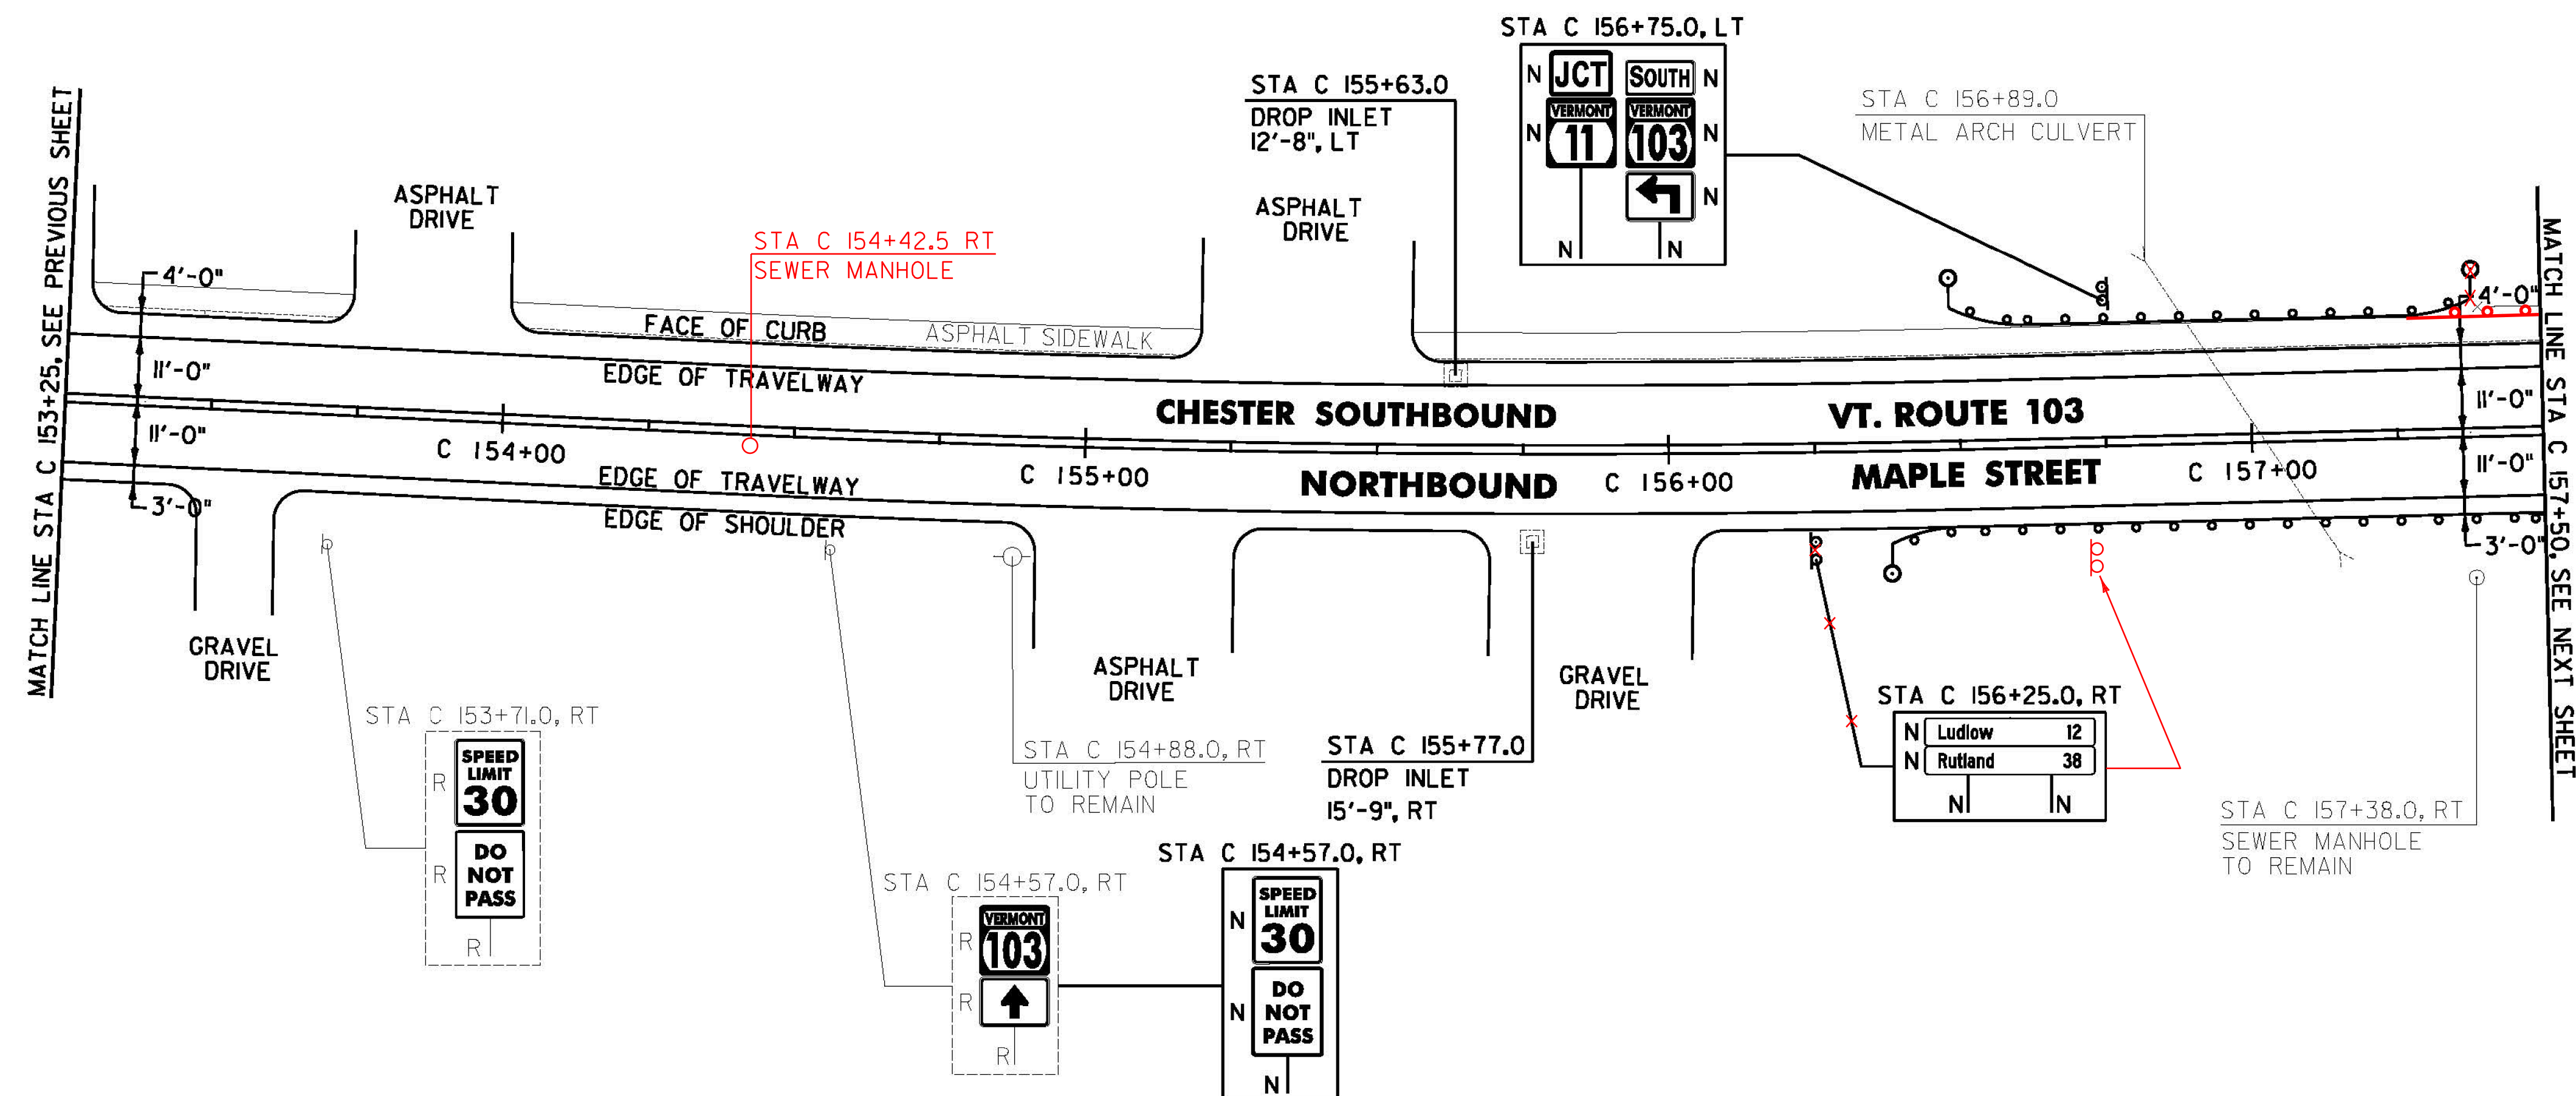


DURABLE 4 INCH WHITE LINE, TYPE A TAPE AND  
 TEMPORARY 4 INCH WHITE LINE, PAINT  
 (ALL LINES WILL INCLUDE EDGE LINE BREAKS AND  
 RADIUS FOR TOWN HIGHWAYS)  
 CHESTER:  
 STA C 153+25.00 - STA C 157+50.00 EDGE LINE LT & RT

DURABLE 4 INCH YELLOW LINE, TYPE A TAPE AND  
 TEMPORARY 4 INCH YELLOW LINE, PAINT  
 (ALL LINES WILL INCLUDE C/L LINE BREAKS FOR TOWN HIGHWAYS)  
 S = SOLID, D = DASHED  
 CHESTER:  
 STA C 153+25.00 - STA C 157+50.00 LT & RT  
 S = S

REMOVING SIGNS  
 AS SHOWN - 4

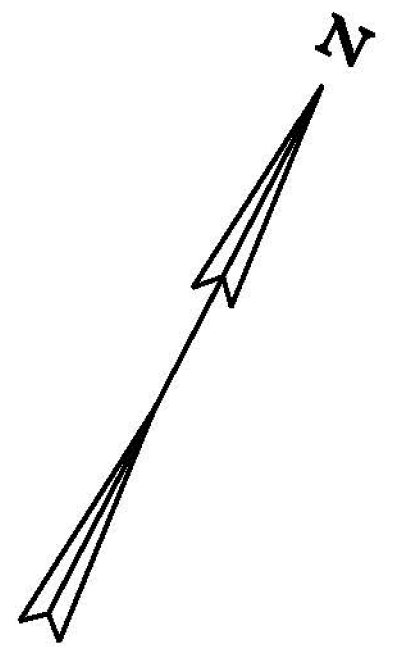

CHANGE ELEVATION SEWER MANHOLE  
 STA C 154+42.5 RT

REHAB. DROP INLETS, CATCH BASINS,  
 OR MANHOLES, CLASS I, II OR III  
 CHESTER:  
 STA C 155+63.0 LT  
 STA C 155+77.0 RT

STEEL BEAM GUARDRAIL, GALVANIZED  
 CHESTER:  
 STA C 156+34.0 - STA C 157+50.0 RT  
 STA C 156+46.5 - STA C 156+73.5 LT  
 STA C 157+11.0 - STA C 157+38.0 LT  
 STA C 157+09.0 - STA C 157+50.0 RT  
 ANCHOR FOR STEEL BEAM RAIL  
 CHESTER:  
 STA C 156+40.5 RT  
 STA C 156+53.0 LT  
 STA C 157+31.5 LT

REMOVAL AND DISPOSAL OF GUARDRAIL  
 CHESTER:  
 STA C 156+51.0 - STA C 157+38.0 LT  
 STA C 156+38.0 - STA C 157+50.0 RT

HD STEEL BEAM GUARDRAIL, GALVANIZED/NESTED  
 CHESTER:  
 STA C 156+73.5 - STA C 157+11.0 LT  
 STA C 156+71.5 - STA C 157+09.0 RT  
 DELINEATOR WITH STEEL POST  
 CHESTER:  
 STA C 156+34.0 RT  
 STA C 156+46.5 LT  
 STA C 157+38.0 LT

SIGN LEGEND  
 R = REMOVE  
 S = SALVAGE  
 N = NEW  
 RET = RETAIN  
 B-B = BACK TO BACK  
 EXISTING = -----  
 NEW = \_\_\_\_\_  
 R = RETURN TO TOWN  
 OF CHESTER

NOT TO SCALE

<b>CHESTER PROJECT LAYOUT SHEET #14</b>	PROJECT NAME: CHESTER-SPRINGFIELD-ROCKINGHAM-WINDSOR
	PROJECT NUMBER: STP 2952(0)
	FILE NAME: z13c518bdr_seg01.dgn PROJECT LEADER: D. GOZALKOWSKI DESIGNED BY: A. HAWKINS
	PLOT DATE: 3/27/2015 DRAWN BY: A. KIRBY CHECKED BY: J. SHIELDS SHEET 44 OF 309