

DURABLE 4 INCH WHITE LINE, TYPE A TAPE AND TEMPORARY 4 INCH WHITE LINE, PAINT
 (ALL LINES WILL INCLUDE EDGE LINE BREAKS AND RADIUS FOR TOWN HIGHWAYS)
 CHESTER:
 STA C 165+25.00 - STA C 170+25.00 EDGE LINE LT & RT
 STA C 165+73.92 EDGE LINES LT, TH-101
 STA C 165+73.92 EDGE LINES LT, TH-87

DURABLE 4 INCH YELLOW LINE, TYPE A TAPE AND TEMPORARY 4 INCH YELLOW LINE, PAINT
 (ALL LINES WILL INCLUDE C/L LINE BREAKS FOR TOWN HIGHWAYS)
 S = SOLID, D = DASHED
 CHESTER:
 STA C 165+25.00 - STA C 170+25.00 LT & RT
 STA C 165+73.92 DOUBLE SOLID LT, TH-101
 STA C 165+73.92 DOUBLE SOLID LT, TH-87

DURABLE 24 INCH STOP BAR, TYPE A TAPE AND TEMPORARY 24 INCH STOP BAR, PAINT
 CHESTER:
 STA C 165+73.92 LT, TH-101
 STA C 165+73.92 LT, TH-87

REMOVING SIGNS AS SHOWN - 7



DURABLE 8 INCH WHITE LINE, TYPE A TAPE
 STA C 166+68.00 - STA C 166+80.00 RT

DURABLE LETTER OR SYMBOL, TYPE D TAPE
 CHESTER:
 STA C 165+73.92 LT, TH-101 "S,T,O,P" (4 EA)
 STA C 165+73.92 LT, TH-87 "S,T,O,P" (4 EA)

TEMPORARY LETTER OR SYMBOL, PAINT
 CHESTER:
 STA C 165+73.92 LT, TH-101 "S,T,O,P" (8 EA)
 STA C 165+73.92 LT, TH-87 "S,T,O,P" (8 EA)

DURABLE CROSSWALK MARKING, TYPE A TAPE AND TEMPORARY CROSSWALK MARKING, PAINT
 CHESTER:
 STA C 165+73.92 LT, TH-101

BITUMINOUS CONCRETE GUTTERS AND TRAFFIC ISLANDS
 CHESTER:
 STA C 169+34.0 - STA C 170+62.0 LT, 7.14 TON

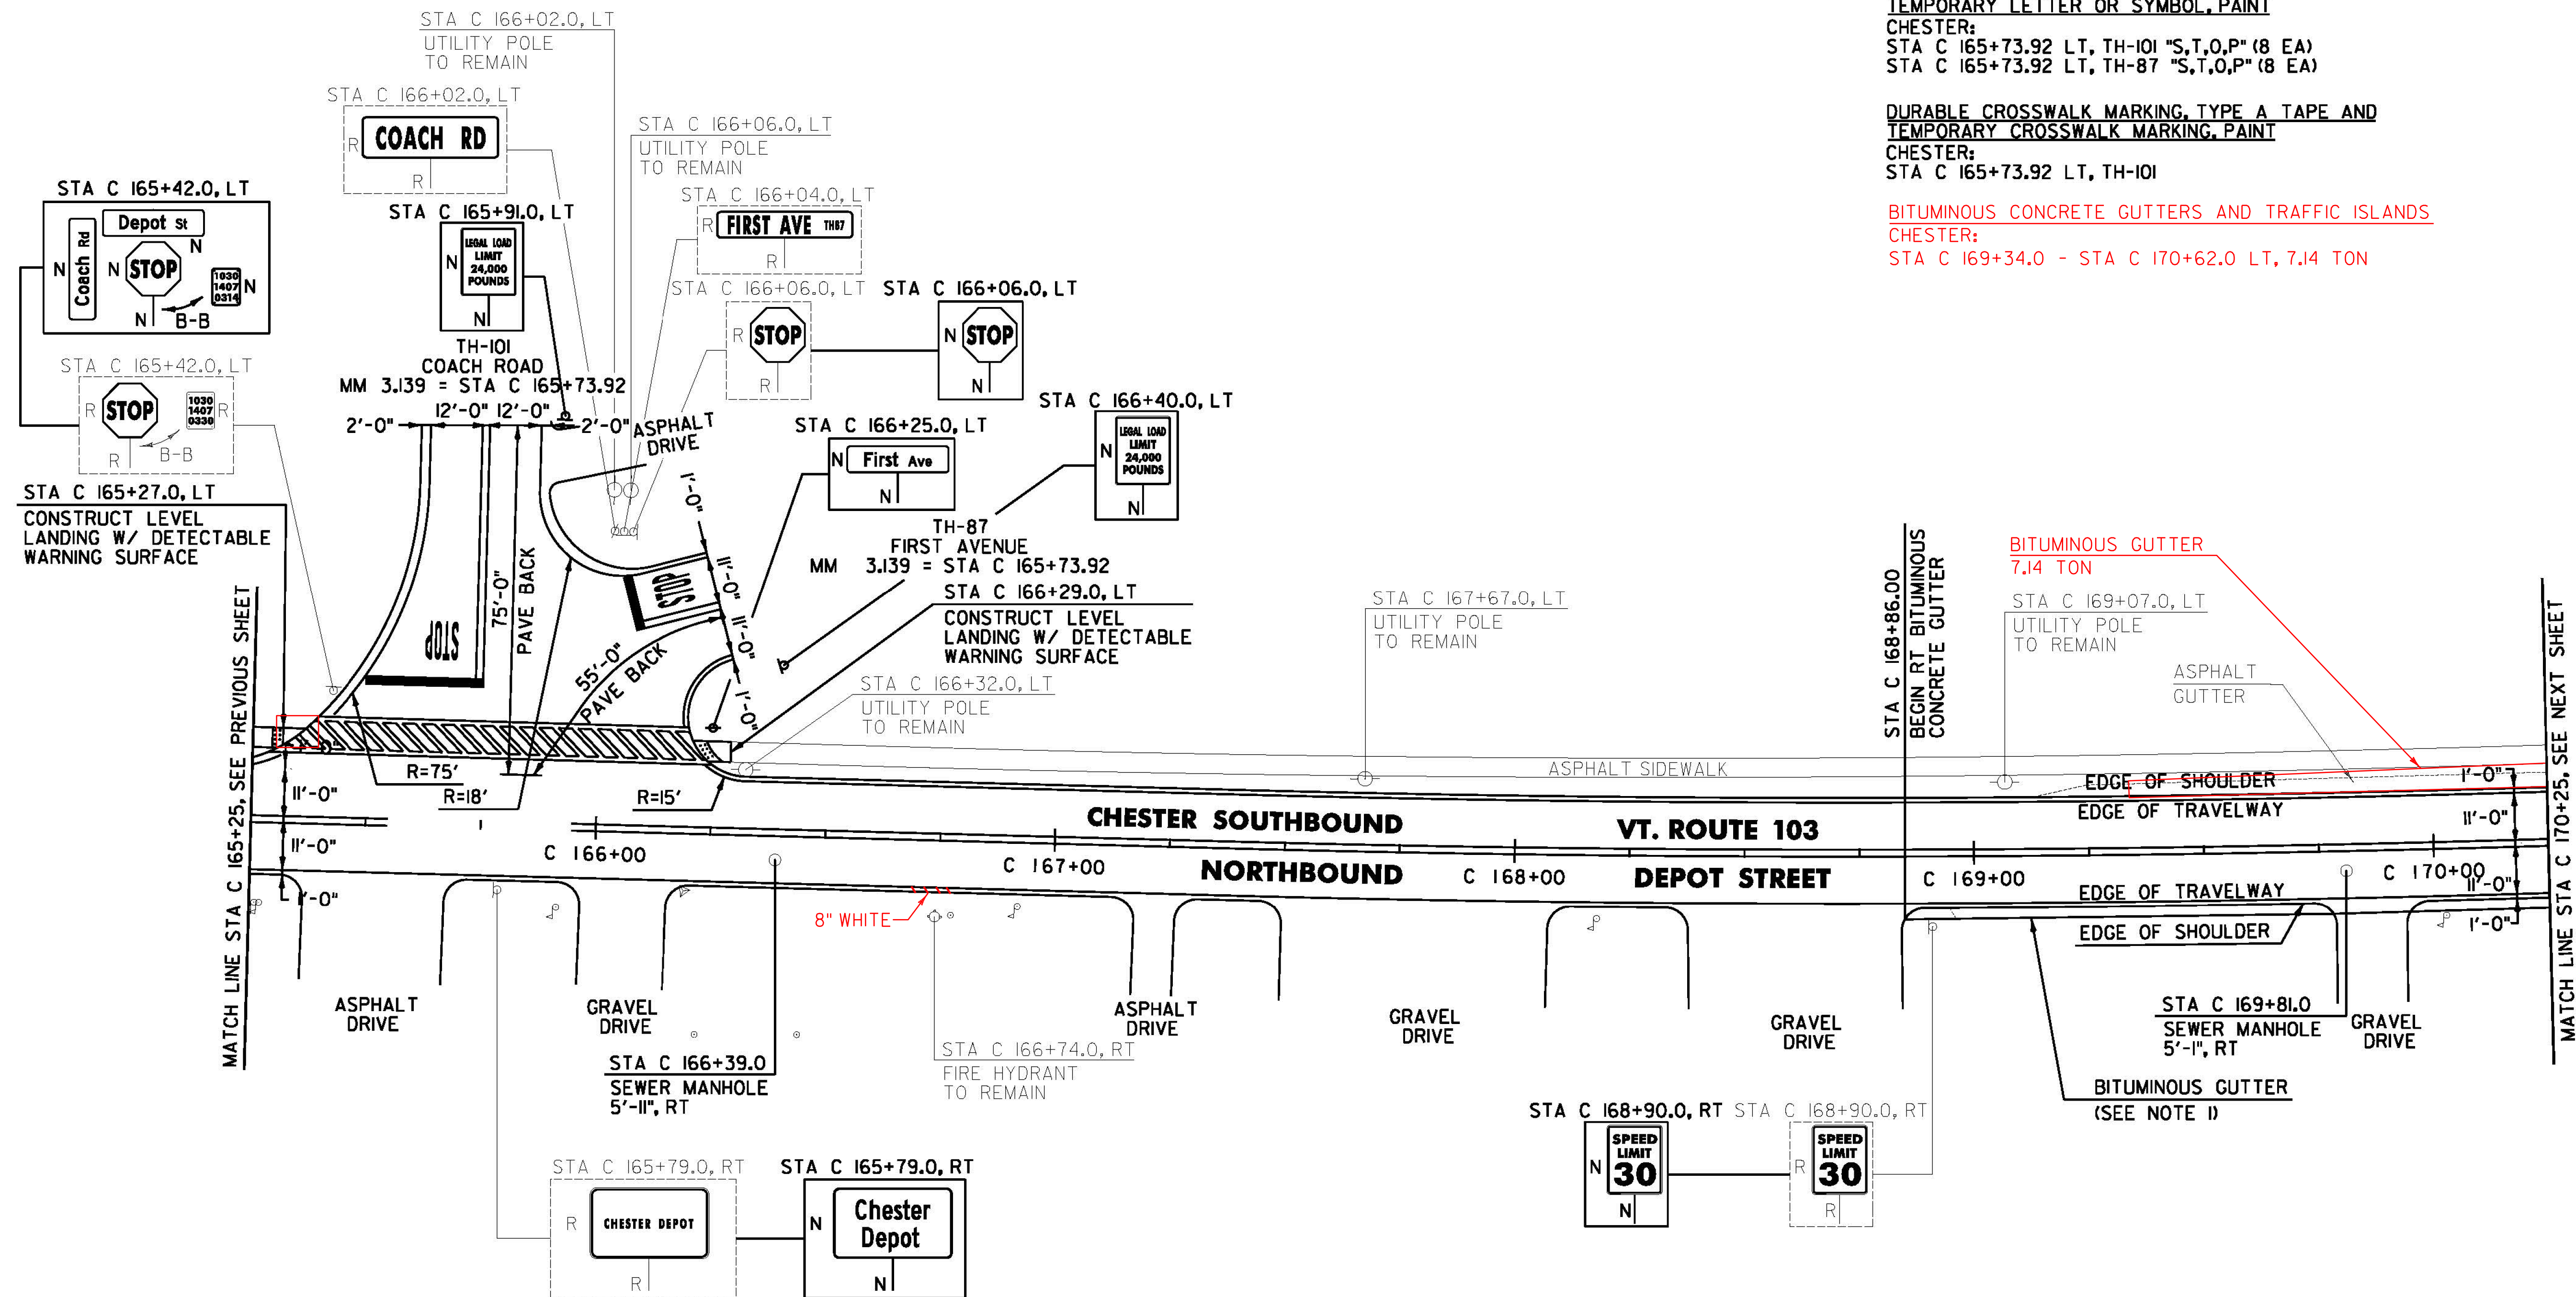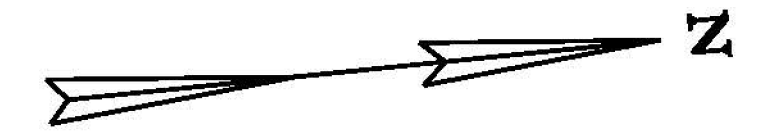

CHANGING ELEVATION OF SEWER MANHOLES
 CHESTER:
 STA C 166+39.0 RT
 STA C 169+81.0 RT

BITUMINOUS CONCRETE GUTTERS AND TRAFFIC ISLANDS
 CHESTER:
 STA C 168+86.0 - STA C 170+25.0 RT (3.4 T)

PORTLAND CEMENT CONCRETE SIDEWALK, 5 INCH
 CHESTER:
 STA C 165+27.0 LT
 STA C 166+29.0 LT

DETECTABLE WARNING SURFACE
 CHESTER:
 STA C 165+27.0 LT
 STA C 166+29.0 LT

SIGN LEGEND
 R = REMOVE
 S = SALVAGE
 N = NEW
 RET = RETAIN
 B-B = BACK TO BACK
 EXISTING = _____
 NEW = _____
 R = RETURN TO TOWN OF CHESTER

NOT TO SCALE

CHESTER PROJECT LAYOUT SHEET #17

NOTE:
 1. SEE SHEET 16 FOR BITUMINOUS CONCRETE GUTTER DETAIL.

PROJECT NAME: CHESTER-SPRINGFIELD-ROCKINGHAM-WINDSOR
 PROJECT NUMBER: STP 2952(1)

FILE NAME: z13c518bdr_seg01.dgn
 PROJECT LEADER: D. GOZALKOWSKI
 DESIGNED BY: A. HAWKINS

PLOT DATE: 3/27/2015
 DRAWN BY: A. KIRBY
 CHECKED BY: J. SHIELDS
 SHEET 47 OF 309