

DURABLE 4 INCH WHITE LINE, TYPE A TAPE AND TEMPORARY 4 INCH WHITE LINE, PAINT
 (ALL LINES WILL INCLUDE EDGE LINE BREAKS AND RADIUS FOR TOWN HIGHWAYS)
 CHESTER:
 STA C 190+25.00 - STA C 194+75.00 EDGE LINE LT & RT
 STA C 191+08.32 EDGE LINES LT, TH-87
 STA C 191+13.60 EDGE LINES RT, TH-9

DURABLE 4 INCH YELLOW LINE, TYPE A TAPE AND TEMPORARY 4 INCH YELLOW LINE, PAINT
 (ALL LINES WILL INCLUDE C/L LINE BREAKS FOR TOWN HIGHWAYS)
 S = SOLID, D = DASHED
 CHESTER:
 STA C 190+25.00 - STA C 194+75.00 LT & RT
 STA C 191+08.32 DOUBLE SOLID LT, TH-87
 STA C 191+13.60 DOUBLE SOLID RT, TH-9



DURABLE LETTER OR SYMBOL, TYPE D TAPE CHESTER:
 STA C 191+08.32 LT, TH-87 "S,T,O,P" (4 EA)
 STA C 191+13.60 RT, TH-9 "S,T,O,P" (4 EA)

TEMPORARY LETTER OR SYMBOL, PAINT CHESTER:
 STA C 191+08.32 LT, TH-87 "S,T,O,P" (8 EA)
 STA C 191+13.60 RT, TH-9 "S,T,O,P" (8 EA)

DURABLE 24 INCH STOP BAR, TYPE A TAPE AND TEMPORARY 24 INCH STOP BAR, PAINT
 CHESTER:
 STA C 191+08.32 LT, TH-87
 STA C 191+13.60 RT, TH-9

DURABLE CROSSWALK MARKING, TYPE A TAPE AND TEMPORARY CROSSWALK MARKING, PAINT
 CHESTER:
 STA C 191+08.32 LT, TH-87

REMOVING SIGNS AS SHOWN - 9

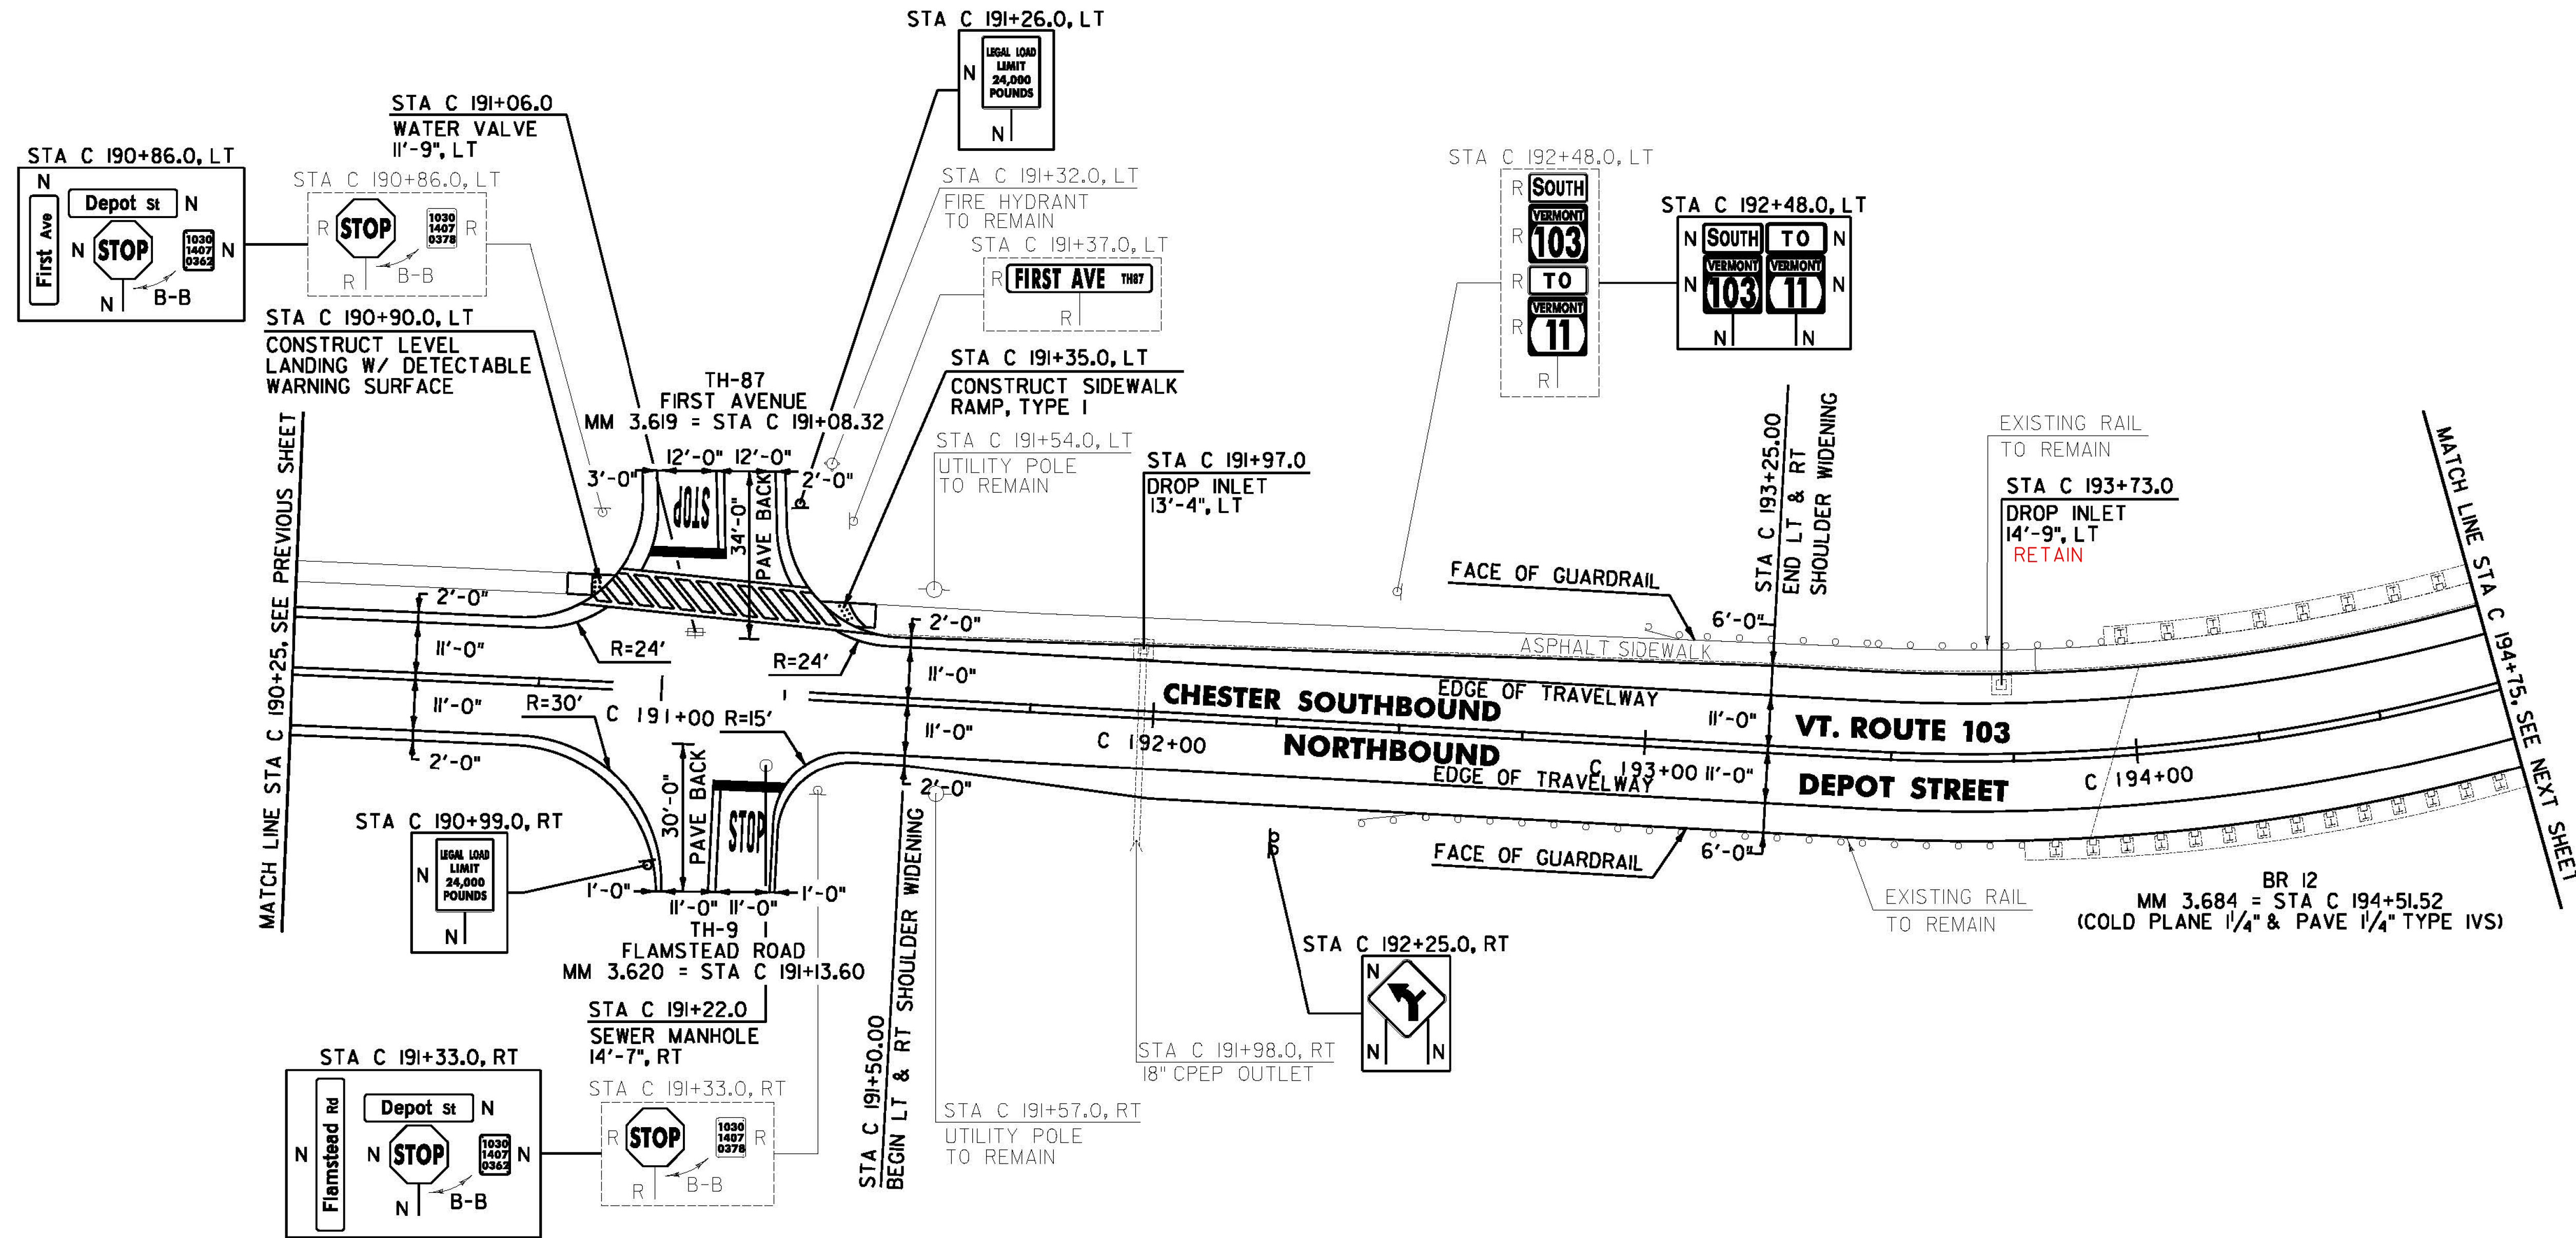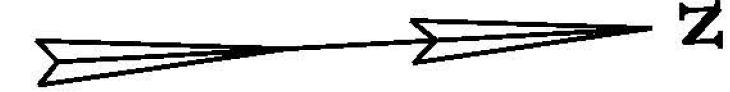

REHAB. DROP INLETS, CATCH BASINS, OR MANHOLES, CLASS I, II OR III
 CHESTER:
 STA C 191+97.0 LT
~~STA C 193+73.0 LT~~

CHANGING ELEVATION OF SEWER MANHOLES
 CHESTER:
 STA C 191+22.0 RT

ADJUST ELEVATION OF VALVE BOX
 CHESTER:
 STA C 191+06.0 LT

REMOVING AND RESETTING CURB
 CHESTER:
 STA C 191+35.0 LT

PORTLAND CEMENT CONCRETE SIDEWALK, 5 INCH
 CHESTER:
 STA C 190+90.0 LT
 STA C 191+35.0 LT

DETECTABLE WARNING SURFACE
 CHESTER:
 STA C 190+90.0 LT
 STA C 191+35.0 LT

REMOVE AND REPLACE REFLECTOR UNIT
 CHESTER:
 STA C 192+82.3 RT
 STA C 193+13.5 RT
 STA C 193+32.5 LT
 STA C 193+44.8 RT
 STA C 193+63.8 LT
 STA C 193+76.0 RT
 STA C 193+95.0 LT

SIGN LEGEND
 R = REMOVE
 S = SALVAGE
 N = NEW
 RET = RETAIN
 B-B = BACK TO BACK
 EXISTING = -----
 NEW = _____
 R = RETURN TO TOWN OF CHESTER

NOT TO SCALE

CHESTER PROJECT LAYOUT SHEET #22	PROJECT NAME: CHESTER-SPRINGFIELD-ROCKINGHAM-WINDSOR	PLOT DATE: 3/27/2015
	PROJECT NUMBER: STP 2952(1)	DRAWN BY: A. KIRBY
	FILE NAME: z13c518bdr_seg01.dgn	CHECKED BY: J. SHIELDS
	DESIGNED BY: A. HAWKINS	SHEET 52 OF 309