
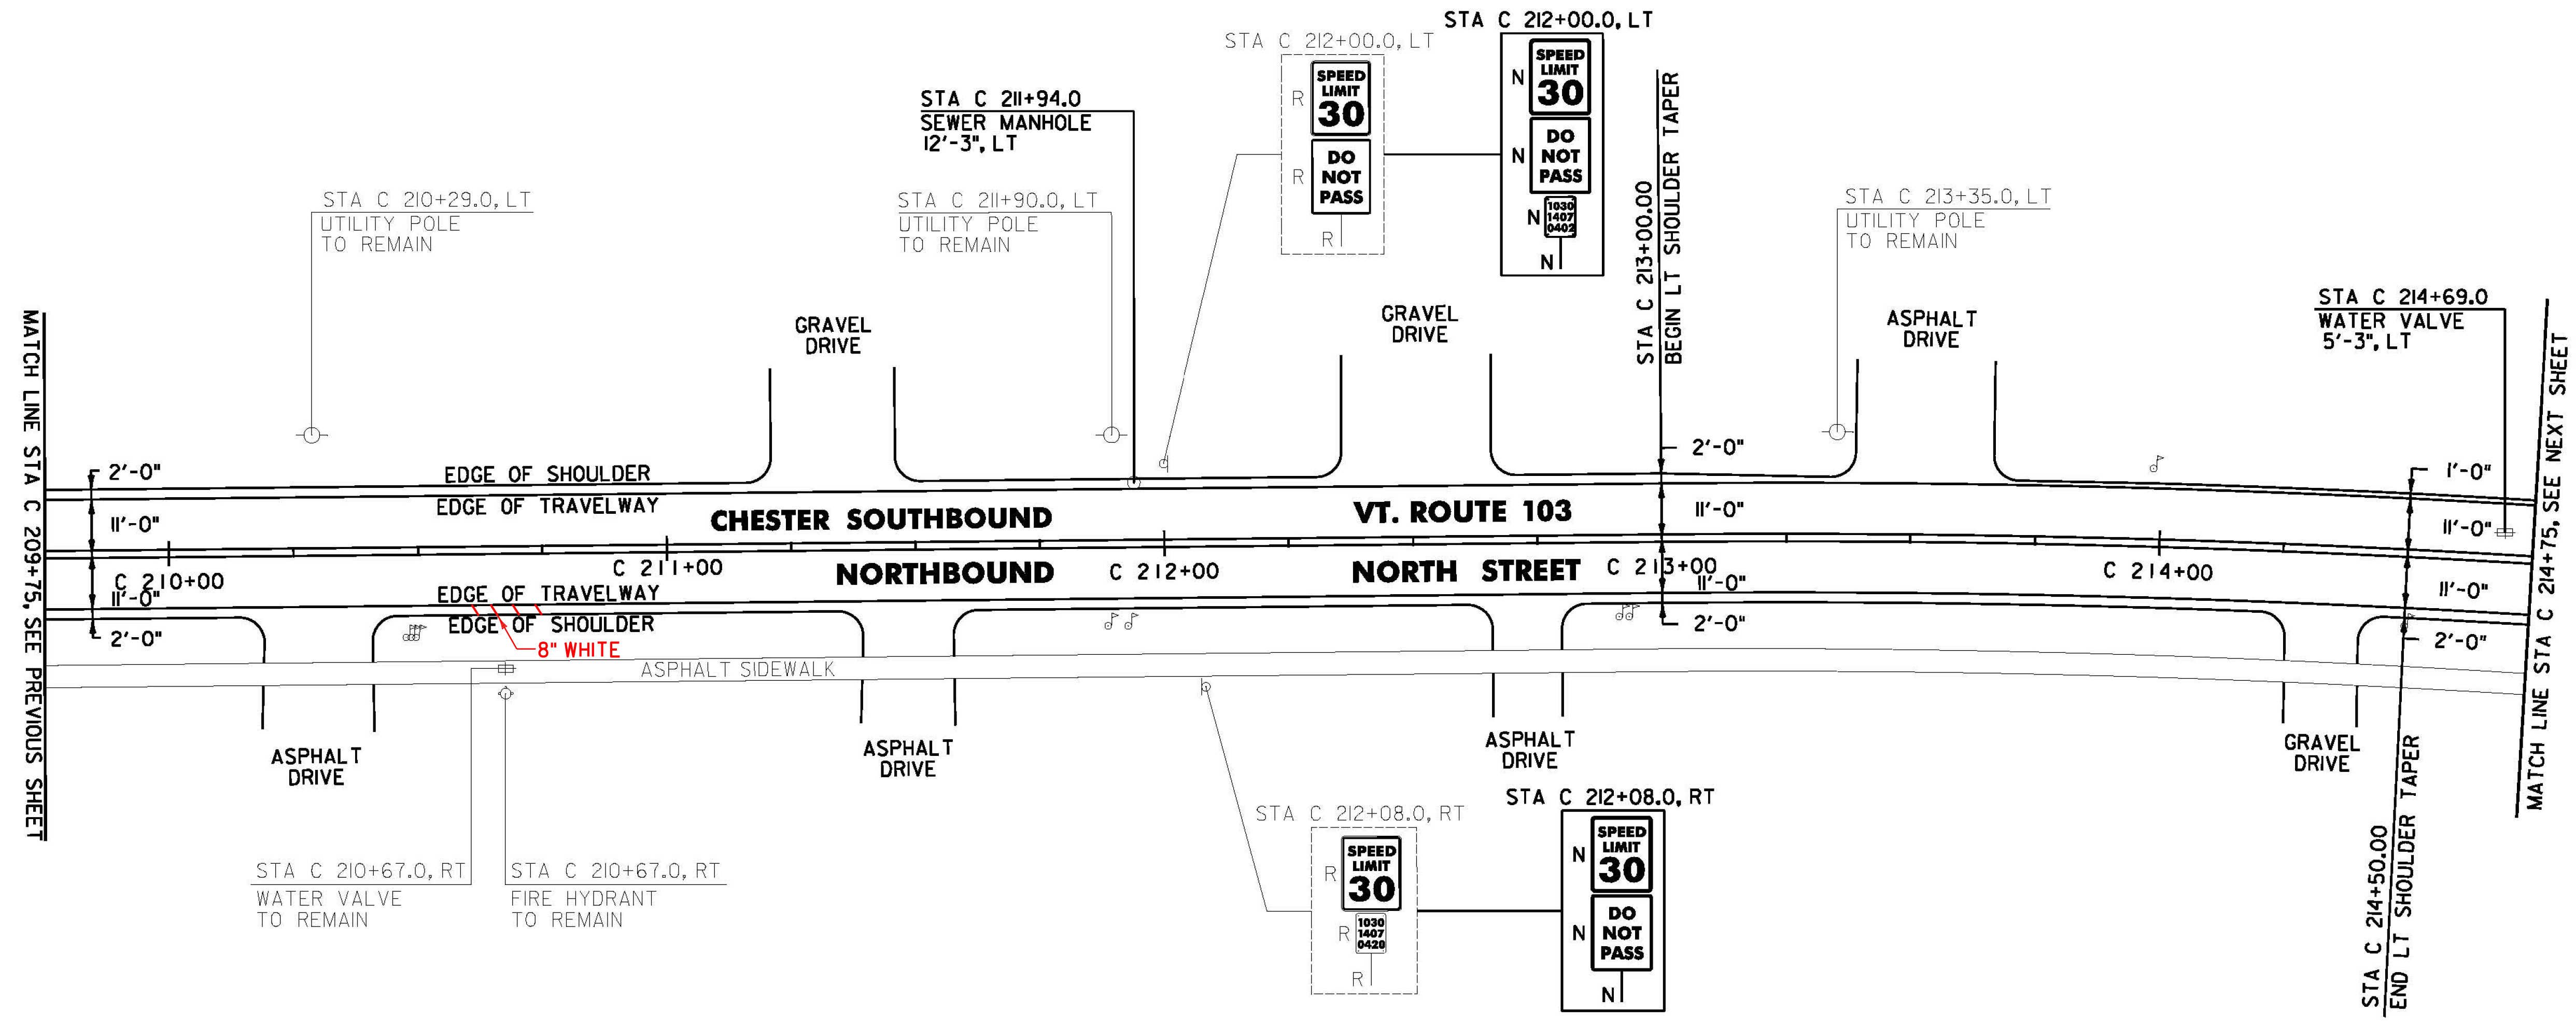


DURABLE 4 INCH WHITE LINE, TYPE A TAPE AND
 TEMPORARY 4 INCH WHITE LINE, PAINT
 (ALL LINES WILL INCLUDE EDGE LINE BREAKS AND
 RADIUS FOR TOWN HIGHWAYS)
 CHESTER:
 STA C 209+75.00 - STA C 214+75.00 EDGE LINE LT & RT

DURABLE 8 INCH WHITE LINE, TYPE A TAPE
 STA C 210+61- STA C 210+73 RT

DURABLE 4 INCH YELLOW LINE, TYPE A TAPE AND
 TEMPORARY 4 INCH YELLOW LINE, PAINT
 (ALL LINES WILL INCLUDE C/L LINE BREAKS FOR TOWN HIGHWAYS)
 S = SOLID, D = DASHED
 CHESTER:
 STA C 209+75.00 - STA C 214+75.00 LT & RT
 S - S

REMOVING SIGNS
 AS SHOWN - 4

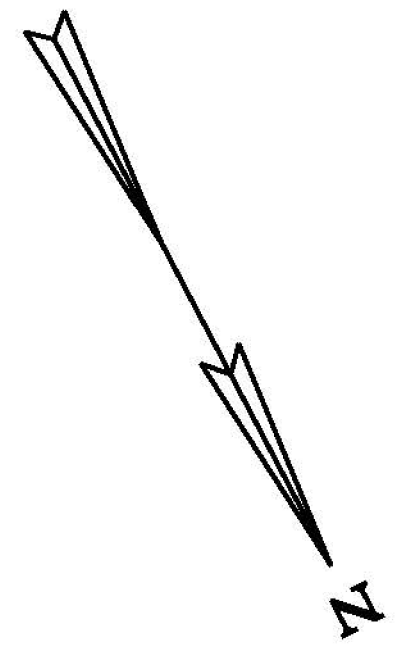

CHANGING ELEVATION OF SEWER MANHOLES
 CHESTER:
 STA C 211+94.0 LT

ADJUST ELEVATION OF VALVE BOX
 CHESTER:
 STA C 214+69.0 LT

SIGN LEGEND
 R = REMOVE
 S = SALVAGE
 N = NEW
 RET = RETAIN
 B-B = BACK TO BACK
 EXISTING = _____
 NEW = _____
 R = RETURN TO TOWN
 OF CHESTER

NOT TO SCALE
**CHESTER
 PROJECT
 LAYOUT
 SHEET #26**

PROJECT NAME: CHESTER-SPRINGFIELD-ROCKINGHAM-WINDSOR
 PROJECT NUMBER: STP 2952(1)
 FILE NAME: z13c518bdr_seg01.dgn
 PROJECT LEADER: D. GOZALKOWSKI
 DESIGNED BY: A. HAWKINS

PLOT DATE: 3/27/2015
 DRAWN BY: A. KIRBY
 CHECKED BY: J. SHIELDS
 SHEET 56 OF 309