
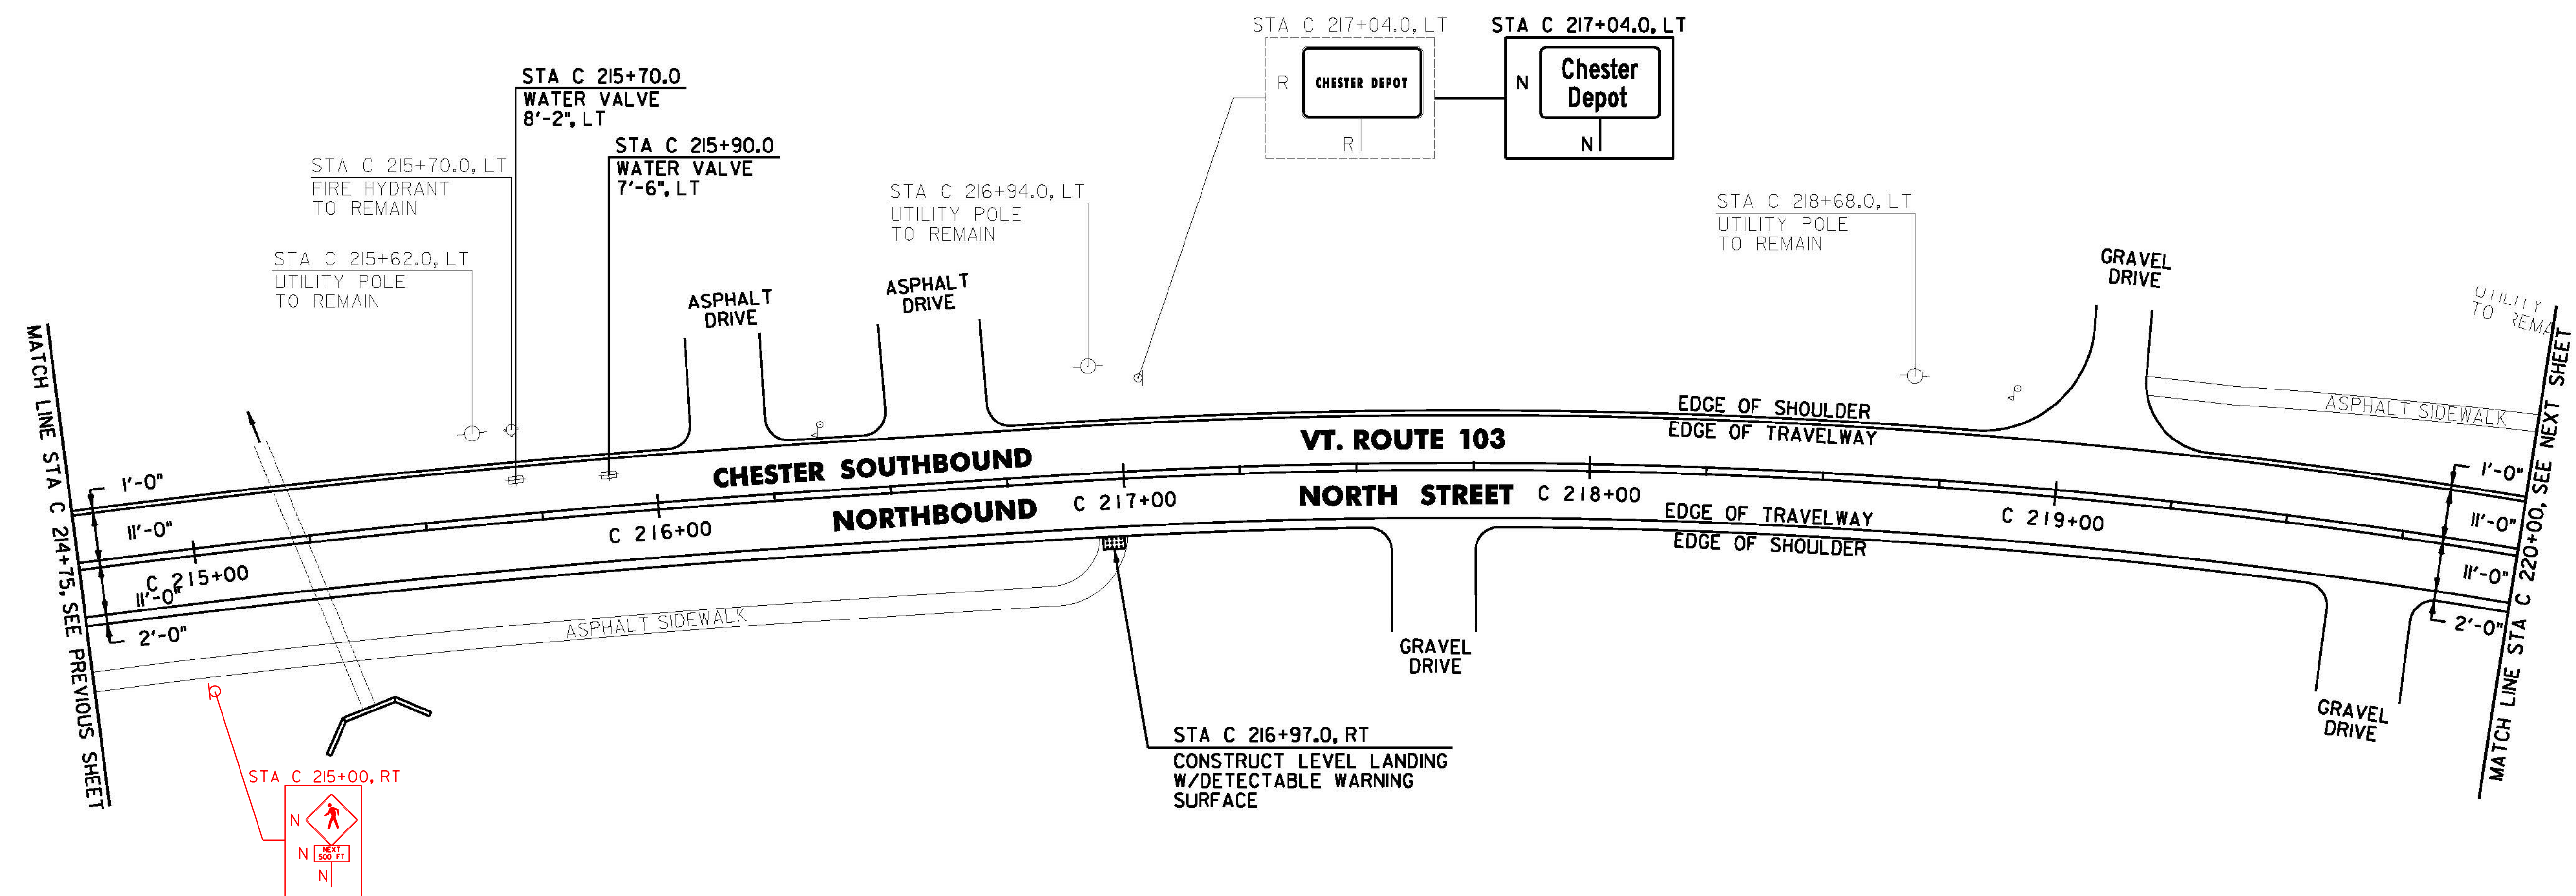


DURABLE 4 INCH WHITE LINE, TYPE A TAPE AND
 TEMPORARY 4 INCH WHITE LINE, PAINT
 (ALL LINES WILL INCLUDE EDGE LINE BREAKS AND
 RADIUS FOR TOWN HIGHWAYS)
 CHESTER:
 STA C 214+75.00 - STA C 220+00.00 EDGE LINE LT & RT

DURABLE 4 INCH YELLOW LINE, TYPE A TAPE AND
 TEMPORARY 4 INCH YELLOW LINE, PAINT
 (ALL LINES WILL INCLUDE C/L LINE BREAKS FOR TOWN HIGHWAYS)
 S = SOLID, D = DASHED
 CHESTER:
 STA C 214+75.00 - STA C 220+00.00 LT C RT
 S S

REMOVING SIGNS
 AS SHOWN - 1

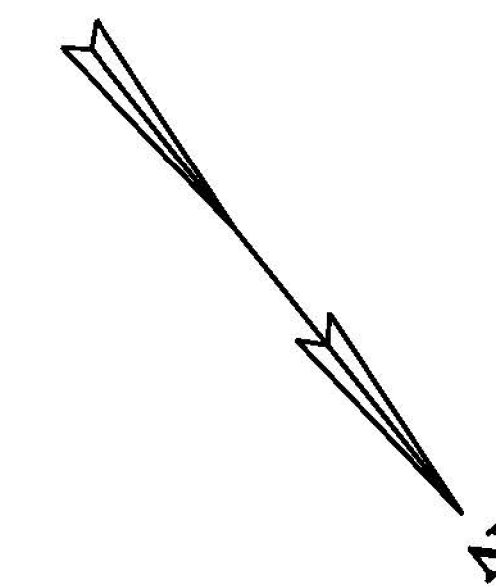

PORTLAND CEMENT CONCRETE SIDEWALK, 5 INCH
 CHESTER:
 STA C 216+97.0 RT

DETECTABLE WARNING SURFACE
 CHESTER:
 STA C 216+97.0 RT

ADJUST ELEVATION OF VALVE BOX
 CHESTER:
 STA C 215+70.0 LT
 STA C 215+90.0 LT

SIGN LEGEND
 R = REMOVE
 S = SALVAGE
 N = NEW
 RET = RETAIN
 B-B = BACK TO BACK
 EXISTING = _____
 NEW = _____
 R = RETURN TO TOWN
 OF CHESTER

NOT TO SCALE

CHESTER PROJECT LAYOUT SHEET #27	PROJECT NAME: CHESTER-SPRINGFIELD-ROCKINGHAM-WINDSOR
	PROJECT NUMBER: STP 2952(1)
	FILE NAME: z13c518bdr_seg01.dgn
	PLOT DATE: 3/27/2015
	DRAWN BY: A. KIRBY
	CHECKED BY: J. SHIELDS
	DESIGNED BY: A. HAWKINS
	SHEET 57 OF 309