

DURABLE 4 INCH WHITE LINE, TYPE A TAPE AND TEMPORARY 4 INCH WHITE LINE, PAINT
 (ALL LINES WILL INCLUDE EDGE LINE BREAKS AND RADIUS FOR TOWN HIGHWAYS)
 SPRINGFIELD:
 STA S 196+50.00 - STA S 201+50.00 EDGE LINE LT & RT
 STA S 198+36.96 EDGE LINES LT, TH-336
 STA S 198+36.96 SOLID LANE LINE LT, TH-336
 STA S 199+54.00 - STA S 199+86.00 SIDEWALK DESIGNATION LINE LT
 STA S 199+54.00 - STA S 199+86.00 SIDEWALK DESIGNATION LINE LT

DURABLE 4 INCH YELLOW LINE, TYPE A TAPE AND TEMPORARY 4 INCH YELLOW LINE, PAINT
 (ALL LINES WILL INCLUDE C/L LINE BREAKS FOR TOWN HIGHWAYS)
 S = SOLID, D = DASHED
 SPRINGFIELD:
 STA S 196+50.00 - STA S 201+50.00 LT & RT
 STA S 198+36.96 DOUBLE SOLID LT, TH-336

DURABLE 8 INCH WHITE LINE, TYPE A TAPE
 SPRINGFIELD:
 STA S 199+16.00 - STA S 199+28.00 RT, FIRE HYDRANT, NO PARKING


DURABLE 24 INCH STOP BAR, TYPE A TAPE AND TEMPORARY 24 INCH STOP BAR, PAINT
 SPRINGFIELD:
 STA S 198+36.96 LT, TH-336

DURABLE LETTER OR SYMBOL, TYPE D TAPE
 SPRINGFIELD:
 STA S 198+36.96 LT, TH-336 "S,T,O,P" (4 EA)
 STA S 198+36.96 LT, TH-336 "S,T,O,P" (4 EA)
 STA S 198+36.96 LT, TH-336 ARROW (1EA)
 STA S 198+36.96 LT, TH-336 ARROW (1EA)
 STA S 201+24.00 LT, "S,C,H,O,O,L" (16 EA)

REMOVING SIGNS AS SHOWN - 20
ERECTING SALVAGED SIGNS AS SHOWN - 1

TEMPORARY LETTER OR SYMBOL, PAINT
 SPRINGFIELD:
 STA S 198+36.96 LT, TH-336 "S,T,O,P" (8 EA)
 STA S 198+36.96 LT, TH-336 "S,T,O,P" (8 EA)
 STA S 198+36.96 LT, TH-336 ARROW (2 EA)
 STA S 198+36.96 LT, TH-336 ARROW (2 EA)
 STA S 201+24.00 LT, "S,C,H,O,O,L" (12 EA)

DURABLE CROSSWALK MARKING, TYPE A TAPE AND TEMPORARY CROSSWALK MARKING, PAINT
 SPRINGFIELD:
 STA S 198+36.96 LT, TH-336
 STA S 198+63.00 LT/RT

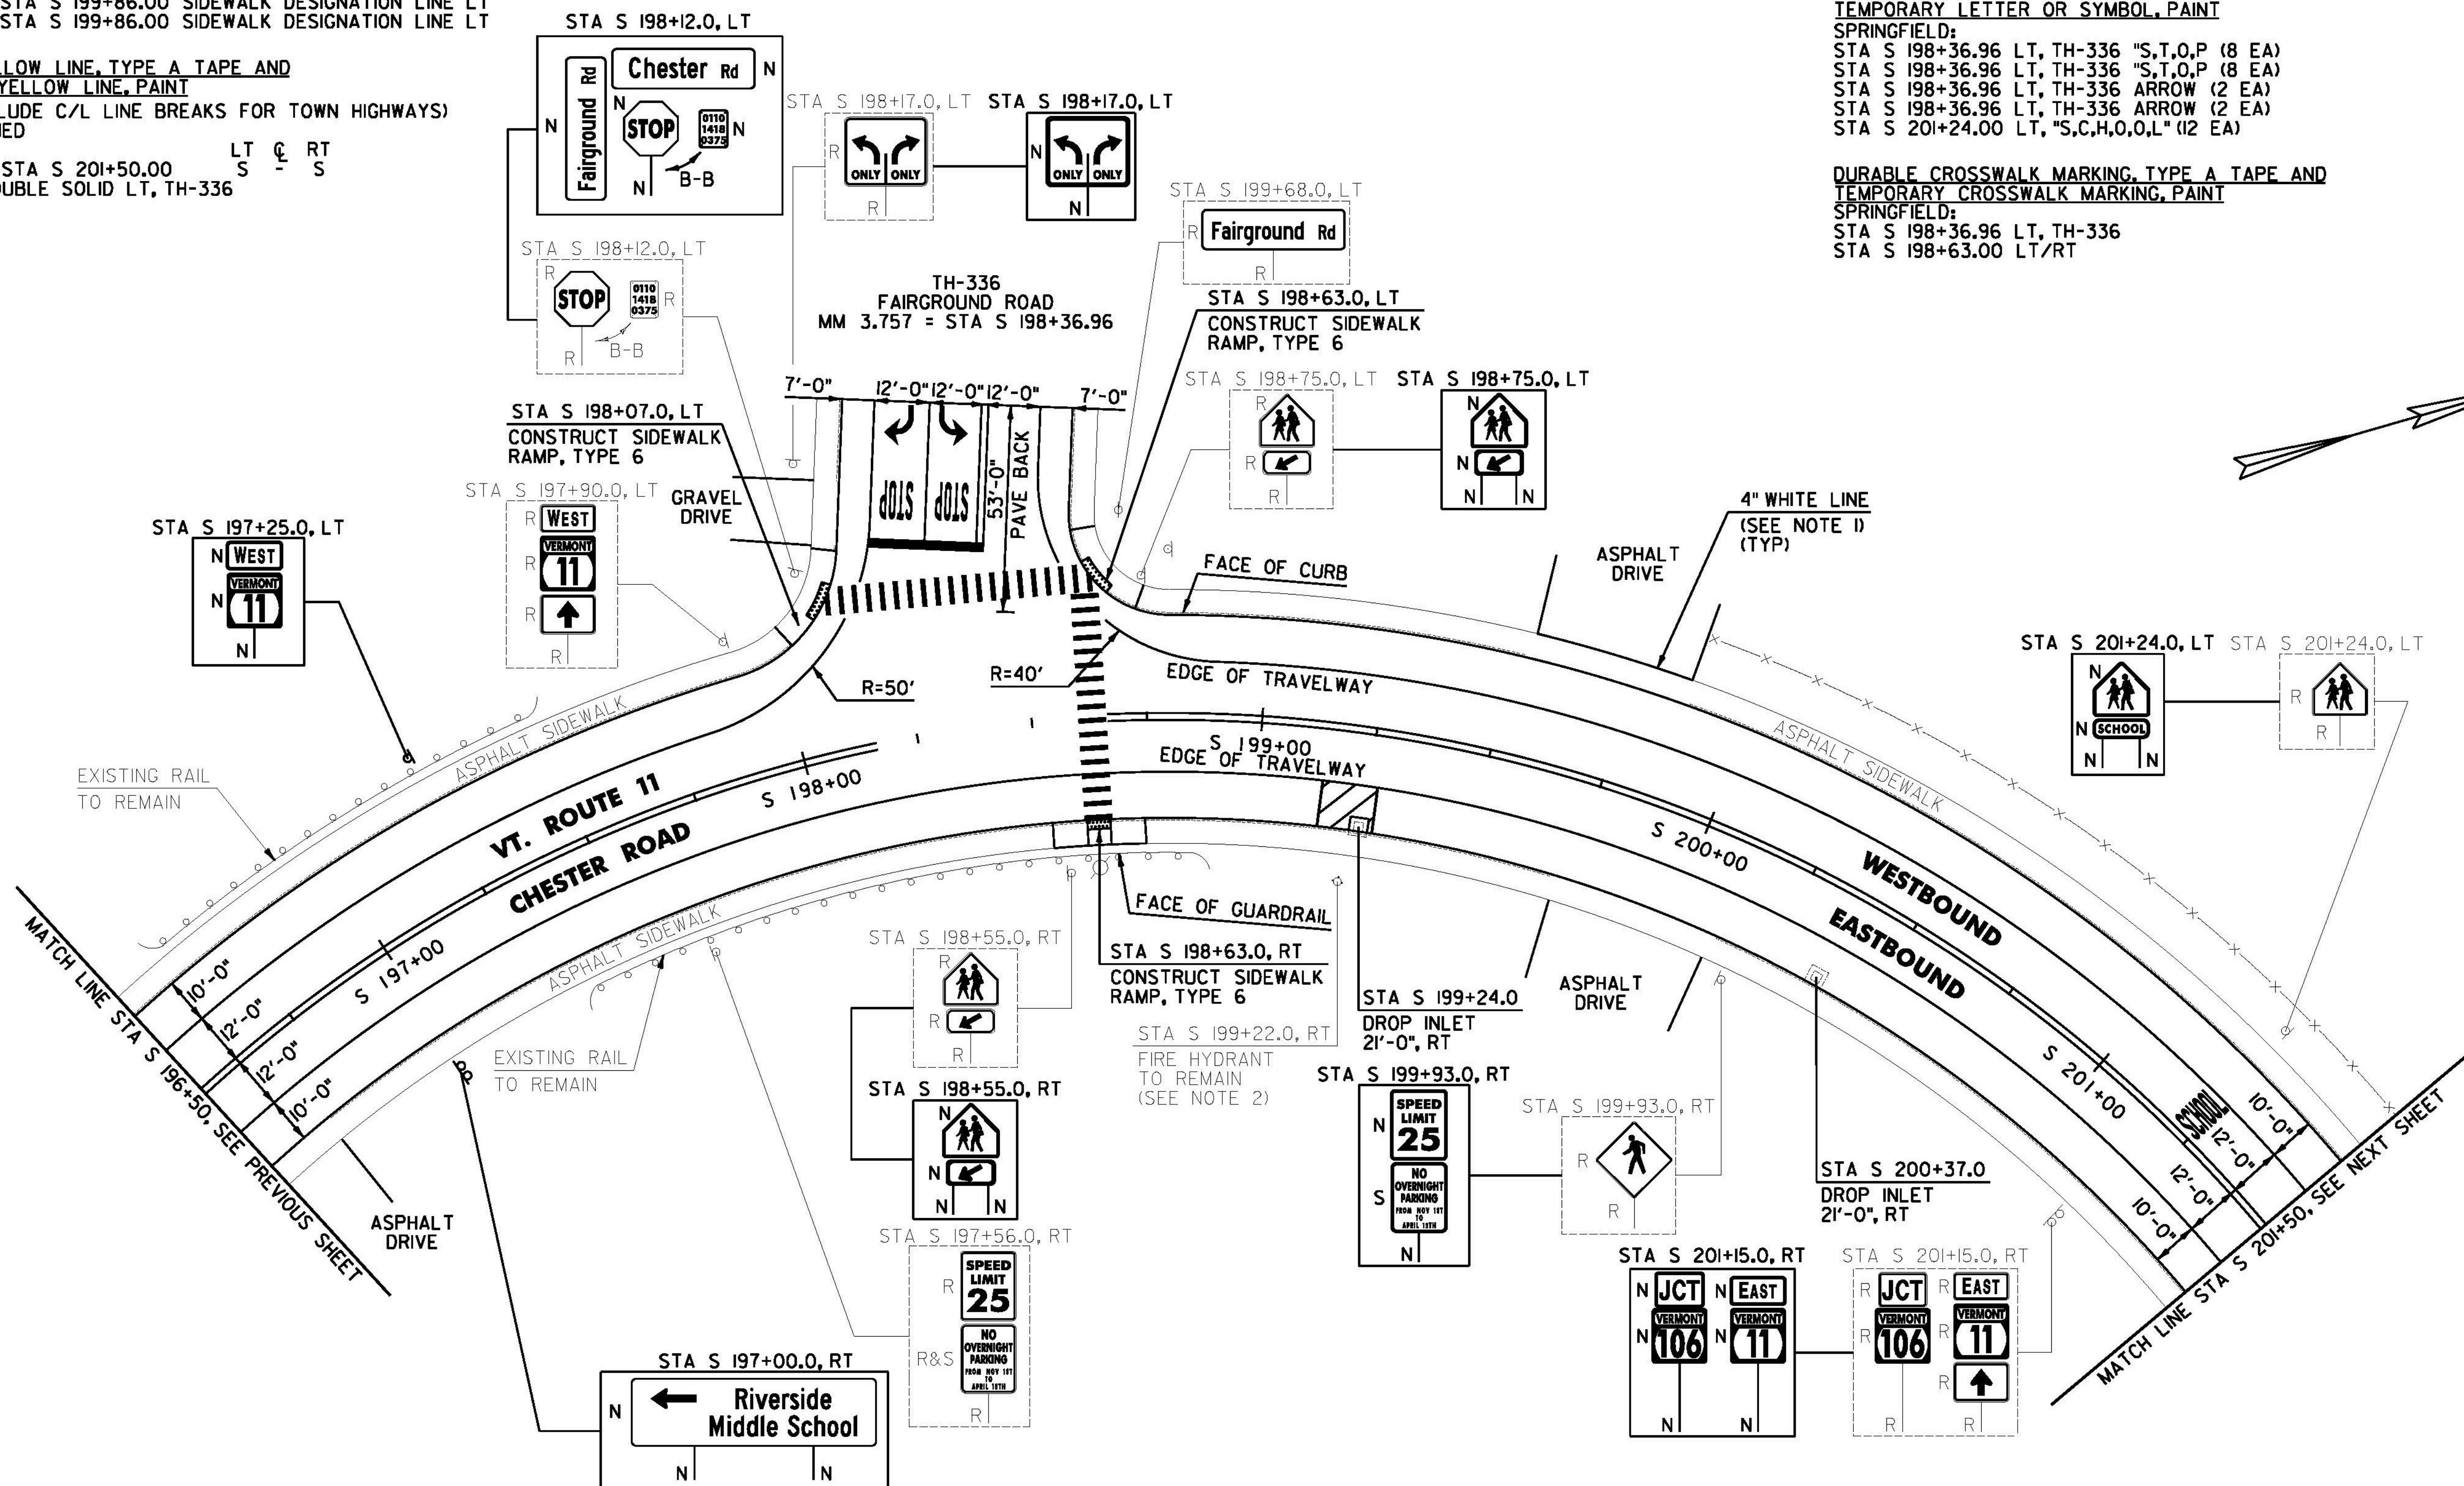

REHAB. DROP INLETS, CATCH BASINS, OR MANHOLES, CLASS I, II, OR III
 SPRINGFIELD:
 STA S 199+24.0 RT
 STA S 200+37.0 RT

CAST-IN-PLACE CONCRETE CURB, TYPE B
 SPRINGFIELD:
 STA S 198+07.0 LT
 STA S 198+63.0 LT
 STA S 198+63.0 RT

PORTLAND CEMENT CONCRETE SIDEWALK, 5 INCH
 SPRINGFIELD:
 STA S 198+07.0 LT
 STA S 198+63.0 LT
 STA S 198+63.0 RT

DETECTABLE WARNING SURFACE
 SPRINGFIELD:
 STA S 198+07.0 LT
 STA S 198+63.0 LT
 STA S 198+63.0 RT

NOTES:
 1. THE CONTRACTOR SHALL PROVIDE 4" WHITE LINES TO CONNECT THE SIDEWALKS ACROSS THE DRIVEWAY AND SEPARATE THE DRIVEWAY AND THE PEDESTRIAN WALKWAY.
 2. SEE SHEET 16 FOR FIRE HYDRANT PAVEMENT MARKING DETAIL.

SIGN LEGEND
 R = REMOVE
 S = SALVAGE
 N = NEW
 RET = RETAIN
 B-B = BACK TO BACK
 EXISTING = _____
 NEW = _____
 R = RETURN TO TOWN OF SPRINGFIELD

NOT TO SCALE
SPRINGFIELD PROJECT LAYOUT SHEET #3

PROJECT NAME: CHESTER-SPRINGFIELD-ROCKINGHAM-WINDSOR
 PROJECT NUMBER: STP 29520

FILE NAME: z13c518bdr_seg02.dgn
 PROJECT LEADER: D. GOZALKOWSKI
 DESIGNED BY: A. HAWKINS

PLOT DATE: 3/27/2015
 DRAWN BY: A. KIRBY
 CHECKED BY: J. SHIELDS
 SHEET 110 OF 309