

DURABLE 4 INCH WHITE LINE, TYPE A TAPE AND TEMPORARY 4 INCH WHITE LINE, PAINT
 (ALL LINES WILL INCLUDE EDGE LINE BREAKS AND RADIUS FOR TOWN HIGHWAYS)

SPRINGFIELD:
 STA S 201+50.00 - STA S 206+50.00 EDGE LINE LT & RT
 STA S 202+78.00 - STA S 205+07.00 DOTTED LANE LINE RT
 STA S 202+78.00 - STA S 205+07.00 DOTTED LANE LINE RT
 STA S 205+07.00 - STA S 206+46.00 SOLID LANE LINE RT
 STA S 205+07.00 - STA S 206+46.00 SOLID LANE LINE RT

DURABLE 4 INCH YELLOW LINE, TYPE A TAPE AND TEMPORARY 4 INCH YELLOW LINE, PAINT
 (ALL LINES WILL INCLUDE C/L LINE BREAKS FOR TOWN HIGHWAYS)

S = SOLID, D = DASHED
 SPRINGFIELD:
 STA S 201+50.00 - STA S 206+47.00 LT & RT
 S - S

DURABLE LETTER OR SYMBOL, TYPE D TAPE
 SPRINGFIELD:

STA S 205+11.00 RT, ARROW (1EA)
 STA S 205+11.00 RT, ARROW (1EA)
 STA S 205+11.00 RT, ARROW (2 EA)
 STA S 205+75.00 RT, "O,N,L,Y" (4 EA)
 STA S 205+75.00 RT, ARROW (2 EA)
 STA S 205+75.00 RT, ARROW (2 EA)
 STA S 206+39.00 RT, ARROW (1EA)
 STA S 206+39.00 RT, ARROW (1EA)
 STA S 206+39.00 RT, ARROW (2 EA)

TEMPORARY LETTER OR SYMBOL, PAINT
 SPRINGFIELD:

STA S 205+11.00 RT, ARROW (2 EA)
 STA S 205+11.00 RT, ARROW (2 EA)
 STA S 205+11.00 RT, ARROW (4 EA)
 STA S 205+75.00 RT, ARROW (4 EA)
 STA S 206+39.00 RT, ARROW (2 EA)
 STA S 206+39.00 RT, ARROW (2 EA)
 STA S 206+39.00 RT, ARROW (4 EA)



DURABLE 24 INCH STOP BAR, TYPE A TAPE AND TEMPORARY 24 INCH STOP BAR, PAINT
 SPRINGFIELD:

STA S 206+47.00 RT

DURABLE CROSSWALK MARKING, TYPE A TAPE
TEMPORARY CROSSWALK MARKING, PAINT
 SPRINGFIELD:

STA S 202+74.00 LT/RT

REMOVING SIGNS AS SHOWN - 16

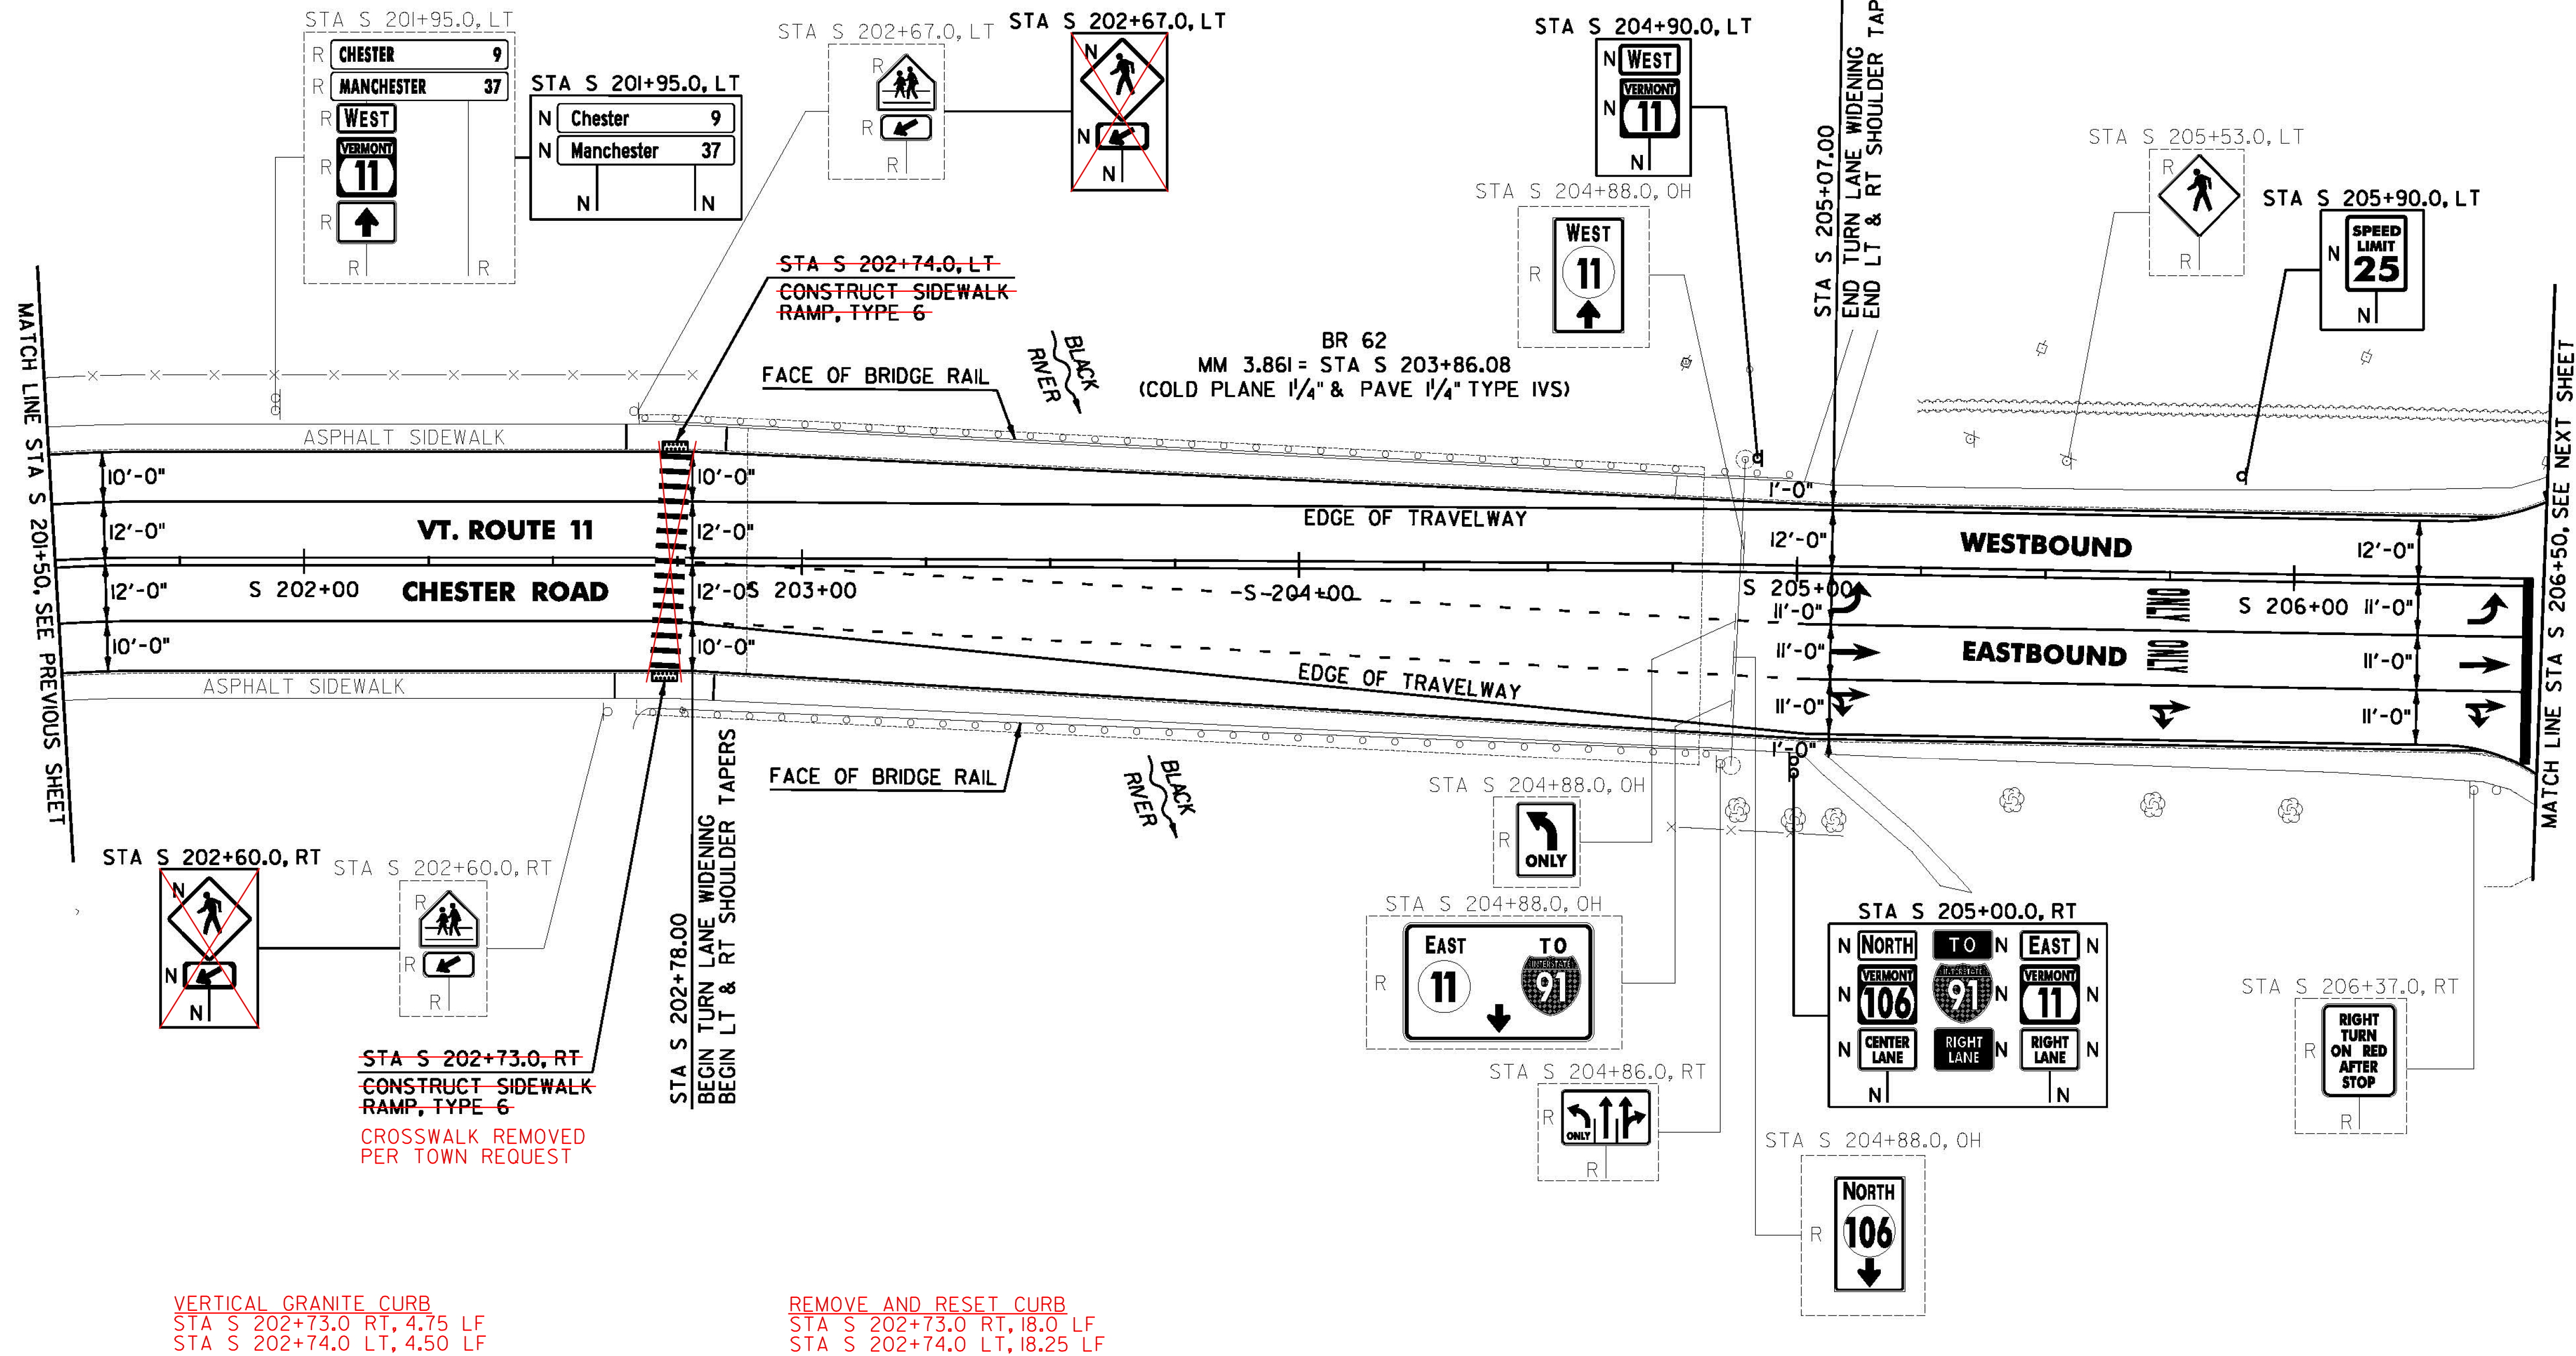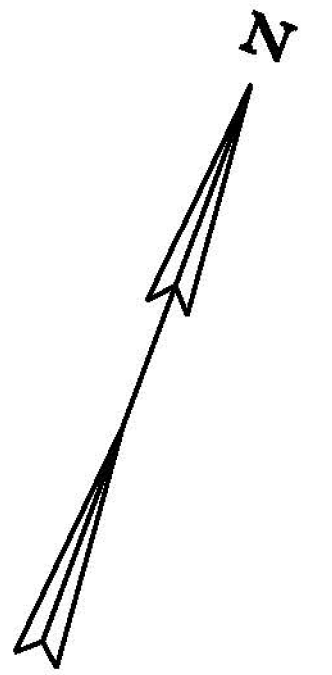

VERTICAL GRANITE CURB
 STA S 202+73.0 RT, 4.75 LF
 STA S 202+74.0 LT, 4.50 LF

CAST-IN-PLACE CONCRETE CURB, TYPE B
 SPRINGFIELD:
 STA S 202+73.0 RT
 STA S 202+74.0 LT

PORTLAND CEMENT CONCRETE SIDEWALK, 5-INCH
 SPRINGFIELD:
 STA S 202+73.0 RT
 STA S 202+74.0 LT

REMOVE AND RESET CURB
 STA S 202+73.0 RT, 18.0 LF
 STA S 202+74.0 LT, 18.25 LF

DETECTABLE WARNING SURFACE
 SPRINGFIELD:
 STA S 202+73.0 RT
 STA S 202+74.0 LT

REMOVE EXISTING OVERHEAD SIGN ASSEMBLY, MULTI-SUPPORT
 SPRINGFIELD:
 STA S 204+88.0 LT/RT

SIGN LEGEND
 R = REMOVE
 S = SALVAGE
 N = NEW
 RET = RETAIN
 B-B = BACK TO BACK
 EXISTING =
 NEW =
 R = RETURN TO TOWN OF SPRINGFIELD

NOT TO SCALE

SPRINGFIELD PROJECT LAYOUT SHEET #4

PROJECT NAME: CHESTER-SPRINGFIELD-ROCKINGHAM-WINDSOR
 PROJECT NUMBER: STP 2952(0)

FILE NAME: z13c518bdr_seg02.dgn
 PROJECT LEADER: D. GOZALKOWSKI
 DESIGNED BY: A. HAWKINS

PLOT DATE: 3/27/2015
 DRAWN BY: A. KIRBY
 CHECKED BY: J. SHIELDS
 SHEET III OF 309