

**DURABLE 4 INCH WHITE LINE, TYPE A TAPE AND TEMPORARY 4 INCH WHITE LINE, PAINT**  
 (ALL LINES WILL INCLUDE EDGE LINE BREAKS AND RADIUS FOR TOWN HIGHWAYS)

**SPRINGFIELD:**  
 STA S 206+50.00 - STA S 211+00.00 EDGE LINE LT & RT  
 STA S 207+39.00 - STA S 209+62.00 SOLID LANE LINE RT  
 STA S 207+40.00 - STA S 208+45.00 SOLID LANE LINE CL  
 STA S 207+40.00 - STA S 208+45.00 SOLID LANE LINE LT  
 STA S 208+45.00 - STA S 209+20.00 DOTTED LANE LINE CL  
 STA S 210+79.00 - STA S 211+00.00 SOLID LANE LINE LT

**DURABLE 4 INCH YELLOW LINE, TYPE A TAPE AND TEMPORARY 4 INCH YELLOW LINE, PAINT**  
 (ALL LINES WILL INCLUDE C/L LINE BREAKS FOR TOWN HIGHWAYS)

**SPRINGFIELD:**  
 STA S 207+38.00 - STA S 210+02.00 MEDIAN EDGE LINE RT  
 STA S 210+75.00 - STA S 211+00.00 MEDIAN EDGE LINE LT/RT

**DURABLE CROSSWALK MARKING, TYPE A TAPE AND TEMPORARY CROSSWALK MARKING, PAINT**

**SPRINGFIELD:**  
 STA S 206+55.00 LT/RT  
 STA S 206+58.00 - STA S 207+28.00 LT  
 STA S 206+60.00 - STA S 207+30.00 RT  
 STA S 207+34.00 LT/RT  
 STA S 210+17.00 RT  
 STA S 210+67.00 LT/RT

**DURABLE 24 INCH STOP BAR, TYPE A TAPE AND TEMPORARY 24 INCH STOP BAR, PAINT**

**SPRINGFIELD:**  
 STA S 207+40.00 LT/RT  
 STA S 210+09.00 RT  
 STA S 210+10.00 RT  
 STA S 210+79.00 LT

**PAINTED CURB**

**SPRINGFIELD:**  
 STA S 207+38.00 - STA S 207+68.00 RT (60.0 LF)  
 STA S 208+15.00 - STA S 208+75.00 RT (60.0 LF)  
 STA S 208+86.00 - STA S 209+46.00 RT (60.0 LF)  
 STA S 208+94.00 LT (60.0 LF)  
 STA S 209+71.00 LT (60.0 LF)  
 STA S 210+02.00 RT (60.0 LF)  
 STA S 209+63.00 RT (60.0 LF)  
 STA S 209+96.00 RT (60.0 LF)  
 STA S 210+24.00 RT (60.0 LF)  
 STA S 210+76.00 - STA S 211+00.00 LT/RT (48.0 LF)

**DURABLE 8 INCH WHITE LINE, TYPE A TAPE**

**SPRINGFIELD:**  
 STA S 209+62.00 - STA S 210+11.00 HATCHED GORE AREA RT  
 STA S 210+20.00 - STA S 211+00.00 HATCHED AREA LT/RT


**TEMPORARY LETTER OR SYMBOL, PAINT**

**SPRINGFIELD:**  
 STA S 207+43.0 RT, ARROW (2 EA)  
 STA S 207+48.0 LT, ARROW (2 EA)  
 STA S 207+48.0 LT, ARROW (2 EA)  
 STA S 207+48.0 RT, ARROW (2 EA)  
 STA S 207+94.5 LT, ARROW (2 EA)  
 STA S 208+41.0 LT, ARROW (2 EA)  
 STA S 208+41.0 LT, ARROW (2 EA)  
 STA S 208+41.0 RT, ARROW (2 EA)  
 STA S 208+50.0 RT, ARROW (2 EA)  
 STA S 209+58.0 RT, ARROW (2 EA)  
 STA S 210+88.0 LT, ARROW (4 EA)

**DURABLE LETTER OR SYMBOL, TYPE D TAPE**

**SPRINGFIELD:**  
 STA S 207+43.0 RT, ARROW (1EA)  
 STA S 207+48.0 LT, ARROW (1EA)  
 STA S 207+48.0 LT, ARROW (1EA)  
 STA S 207+48.0 RT, ARROW (1EA)  
 STA S 207+94.5 LT, ARROW (1EA)  
 STA S 207+94.5 LT, "O.N.L.Y." (4 EA)  
 STA S 207+94.5 RT, "O.N.L.Y." (4 EA)  
 STA S 207+96.0 RT, "O.N.L.Y." (4 EA)  
 STA S 208+41.0 LT, ARROW (1EA)  
 STA S 208+41.0 RT, ARROW (1EA)  
 STA S 208+50.0 RT, ARROW (1EA)  
 STA S 209+04.0 RT, "O.N.L.Y." (4 EA)  
 STA S 209+58.0 RT, ARROW (1EA)  
 STA S 210+88.0 LT, ARROW (1EA)  
 STA S 210+88.0 LT, ARROW (2 EA)

**REMOVING SIGNS AS SHOWN - 38**

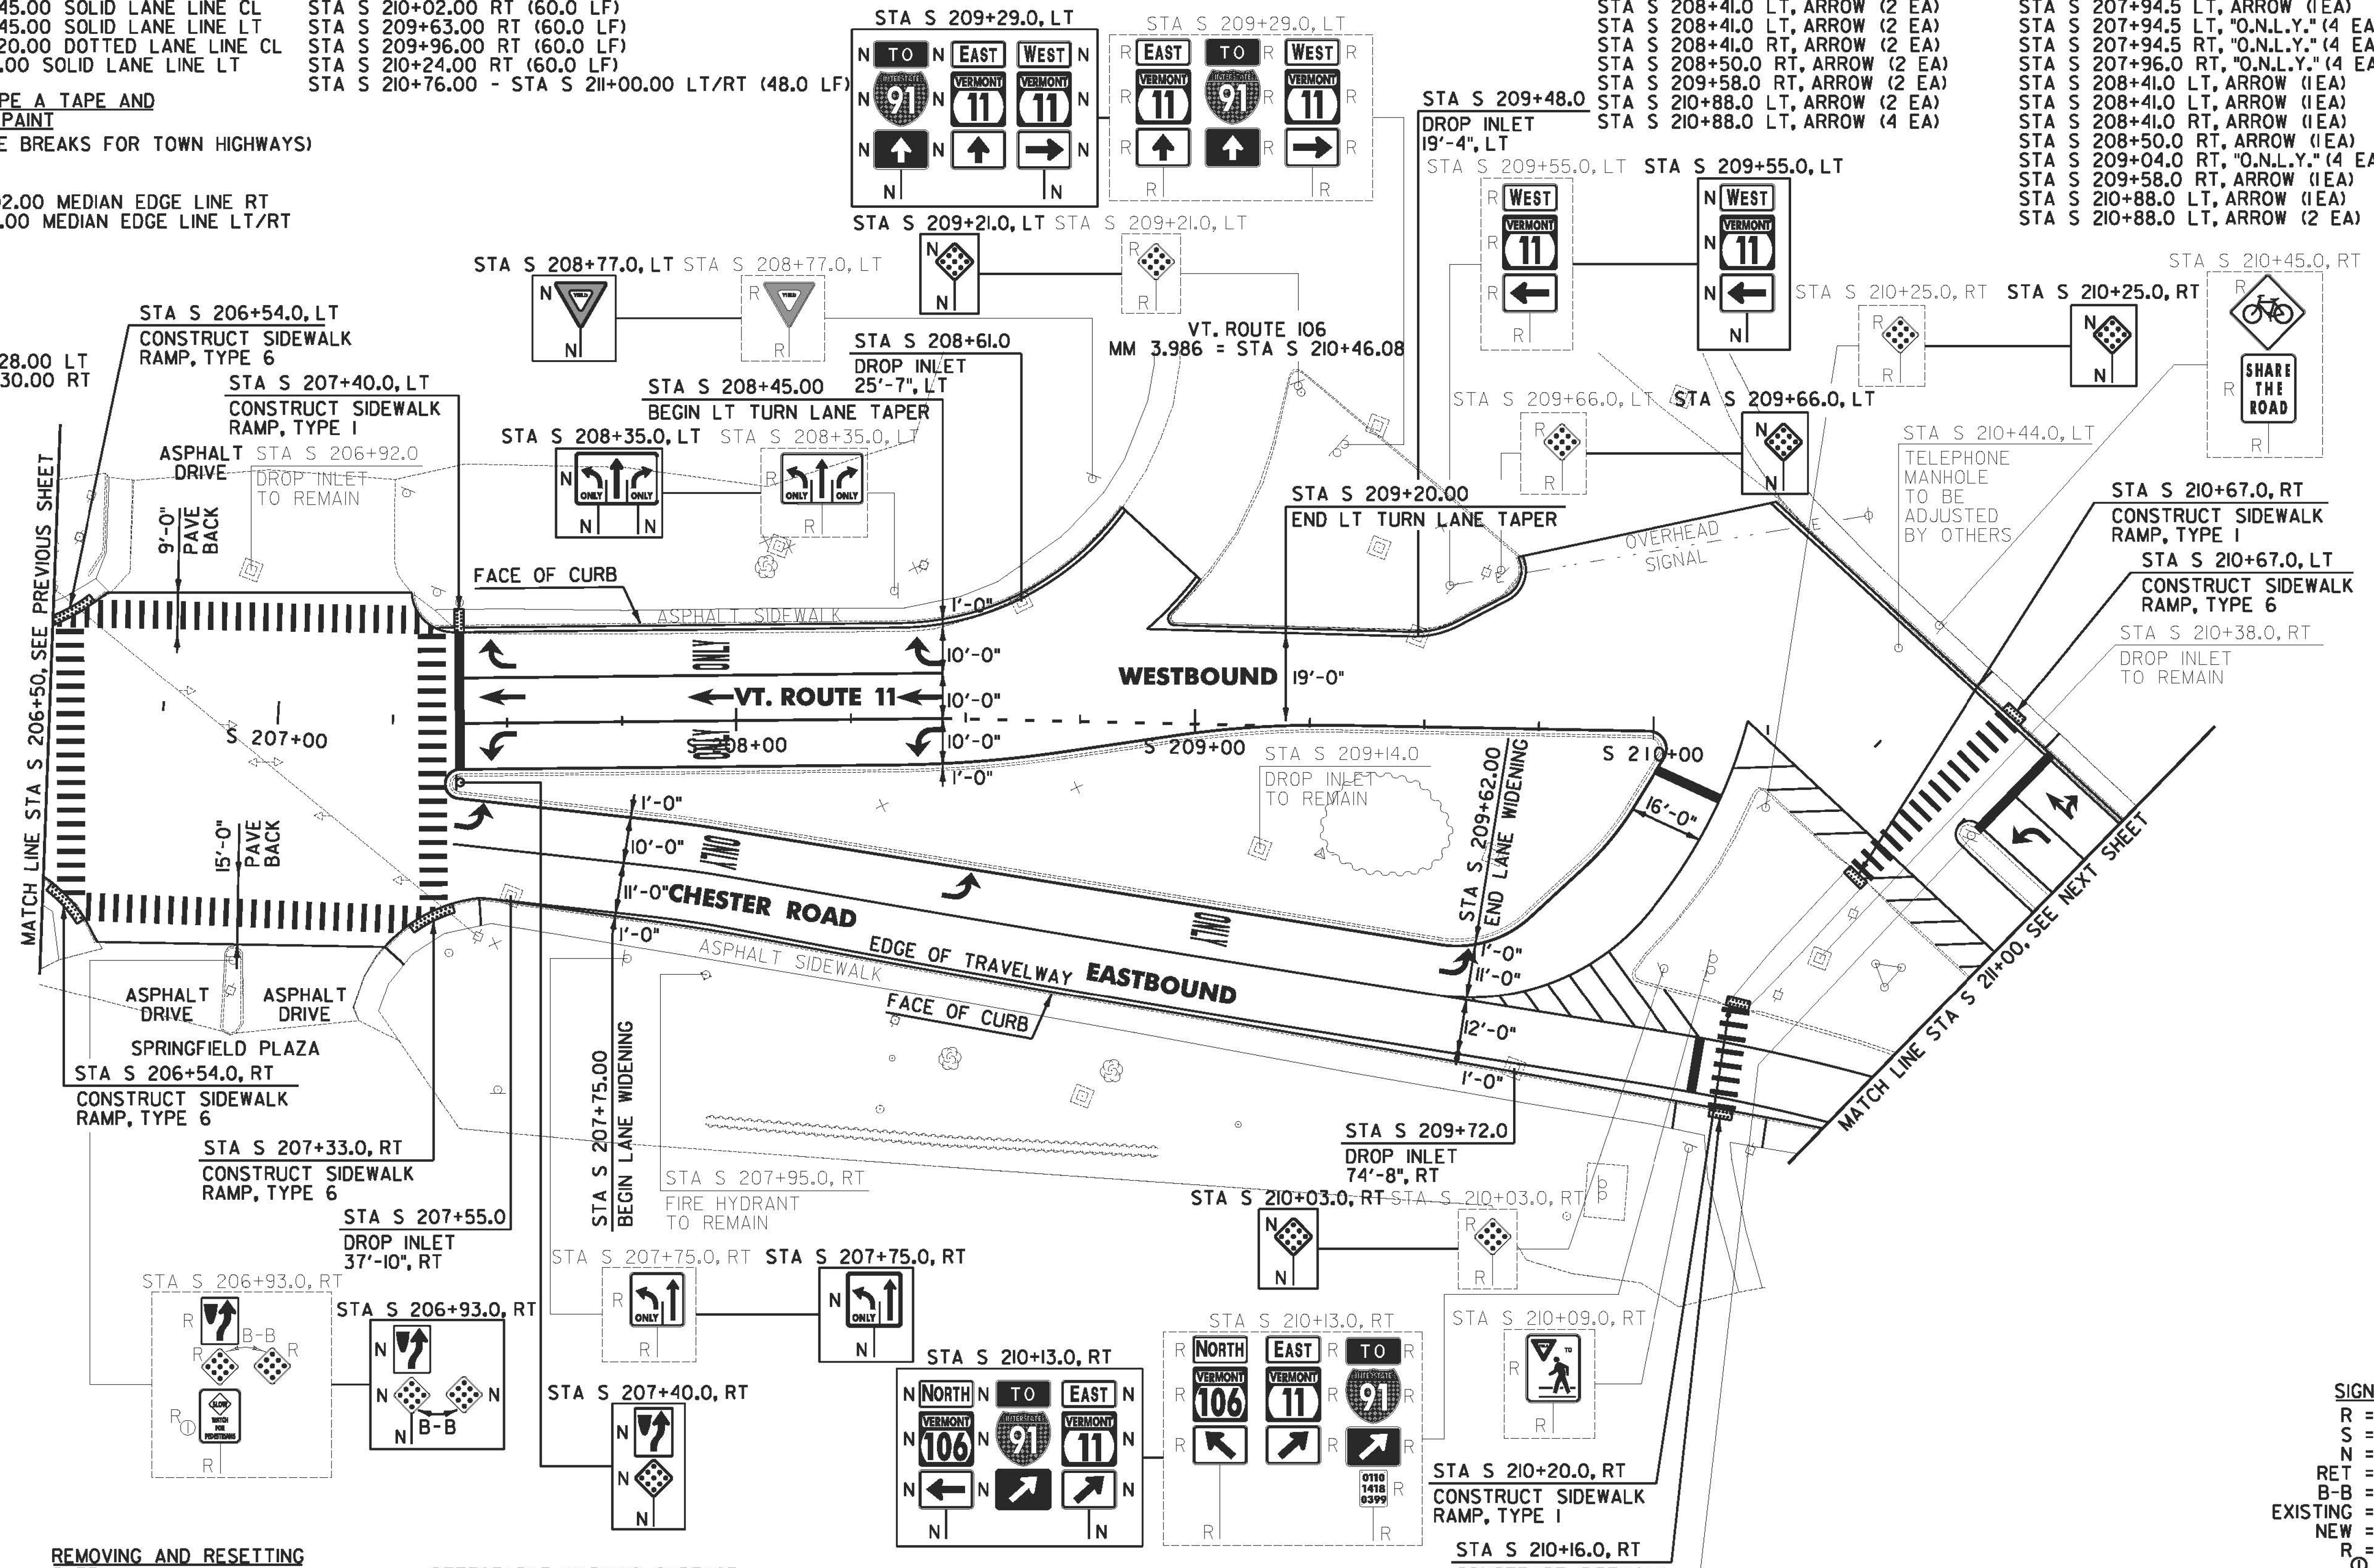

**PORTLAND CEMENT CONCRETE SIDEWALK, 5 INCH**

**SPRINGFIELD:**  
 STA S 206+54.0 LT  
 STA S 206+54.0 RT  
 STA S 207+33.0 RT  
 STA S 207+40.0 LT  
 STA S 210+16.0 RT  
 STA S 210+20.0 RT  
 STA S 210+67.0 RT  
 STA S 210+67.0 LT

**REMOVING AND RESETTING CURB**

**SPRINGFIELD:**  
 STA S 206+54.0 LT  
 STA S 206+54.0 RT  
 STA S 207+33.0 RT  
 STA S 207+40.0 LT  
 STA S 210+16.0 RT  
 STA S 210+20.0 RT  
 STA S 210+67.0 RT  
 STA S 210+67.0 LT

**DETECTABLE WARNING SURFACE**

**SPRINGFIELD:**  
 STA S 206+54.0 LT  
 STA S 206+54.0 RT  
 STA S 207+33.0 RT  
 STA S 207+40.0 LT  
 STA S 210+16.0 RT  
 STA S 210+20.0 RT  
 STA S 210+67.0 RT  
 STA S 210+67.0 LT

**REHAB. DROP INLETS, CATCH BASINS, OR MANHOLES, CLASS I, II, OR III**

**SPRINGFIELD:**  
 STA S 207+55.0 RT  
 STA S 208+61.0 LT  
 STA S 209+48.0 LT  
 STA S 209+72.0 RT

**NOT TO SCALE**

**SPRINGFIELD PROJECT LAYOUT SHEET #5**

**PROJECT NAME:** CHESTER-SPRINGFIELD-ROCKINGHAM-WINDSOR

**PROJECT NUMBER:** STP 2952(I)

**FILE NAME:** z13c518bdr\_seg02.dgn  
**PROJECT LEADER:** D. GOZALKOWSKI  
**DESIGNED BY:** A. HAWKINS

**PLOT DATE:** 3/27/2015  
**DRAWN BY:** A. KIRBY  
**CHECKED BY:** J. SHIELDS  
**SHEET 112 OF 309**

SEE SHEET 112 A