

DURABLE 4 INCH WHITE LINE, TYPE A TAPE AND TEMPORARY 4 INCH WHITE LINE, PAINT
 (ALL LINES WILL INCLUDE EDGE LINE BREAKS AND RADIUS FOR TOWN HIGHWAYS)
 SPRINGFIELD:
 STA R 0+49.00 - STA R 2+67.24 EDGE LINE RT
 STA R 0+58.08 EDGE LINES RT, EATON AVENUE
 STA R 0+80.00 - STA R 2+11.00 EDGE LINE LT
 STA R 1+33.00 - STA R 1+34.00 EXIT EDGE LINE LT
 STA R 1+45.00 - STA R 2+11.00 EXIT EDGE LINE LT
 STA R 1+61.00 - STA R 2+67.24 EXIT EDGE LINE LT
 STA R 2+11.00 - STA R 2+67.24 SOLID LANE LINE LT

DURABLE 8 INCH WHITE LINE, TYPE A TAPE
 SPRINGFIELD:
 STA R 0+80.00 - STA R 2+07.00 HATCHED GORE AREA LT

DURABLE 24 INCH STOP BAR, TYPE A TAPE AND TEMPORARY 24 INCH STOP BAR, PAINT
 SPRINGFIELD:
 STA R 0+58.08 RT, EATON AVENUE
 STA R 1+22.00 LT


DURABLE 4 INCH YELLOW LINE, TYPE A TAPE AND TEMPORARY 4 INCH YELLOW LINE, PAINT
 (ALL LINES WILL INCLUDE C/L LINE BREAKS FOR TOWN HIGHWAYS)
 S = SOLID, D = DASHED
 SPRINGFIELD:
 STA R 1+21.00 - STA R 2+67.24 LT & RT
 STA R 0+58.08 DOUBLE SOLID RT, EATON AVENUE
 STA R 1+33.00 - STA R 1+45.00 EXIT EDGE LINE LT

DURABLE LETTER OR SYMBOL, TYPE D TAPE
 SPRINGFIELD:
 STA R 1+33.50 LT, ARROWS (2 EA)
 STA R 1+42.00 LT, YIELD LINE (5 EA)
 STA R 1+97.00 LT, ARROWS (2 EA)
 STA R 2+15.00 LT, ARROW (1 EA)
 STA R 2+60.50 LT, ARROWS (2 EA)
 STA R 2+63.00 LT, ARROW (1 EA)

TEMPORARY LETTER OR SYMBOL, PAINT
 SPRINGFIELD:
 STA R 1+33.50 LT, ARROWS (4 EA)
 STA R 1+42.00 LT, YIELD LINE (10 EA)
 STA R 1+97.00 LT, ARROWS (4 EA)
 STA R 2+15.00 LT, ARROW (2 EA)
 STA R 2+60.50 LT, ARROWS (4 EA)
 STA R 2+63.00 LT, ARROW (2 EA)

DURABLE CROSSWALK MARKING, TYPE A TAPE AND TEMPORARY CROSSWALK MARKING, PAINT
 SPRINGFIELD:
 STA R 0+58.08 RT, EATON AVENUE
REMOVING SIGNS
 AS SHOWN - 2

*VERMONT ROUTE 106
 EXTENSION ADDED 5/24/2016
 BY PROJECT MANAGER,
 MICHAEL FOWLER

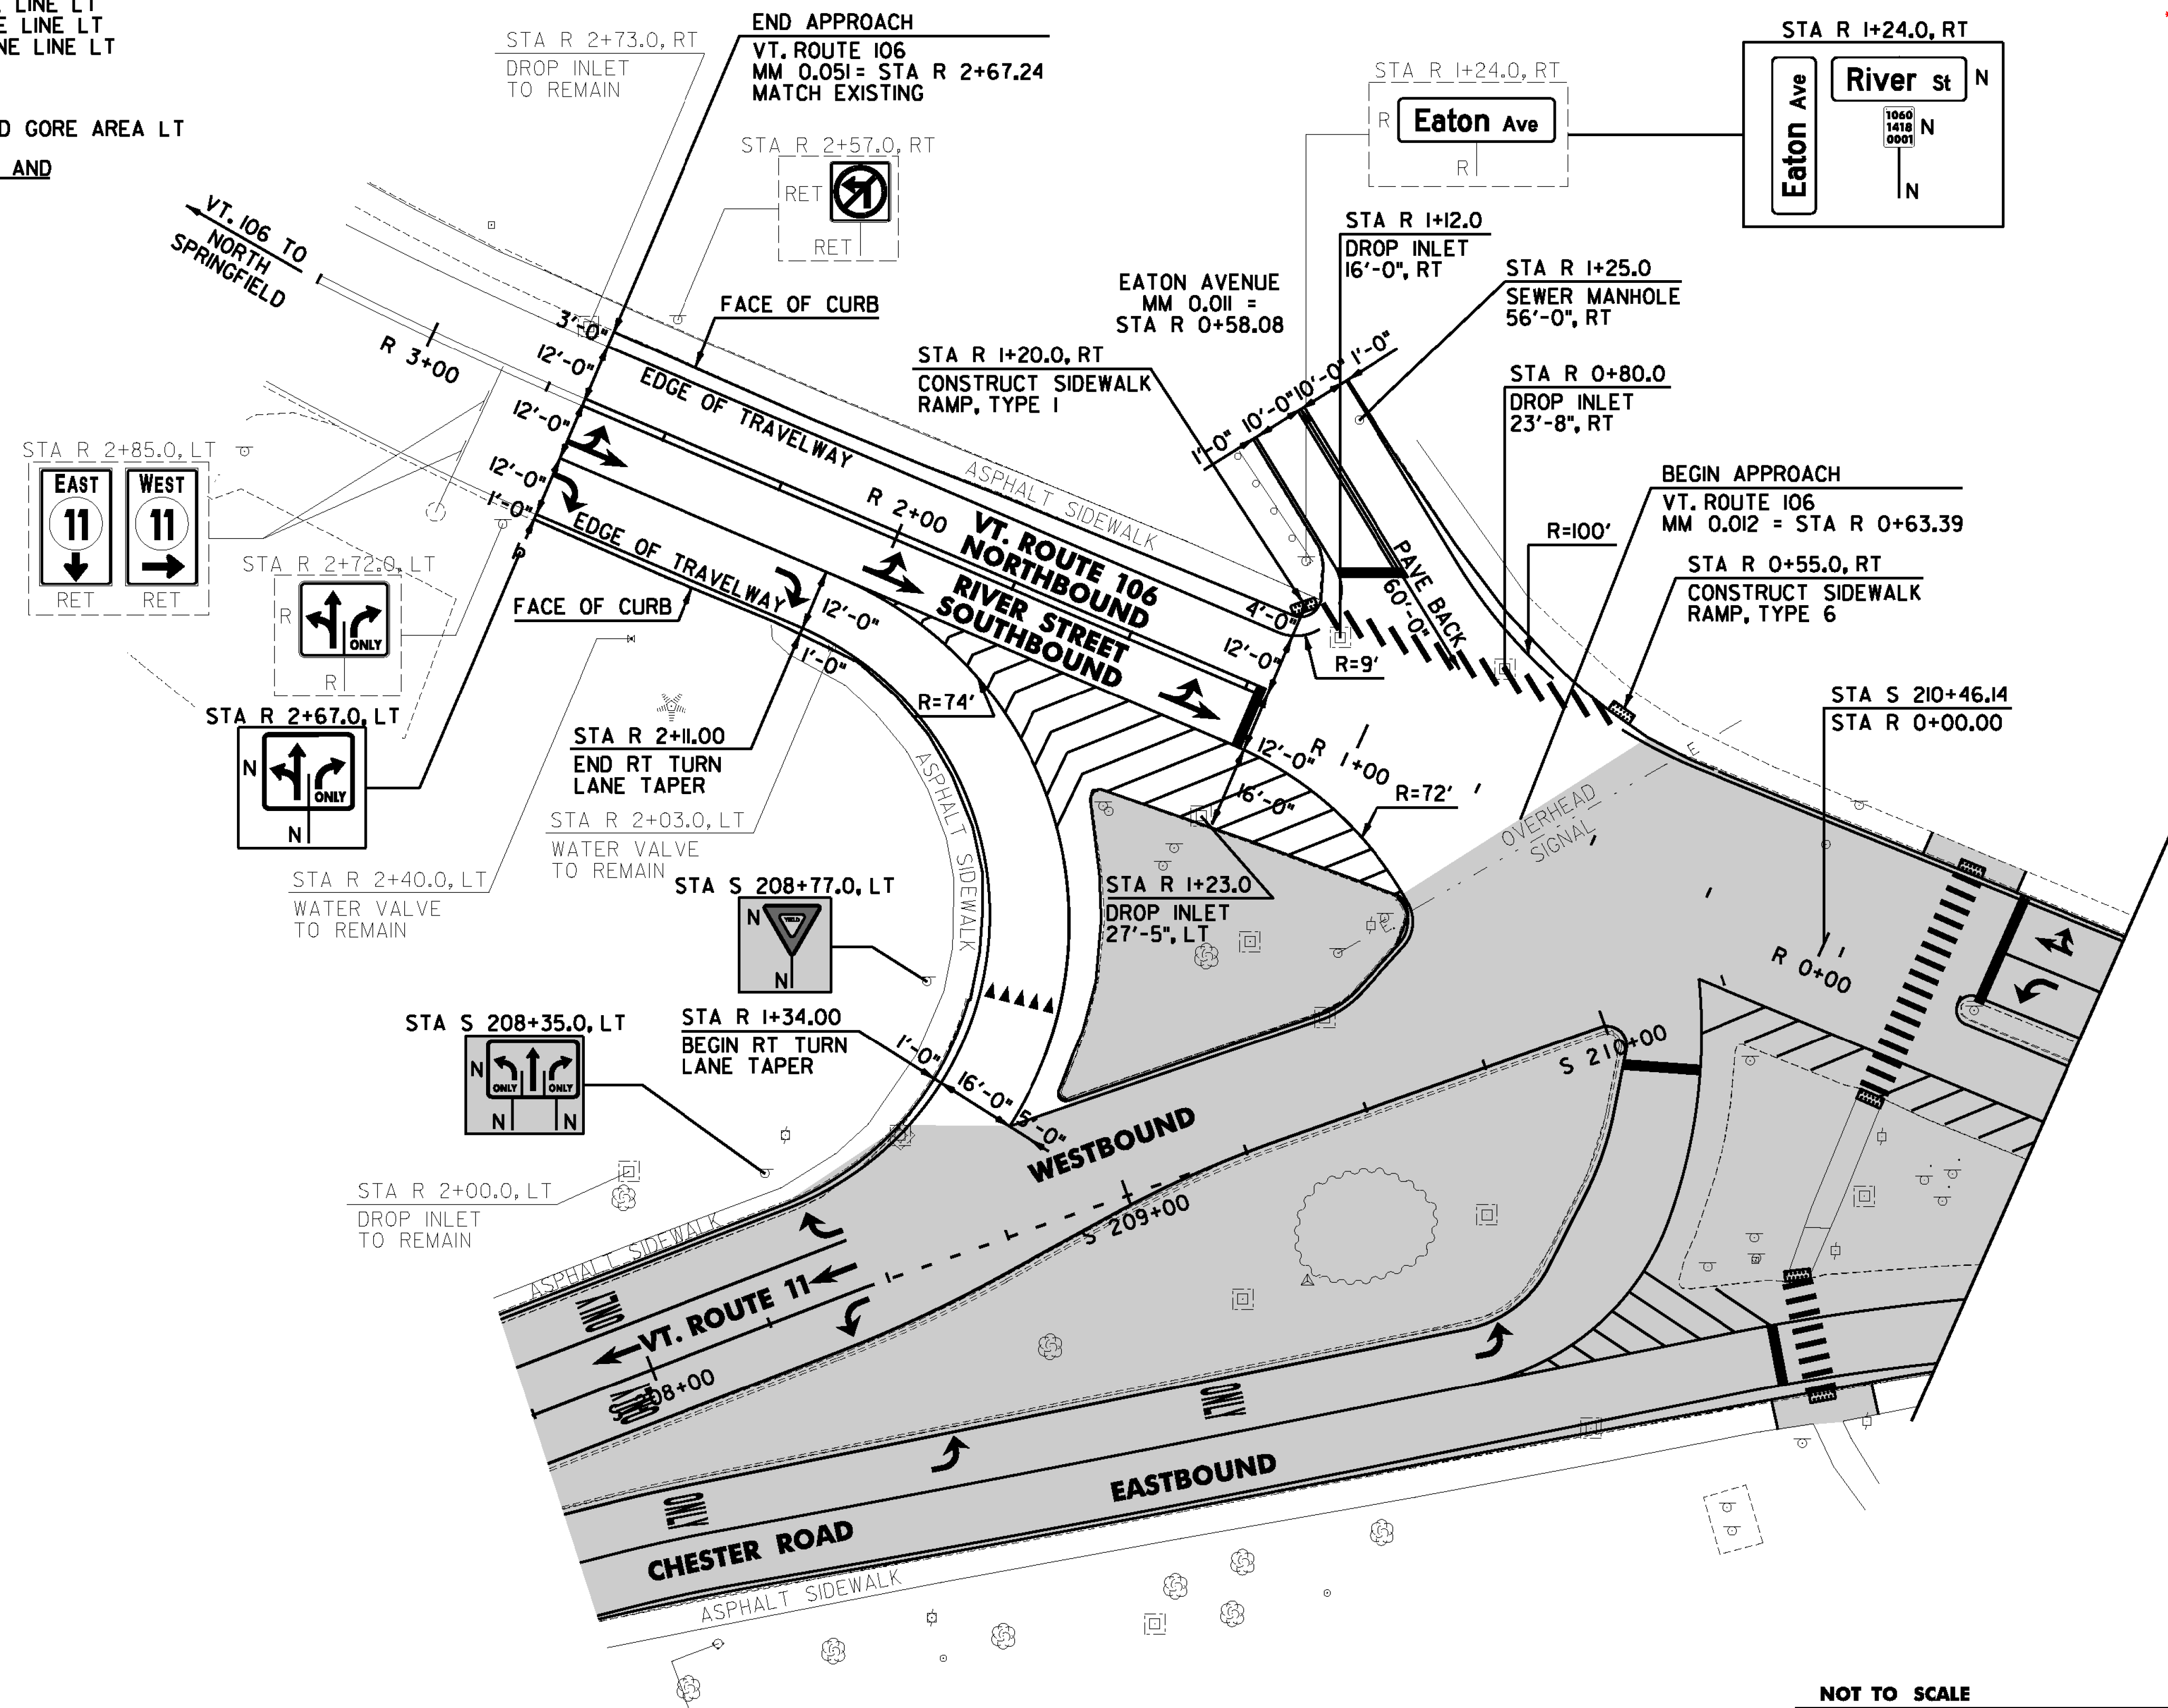

CHANGING ELEVATION OF SEWER MANHOLES
 SPRINGFIELD:
 STA R 1+25.0 RT

REHAB. DROP INLETS, CATCH BASINS, OR MANHOLES, CLASS I, II, OR III
 SPRINGFIELD:
 STA R 0+80.0 RT
 STA R 1+12.0 RT
 STA R 1+23.0 LT

PAINTED CURB
 SPRINGFIELD:
 STA R 1+44.00 LT (60.0 LF)

DETECTABLE WARNING SURFACE
 SPRINGFIELD:
 STA R 0+55.0 RT
 STA R 1+20.0 RT

REMOVING AND RESETTING CURB
 SPRINGFIELD:
 STA R 0+55.0 RT
 STA R 1+20.0 RT

PORTLAND CEMENT CONCRETE SIDEWALK, 5 INCH
 SPRINGFIELD:
 STA R 0+55.0 RT
 STA R 1+20.0 RT

TO BE CONSTRUCTED PER
 SPRINGFIELD PROJECT
 LAYOUT SHEET #5

NOT TO SCALE

**VT. ROUTE 106
 PROJECT
 LAYOUT
 SHEET**

PROJECT NAME: CHESTER-SPRINGFIELD-ROCKINGHAM-WINDSOR
 PROJECT NUMBER: STP 2952(1)

FILE NAME: z13c518mdt05.dgn
 PROJECT LEADER: D. GOZALKOWSKI
 DESIGNED BY: A. HAWKINS

PLOT DATE: 5/24/2016
 DRAWN BY: A. KIRBY
 CHECKED BY: J. SHIELDS
 SHEET 1 OF 4