

DURABLE 4 INCH WHITE LINE, TYPE A TAPE AND TEMPORARY 4 INCH WHITE LINE, PAINT
 (ALL LINES WILL INCLUDE EDGE LINE BREAKS AND RADIUS FOR TOWN HIGHWAYS)
 SPRINGFIELD:
 STA S 211+00.00 - STA S 211+75.00 SOLID LANE LINE LT
 STA S 211+00.00 - STA S 215+25.00 EDGE LINE LT & RT
 STA S 211+75.00 - STA S 213+55.00 DOTTED LANE LINE LT

DURABLE 4 INCH YELLOW LINE, TYPE A TAPE AND TEMPORARY 4 INCH YELLOW LINE, PAINT
 (ALL LINES WILL INCLUDE C/L LINE BREAKS FOR TOWN HIGHWAYS)
 S = SOLID, D = DASHED
 SPRINGFIELD:
 STA S 215+25.00 - STA S 216+50.00 LT & RT
 STA S 211+00.00 - STA S 212+92.00 MEDIAN EDGE LINE LT/RT
 STA S 212+92.00 - STA S 215+25.00 DOUBLE SOLID MEDIAN LT/RT

DURABLE 8 INCH WHITE LINE, TYPE A TAPE
 SPRINGFIELD:
 STA S 211+00.00 - STA S 211+98.00 HATCHED AREA RT
 STA S 214+48.00 - STA S 214+60.00 LT, FIRE HYDRANT, NO PARKING


DURABLE 8 INCH YELLOW LINE, TYPE A TAPE
 SPRINGFIELD:
 STA S 212+92.00 - STA S 215+25.00 HATCHED MEDIAN LT/RT

DURABLE 6 INCH WHITE LINE, TYPE A TAPE AND TEMPORARY 6 INCH WHITE LINE, PAINT
 SPRINGFIELD:
 STA S 215+25.00 - STA S 216+50.00 BIKE LANE EDGE LINE LT & RT

DURABLE LETTER OR SYMBOL, TYPE D TAPE
 SPRINGFIELD:
 STA S 211+33.5 LT, "O,N,L,Y" (4 EA)
 STA S 211+33.5 LT, ARROW (2 EA)
 STA S 211+79.0 LT, ARROW (1EA)
 STA S 211+79.0 LT, ARROW (2 EA)
 STA S 211+68.0 RT, YIELD LINE (4 EA)
 STA S 215+70.0 RT, BIKE LANE SYMBOL (1EA)

TEMPORARY LETTER OR SYMBOL, PAINT
 SPRINGFIELD:
 STA S 211+33.5 LT, ARROW (4 EA)
 STA S 211+79.0 LT, ARROW (2 EA)
 STA S 211+79.0 LT, ARROW (4 EA)
 STA S 211+68.0 RT, YIELD LINE (8 EA)

REMOVING SIGNS AS SHOWN - 39
ERECTING SALVAGED SIGNS AS SHOWN - 1

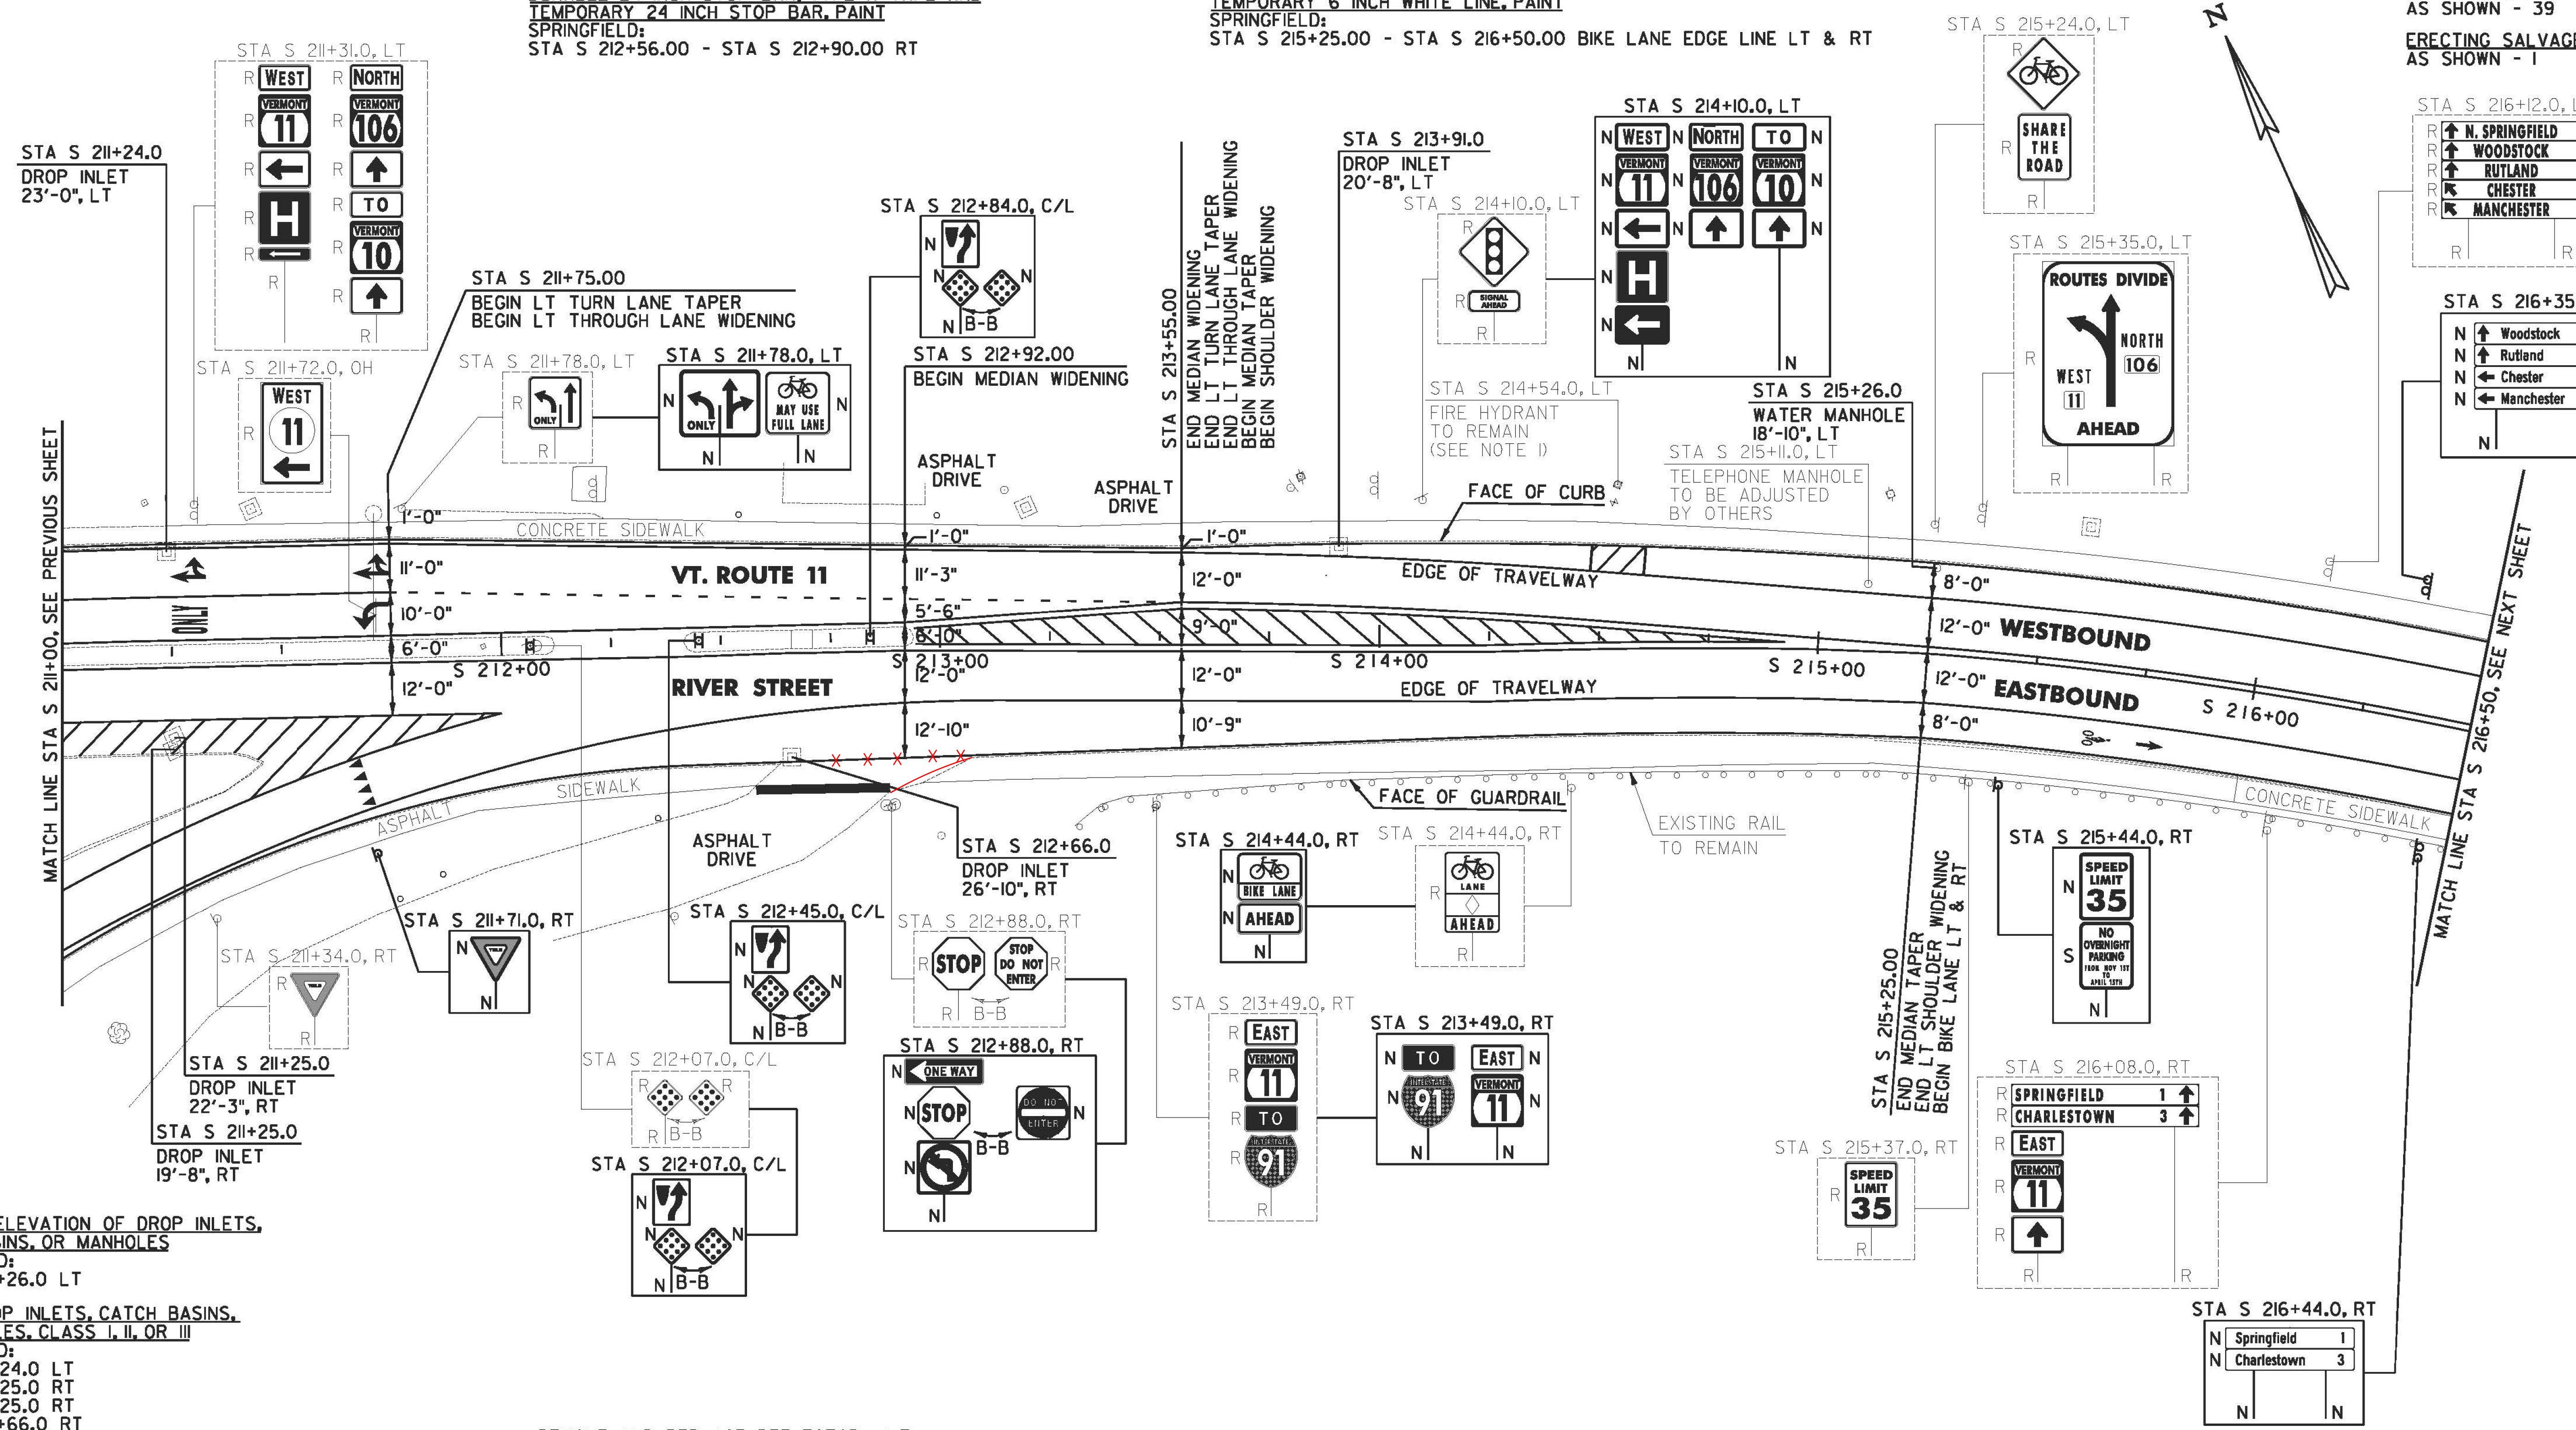

CHANGING ELEVATION OF DROP INLETS, CATCH BASINS, OR MANHOLES
 SPRINGFIELD:
 STA S 215+26.0 LT

REHAB. DROP INLETS, CATCH BASINS, OR MANHOLES, CLASS I, II, OR III
 SPRINGFIELD:
 STA S 211+24.0 LT
 STA S 211+25.0 RT
 STA S 211+25.0 RT
 STA S 212+66.0 RT
 STA S 213+91.0 LT

PAINTED CURB
 SPRINGFIELD:
 STA S 211+00.00 - STA S 211+06.00 LT/RT (12.0 LF)
 STA S 211+45.00 RT (60.0 LF)
 STA S 211+82.00 - STA S 212+12.00 LT/RT (60.0 LF)
 STA S 212+42.00 - STA S 212+94.00 LT/RT (104.0 LF)

REMOVE EXISTING OVERHEAD SIGN ASSEMBLY, CANTILEVER
 SPRINGFIELD:
 STA S 211+72.0 LT

REMOVE AND REPLACE REFLECTOR UNIT
 SPRINGFIELD:
 STA S 213+45.0 RT
 STA S 213+76.3 RT
 STA S 214+07.5 RT
 STA S 214+38.8 RT
 STA S 214+70.0 RT
 STA S 215+01.3 RT
 STA S 215+32.5 RT
 STA S 215+63.8 RT
 STA S 215+95.0 RT
 STA S 216+26.3 RT

NOTE:
 1. SEE SHEET 16 FOR FIRE HYDRANT PAVEMENT MARKING DETAIL.

SIGN LEGEND
 R = REMOVE
 S = SALVAGE
 N = NEW
 RET = RETAIN
 B-B = BACK TO BACK
 EXISTING = _____
 NEW = _____
 R = RETURN TO TOWN OF SPRINGFIELD

NOT TO SCALE
SPRINGFIELD PROJECT LAYOUT SHEET #6

PROJECT NAME: CHESTER-SPRINGFIELD-ROCKINGHAM-WINDSOR
PROJECT NUMBER: STP 2952(1)
FILE NAME: z13c518bdr_seg02.dgn
PROJECT LEADER: D. GOZALKOWSKI
DESIGNED BY: A. HAWKINS

PLOT DATE: 3/27/2015
DRAWN BY: A. KIRBY
CHECKED BY: J. SHIELDS
SHEET 113 OF 309