

**DURABLE 6 INCH WHITE LINE, TYPE A TAPE AND TEMPORARY 6 INCH WHITE LINE, PAINT**  
 (ALL LINES WILL INCLUDE EDGE LINE BREAKS AND RADIUS FOR TOWN HIGHWAYS)  
 SPRINGFIELD:  
 STA S 226+50.00 - STA S 231+50.00 BIKE LANE EDGE LINE LT & RT

**DURABLE 4 INCH YELLOW LINE, TYPE A TAPE AND TEMPORARY 4 INCH YELLOW LINE, PAINT**  
 (ALL LINES WILL INCLUDE C/L LINE BREAKS FOR TOWN HIGHWAYS)  
 S = SOLID, D = DASHED  
 SPRINGFIELD:  
 STA S 226+50.00 - STA S 231+50.00 LT & RT  
 STA S 229+15.20 DOUBLE SOLID LT, TH-325

**DURABLE 4 INCH WHITE LINE, TYPE A TAPE AND TEMPORARY 4 INCH WHITE LINE, PAINT**  
 (ALL LINES WILL INCLUDE EDGE LINE BREAKS AND RADIUS FOR TOWN HIGHWAYS)  
 SPRINGFIELD:  
 STA S 229+15.20 EDGE LINES LT, TH-325

**DURABLE LETTER OR SYMBOL, TYPE D TAPE**  
 SPRINGFIELD:  
 STA S 229+15.20 LT, TH-325 "S,T,O,P" (4 EA)  
 STA S 228+33.0 LT, BIKE LANE SYMBOL (1EA)  
 STA S 229+70.0 RT, BIKE LANE SYMBOL (1EA)


**TEMPORARY LETTER OR SYMBOL, PAINT**  
 SPRINGFIELD:  
 STA S 229+15.20 LT, TH-325 "S,T,O,P" (8 EA)

**DURABLE CROSSWALK MARKING, TYPE A TAPE AND TEMPORARY CROSSWALK MARKING, PAINT**  
 SPRINGFIELD:  
 STA S 229+15.20 LT, TH-325  
 STA S 230+54.0 LT/RT  
 229+04.0

**DURABLE 24 INCH STOP BAR, TYPE A TAPE AND TEMPORARY 24 INCH STOP BAR, PAINT**  
 SPRINGFIELD:  
 STA S 229+15.20 LT, TH-325

**REMOVING SIGNS AS SHOWN - 7**

**ERECTING SALVAGED SIGNS AS SHOWN - 1**

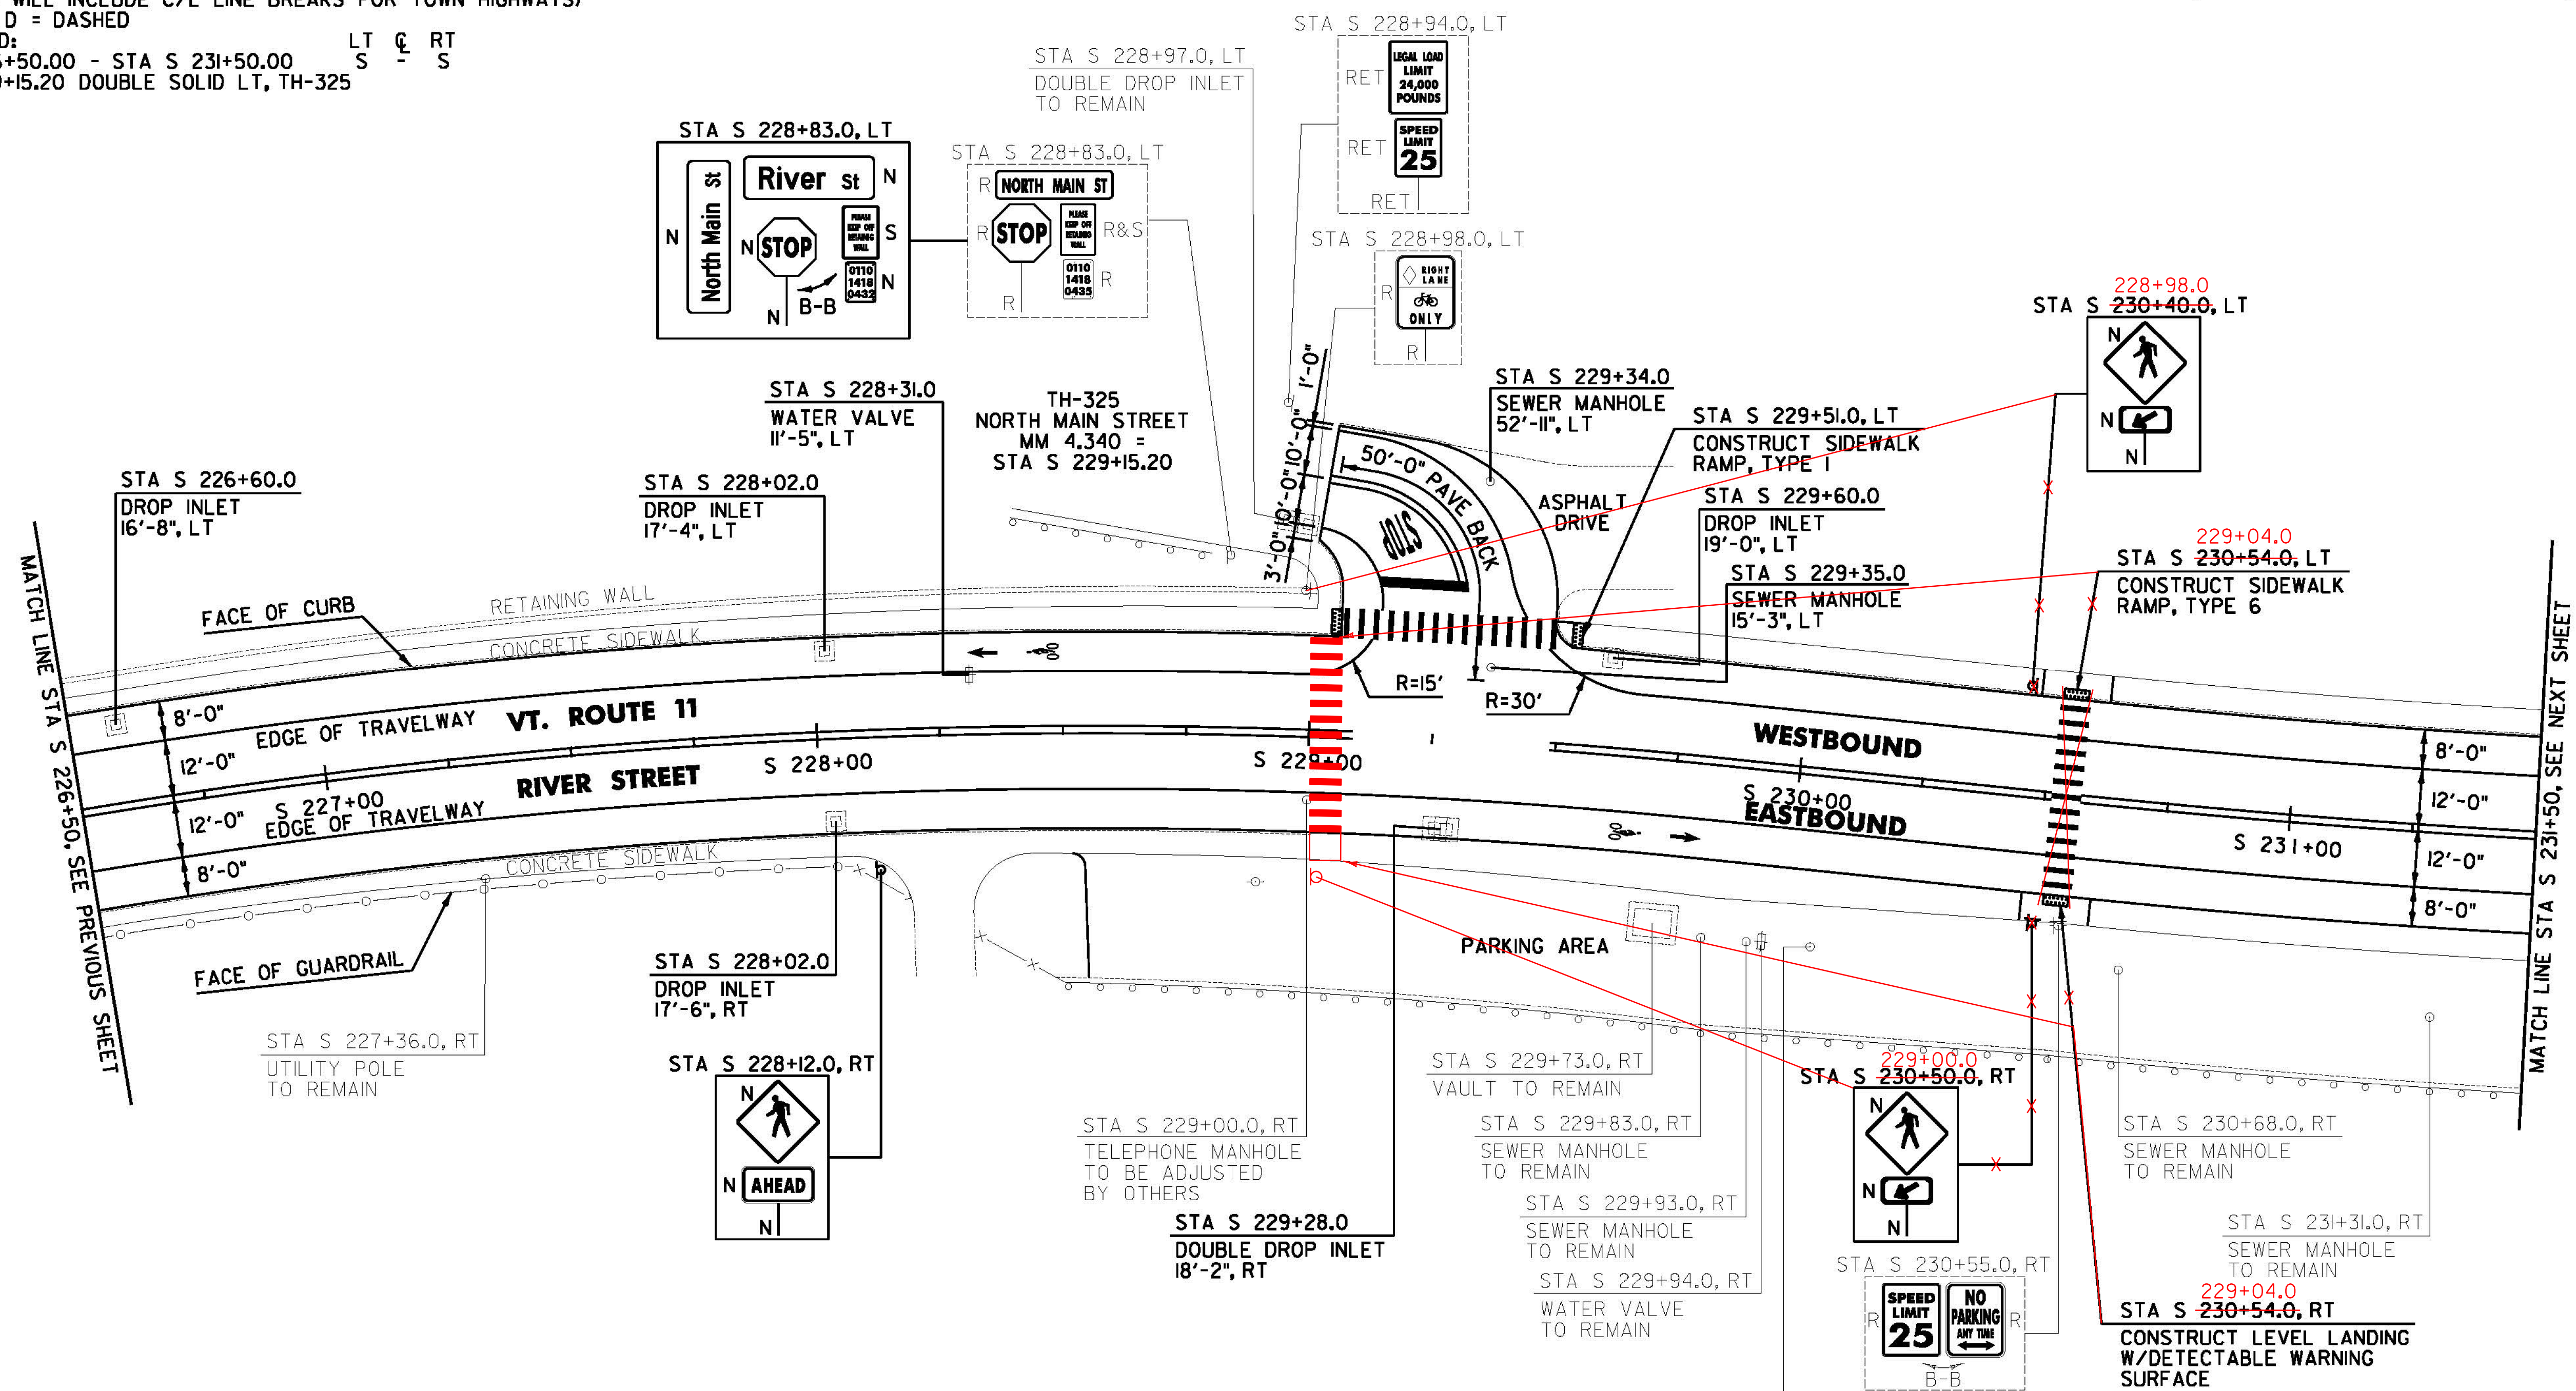

**REHAB. DROP INLETS, CATCH BASINS, OR MANHOLES, CLASS I, II, OR III**  
 SPRINGFIELD:  
 STA S 226+60.0 LT  
 STA S 228+02.0 LT  
 STA S 228+02.0 RT  
 STA S 229+28.0 RT  
 STA S 229+60.0 LT

**CHANGING ELEVATION OF SEWER MANHOLES**  
 SPRINGFIELD:  
 STA S 229+34.0 LT  
 STA S 229+35.0 LT

**REMOVING AND RESETTING CURB**  
 SPRINGFIELD:  
 STA S 229+51.0 LT  
 STA S 230+54.0 LT

**PORTLAND CEMENT CONCRETE SIDEWALK, 5 INCH**  
 SPRINGFIELD:  
 STA S 229+51.0 LT  
 STA S 230+54.0 LT 229+04.0  
 STA S 230+54.0 RT 229+04.0

**DETECTABLE WARNING SURFACE**  
 SPRINGFIELD:  
 STA S 229+51.0 LT  
 STA S 230+54.0 LT 229+04.0  
 STA S 230+54.0 RT 229+04.0

**ADJUST ELEVATION OF VALVE BOX**  
 SPRINGFIELD:  
 STA S 228+31.0 LT

**SIGN LEGEND**  
 R = REMOVE  
 S = SALVAGE  
 N = NEW  
 RET = RETAIN  
 B-B = BACK TO BACK  
 EXISTING = \_\_\_\_\_  
 NEW = \_\_\_\_\_  
 R = RETURN TO TOWN OF SPRINGFIELD

**NOT TO SCALE**

**SPRINGFIELD PROJECT LAYOUT SHEET #9**

**NOTE:**  
 I. EXISTING SIGNS ARE MOUNTED TO THE UTILITY POLE.

**PROJECT NAME:** CHESTER-SPRINGFIELD-ROCKINGHAM-WINDSOR  
**PROJECT NUMBER:** STP 2952(1)

**FILE NAME:** z13c518bdr\_seg02.dgn  
**PROJECT LEADER:** D. GOZALKOWSKI  
**DESIGNED BY:** A. HAWKINS

**PLOT DATE:** 3/27/2015  
**DRAWN BY:** A. KIRBY  
**CHECKED BY:** J. SHIELDS  
**SHEET 116 OF 309**