

DURABLE 4 INCH WHITE LINE, TYPE A TAPE AND TEMPORARY 4 INCH WHITE LINE, PAINT
 (ALL LINES WILL INCLUDE EDGE LINE BREAKS AND RADIUS FOR TOWN HIGHWAYS)

SPRINGFIELD:
 STA S 238+63.00 - STA S 240+17.00 DOTTED EDGE LINE LT
 STA S 238+71.00 - STA S 239+97.00 RT, PARKING SPACES
 STA S 239+71.20 EDGE LINES LT, TH-313
 STA S 240+17.00 - STA S 241+50.00 EDGE LINE LT
 STA S 240+20.00 - STA S 241+16.00 RT, PARKING SPACES
 STA S 240+71.52 LT, TH-5, PARKING SPACES

DURABLE 4 INCH YELLOW LINE, TYPE A TAPE AND TEMPORARY 4 INCH YELLOW LINE, PAINT
 (ALL LINES WILL INCLUDE C/L LINE BREAKS FOR TOWN HIGHWAYS)

SPRINGFIELD:
 S = SOLID, D = DASHED
 STA S 236+50.00 - STA S 240+17.00 LT & RT
 STA S 239+71.20 DOUBLE SOLID LT, TH-313
 STA S 240+17.00 - STA S 241+50.00 DOUBLE SOLID MEDIAN RT/C/L
 STA S 240+71.52 DOUBLE SOLID LT, TH-5

DURABLE 24 INCH STOP BAR, TYPE A TAPE AND TEMPORARY 24 INCH STOP BAR, PAINT

SPRINGFIELD:
 STA S 239+71.20 LT, TH-313
 STA S 240+71.52 LT, TH-5

DURABLE 6 INCH WHITE LINE, TYPE A TAPE AND TEMPORARY 6 INCH WHITE LINE, PAINT

SPRINGFIELD:
 STA S 236+50.00 - STA S 238+55.0 BIKE LANE EDGE LINE LT & RT

DURABLE 8 INCH YELLOW LINE, TYPE A TAPE

SPRINGFIELD:
 STA S 240+17.00 - STA S 241+50.00 HATCHED MEDIAN RT

DURABLE LETTER OR SYMBOL, TYPE D TAPE

SPRINGFIELD:
 STA S 239+71.20 LT, TH-313 "S,T,O,P" (4 EA)
 STA S 240+71.52 LT, TH-5 "S,T,O,P" (4 EA)
 STA S 238+00.00 LT, BIKE LANE SYMBOL (1EA)

TEMPORARY LETTER OR SYMBOL, PAINT

SPRINGFIELD:
 STA S 239+71.20 LT, TH-313 "S,T,O,P" (8 EA)
 STA S 240+71.52 LT, TH-5 "S,T,O,P" (8 EA)
 STA S 237+00.00 LT, BIKE LANE ARROW (2 EA)

DURABLE CROSSWALK MARKING, TYPE A TAPE AND TEMPORARY CROSSWALK MARKING, PAINT


SPRINGFIELD:
 STA S 238+61.00 LT/RT
 STA S 239+71.20 LT, TH-313
 STA S 240+71.52 LT, TH-5
 STA S 241+48.00 LT/RT

DURABLE 8 INCH WHITE LINE, TYPE A TAPE

SPRINGFIELD:
 STA S 238+37.00 - STA S 238+57.00 LT, NO PARKING
 STA S 238+37.00 - STA S 238+57.00 RT, NO PARKING
 STA S 238+71.00 - STA S 238+93.00 RT, NO PARKING
 STA S 239+84.00 - STA S 239+98.00 RT, NO PARKING
 STA S 240+20.00 - STA S 240+25.00 RT, NO PARKING
 STA S 240+71.52 LT, TH-5, NO PARKING
 STA S 241+12.00 - STA S 241+16.00 RT, NO PARKING

REMOVING SIGNS AS SHOWN - 21

ERECTING SALVAGED SIGNS AS SHOWN - 3

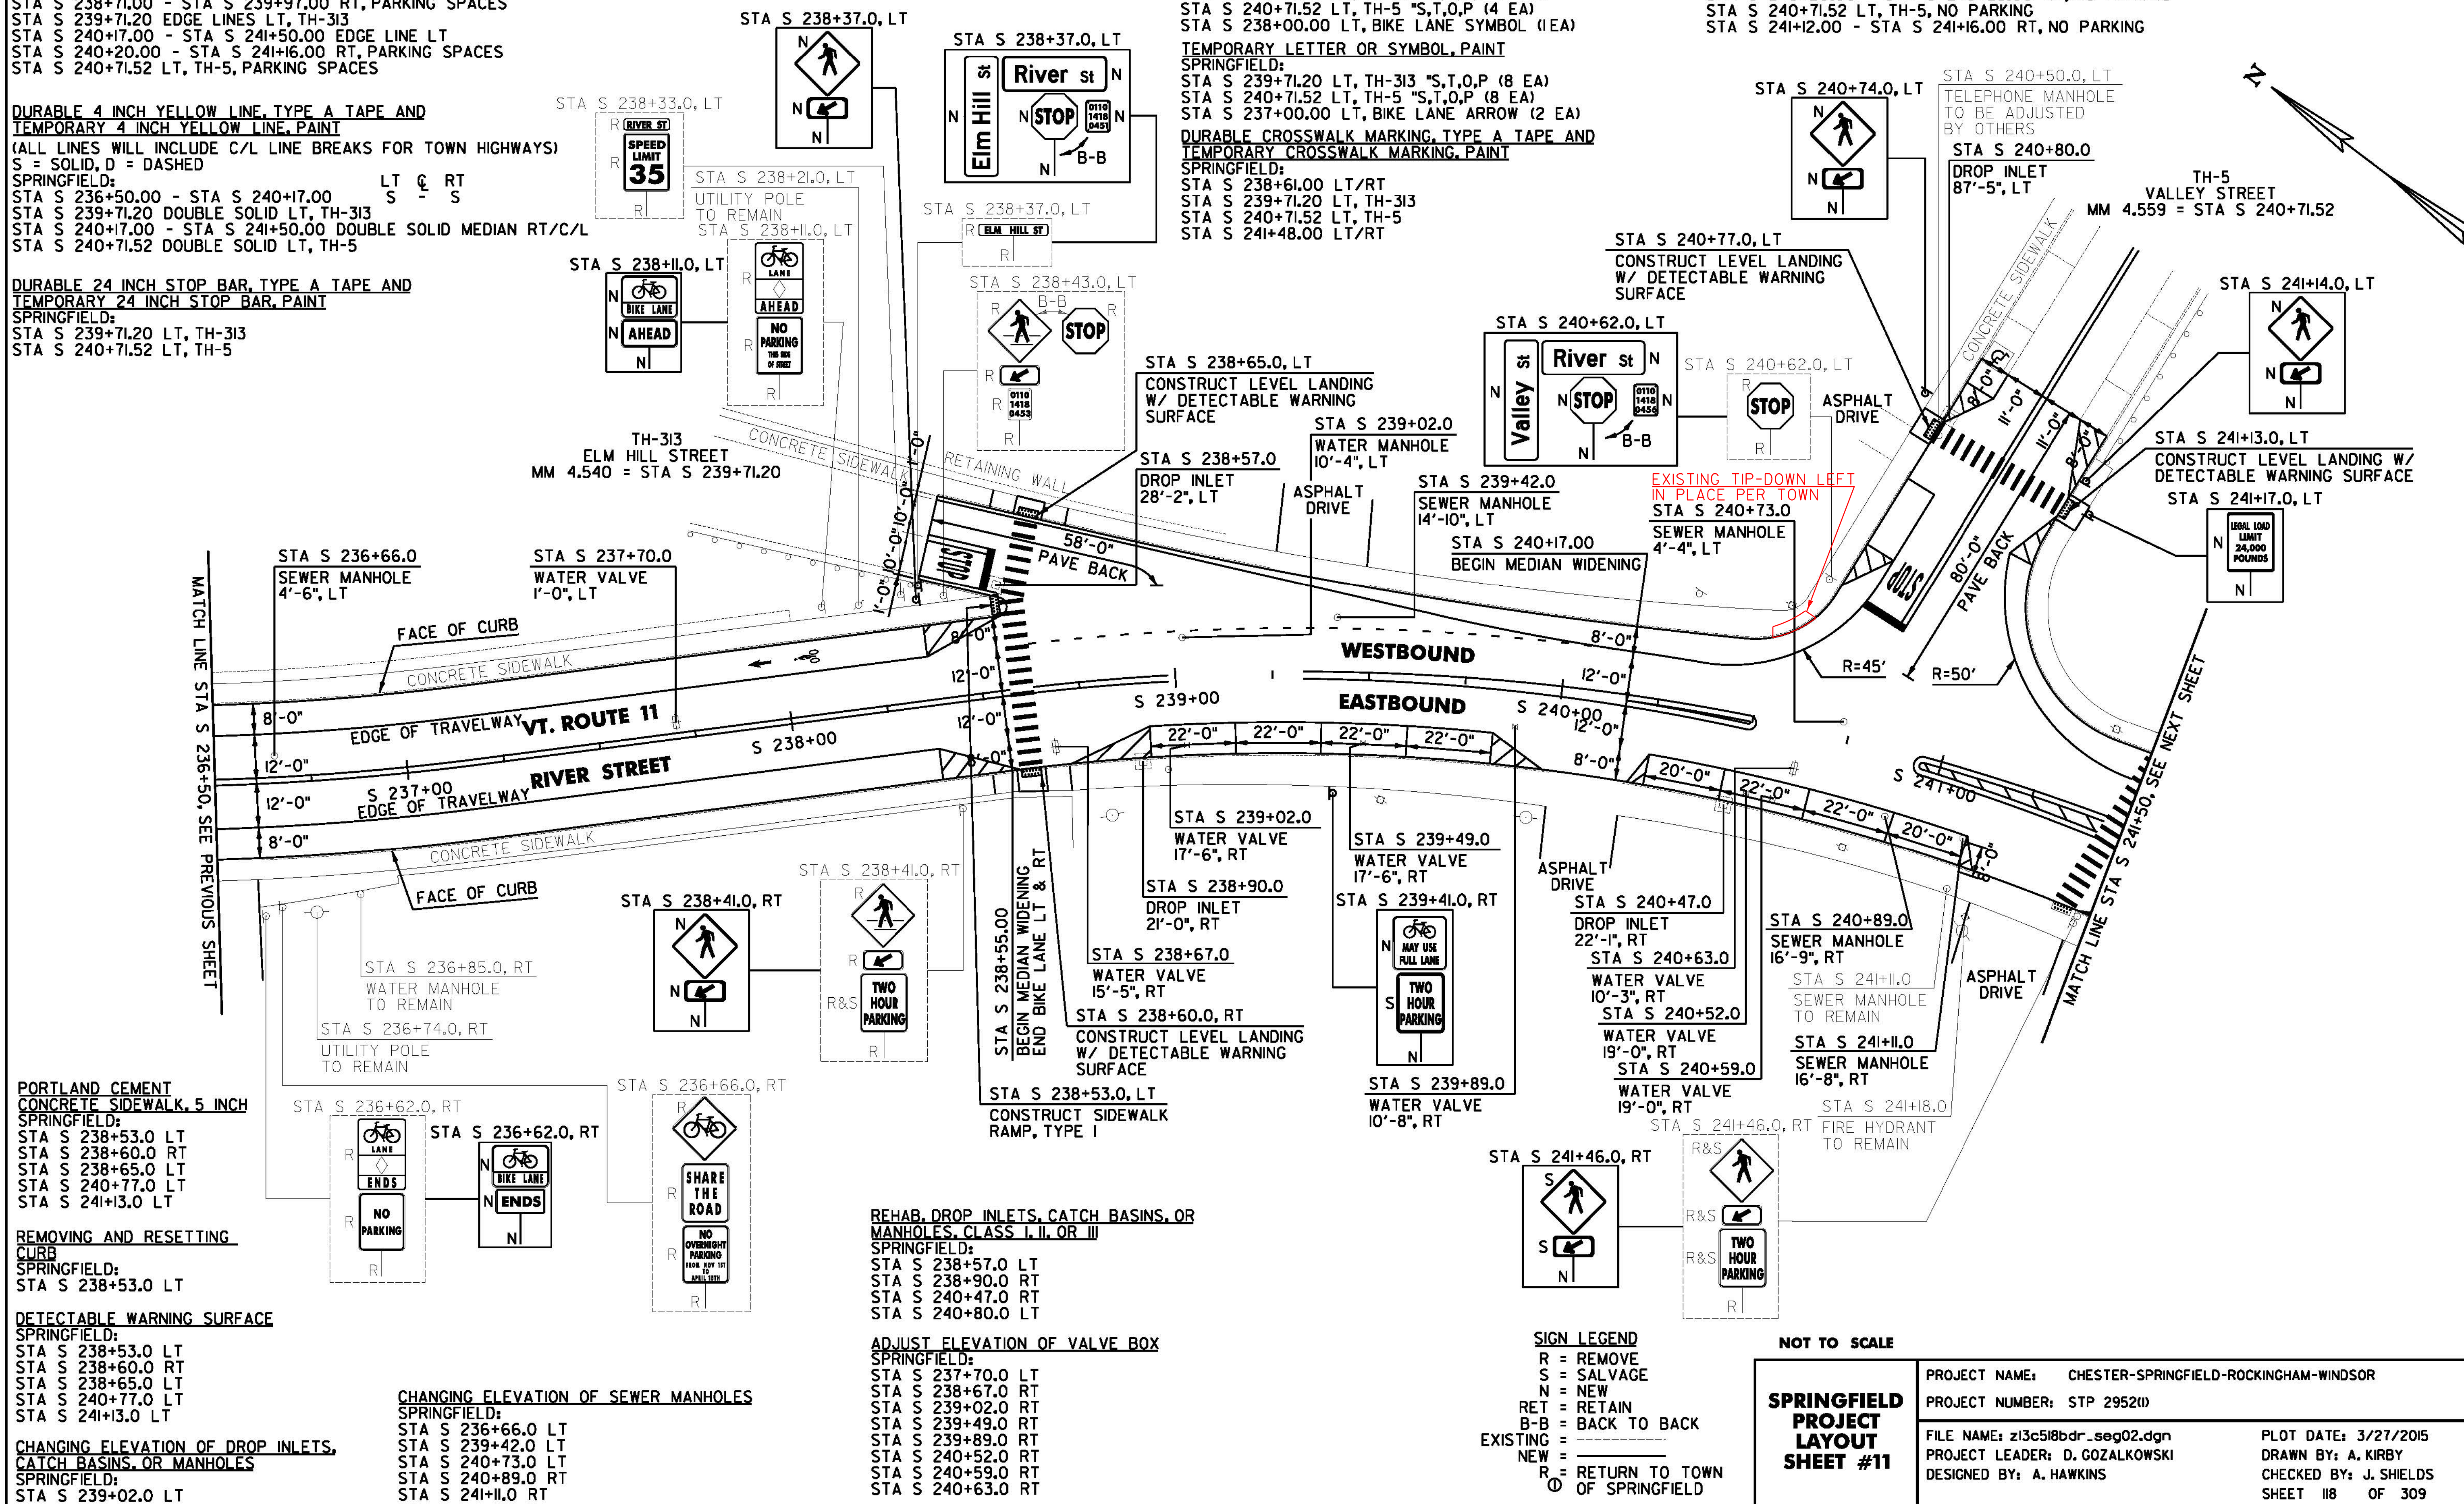

PORTLAND CEMENT CONCRETE SIDEWALK, 5 INCH

SPRINGFIELD:
 STA S 238+53.0 LT
 STA S 238+60.0 RT
 STA S 238+65.0 LT
 STA S 240+77.0 LT
 STA S 241+13.0 LT

REMOVING AND RESETTNG CURB

SPRINGFIELD:
 STA S 238+53.0 LT

DETECTABLE WARNING SURFACE

SPRINGFIELD:
 STA S 238+53.0 LT
 STA S 238+60.0 RT
 STA S 238+65.0 LT
 STA S 240+77.0 LT
 STA S 241+13.0 LT

CHANGING ELEVATION OF DROP INLETS, CATCH BASINS, OR MANHOLES

SPRINGFIELD:
 STA S 239+02.0 LT

CHANGING ELEVATION OF SEWER MANHOLES

SPRINGFIELD:
 STA S 236+66.0 LT
 STA S 239+42.0 LT
 STA S 240+73.0 LT
 STA S 240+89.0 RT
 STA S 241+11.0 RT

REHAB. DROP INLETS, CATCH BASINS, OR MANHOLES, CLASS I, II, OR III

SPRINGFIELD:
 STA S 238+57.0 LT
 STA S 238+90.0 RT
 STA S 240+47.0 RT
 STA S 240+80.0 LT

ADJUST ELEVATION OF VALVE BOX

SPRINGFIELD:
 STA S 237+70.0 LT
 STA S 238+67.0 RT
 STA S 239+02.0 RT
 STA S 239+49.0 RT
 STA S 239+89.0 RT
 STA S 240+52.0 RT
 STA S 240+59.0 RT
 STA S 240+63.0 RT

SIGN LEGEND

R = REMOVE
 S = SALVAGE
 N = NEW
 RET = RETAIN
 B-B = BACK TO BACK
 EXIST = EXISTING
 NEW = NEW
 R = RETURN TO TOWN OF SPRINGFIELD

NOT TO SCALE

SPRINGFIELD PROJECT LAYOUT SHEET #11

PROJECT NAME: CHESTER-SPRINGFIELD-ROCKINGHAM-WINDSOR

PROJECT NUMBER: STP 2952(1)

FILE NAME: z13c518bdr_seg02.dgn
PROJECT LEADER: D. GOZALKOWSKI
DESIGNED BY: A. HAWKINS

PLOT DATE: 3/27/2015
DRAWN BY: A. KIRBY
CHECKED BY: J. SHIELDS
SHEET 118 OF 309