

DURABLE 4 INCH WHITE LINE, TYPE A TAPE AND TEMPORARY 4 INCH WHITE LINE, PAINT

(ALL LINES WILL INCLUDE EDGE LINE BREAKS AND RADIUS FOR TOWN HIGHWAYS)

SPRINGFIELD:
 STA S 241+50.00 - STA S 243+79.00 EDGE LINE LT
 STA S 241+50.00 - STA S 243+85.00 RT PARKING SPACES
 STA S 242+21.00 - STA S 243+22.00 DOTTED LANE LINE RT
 STA S 242+95.00 - STA S 243+54.00 SIDEWALK DESIGNATION LINE LT
 STA S 242+95.00 - STA S 243+54.00 SIDEWALK DESIGNATION LINE RT
 STA S 243+22.00 - STA S 243+79.00 SOLID LANE LINE RT
 STA S 244+46.00 - STA S 245+41.00 RT PARKING SPACES
 STA S 244+80.00 - STA S 245+33.00 SOLID LANE LINE C/L
 STA S 244+14.72 EDGE LINES RT, TH-340
 STA S 244+14.72 SOLID LANE LINE RT, TH-340
 STA S 244+30.56 EDGE LINES LT, TH-3
 STA S 244+30.56 SOLID LANE LINE LT, TH-3
 STA S 244+77.00 - STA S 245+50.00 LT PARKING SPACES
 STA S 245+33.00 - STA S 245+50.00 DOTTED LANE LINE LT

DURABLE 4 INCH YELLOW LINE, TYPE A TAPE AND TEMPORARY 4 INCH YELLOW LINE, PAINT

(ALL LINES WILL INCLUDE C/L LINE BREAKS FOR TOWN HIGHWAYS)

SPRINGFIELD:
 S = SOLID, D = DASHED
 STA S 243+22.00 - STA S 243+79.00 LT C RT
 STA S 241+50.00 - STA S 243+22.00 DOUBLE SOLID MEDIAN RT/CL
 STA S 244+14.72 DOUBLE SOLID RT, TH-340
 STA S 244+30.56 DOUBLE SOLID LT, TH-3
 STA S 244+81.00 - STA S 245+33.00 DOUBLE SOLID RT
 STA S 245+33.00 - STA S 245+50.00 DOUBLE SOLID MEDIAN RT



DURABLE 8 INCH YELLOW LINE, TYPE A TAPE
SPRINGFIELD:
 STA S 241+50.00 - STA S 243+22.00 HATCHED MEDIAN RT
 STA S 245+33.00 - STA S 245+50.00 HATCHED MEDIAN RT

DURABLE 8 INCH WHITE LINE, TYPE A TAPE

SPRINGFIELD:
 STA S 241+50.00 - STA S 241+76.00 RT, NO PARKING
 STA S 242+38.00 - STA S 242+50.00 LT, FIRE HYDRANT, NO PARKING
 STA S 243+56.00 - STA S 243+85.00 RT, NO PARKING
 STA S 244+33.00 LT, FIRE HYDRANT, NO PARKING
 STA S 244+46.00 - STA S 244+84.00 RT, NO PARKING
 STA S 244+77.00 - STA S 245+06.00 LT, NO PARKING
 STA S 245+27.00 - STA S 245+41.00 RT, NO PARKING

DURABLE 24 INCH STOP BAR, TYPE A TAPE AND TEMPORARY 24 INCH STOP BAR, PAINT

SPRINGFIELD:
 STA S 243+79.00 RT
 STA S 244+14.72 RT, TH-340
 STA S 244+30.56 LT, TH-3
 STA S 244+81.00 LT

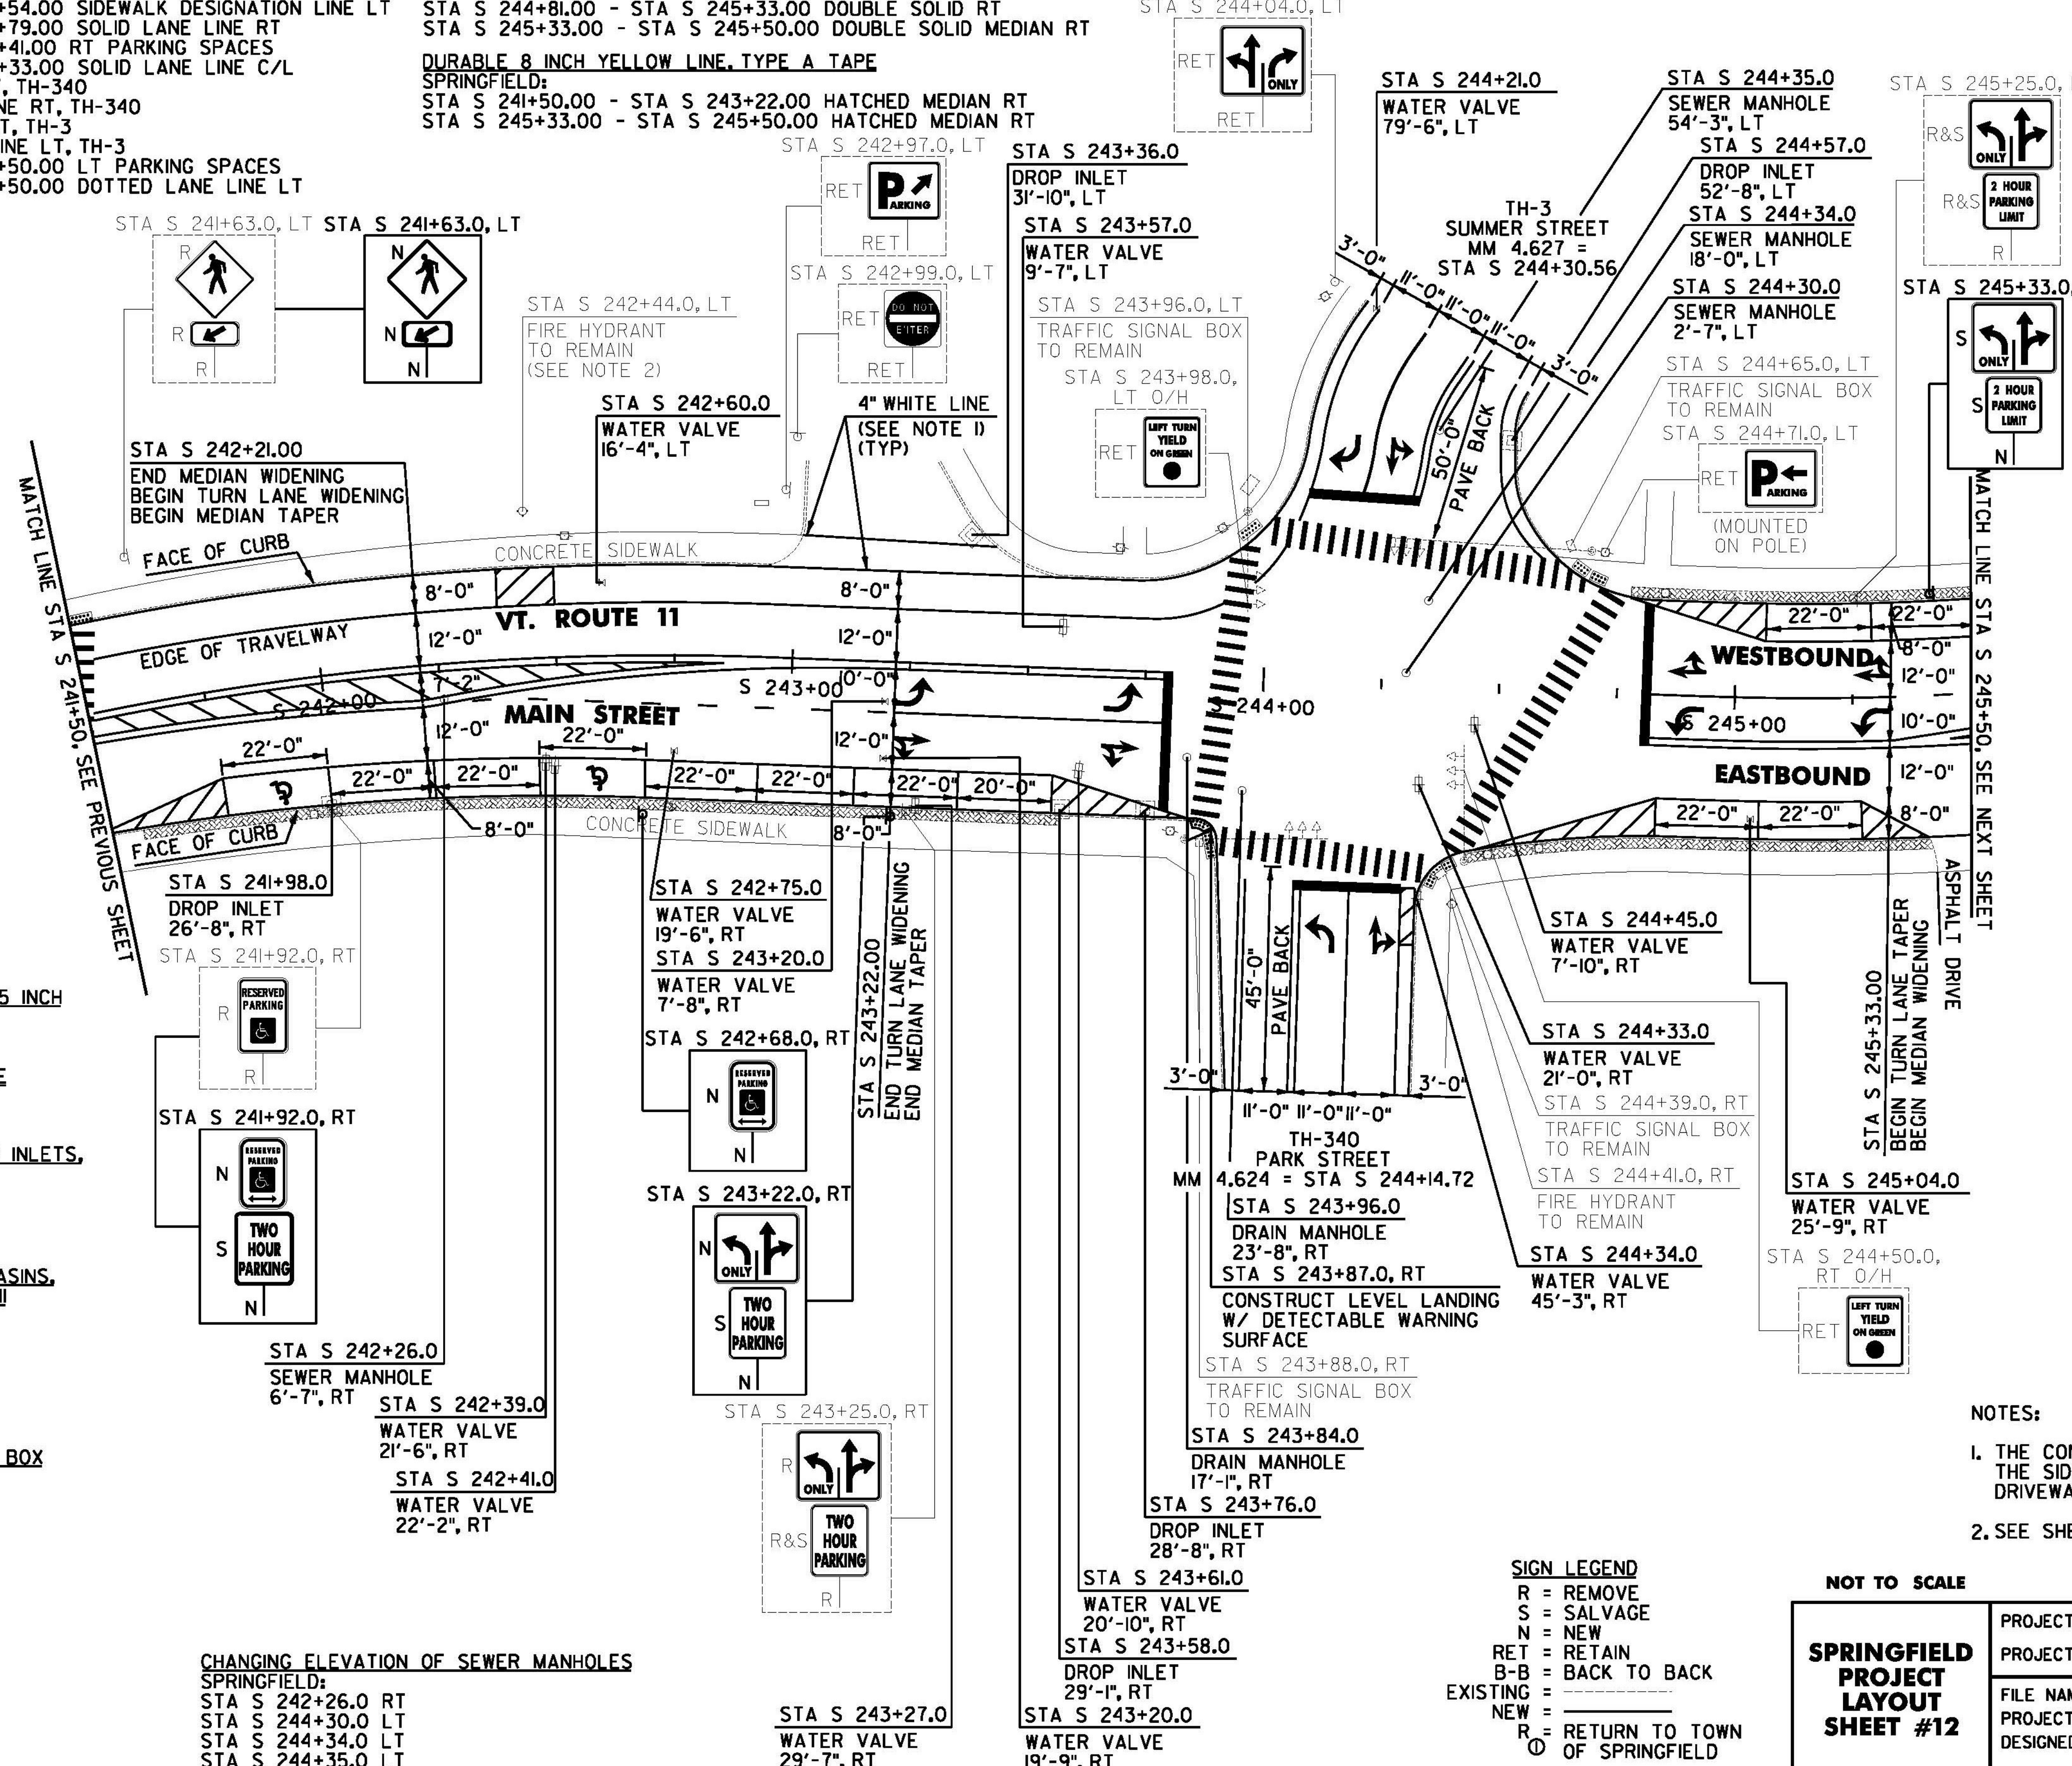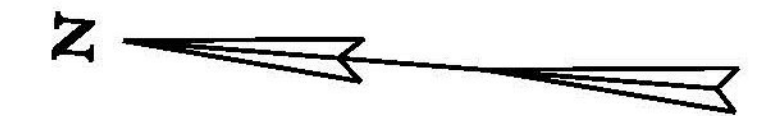

REMOVING SIGNS
 AS SHOWN - 7

ERECTING SALVAGED SIGNS
 AS SHOWN - 4

DURABLE LETTER OR SYMBOL, TYPE D TAPE
SPRINGFIELD:
 STA S 241+89.00 RT, HANDICAP SYMBOL (1 EA)
 STA S 242+58.00 RT, HANDICAP SYMBOL (1 EA)
 STA S 243+26.00 RT, ARROW (1 EA)
 STA S 243+26.00 RT, ARROW (2 EA)
 STA S 243+70.00 RT, ARROW (1 EA)
 STA S 243+70.00 RT, ARROW (2 EA)
 STA S 244+14.72 RT, TH-340 ARROW (1 EA)
 STA S 244+14.72 RT, TH-340 ARROW (2 EA)
 STA S 244+30.56 LT, TH-3 ARROW (1 EA)
 STA S 244+30.56 LT, TH-3 ARROW (2 EA)
 STA S 244+90.00 LT, ARROW (1 EA)
 STA S 244+90.00 LT, ARROW (2 EA)
 STA S 245+29.00 LT, ARROW (1 EA)
 STA S 245+29.00 LT, ARROW (2 EA)

TEMPORARY LETTER OR SYMBOL, PAINT
SPRINGFIELD:
 STA S 243+26.00 RT, ARROW 2 EA)
 STA S 243+26.00 RT, ARROW (4 EA)
 STA S 243+70.00 RT, ARROW (2 EA)
 STA S 243+70.00 RT, ARROW (4 EA)
 STA S 244+14.72 RT, TH-340 ARROW 2 EA)
 STA S 244+14.72 RT, TH-340 ARROW (4 EA)
 STA S 244+30.56 LT, TH-3 ARROW 2 EA)
 STA S 244+30.56 LT, TH-3 ARROW (4 EA)
 STA S 244+90.00 LT, ARROW (2 EA)
 STA S 244+90.00 LT, ARROW (4 EA)
 STA S 245+29.00 LT, ARROW (2 EA)
 STA S 245+29.00 LT, ARROW (4 EA)

DURABLE CROSSWALK MARKING, TYPE A TAPE AND TEMPORARY CROSSWALK MARKING, PAINT
SPRINGFIELD:
 STA S 241+48.00 LT/RT
 STA S 243+92.00 LT/RT
 STA S 244+14.72 RT, TH-340
 STA S 244+30.56 LT, TH-3
 STA S 244+59.00 LT/RT

PORTLAND CEMENT SIDEWALK, 5 INCH
SPRINGFIELD:
 STA S 243+87.0 RT

DETECTABLE WARNING SURFACE
SPRINGFIELD:
 STA S 243+87.0 RT

CHANGING ELEVATION OF DROP INLETS, CATCH BASINS, OR MANHOLES
SPRINGFIELD:
 STA S 243+84.0 RT
 STA S 243+96.0 RT

REHAB. DROP INLETS, CATCH BASINS, OR MANHOLES, CLASS I, II, OR III
SPRINGFIELD:
 STA S 241+98.0 RT
 STA S 243+36.0 LT
 STA S 243+58.0 RT
 STA S 243+76.0 RT
 STA S 244+57.0 LT

ADJUST ELEVATION OF VALVE BOX
SPRINGFIELD:
 STA S 242+39.0 RT
 STA S 242+41.0 RT
 STA S 242+60.0 LT
 STA S 242+75.0 RT
 STA S 243+20.0 RT
 STA S 243+20.0 RT
 STA S 243+27.0 RT
 STA S 243+57.0 LT
 STA S 243+61.0 RT
 STA S 244+21.0 LT
 STA S 244+33.0 RT
 STA S 244+34.0 RT
 STA S 244+45.0 RT
 STA S 245+04.0 RT

CHANGING ELEVATION OF SEWER MANHOLES
SPRINGFIELD:
 STA S 242+26.0 RT
 STA S 242+39.0 RT
 STA S 242+41.0 RT
 STA S 242+41.0 RT
 STA S 242+41.0 RT

CHANGING ELEVATION OF SEWER MANHOLES
SPRINGFIELD:
 STA S 242+26.0 RT
 STA S 244+30.0 LT
 STA S 244+34.0 LT
 STA S 244+35.0 LT

STA S 243+27.0
 WATER VALVE
 29'-7", RT

STA S 243+20.0
 WATER VALVE
 19'-9", RT

SIGN LEGEND
 R = REMOVE
 S = SALVAGE
 N = NEW
 RET = RETAIN
 B-B = BACK TO BACK
 EXISTING = _____
 NEW = _____
 R = RETURN TO TOWN OF SPRINGFIELD

NOT TO SCALE
SPRINGFIELD PROJECT LAYOUT SHEET #12

NOTES:
 1. THE CONTRACTOR SHALL PROVIDE 4" WHITE LINES TO CONNECT THE SIDEWALKS ACROSS THE DRIVEWAY AND SEPARATE THE DRIVEWAY AND THE PEDESTRIAN WALKWAY.
 2. SEE SHEET 16 FOR FIRE HYDRANT PAVEMENT MARKING DETAIL.

PROJECT NAME: CHESTER-SPRINGFIELD-ROCKINGHAM-WINDSOR	PLOT DATE: 3/27/2015
PROJECT NUMBER: STP 295210	DRAWN BY: A. KIRBY
FILE NAME: z13c518bdr_seg02.dgn	CHECKED BY: J. SHIELDS
PROJECT LEADER: D. GOZALKOWSKI	DESIGNED BY: A. HAWKINS
SHEET 119 OF 309	