

DURABLE 4 INCH WHITE LINE, TYPE A TAPE AND TEMPORARY 4 INCH WHITE LINE, PAINT
 (ALL LINES WILL INCLUDE EDGE LINE BREAKS AND RADIUS FOR TOWN HIGHWAYS)
 SPRINGFIELD:
 STA S 245+50.00 - STA S 245+74.00 LT, PARKING SPACES
 STA S 245+50.00 - STA S 246+33.00 DOTTED LANE LINE LT
 STA S 245+52.00 - STA S 246+89.00 RT, PARKING SPACES
 STA S 245+92.00 - STA S 248+09.00 LT, PARKING SPACES
 STA S 247+04.00 - STA S 247+82.00 RT, PARKING SPACES
 STA S 248+14.00 - STA S 249+81.00 RT, PARKING SPACES
 STA S 248+17.00 - STA S 248+90.00 LT, PARKING SPACES
 STA S 249+14.00 - STA S 249+80.00 LT, PARKING SPACES
 STA S 250+07.00 - STA S 250+50.00 LT, PARKING SPACES
 STA S 250+21.00 - STA S 250+50.00 RT, PARKING SPACES

DURABLE CROSSWALK MARKING, TYPE A TAPE AND TEMPORARY CROSSWALK MARKING, PAINT
 SPRINGFIELD:
 STA S 248+11.00 LT/RT
 STA S 249+84.00 LT/RT


DURABLE 4 INCH YELLOW LINE, TYPE A TAPE AND TEMPORARY 4 INCH YELLOW LINE, PAINT
 (ALL LINES WILL INCLUDE C/L LINE BREAKS FOR TOWN HIGHWAYS)
 S = SOLID, D = DASHED
 SPRINGFIELD:
 STA S 249+40.00 - STA S 250+50.00 LT C/RT
 STA S 249+40.00 - STA S 250+50.00 S - S
 STA S 245+50.00 - STA S 249+40.00 DOUBLE SOLID MEDIAN RT/CL

DURABLE 8 INCH YELLOW LINE, TYPE A TAPE
 SPRINGFIELD:
 STA S 245+50.00 - STA S 249+40.00 HATCHED MEDIAN LT/RT

DURABLE LETTER OR SYMBOL, TYPE D TAPE
 SPRINGFIELD:
 STA S 246+75.00 RT, HANDICAP SYMBOL
 STA S 248+47.00 RT, HANDICAP SYMBOL
 STA S 248+69.00 RT, HANDICAP SYMBOL
 STA S 249+49.00 LT, HANDICAP SYMBOL

DURABLE 8 INCH WHITE LINE, TYPE A TAPE
 SPRINGFIELD:
 STA S 245+50.00 - STA S 245+74.00 LT, NO PARKING
 STA S 245+52.00 - STA S 245+57.00 RT, NO PARKING
 STA S 245+92.00 - STA S 245+95.00 LT, NO PARKING
 STA S 246+84.00 - STA S 246+89.00 RT, NO PARKING
 STA S 247+04.00 - STA S 247+12.00 RT, NO PARKING
 STA S 247+74.00 - STA S 247+82.00 RT, NO PARKING
 STA S 247+89.00 - STA S 248+09.00 LT, NO PARKING
 STA S 248+14.00 - STA S 248+36.00 RT, NO PARKING
 STA S 248+17.00 - STA S 248+47.00 LT, NO PARKING
 STA S 248+81.00 - STA S 248+90.00 LT, NO PARKING
 STA S 249+14.00 - STA S 249+18.00 LT, NO PARKING
 STA S 249+46.00 - STA S 249+81.00 RT, NO PARKING
 STA S 249+60.00 - STA S 249+80.00 LT, NO PARKING
 STA S 250+07.00 - STA S 250+20.00 LT, NO PARKING
 STA S 250+21.00 - STA S 250+31.00 RT, NO PARKING
 STA S 250+43.00 - STA S 250+50.00 LT, NO PARKING

REMOVING SIGNS AS SHOWN - 12
ERECTING SALVAGED SIGNS AS SHOWN - 4

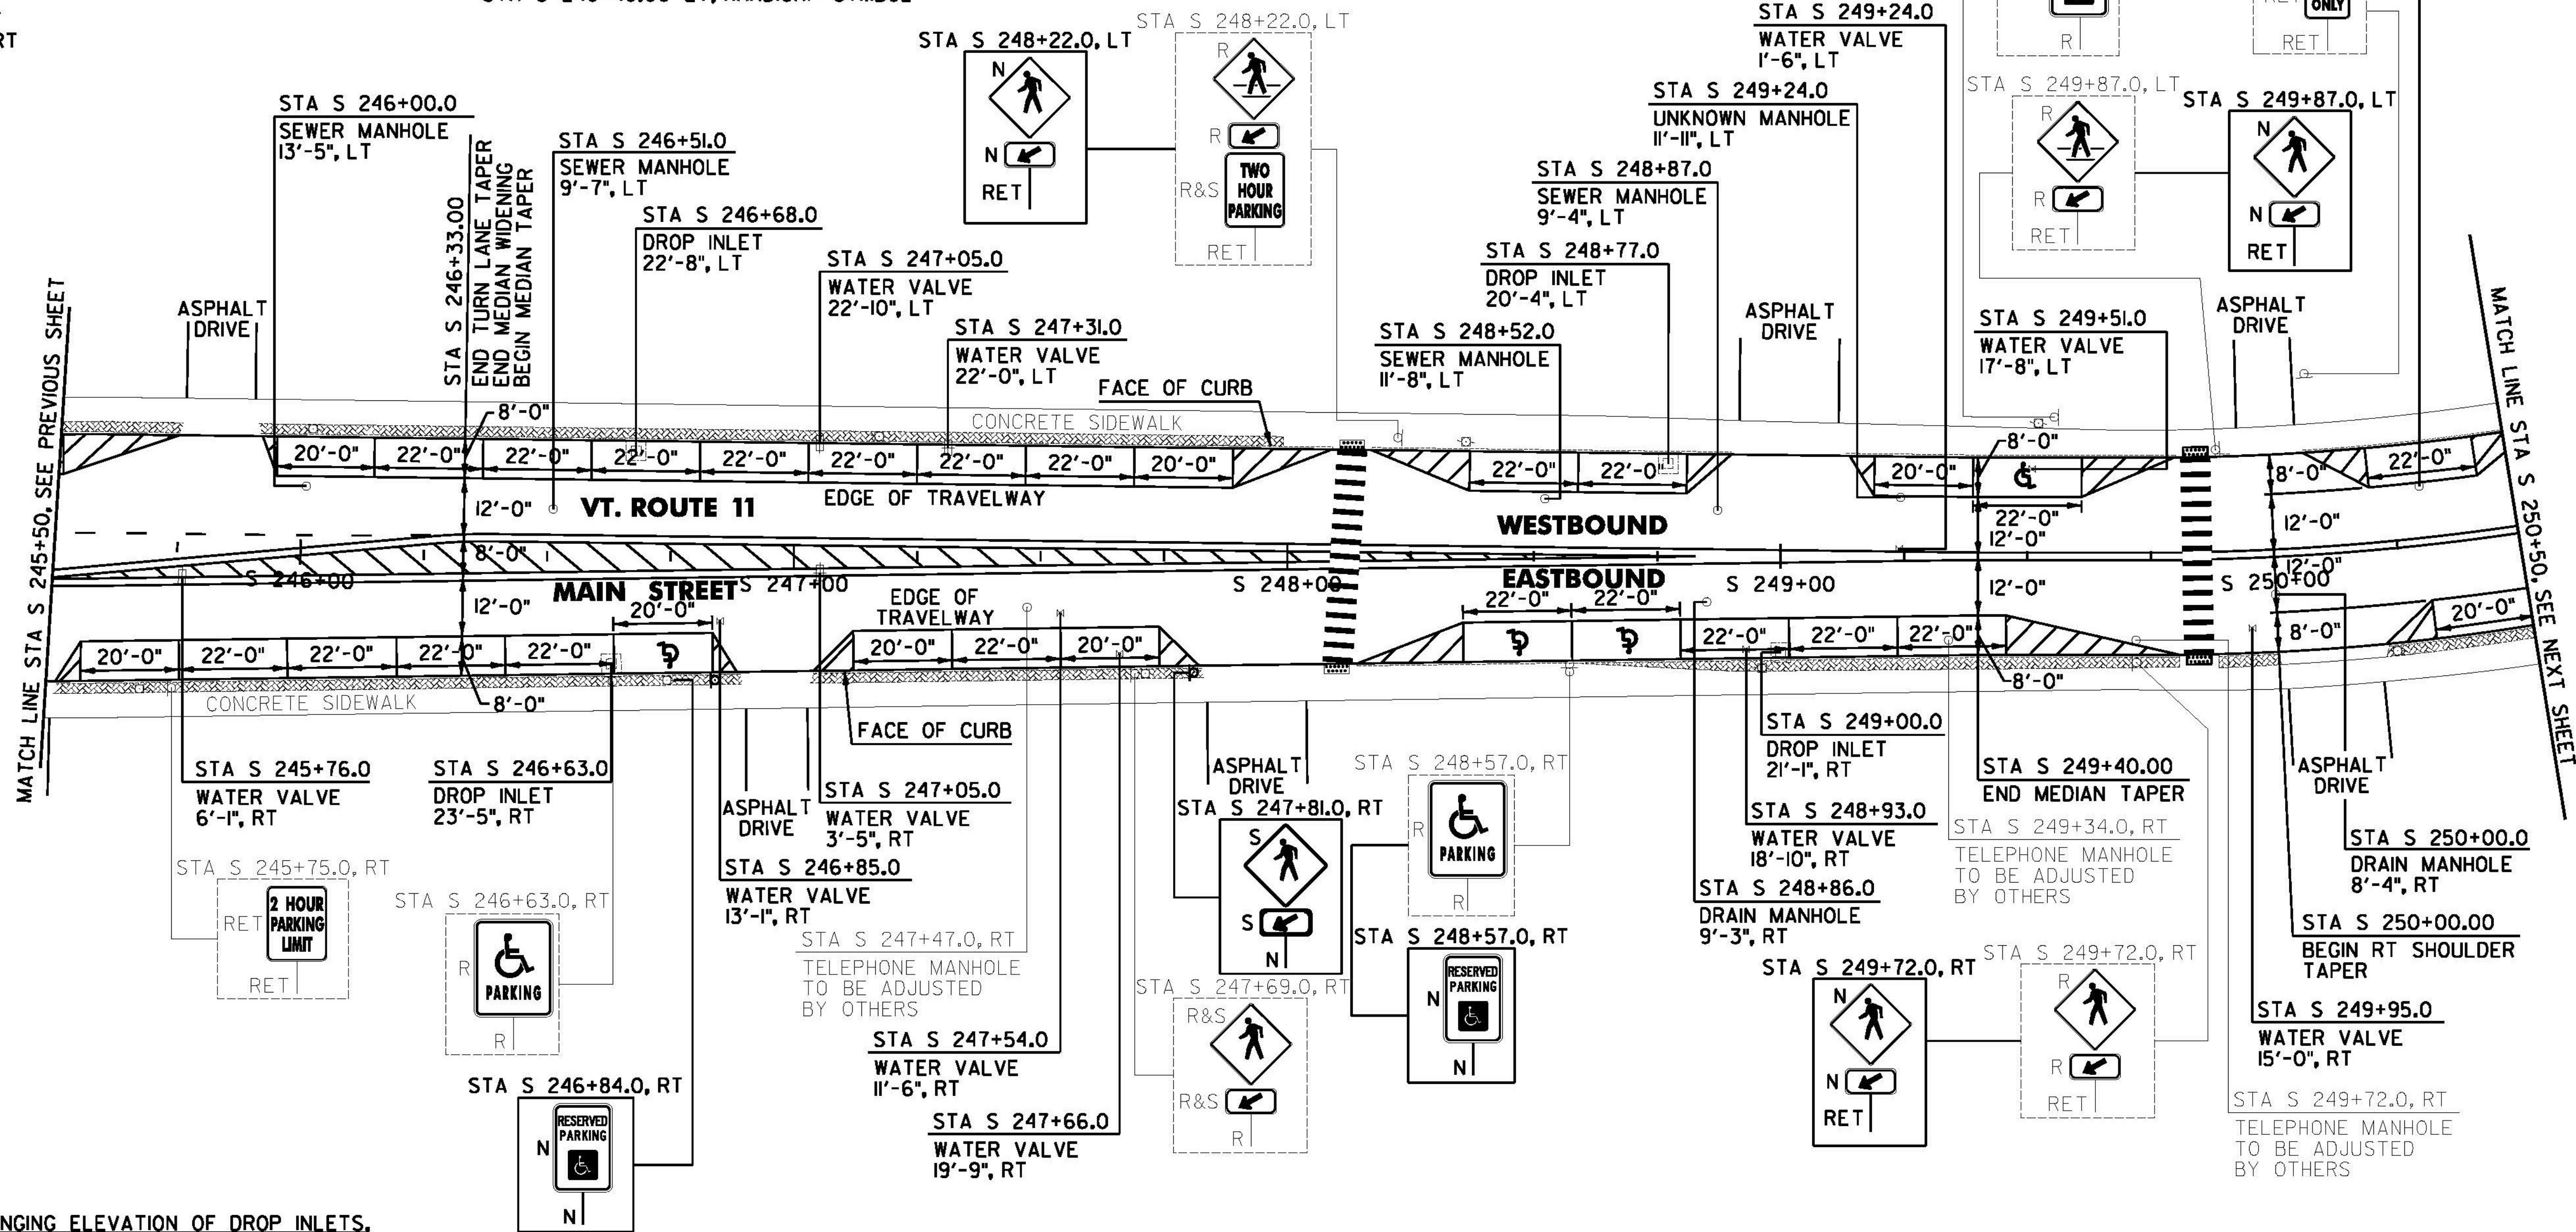

CHANGING ELEVATION OF DROP INLETS, CATCH BASINS, OR MANHOLES
 SPRINGFIELD:
 STA S 248+86.0 RT
 STA S 249+24.0 LT
 STA S 250+00.0 RT

REHAB. DROP INLETS, CATCH BASINS, OR MANHOLES, CLASS I, II, OR III
 SPRINGFIELD:
 STA S 246+63.0 RT
 STA S 246+68.0 LT
 STA S 248+77.0 LT
 STA S 249+00.0 RT

CHANGING ELEVATION OF SEWER MANHOLES
 SPRINGFIELD:
 STA S 246+00.0 LT
 STA S 246+51.0 LT
 STA S 248+52.0 LT
 STA S 248+87.0 LT
 STA S 250+31.0 LT

ADJUST ELEVATION OF VALVE BOX
 SPRINGFIELD:
 STA S 245+76.0 RT
 STA S 246+85.0 RT
 STA S 247+05.0 RT
 STA S 247+05.0 LT
 STA S 247+31.0 LT
 STA S 247+54.0 RT
 STA S 247+66.0 RT
 STA S 248+93.0 RT
 STA S 249+24.0 LT
 STA S 249+51.0 LT
 STA S 249+95.0 RT

SIGN LEGEND
 R = REMOVE
 S = SALVAGE
 N = NEW
 RET = RETAIN
 B-B = BACK TO BACK
 EXISTING = -----
 NEW = _____
 R = RETURN TO TOWN OF SPRINGFIELD

NOT TO SCALE
SPRINGFIELD PROJECT LAYOUT SHEET #13

PROJECT NAME: CHESTER-SPRINGFIELD-ROCKINGHAM-WINDSOR
 PROJECT NUMBER: STP 295210

FILE NAME: z13c518bdr_seg02.dgn
 PROJECT LEADER: D. GOZALKOWSKI
 DESIGNED BY: A. HAWKINS

PLOT DATE: 3/27/2015
 DRAWN BY: A. KIRBY
 CHECKED BY: J. SHIELDS
 SHEET 120 OF 309