

**DURABLE 4 INCH WHITE LINE, TYPE A TAPE AND TEMPORARY 4 INCH WHITE LINE, PAINT**  
 (ALL LINES WILL INCLUDE EDGE LINE BREAKS AND RADIUS FOR TOWN HIGHWAYS)  
 SPRINGFIELD:  
 STA S 258+50.00 - STA S 260+35.00 EDGE LINE RT  
 STA S 258+50.00 - STA S 262+50.00 EDGE LINE LT  
 STA S 260+35.00 - STA S 261+49.00 DOTTED EDGE LINE RT  
 STA S 261+4.88 EDGE LINES RT, TH-4  
 STA S 261+4.88 SOLID LANE LINE RT, TH-4  
 STA S 261+49.00 - STA S 262+50.00 EDGE LINE RT  
 STA S 262+09.92 EDGE LINES RT, TH-369  
 STA S 262+09.92 SOLID LANE LINE RT, TH-369  
 STA S 262+45.00 - STA S 262+50.00 SOLID LANE LINE LT  
 STA S 262+45.00 - STA S 262+50.00 DASHED LANE LINE RT

**TEMPORARY LETTER OR SYMBOL, PAINT**  
 SPRINGFIELD:  
 STA S 261+4.88 RT, TH-4 ARROW (2 EA)  
 STA S 261+4.88 RT, TH-4 ARROW (2 EA)  
 STA S 261+4.88 RT, TH-4 "S,T,O,P" (8 EA)  
 STA S 261+4.88 RT, TH-4 "S,T,O,P" (8 EA)  
 STA S 262+09.92 RT, TH-369 "S,T,O,P" (8 EA)  
 STA S 262+09.92 RT, TH-369 "S,T,O,P" (8 EA)  
 STA S 262+09.92 RT, TH-369 ARROW (2 EA)  
 STA S 262+09.92 RT, TH-369 ARROW (2 EA)



**DURABLE 4 INCH YELLOW LINE, TYPE A TAPE AND TEMPORARY 4 INCH YELLOW LINE, PAINT**  
 (ALL LINES WILL INCLUDE C/L LINE BREAKS FOR TOWN HIGHWAYS)  
 S = SOLID, D = DASHED  
 SPRINGFIELD:  
 STA S 258+50.00 - STA S 260+35.00 LT C RT  
 STA S 262+09.92 DOUBLE SOLID RT TH-369  
 STA S 260+35.00 - STA S 261+85.00 DOUBLE SOLID MEDIAN LT/CL  
 STA S 262+45.00 - STA S 262+50.00 DOUBLE SOLID MEDIAN LT/CL

**DURABLE 8 INCH WHITE LINE, TYPE A TAPE**  
 SPRINGFIELD:  
 STA S 261+49.00 - STA S 261+95.00 HATCHED GORE AREA RT  
**DURABLE 8 INCH YELLOW LINE, TYPE A TAPE**  
 SPRINGFIELD:  
 STA S 260+35.00 - STA S 261+85.00 HATCHED MEDIAN LT  
 STA S 262+45.00 - STA S 262+50.00 HATCHED MEDIAN C/L

**REMOVING SIGNS**  
 AS SHOWN - 13  
**ERECTING SALVAGED SIGNS**  
 AS SHOWN - 3

**DURABLE LETTER OR SYMBOL, TYPE D TAPE**  
 SPRINGFIELD:  
 STA S 261+4.88 RT, TH-4 ARROW (1 EA)  
 STA S 261+4.88 RT, TH-4 ARROW (1 EA)  
 STA S 261+4.88 RT, TH-4 "S,T,O,P" (4 EA)  
 STA S 261+4.88 RT, TH-4 "S,T,O,P" (4 EA)  
 STA S 262+09.92 RT, TH-369 "S,T,O,P" (4 EA)  
 STA S 262+09.92 RT, TH-369 "S,T,O,P" (4 EA)  
 STA S 262+09.92 RT, TH-369 ARROW (1 EA)  
 STA S 262+09.92 RT, TH-369 ARROW (1 EA)

**DURABLE 24 INCH STOP BAR, TYPE A TAPE AND TEMPORARY 24 INCH STOP BAR, PAINT**  
 SPRINGFIELD:  
 STA S 261+4.88 RT TH-4  
 STA S 262+09.92 RT, TH-369  
**DURABLE CROSSWALK MARKING, TYPE A TAPE AND TEMPORARY CROSSWALK MARKING, PAINT**  
 SPRINGFIELD:  
 STA S 260+48.00 LT/RT

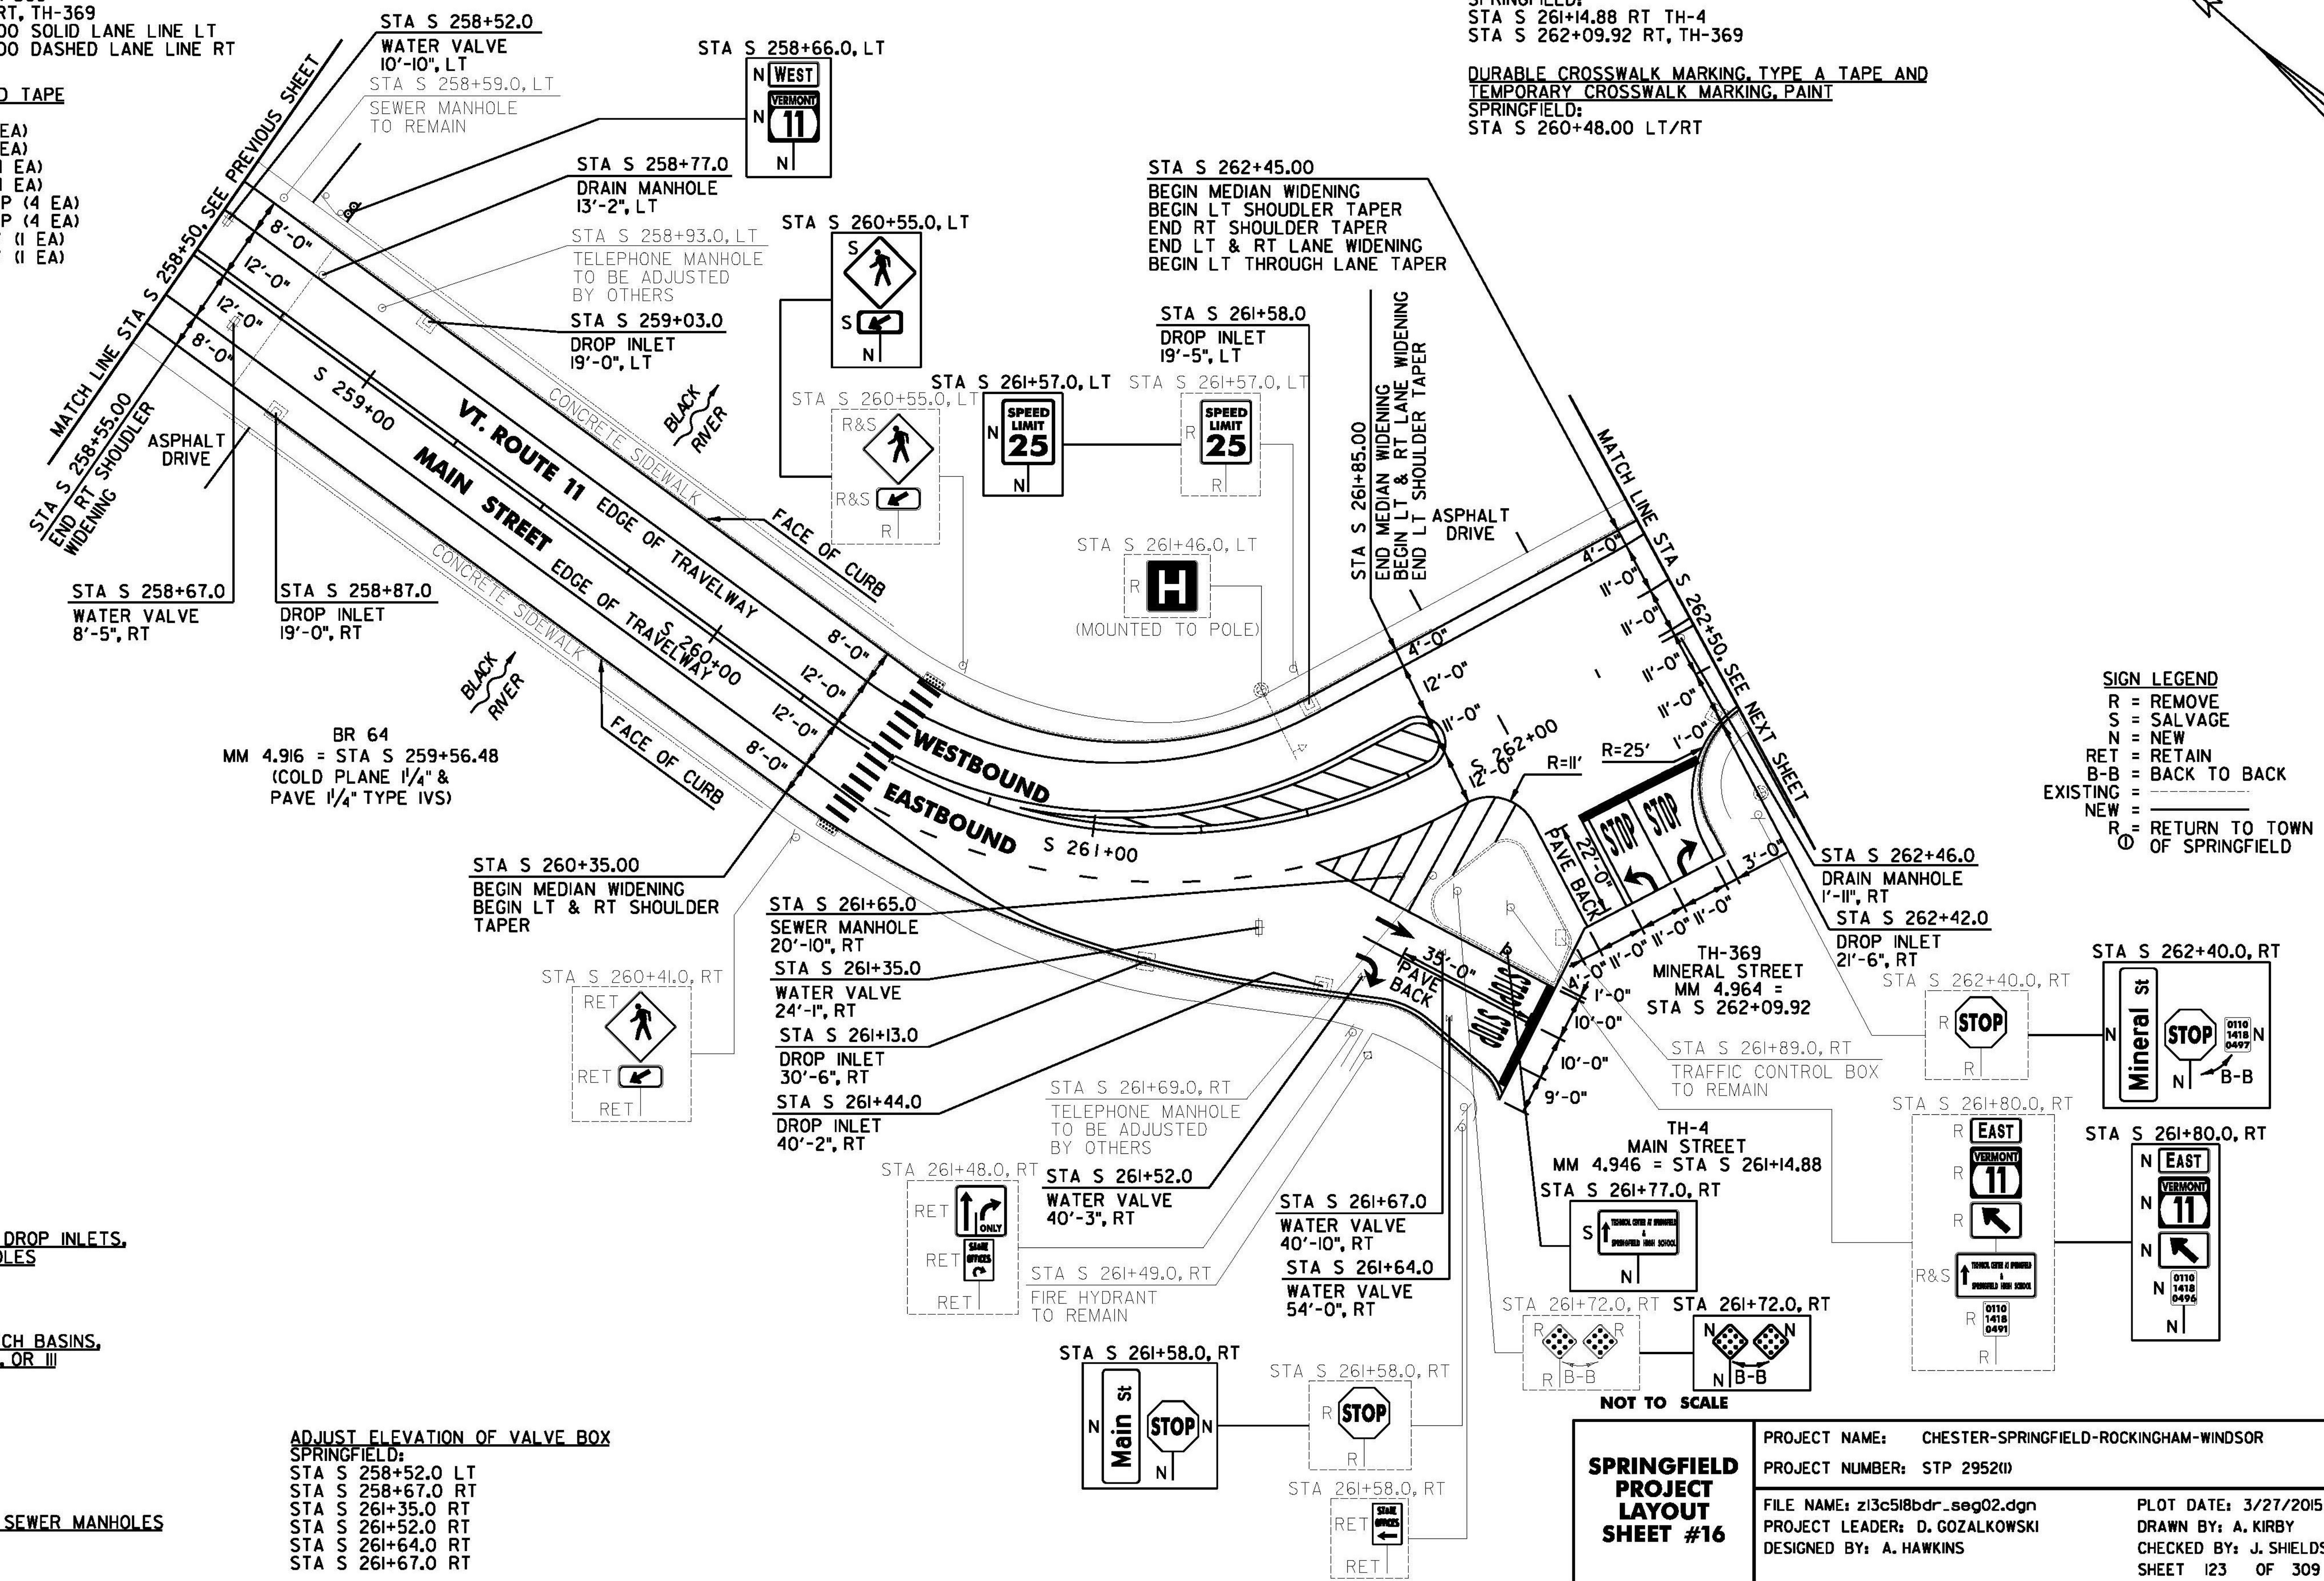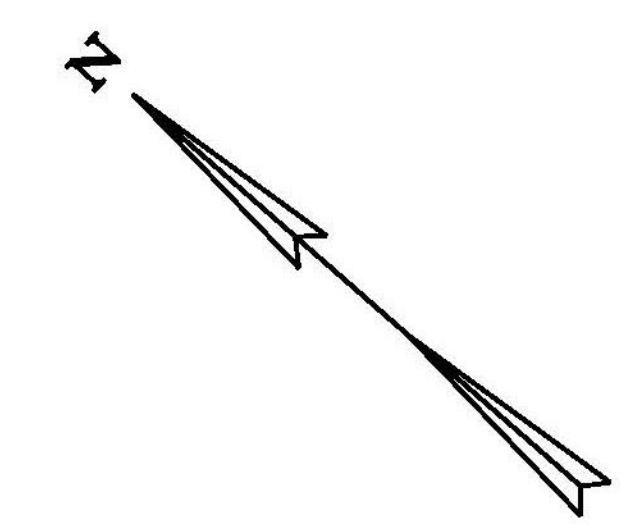

**SIGN LEGEND**  
 R = REMOVE  
 S = SALVAGE  
 N = NEW  
 RET = RETAIN  
 B-B = BACK TO BACK  
 EXISTING =   
 NEW =   
 R = RETURN TO TOWN OF SPRINGFIELD

**CHANGING ELEVATION OF DROP INLETS, CATCH BASINS, OR MANHOLES**  
 SPRINGFIELD:  
 STA S 258+77.0 LT  
 STA S 262+46.0 RT

**REHAB DROP INLETS, CATCH BASINS, OR MANHOLES, CLASS I, II, OR III**  
 SPRINGFIELD:  
 STA S 258+87.0 RT  
 STA S 259+03.0 LT  
 STA S 261+13.0 RT  
 STA S 261+44.0 RT  
 STA S 261+58.0 LT  
 STA S 262+42.0 RT

**CHANGING ELEVATION OF SEWER MANHOLES**  
 SPRINGFIELD:  
 STA S 261+65.0 RT

**ADJUST ELEVATION OF VALVE BOX**  
 SPRINGFIELD:  
 STA S 258+52.0 LT  
 STA S 258+67.0 RT  
 STA S 261+35.0 RT  
 STA S 261+52.0 RT  
 STA S 261+64.0 RT  
 STA S 261+67.0 RT

**SPRINGFIELD PROJECT LAYOUT SHEET #16**

PROJECT NAME: CHESTER-SPRINGFIELD-ROCKINGHAM-WINDSOR  
 PROJECT NUMBER: STP 295210  
 FILE NAME: z13c518bdr\_seg02.dgn  
 PROJECT LEADER: D. GOZALKOWSKI  
 DESIGNED BY: A. HAWKINS  
 PLOT DATE: 3/27/2015  
 DRAWN BY: A. KIRBY  
 CHECKED BY: J. SHIELDS  
 SHEET 123 OF 309