



DURABLE 4 INCH WHITE LINE, TYPE A TAPE AND TEMPORARY 4 INCH WHITE LINE, PAINT  
 (ALL LINES WILL INCLUDE EDGE LINE BREAKS AND RADIUS FOR TOWN HIGHWAYS)  
 SPRINGFIELD:  
 STA S 266+50.00 - STA S 268+00.00 EDGE LINE LT  
 STA S 266+50.00 - STA S 271+50.00 DASHED LANE LINE LT & RT

DURABLE 4 INCH YELLOW LINE, TYPE A TAPE AND TEMPORARY 4 INCH YELLOW LINE, PAINT  
 (ALL LINES WILL INCLUDE C/L LINE BREAKS FOR TOWN HIGHWAYS)  
 S = SOLID, D = DASHED  
 SPRINGFIELD:  
 STA S 266+50.00 - STA S 271+50.00 LT & RT  
 S - S

DURABLE 6 INCH WHITE LINE, TYPE A TAPE AND TEMPORARY 6 INCH WHITE LINE, PAINT  
 (ALL LINES WILL INCLUDE C/L LINE BREAKS FOR TOWN HIGHWAYS)  
 S = SOLID, D = DASHED  
 SPRINGFIELD:  
 STA S 266+50.00 - STA S 271+50.00 BIKE LANE EDGE LINE RT  
 STA S 268+00.00 - STA S 271+50.00 BIKE LANE EDGE LINE LT

DURABLE LETTER OR SYMBOL, TYPE D TAPE  
 SPRINGFIELD:  
 STA S 270+90.0 LT, BIKE LANE SYMBOL (1EA)  
DURABLE 8 INCH WHITE LINE, TYPE A TAPE  
 SPRINGFIELD:  
 STA S 268+08.0 - STA S 268+20.0 LT, FIRE HYDRANT, NO PARKING

REMOVING SIGNS  
 AS SHOWN - 2  
ERECTING SALVAGED SIGNS  
 AS SHOWN - 1

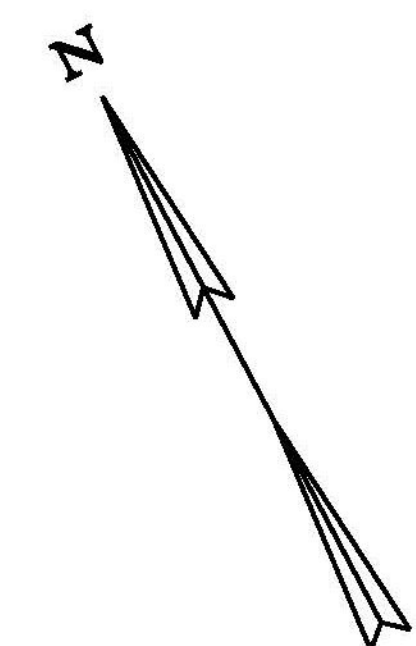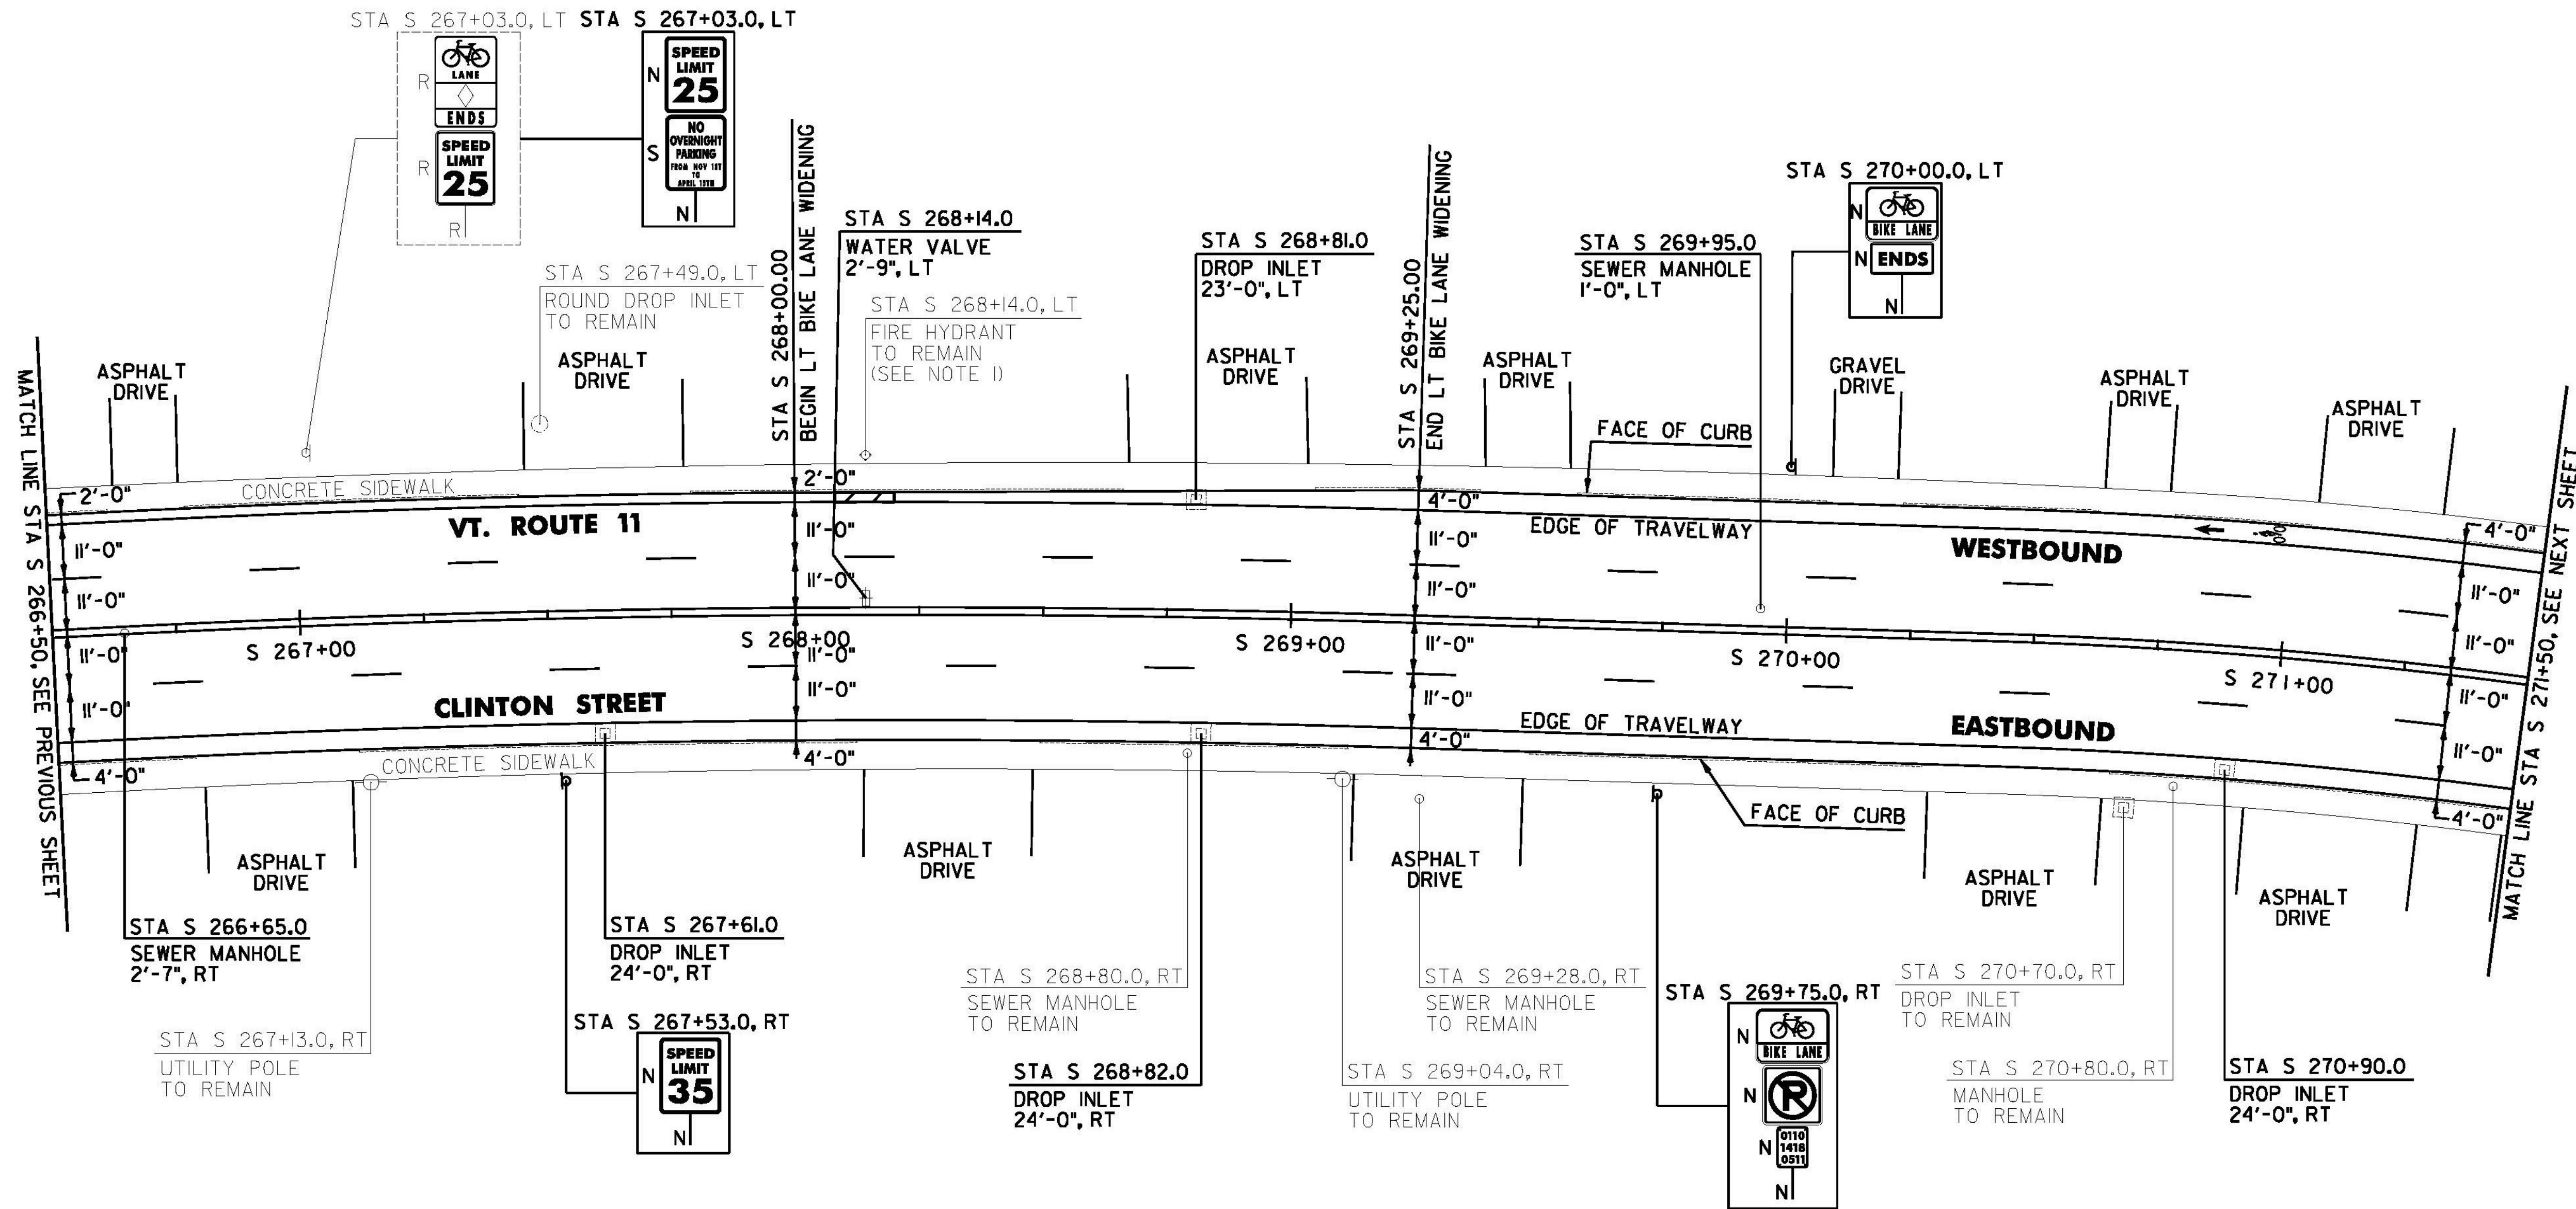

NOTE:  
 1. SEE SHEET 16 FOR FIRE HYDRANT PAVEMENT MARKING DETAIL.

REHAB. DROP INLETS, CATCH BASINS, OR MANHOLES, CLASS I, II, OR III  
 SPRINGFIELD:  
 STA S 267+61.0 RT  
 STA S 268+81.0 LT  
 STA S 268+82.0 RT  
 STA S 270+90.0 RT

CHANGING ELEVATION OF SEWER MANHOLES  
 SPRINGFIELD:  
 STA S 266+65.0 RT  
 STA S 269+95.0 LT  
ADJUST ELEVATION OF VALVE BOX  
 SPRINGFIELD:  
 STA S 268+14.0 LT

SIGN LEGEND  
 R = REMOVE  
 S = SALVAGE  
 N = NEW  
 RET = RETAIN  
 B-B = BACK TO BACK  
 EXISTING = \_\_\_\_\_  
 NEW = \_\_\_\_\_  
 R = RETURN TO TOWN OF SPRINGFIELD

**NOT TO SCALE**  
**SPRINGFIELD PROJECT LAYOUT SHEET #18**

PROJECT NAME: CHESTER-SPRINGFIELD-ROCKINGHAM-WINDSOR	PLOT DATE: 3/27/2015
PROJECT NUMBER: STP 29520	DRAWN BY: A. KIRBY
FILE NAME: z13c518bdr_seg02.dgn	CHECKED BY: J. SHIELDS
PROJECT LEADER: D. GOZALKOWSKI	SHEET 125 OF 309
DESIGNED BY: A. HAWKINS	