



DURABLE 4 INCH WHITE LINE, TYPE A TAPE AND  
TEMPORARY 4 INCH WHITE LINE, PAINT  
(ALL LINES WILL INCLUDE EDGE LINE BREAKS AND  
RADIUS FOR TOWN HIGHWAYS)  
SPRINGFIELD:  
STA S 271+50.00 - STA S 276+50.00 DASHED LANE LINE LT & RT

DURABLE 4 INCH YELLOW LINE, TYPE A TAPE AND  
TEMPORARY 4 INCH YELLOW LINE, PAINT  
(ALL LINES WILL INCLUDE C/L LINE BREAKS FOR TOWN HIGHWAYS)  
S = SOLID, D = DASHED  
SPRINGFIELD:  
STA S 271+50.00 - STA S 276+50.00 LT & RT  
S - S

DURABLE 6 INCH WHITE LINE, TYPE A TAPE AND  
TEMPORARY 6 INCH WHITE LINE, PAINT  
(ALL LINES WILL INCLUDE C/L LINE BREAKS FOR TOWN HIGHWAYS)  
S = SOLID, D = DASHED  
SPRINGFIELD:  
STA S 271+50.00 - STA S 276+50.00 BIKE LANE EDGE LINE LT & RT

DURABLE 8 INCH WHITE LINE, TYPE A TAPE  
SPRINGFIELD:  
STA S 272+62.0 - STA S 272+74.0 LT, FIRE HYDRANT, NO PARKING

REMOVING SIGNS  
AS SHOWN - 2

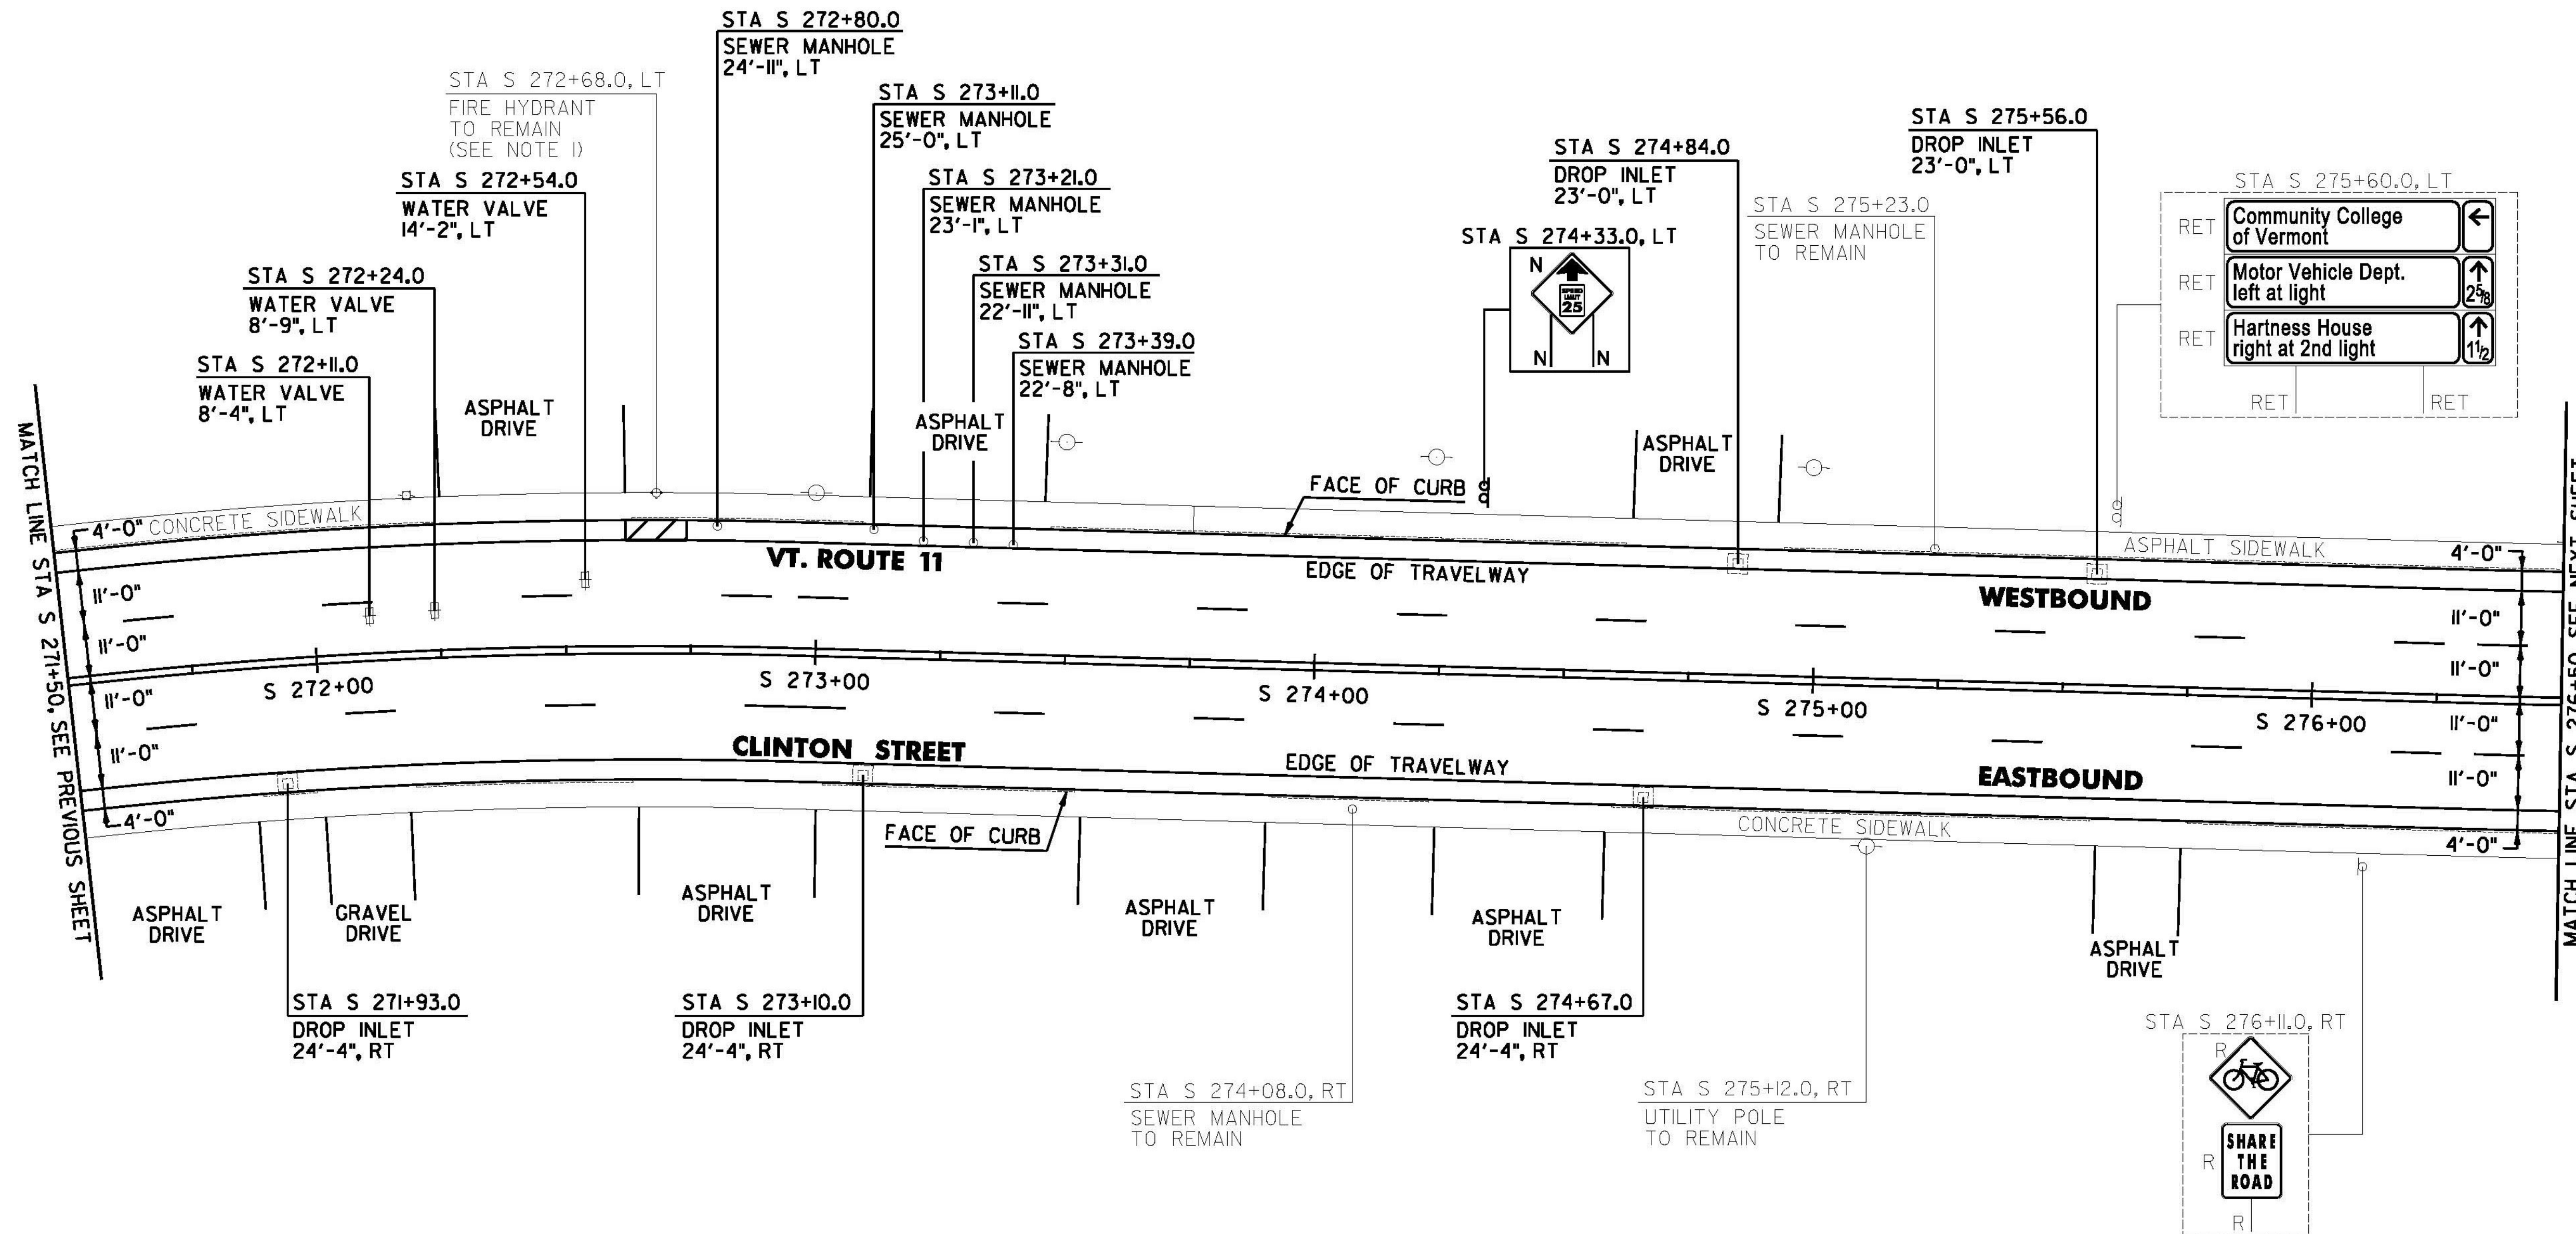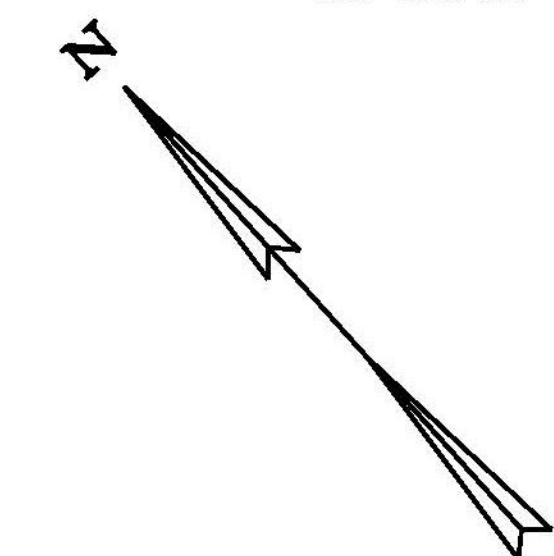

REHAB. DROP INLETS, CATCH BASINS,  
OR MANHOLES, CLASS I, II, OR III  
SPRINGFIELD:  
STA S 271+93.0 RT  
STA S 273+10.0 RT  
STA S 274+67.0 RT  
STA S 274+84.0 LT  
STA S 275+56.0 LT

CHANGING ELEVATION OF SEWER MANHOLES  
SPRINGFIELD:  
STA S 272+80.0 LT  
STA S 273+11.0 LT  
STA S 273+21.0 LT  
STA S 273+31.0 LT  
STA S 273+39.0 LT

ADJUST ELEVATION OF VALVE BOX  
SPRINGFIELD:  
STA S 272+11.0 LT  
STA S 272+24.0 LT  
STA S 272+54.0 LT

**SIGN LEGEND**  
R = REMOVE  
S = SALVAGE  
N = NEW  
RET = RETAIN  
B-B = BACK TO BACK  
EXISTING = \_\_\_\_\_  
NEW = \_\_\_\_\_  
R = RETURN TO TOWN  
OF SPRINGFIELD

NOTE:  
1. SEE SHEET 16 FOR FIRE HYDRANT PAVEMENT MARKING DETAIL.

**NOT TO SCALE**  
**SPRINGFIELD PROJECT LAYOUT SHEET #19**

PROJECT NAME: CHESTER-SPRINGFIELD-ROCKINGHAM-WINDSOR  
PROJECT NUMBER: STP 29520  
FILE NAME: z13c5i8bdr\_seg02.dgn  
PROJECT LEADER: D. GOZALKOWSKI  
DESIGNED BY: A. HAWKINS  
PLOT DATE: 3/27/2015  
DRAWN BY: A. KIRBY  
CHECKED BY: J. SHIELDS  
SHEET 126 OF 309