

DURABLE 4 INCH WHITE LINE, TYPE A TAPE AND TEMPORARY 4 INCH WHITE LINE, PAINT
 (ALL LINES WILL INCLUDE EDGE LINE BREAKS AND RADIUS FOR TOWN HIGHWAYS)
 SPRINGFIELD:
 STA S 281+50.00 - STA S 286+50.00 DASHED LANE LINE LT & RT
 STA S 284+16.96 EDGE LINES LT, TH-430

DURABLE 4 INCH YELLOW LINE, TYPE A TAPE AND TEMPORARY 4 INCH YELLOW LINE, PAINT
 (ALL LINES WILL INCLUDE C/L LINE BREAKS FOR TOWN HIGHWAYS)
 S = SOLID, D = DASHED
 SPRINGFIELD:
 STA S 281+50.00 LT & RT
 STA S 284+16.96 DOUBLE SOLID LT, TH-430

DURABLE 6 INCH WHITE LINE, TYPE A TAPE AND TEMPORARY 6 INCH WHITE LINE, PAINT
 (ALL LINES WILL INCLUDE C/L LINE BREAKS FOR TOWN HIGHWAYS)
 S = SOLID, D = DASHED
 SPRINGFIELD:
 STA S 281+50.00 - STA S 286+50.00 BIKE LANE EDGE LINE LT & RT

DURABLE 8 INCH WHITE LINE, TYPE A TAPE
 SPRINGFIELD:
 STA S 282+25.0 - STA S 282+37.0 LT, FIRE HYDRANT, NO PARKING



DURABLE 24 INCH STOP BAR, TYPE A TAPE AND TEMPORARY 24 INCH STOP BAR, PAINT
 SPRINGFIELD:
 STA S 283+09.00, RT
 STA S 284+16.96 LT, TH-430
 STA S 285+31.00, LT

DURABLE LETTER OR SYMBOL, TYPE D TAPE
 SPRINGFIELD:
 STA S 283+12.0 LT, BIKE LANE SYMBOL (IEA)
 STA S 285+45.0 RT, BIKE LANE SYMBOL (IEA)
 STA S 284+16.96 LT, TH-430 "S,T,O,P (4 EA)

TEMPORARY LETTER OR SYMBOL, PAINT
 SPRINGFIELD:
 STA S 284+16.96 LT, TH-430 "S,T,O,P (8 EA)

REMOVING SIGNS AS SHOWN - II

DURABLE CROSSWALK MARKING, TYPE A TAPE AND TEMPORARY CROSSWALK MARKING, PAINT
 SPRINGFIELD:
 STA S 284+16.96 LT, TH-430

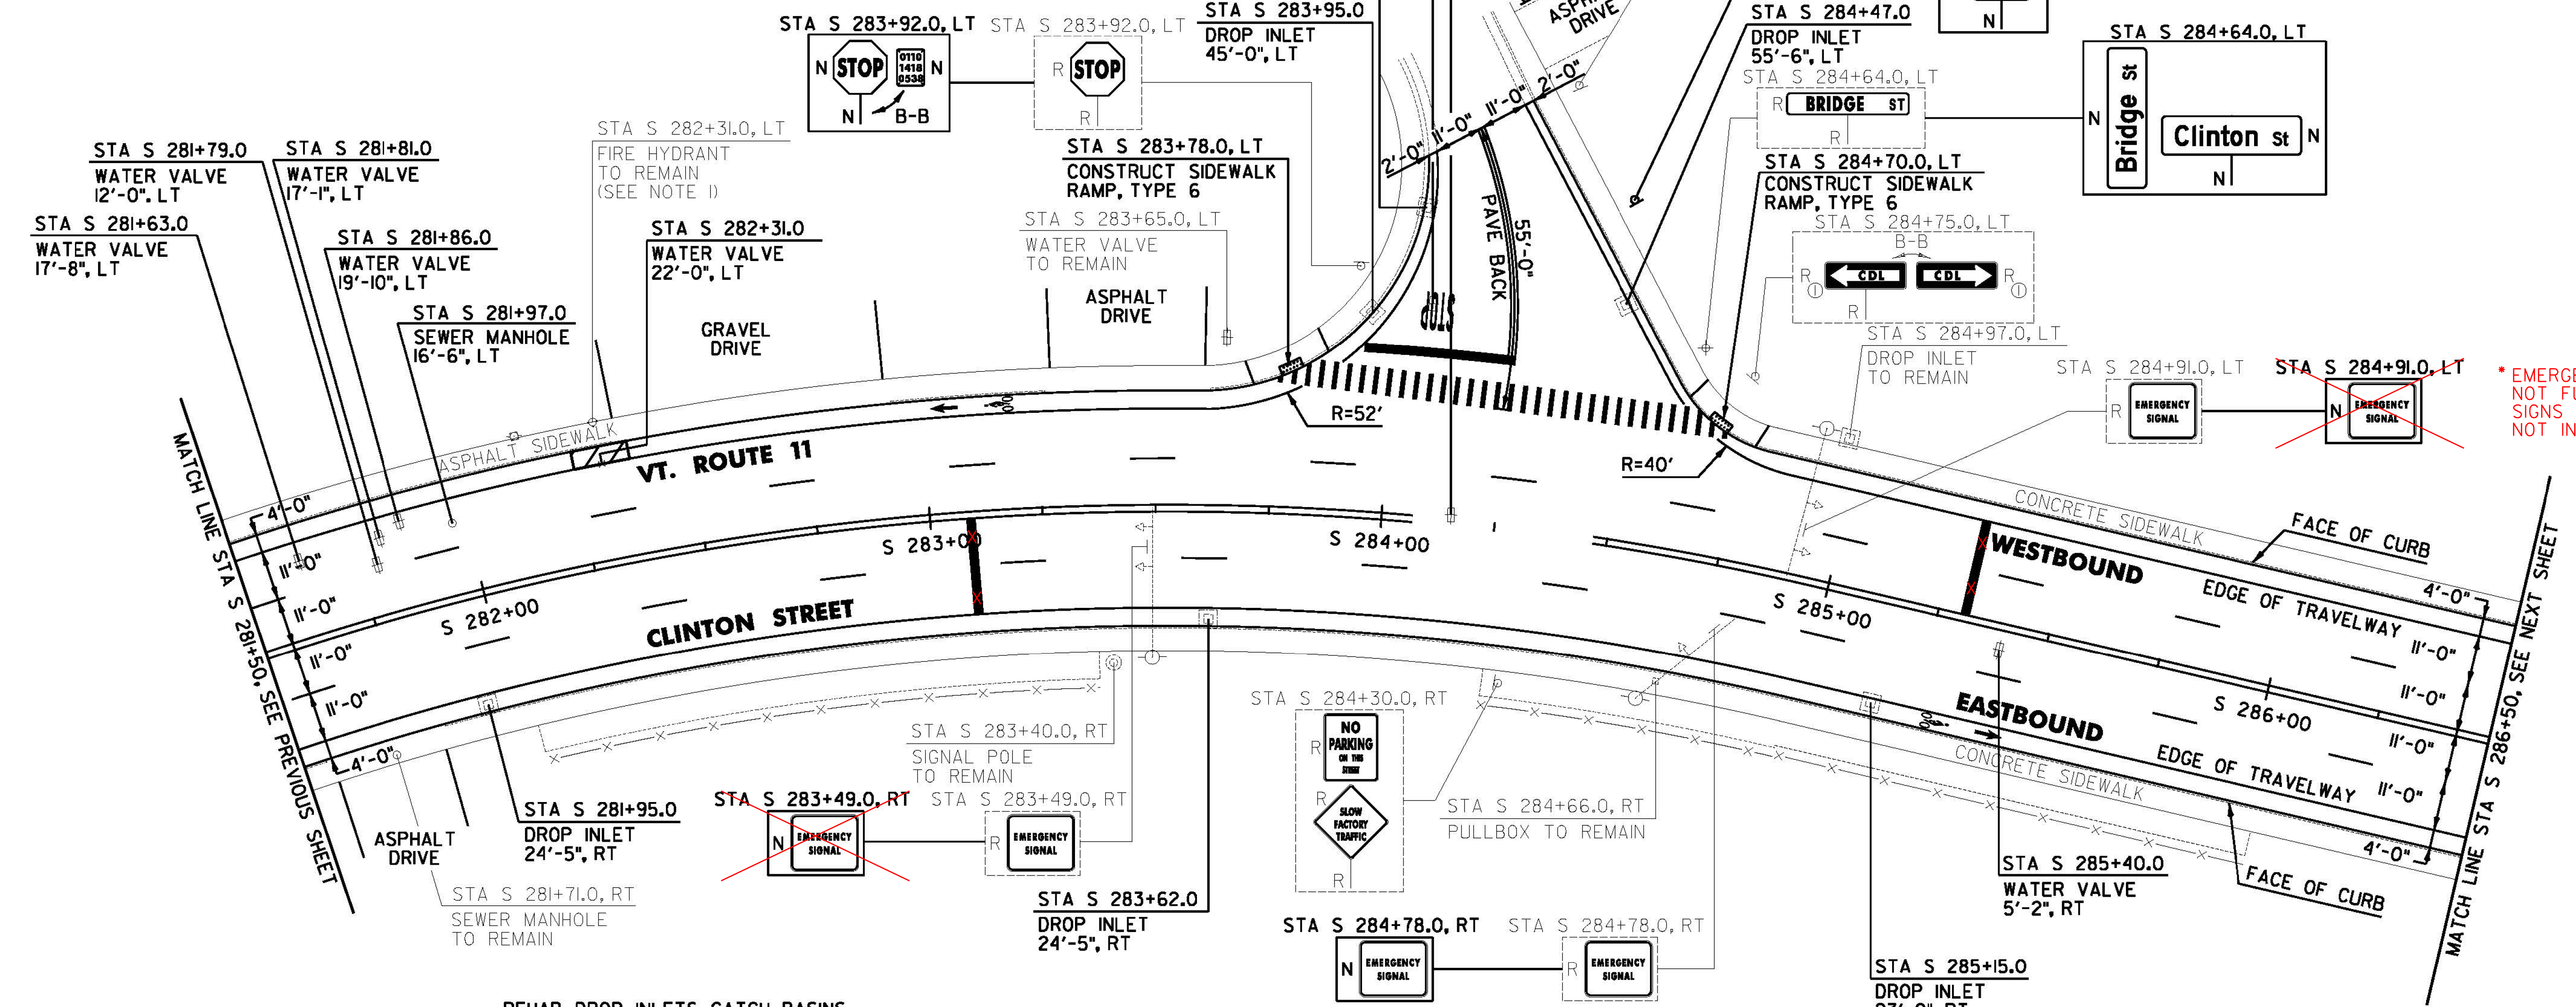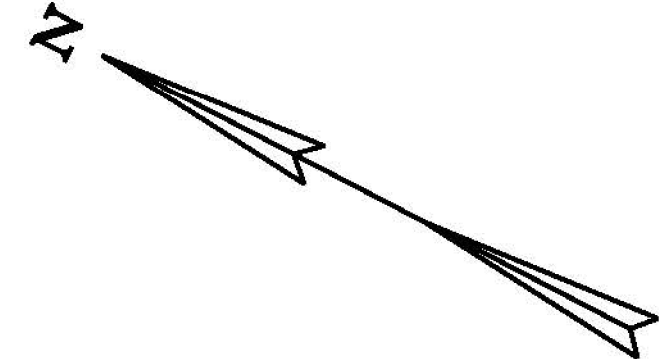

* EMERGENCY SIGNALS NOT FUNCTIONAL. NEW SIGNS AND STOP BAR NOT INSTALLED

REHAB. DROP INLETS, CATCH BASINS, OR MANHOLES, CLASS I, II, OR III
 SPRINGFIELD:
 STA S 281+95.0 RT
 STA S 283+62.0 RT
 STA S 283+95.0 LT
 STA S 284+04.0 LT
 STA S 284+47.0 LT
 STA S 285+15.0 RT

CHANGING ELEVATION OF SEWER MANHOLES
 SPRINGFIELD:
 STA S 281+97.0 LT

REMOVING AND RESETTNG CURB
 SPRINGFIELD:
 STA S 283+78.0 LT
 STA S 284+70.0 LT

DETECTABLE WARNING SURFACE
 SPRINGFIELD:
 STA S 283+78.0 LT
 STA S 284+70.0 LT

ADJUST ELEVATION OF VALVE BOX
 SPRINGFIELD:
 STA S 281+63.0 LT
 STA S 281+79.0 LT
 STA S 281+81.0 LT
 STA S 281+86.0 LT
 STA S 282+31.0 LT
 STA S 284+07.0 LT
 STA S 284+15.0 LT
 STA S 285+40.0 RT

PORTLAND CEMENT CONCRETE SIDEWALK, 5 INCH
 SPRINGFIELD:
 STA S 283+78.0 LT
 STA S 284+70.0 LT

NOTE:
 I. SEE SHEET 16 FOR FIRE HYDRANT PAVEMENT MARKING DETAIL.

SIGN LEGEND
 R = REMOVE
 S = SALVAGE
 N = NEW
 RET = RETAIN
 B-B = BACK TO BACK
 EXISTING = _____
 NEW = _____
 ⊙ = RETURN TO TOWN OF SPRINGFIELD

NOT TO SCALE
SPRINGFIELD PROJECT LAYOUT SHEET #21

PROJECT NAME: CHESTER-SPRINGFIELD-ROCKINGHAM-WINDSOR	PLOT DATE: 3/27/2015
PROJECT NUMBER: STP 2952(1)	DRAWN BY: A. KIRBY
FILE NAME: z13c518bdr_seg02.dgn	CHECKED BY: J. SHIELDS
PROJECT LEADER: D. GOZALKOWSKI	SHEET 128 OF 309
DESIGNED BY: A. HAWKINS	