
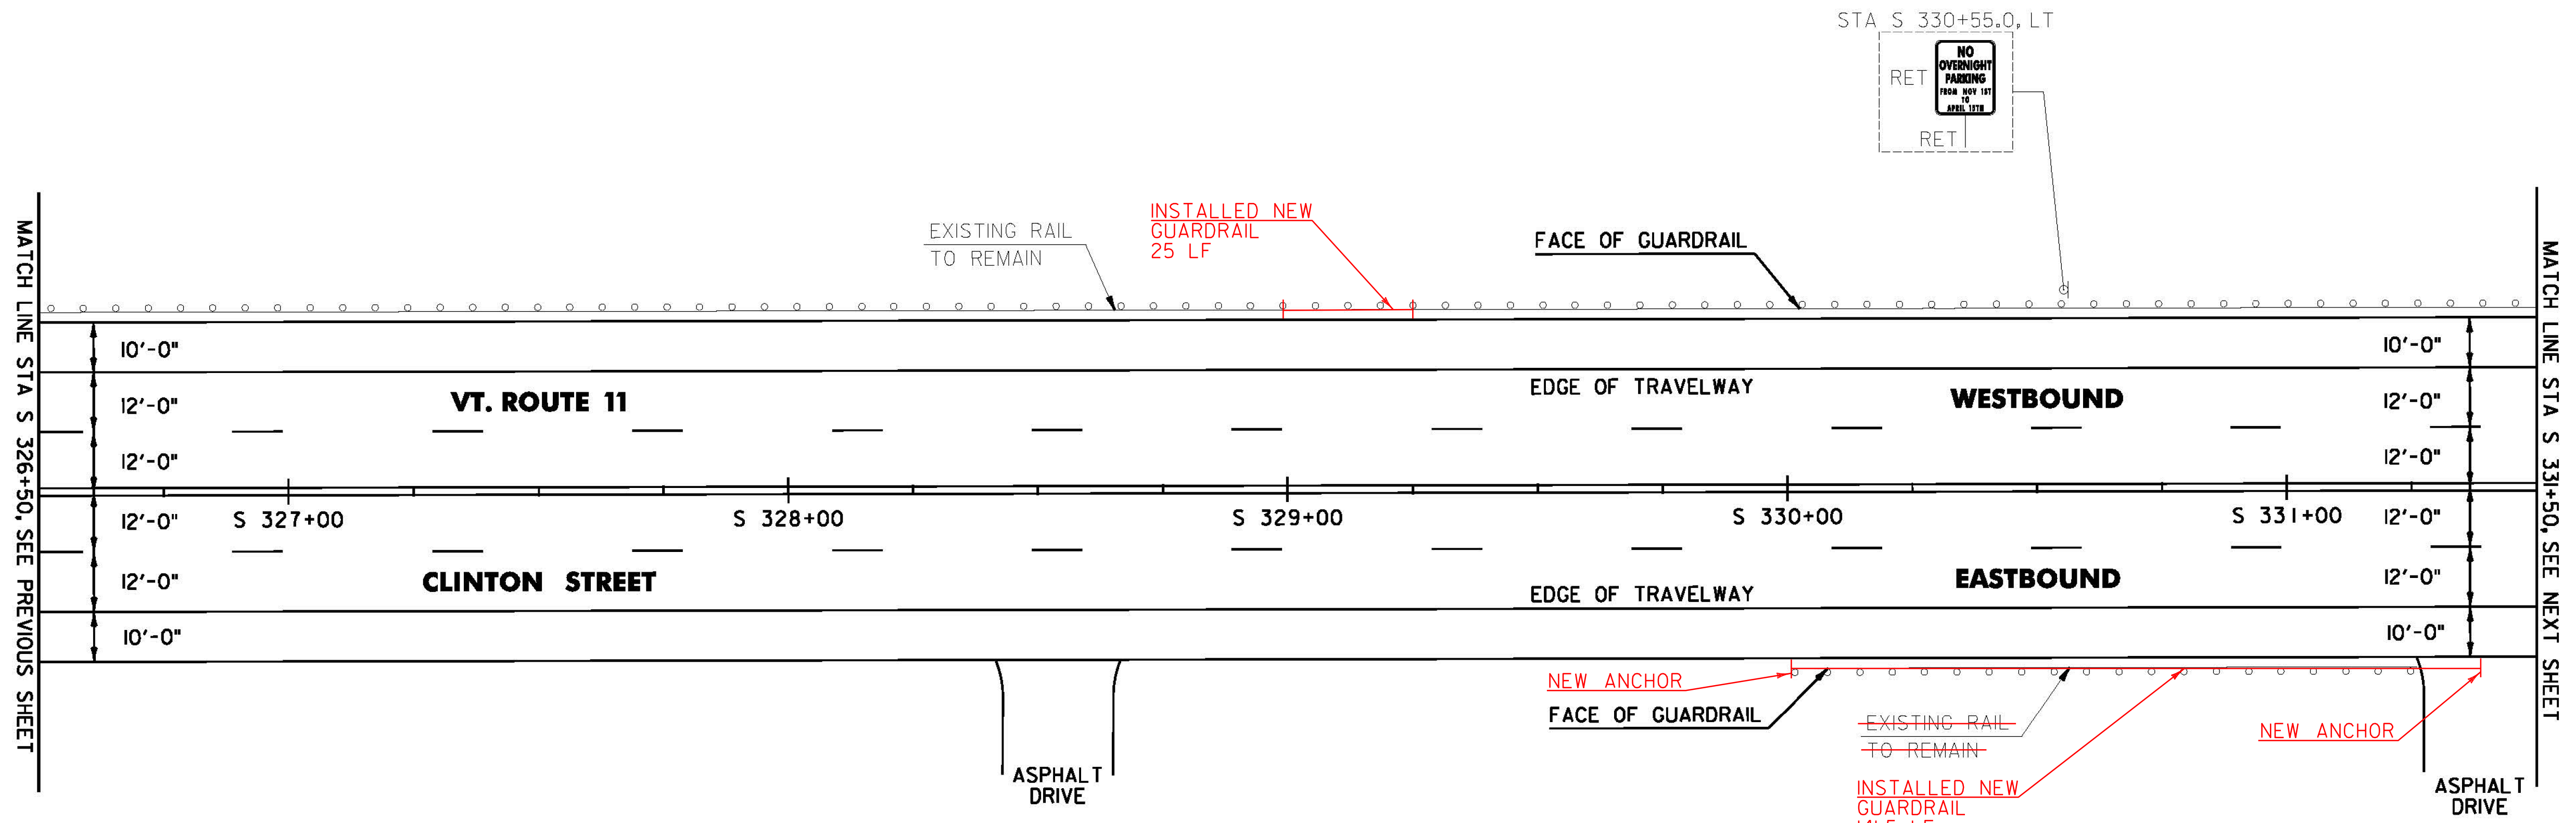


DURABLE 4 INCH WHITE LINE, TYPE A TAPE AND
 TEMPORARY 4 INCH WHITE LINE, PAINT
 (ALL LINES WILL INCLUDE EDGE LINE BREAKS AND
 RADIUS FOR TOWN HIGHWAYS)
 SPRINGFIELD:
 STA S 326+50.00 - STA S 331+50.00 EDGE LINE LT & RT
 STA S 326+50.00 - STA S 331+50.00 DASHED LANE LINE LT & RT

DURABLE 4 INCH YELLOW LINE, TYPE A TAPE AND
 TEMPORARY 4 INCH YELLOW LINE, PAINT
 (ALL LINES WILL INCLUDE C/L LINE BREAKS FOR TOWN HIGHWAYS)
 S = SOLID, D = DASHED
 SPRINGFIELD:
 STA S 326+50.00 - STA S 331+50.00 LT & RT
 S - S

STEEL BEAM GUARDRAIL, GALVANIZED
 STA S 329+00 - STA S 329+25, LT
 STA S 330+00 - STA S 331+41.5, RT

ANCHOR FOR STEEL BEAM GUARDRAIL
 STA S 330+00 RT
 STA S 331+41.5 RT

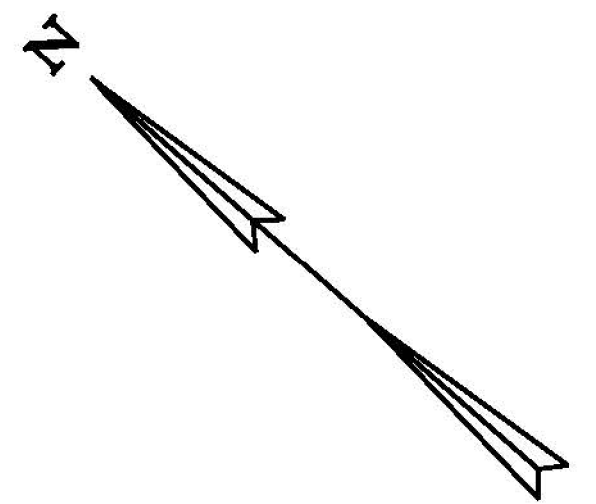

REMOVE AND REPLACE REFLECTOR UNIT

SPRINGFIELD:
 STA S 326+74.8 LT STA S 329+87.3 LT
 STA S 327+06.0 LT STA S 330+18.5 LT
 STA S 327+37.3 LT STA S 330+38.5 RT
 STA S 327+68.5 LT STA S 330+49.8 LT
 STA S 327+99.8 LT STA S 330+69.8 RT
 STA S 328+31.0 LT STA S 330+81.0 LT
 STA S 328+62.3 LT STA S 331+01.0 RT
 STA S 328+93.5 LT STA S 331+12.3 LT
 STA S 329+24.8 LT STA S 331+43.5 LT
 STA S 329+56.0 LT

SIGN LEGEND
 R = REMOVE
 S = SALVAGE
 N = NEW
 RET = RETAIN
 B-B = BACK TO BACK
 EXISTING = -----
 NEW = _____
 R = RETURN TO TOWN
 OF SPRINGFIELD

NOT TO SCALE

**SPRINGFIELD
 PROJECT
 LAYOUT
 SHEET #30**

PROJECT NAME: CHESTER-SPRINGFIELD-ROCKINGHAM-WINDSOR

PROJECT NUMBER: STP 2952(1)

FILE NAME: z13c518bdr_seg02.dgn

PROJECT LEADER: D. GOZALKOWSKI

DESIGNED BY: A. HAWKINS

PLOT DATE: 3/27/2015

DRAWN BY: A. KIRBY

CHECKED BY: J. SHIELDS

SHEET 137 OF 309