


COLD PLANE TYPICAL SECTION
 U.S. ROUTE 5 ROCKINGHAM STA R 0+00.00 TO STA R 2+00.00

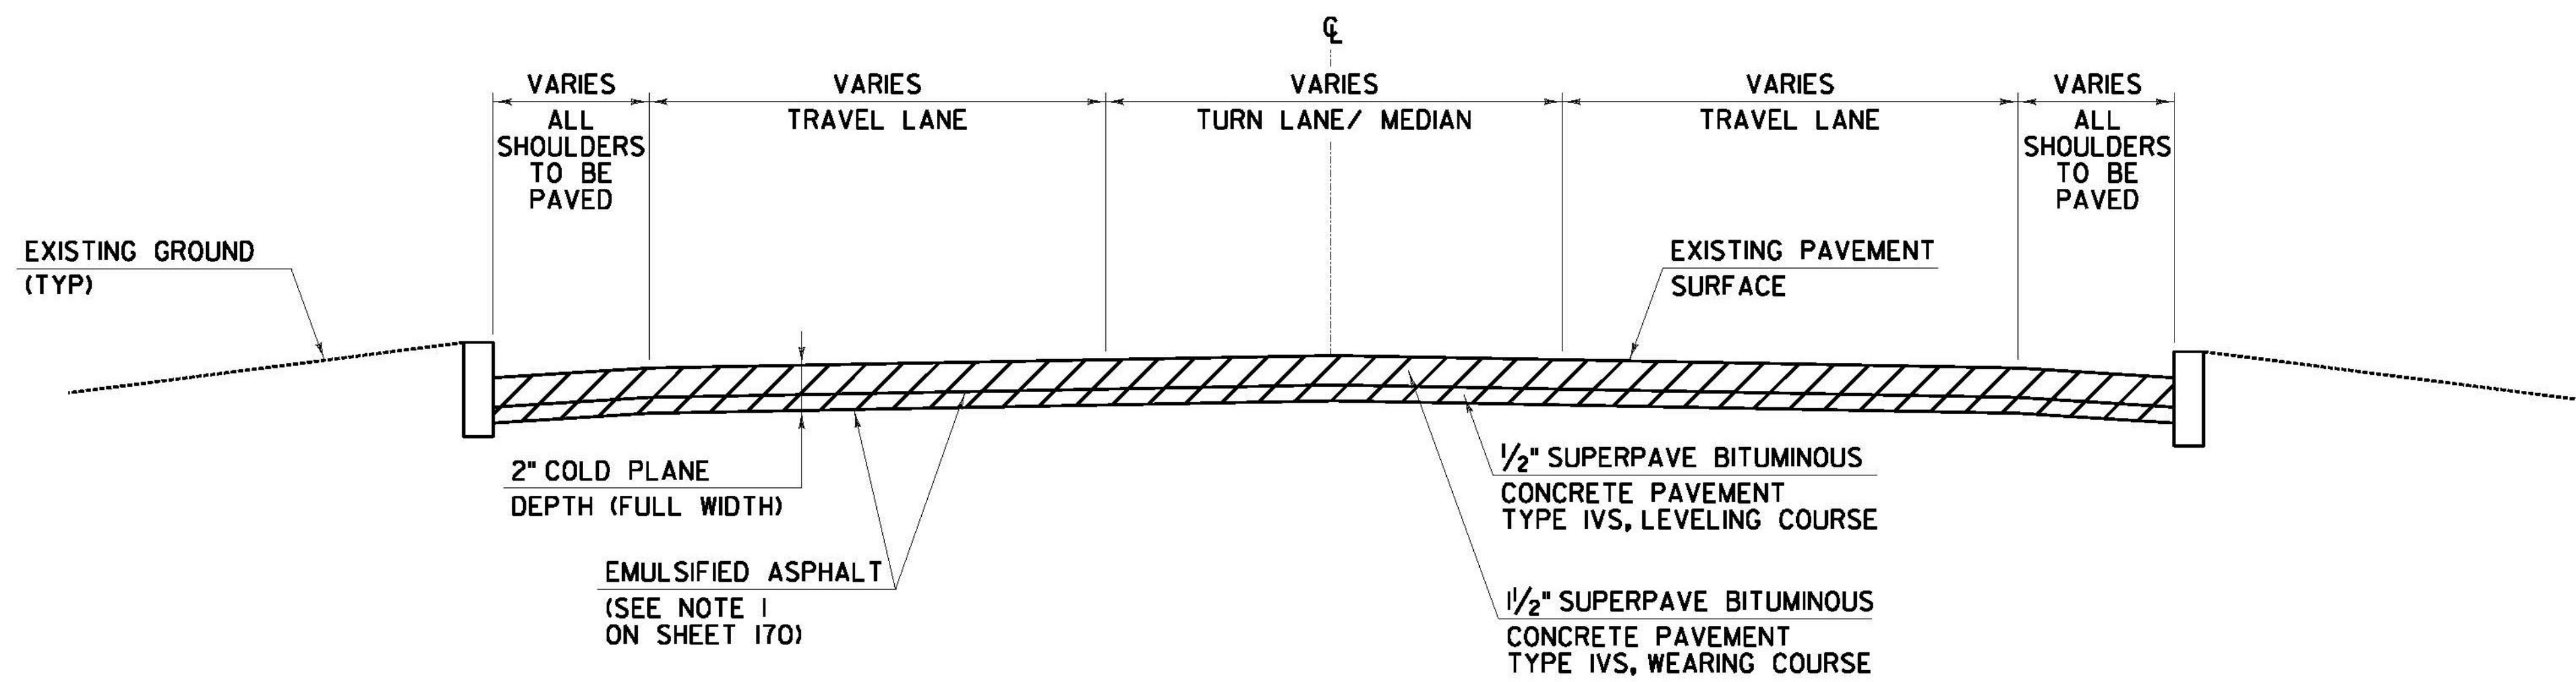

COLD PLANE TYPICAL SECTION
 U.S. ROUTE 5 ROCKINGHAM STA R 61+12.00 TO STA R 76+36.00

NOT TO SCALE

| | |
|--|--|
| ROCKINGHAM PROJECT TYPICAL SHEET #2 | PROJECT NAME: CHESTER-SPRINGFIELD-ROCKINGHAM-WINDSOR |
| | PROJECT NUMBER: STP 295211 |
| | FILE NAME: z13c518+ypbdr_seg03.dgn |
| DESIGNED BY: A. HAWKINS | PLOT DATE: 3/27/2015 |
| | DRAWN BY: A. KIRBY |
| | CHECKED BY: J. SHIELDS |
| | SHEET 171 OF 309 |