

DURABLE 4 INCH WHITE LINE, TYPE A TAPE AND TEMPORARY 4 INCH WHITE LINE, PAINT
 (ALL LINES WILL INCLUDE EDGE LINE BREAKS AND RADIUS FOR TOWN HIGHWAYS)
 ROCKINGHAM:
 STA R 0+00.00 - STA R 4+25.00 EDGE LINE LT & RT
 STA R 0+73.92 EDGE LINES RT, TH-416

DURABLE 4 INCH YELLOW LINE, TYPE A TAPE AND TEMPORARY 4 INCH YELLOW LINE, PAINT
 (ALL LINES WILL INCLUDE C/L LINE BREAKS FOR TOWN HIGHWAYS)
 S = SOLID, D = DASHED
 ROCKINGHAM:
 STA R 0+00.00 - STA R 4+25.00 LT C RT
 STA R 0+73.92 DOUBLE SOLID RT, TH-416

DURABLE 24 INCH STOP BAR, TYPE A TAPE AND TEMPORARY 24 INCH STOP BAR, PAINT
 ROCKINGHAM:
 STA R 0+73.92 RT, TH-416

DURABLE LETTER OR SYMBOL, TYPE D TAPE
 ROCKINGHAM:
 STA R 0+73.92, TH-416 "S,T,O,P" (4 EA)



TEMPORARY LETTER OR SYMBOL, PAINT
 ROCKINGHAM:
 STA R 0+73.92, TH-416 "S,T,O,P" (8 EA)

DURABLE CROSSWALK MARKING, TYPE A TAPE AND TEMPORARY CROSSWALK MARKING, PAINT
 ROCKINGHAM:
 STA R 2+69.28 RT, TH-416
 STA R 2+85.00 LT/RT

DURABLE 8 INCH WHITE LINE, TYPE A TAPE
 ROCKINGHAM:
 STA R 0+22.00 - STA R 0+34.00 RT, FIRE HYDRANT, NO PARKING
 STA R 2+61.00 - STA R 2+81.00 LT, NO PARKING

REMOVING SIGNS AS SHOWN - 8

ERECTING SALVAGED SIGNS AS SHOWN - 1

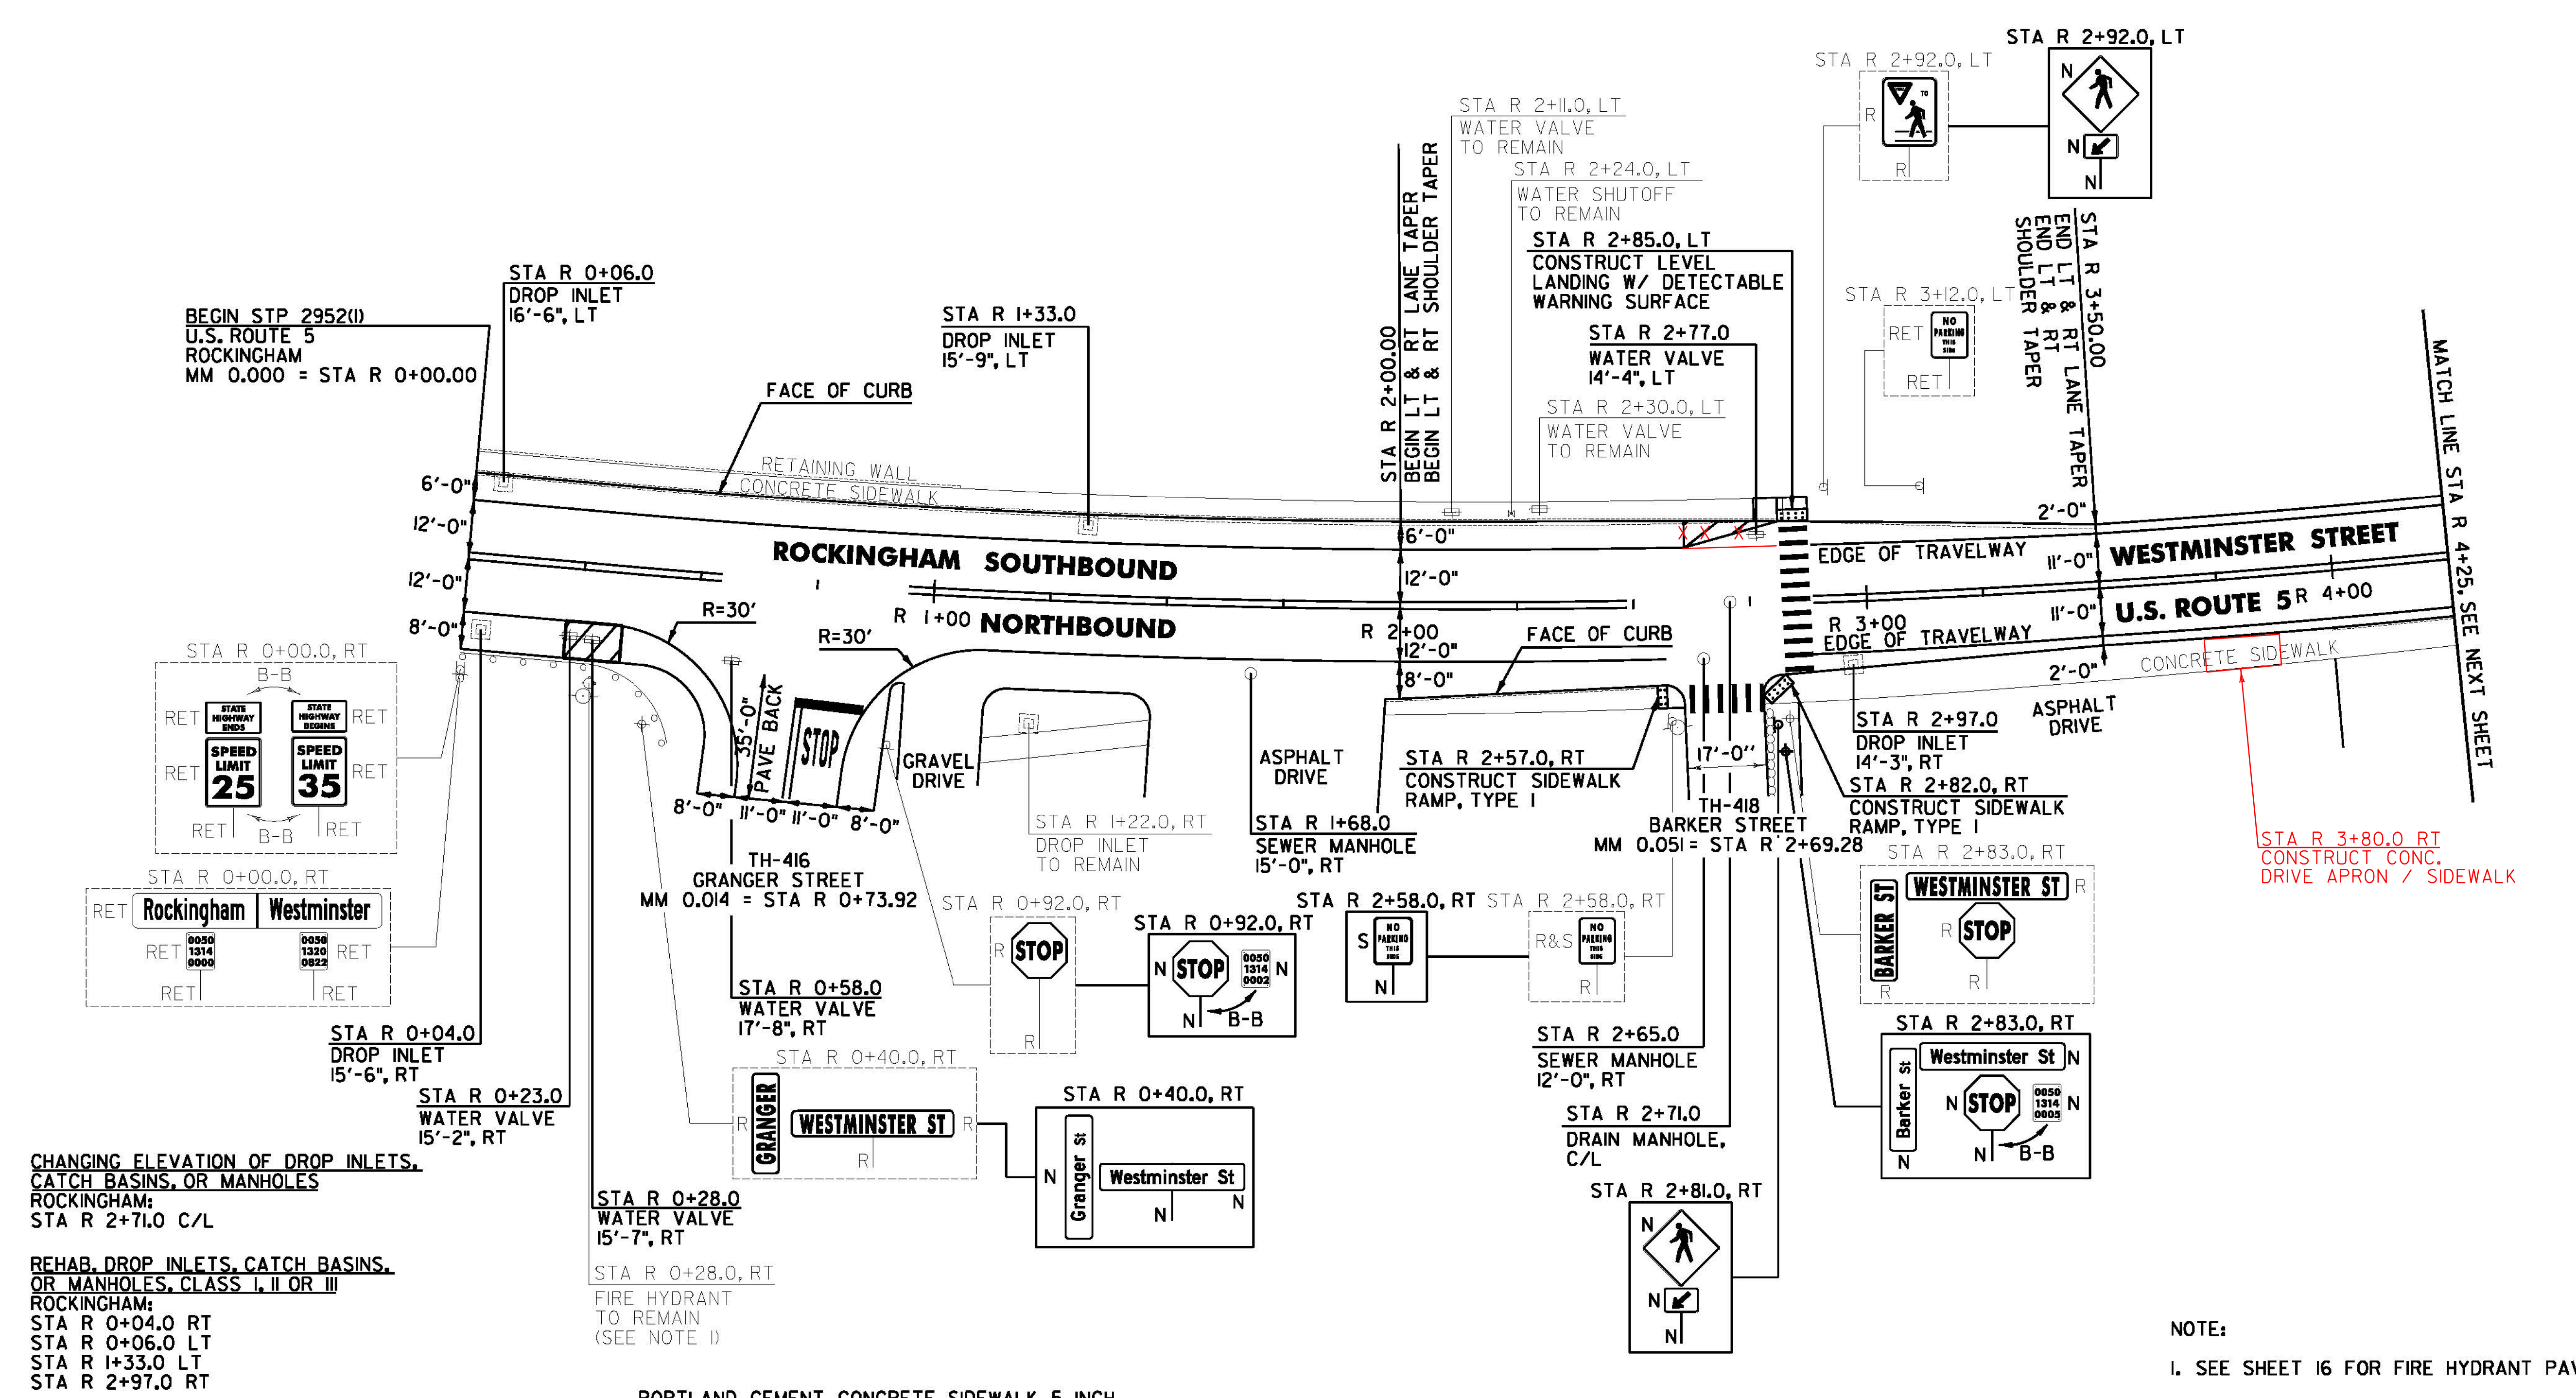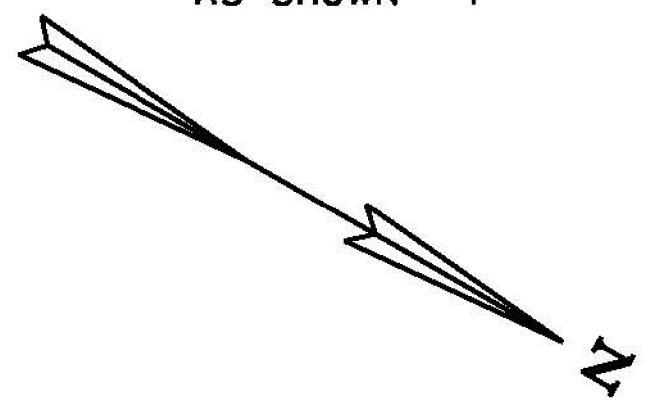

CHANGING ELEVATION OF DROP INLETS, CATCH BASINS, OR MANHOLES
 ROCKINGHAM:
 STA R 2+71.0 C/L

REHAB. DROP INLETS, CATCH BASINS, OR MANHOLES, CLASS I, II OR III
 ROCKINGHAM:
 STA R 0+04.0 RT
 STA R 0+06.0 LT
 STA R 1+33.0 LT
 STA R 2+97.0 RT

CHANGING ELEVATION OF SEWER MANHOLES
 ROCKINGHAM:
 STA R 1+68.0 RT
 STA R 2+65.0 RT

REMOVING AND RESETTING CURB
 ROCKINGHAM:
 STA R 2+57.0 RT
 STA R 2+85.0 LT

PORTLAND CEMENT CONCRETE SIDEWALK, 5 INCH
 ROCKINGHAM:
 STA R 2+57.0 RT
 STA R 2+82.0 RT
 STA R 2+85.0 LT
 STA R 3+80.0 RT

DETECTABLE WARNING SURFACE
 ROCKINGHAM:
 STA R 2+57.0 RT
 STA R 2+82.0 RT
 STA R 2+85.0 LT

ADJUST ELEVATION OF VALVE BOX
 ROCKINGHAM:
 STA R 0+23.0 RT
 STA R 0+28.0 RT
 STA R 0+58.0 RT
 STA R 2+77.0 LT

SIGN LEGEND
 R = REMOVE
 S = SALVAGE
 N = NEW
 RET = RETAIN
 B-B = BACK TO BACK
 EXISTING = _____
 NEW = _____
 R = RETURN TO TOWN OF ROCKINGHAM

NOT TO SCALE
ROCKINGHAM PROJECT LAYOUT SHEET #1

PROJECT NAME: CHESTER-SPRINGFIELD-ROCKINGHAM-WINDSOR
PROJECT NUMBER: STP 2952(1)
FILE NAME: z13c518bdr_seg03.dgn
PROJECT LEADER: D. GOZALKOWSKI
DESIGNED BY: A. HAWKINS

PLOT DATE: 3/27/2015
DRAWN BY: A. KIRBY
CHECKED BY: J. SHIELDS
SHEET 179 OF 309

NOTE:
 I. SEE SHEET 16 FOR FIRE HYDRANT PAVEMENT MARKING DETAIL.

STA R 3+80.0 RT CONSTRUCT CONC. DRIVE APRON / SIDEWALK