

DURABLE 4 INCH WHITE LINE, TYPE A TAPE AND  
TEMPORARY 4 INCH WHITE LINE, PAINT  
(ALL LINES WILL INCLUDE EDGE LINE BREAKS AND RADIUS FOR  
TOWN HIGHWAYS)  
ROCKINGHAM:  
STA R 4+25.00 - STA R 8+25.00 EDGE LINE LT & RT

DURABLE 4 INCH YELLOW LINE, TYPE A TAPE AND  
TEMPORARY 4 INCH YELLOW LINE, PAINT  
(ALL LINES WILL INCLUDE C/L LINE BREAKS FOR TOWN HIGHWAYS)  
S = SOLID, D = DASHED  
ROCKINGHAM:  
STA R 4+25.00 - STA R 8+25.00



LT C RT  
S - S

DURABLE CROSSWALK MARKING, TYPE A TAPE AND  
TEMPORARY CROSSWALK MARKING, PAINT

ROCKINGHAM:  
STA R 8+07.84 RT, TH-418

DURABLE 8 INCH WHITE LINE, TYPE A TAPE  
ROCKINGHAM:  
STA R 4+38.00 - STA R 4+50.00 LT, FIRE HYDRANT, NO PARKING

REMOVING SIGNS  
AS SHOWN - 6

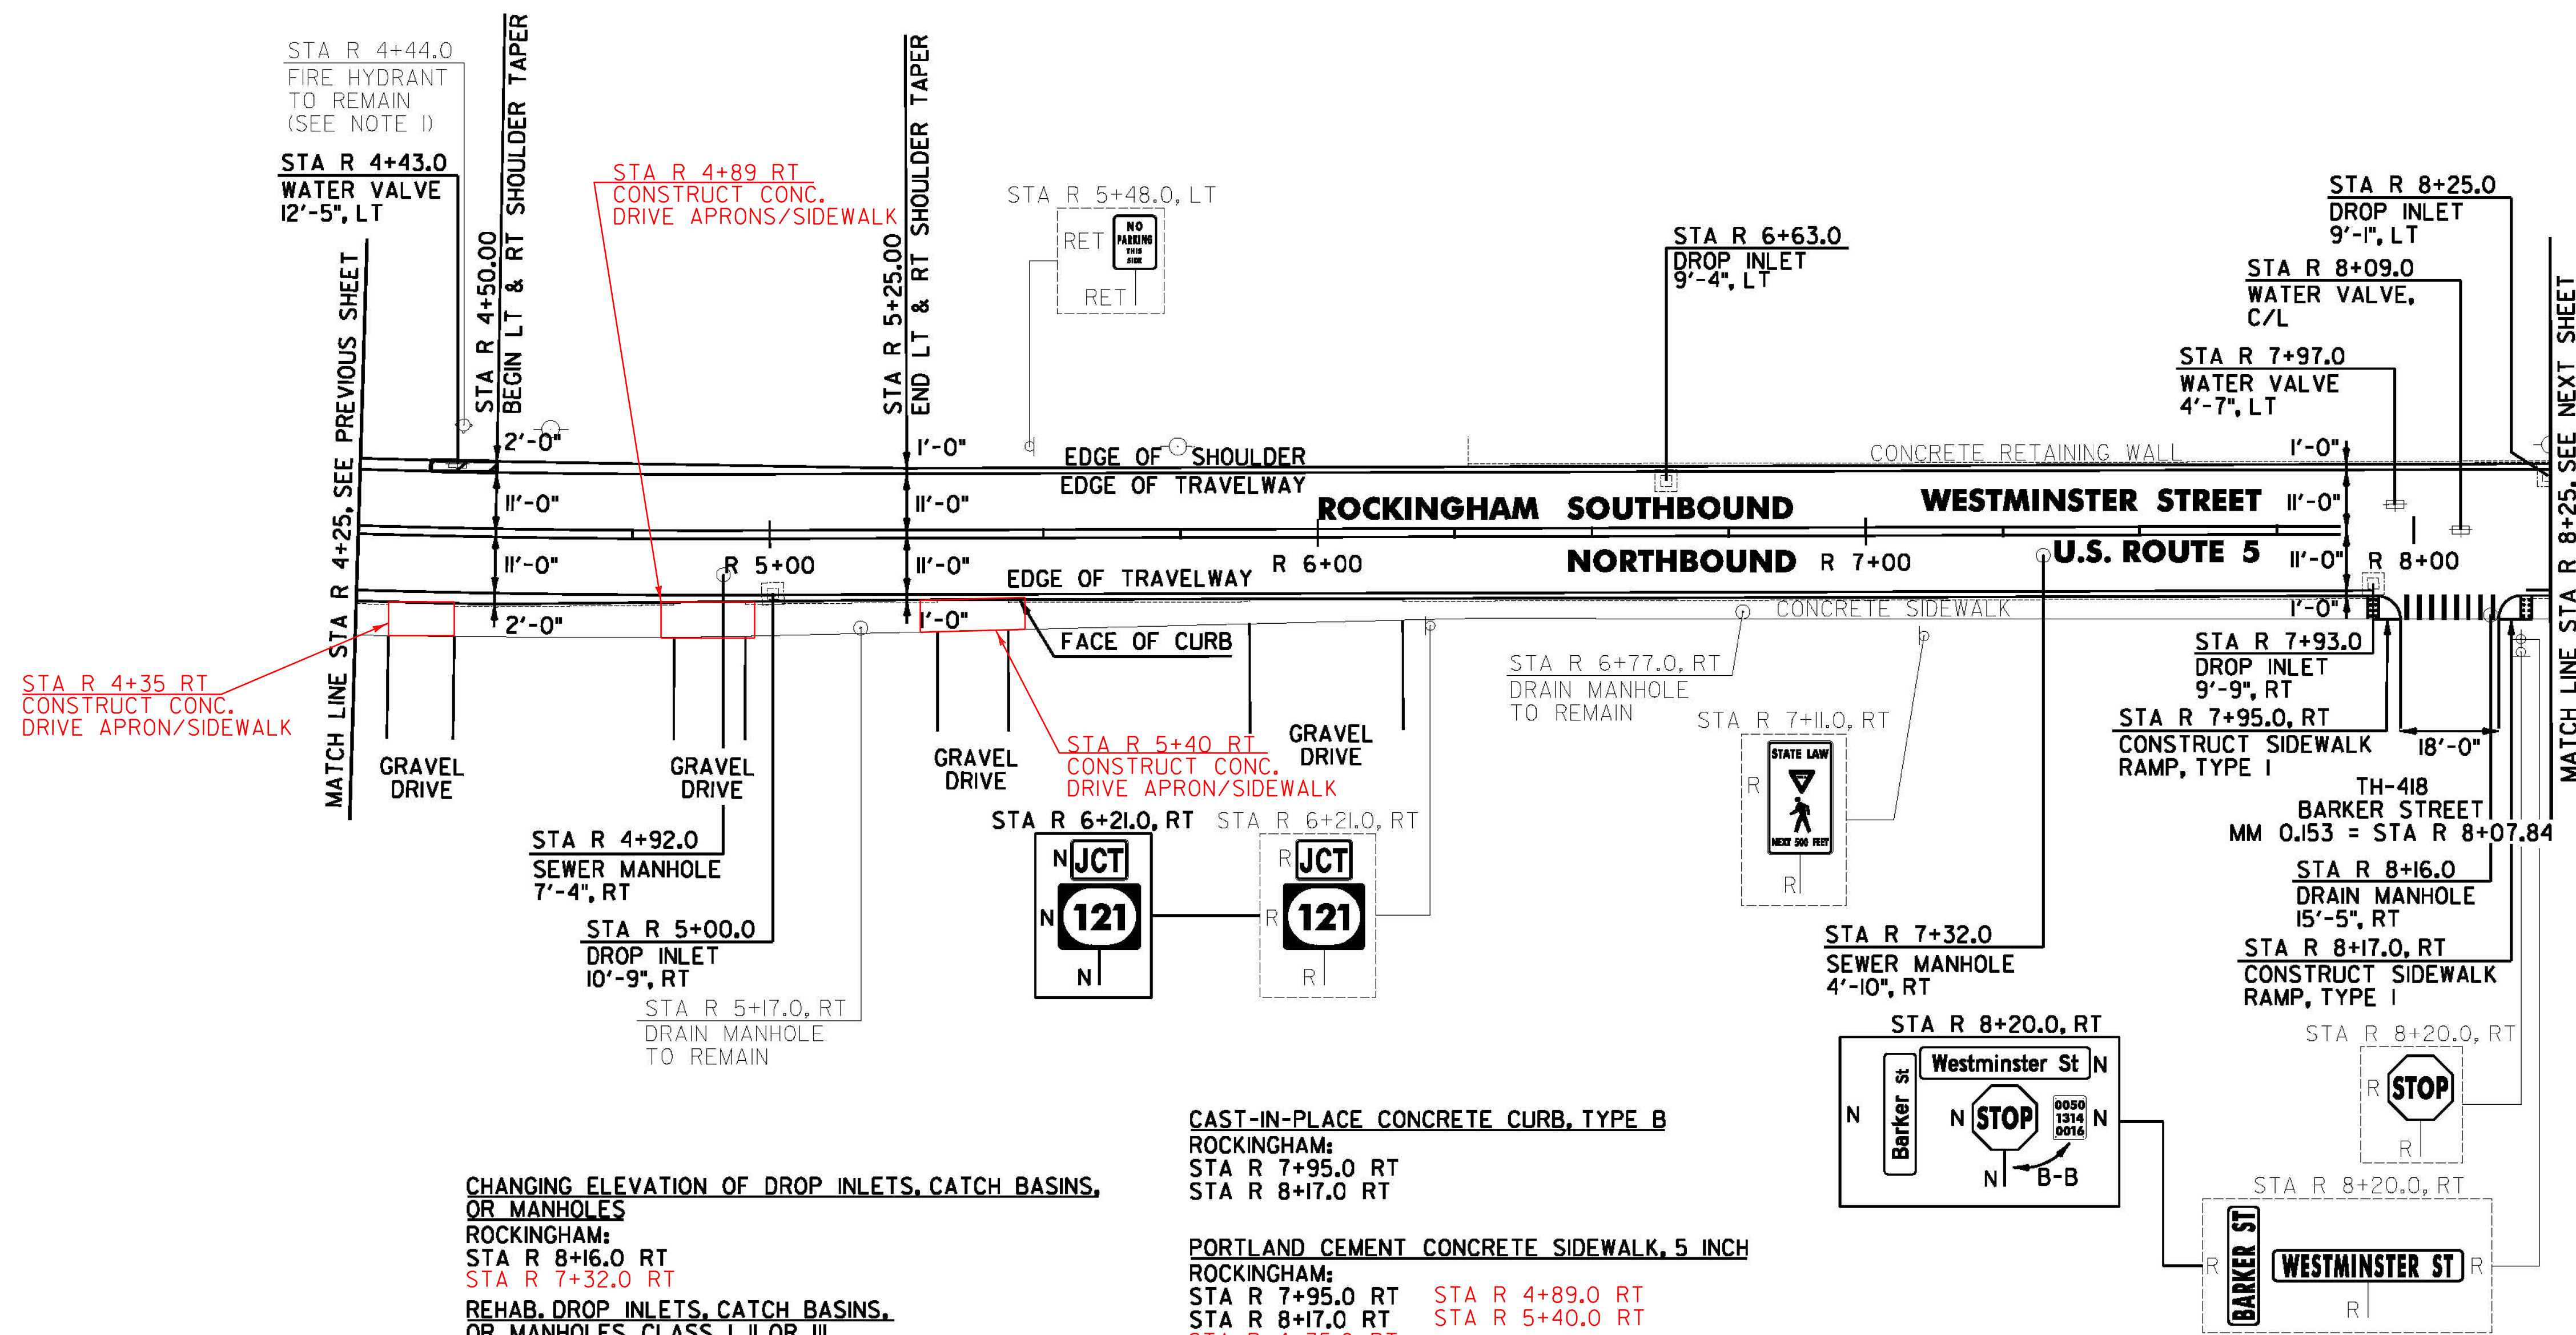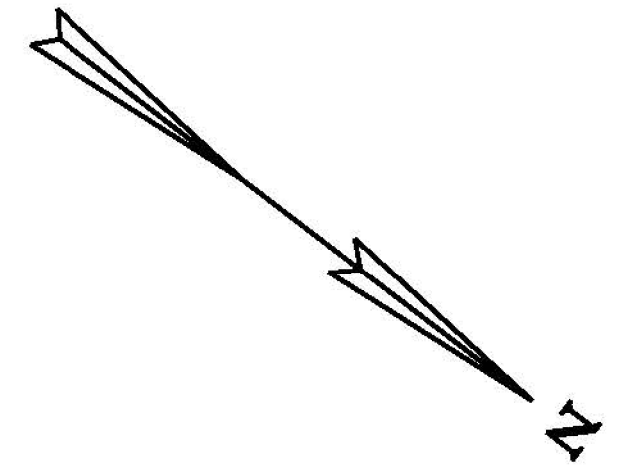

CHANGING ELEVATION OF DROP INLETS, CATCH BASINS,  
OR MANHOLES  
ROCKINGHAM:  
STA R 8+16.0 RT  
STA R 7+32.0 RT  
REHAB. DROP INLETS, CATCH BASINS,  
OR MANHOLES, CLASS I, II OR III  
ROCKINGHAM:  
STA R 5+00.0 RT  
STA R 6+63.0 LT  
STA R 7+93.0 RT  
STA R 8+25.0 LT

CHANGING ELEVATION OF SEWER MANHOLES  
ROCKINGHAM:  
STA R 4+92.0 RT  
STA R 7+32.0 RT

CAST-IN-PLACE CONCRETE CURB, TYPE B  
ROCKINGHAM:  
STA R 7+95.0 RT  
STA R 8+17.0 RT

PORTLAND CEMENT CONCRETE SIDEWALK, 5 INCH  
ROCKINGHAM:  
STA R 7+95.0 RT STA R 4+89.0 RT  
STA R 8+17.0 RT STA R 5+40.0 RT  
STA R 4+35.0 RT  
DETECTABLE WARNING SURFACE  
ROCKINGHAM:  
STA R 7+95.0 RT  
STA R 8+17.0 RT

ADJUST ELEVATION OF VALVE BOX  
ROCKINGHAM:  
STA R 4+43.0 LT  
STA R 7+97.0 LT  
STA R 8+09.0 C/L

**SIGN LEGEND**  
R = REMOVE  
S = SALVAGE  
N = NEW  
RET = RETAIN  
B-B = BACK TO BACK  
EXISTING = \_\_\_\_\_  
NEW = \_\_\_\_\_  
R = RETURN TO TOWN  
OF ROCKINGHAM

NOT TO SCALE

**ROCKINGHAM  
PROJECT  
LAYOUT  
SHEET #2**

PROJECT NAME: CHESTER-SPRINGFIELD-ROCKINGHAM-WINDSOR  
PROJECT NUMBER: STP 2952(1)

FILE NAME: z13c518bdr\_seg03.dgn  
PROJECT LEADER: D. GOZALKOWSKI  
DESIGNED BY: A. HAWKINS

PLOT DATE: 3/27/2015  
DRAWN BY: A. KIRBY  
CHECKED BY: J. SHIELDS  
SHEET 180 OF 309

NOTE:  
I. SEE SHEET 16 FOR FIRE HYDRANT PAVEMENT  
MARKING DETAIL.