

**DURABLE 4 INCH WHITE LINE, TYPE A TAPE AND TEMPORARY 4 INCH WHITE LINE, PAINT**  
 (ALL LINES WILL INCLUDE EDGE LINE BREAKS AND RADIUS FOR TOWN HIGHWAYS)  
 ROCKINGHAM:  
 STA R 8+25.00 - STA R 12+25.00 EDGE LINE LT & RT  
 STA R 10+77.12 EDGE LINES LT, TH-412

**DURABLE 4 INCH YELLOW LINE, TYPE A TAPE AND TEMPORARY 4 INCH YELLOW LINE, PAINT**  
 (ALL LINES WILL INCLUDE C/L LINE BREAKS FOR TOWN HIGHWAYS)  
 S = SOLID, D = DASHED  
 ROCKINGHAM:  
 STA R 8+25.00 - STA R 12+25.00  
 STA R 10+77.12 DOUBLE SOLID LT, TH-412



**DURABLE 24 INCH STOP BAR, TYPE A TAPE AND TEMPORARY 24 INCH STOP BAR, PAINT**  
 ROCKINGHAM:  
 STA R 10+77.12 LT, TH-412

**DURABLE LETTER OR SYMBOL, TYPE D TAPE**  
 ROCKINGHAM:  
 STA R 10+77.12 LT, TH-412 "S,T,O,P" (4 EA)

**TEMPORARY LETTER OR SYMBOL, PAINT**  
 ROCKINGHAM:  
 STA R 10+77.12 LT, TH-412 "S,T,O,P" (8 EA)

**DURABLE CROSSWALK MARKING, TYPE A TAPE AND TEMPORARY CROSSWALK MARKING, PAINT**  
 ROCKINGHAM:  
 STA R 11+44.0 LT/RT

REMOVING SIGNS AS SHOWN - 14

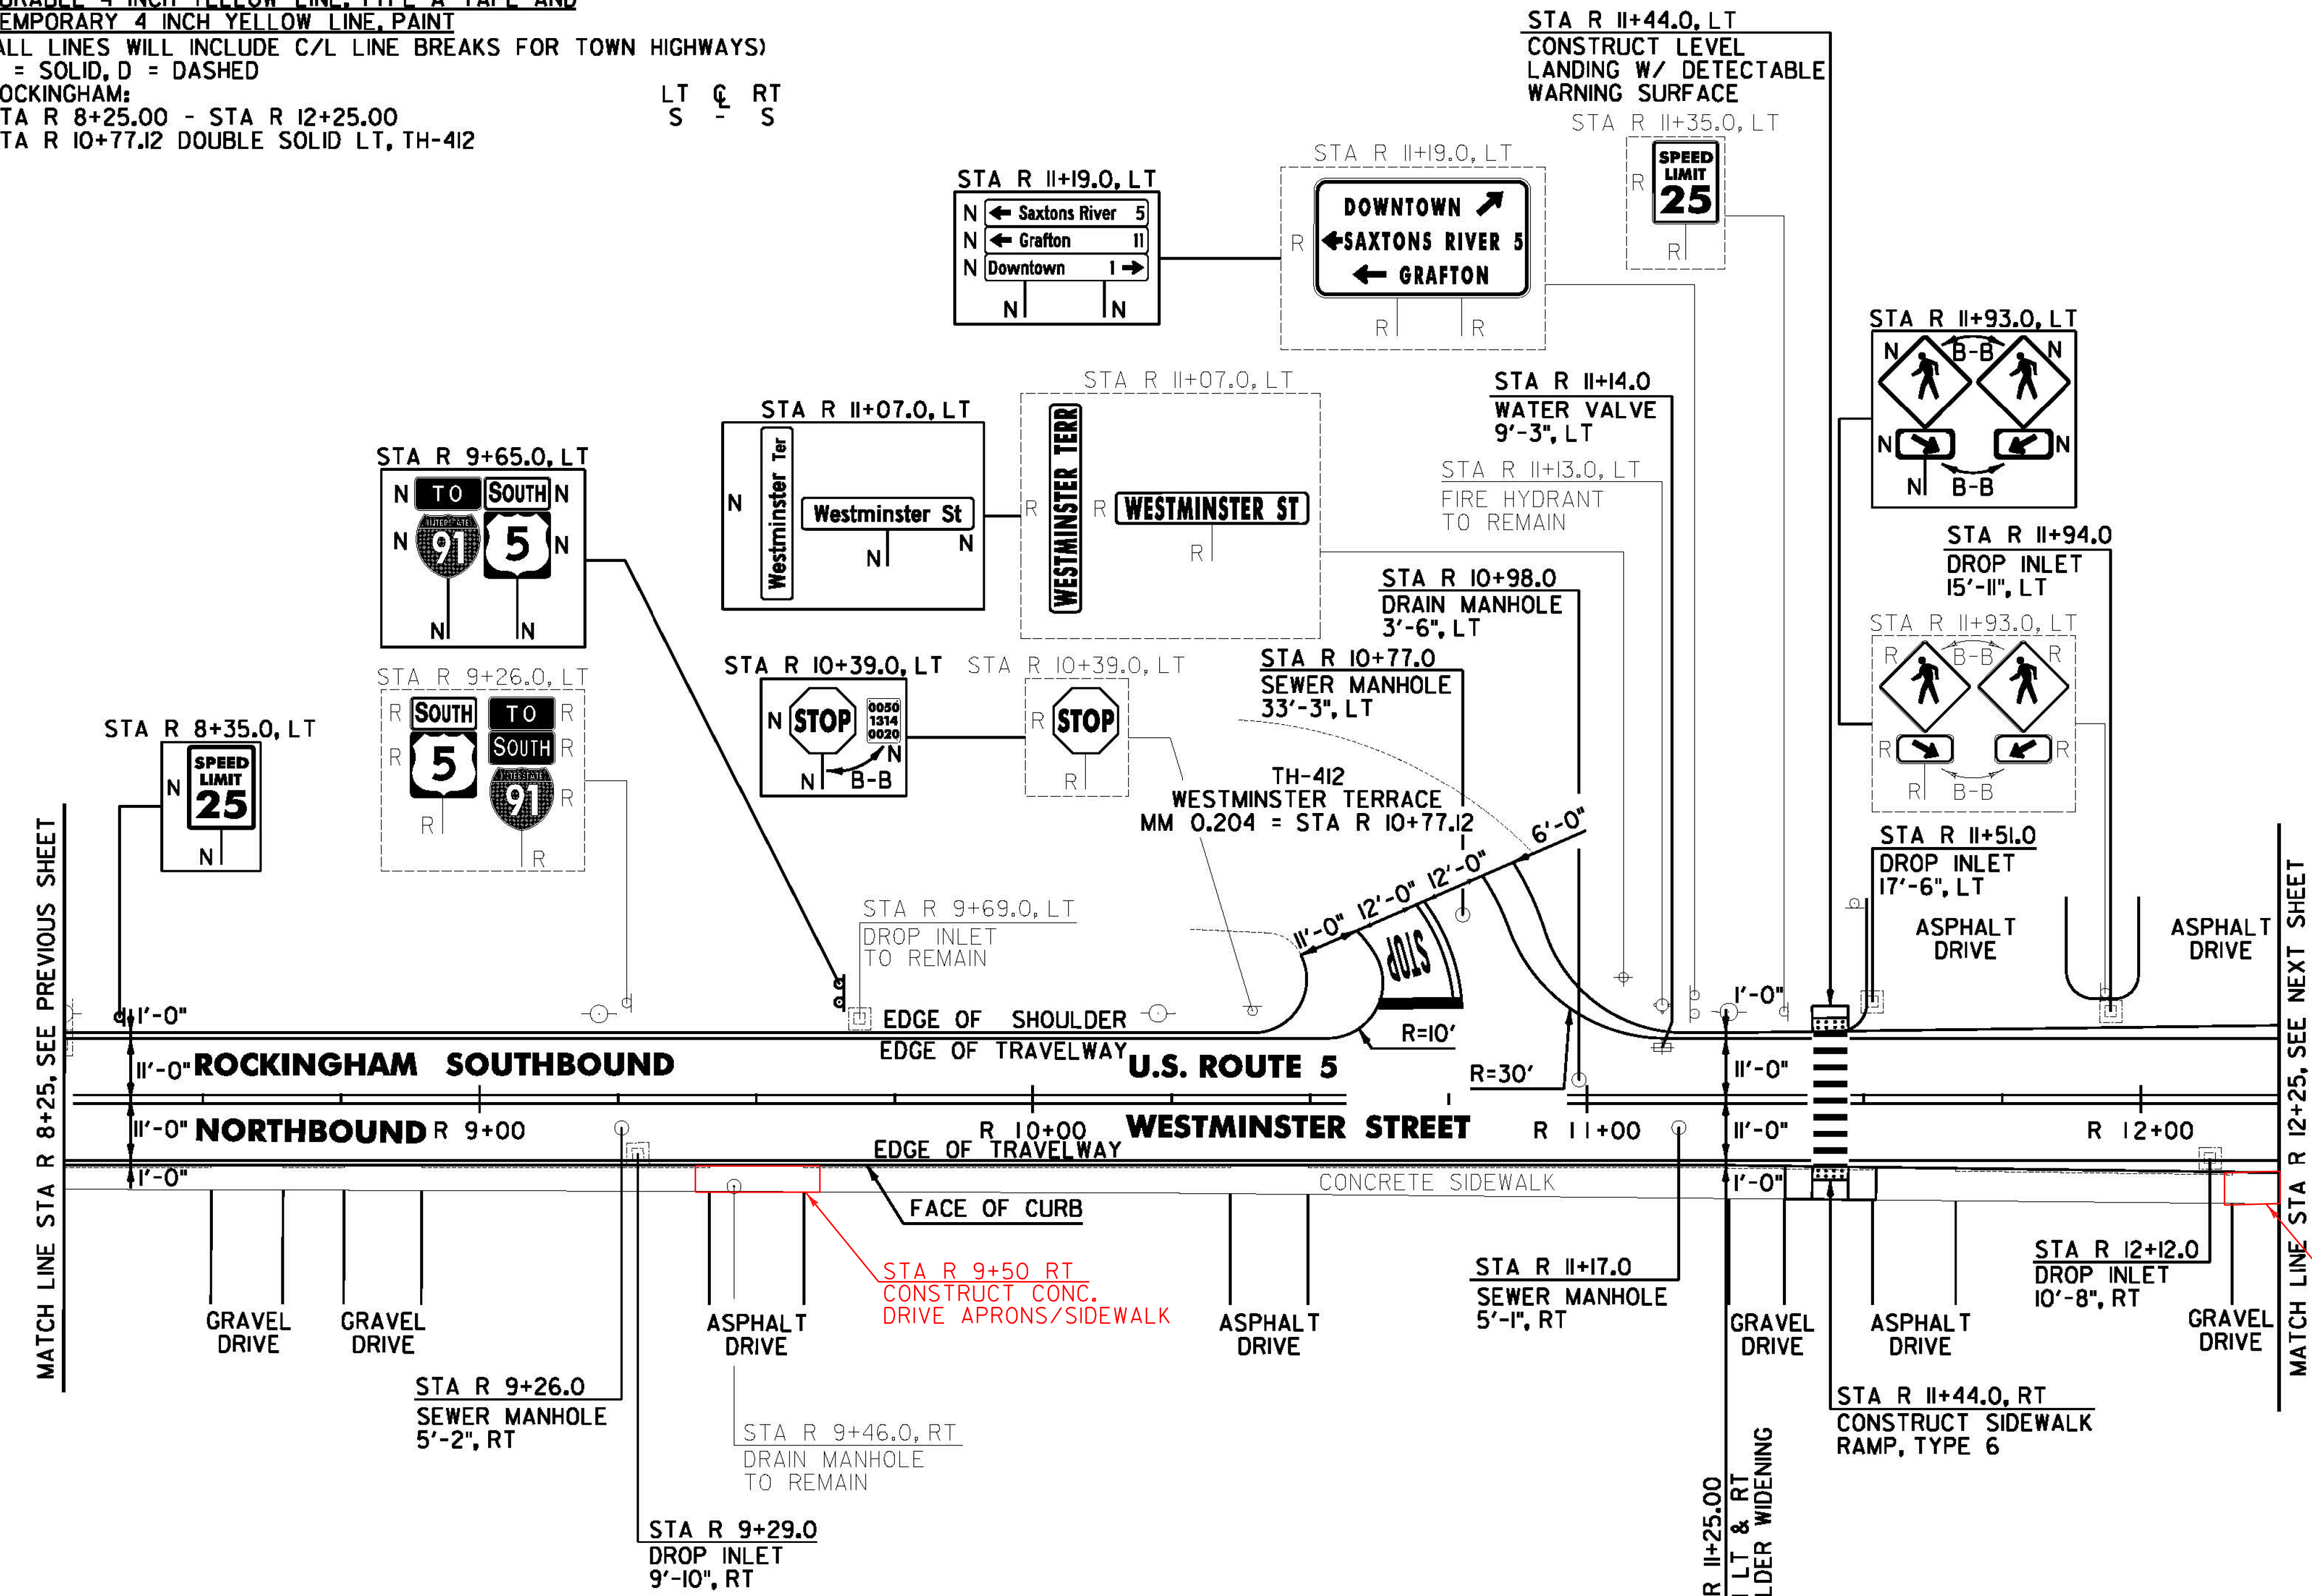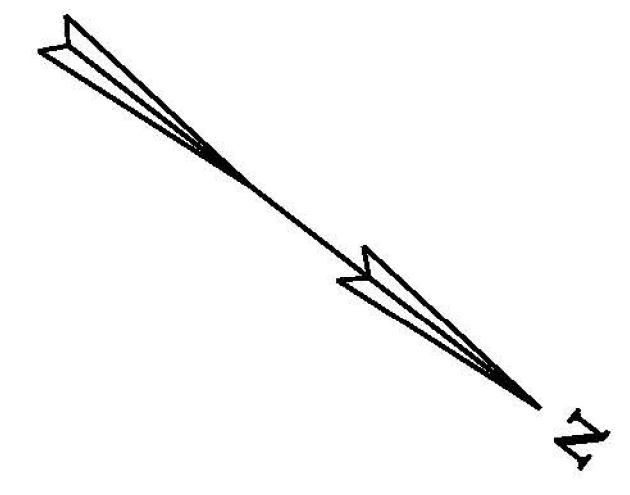

**CHANGING ELEVATION OF DROP INLETS, CATCH BASINS, OR MANHOLES**  
 ROCKINGHAM:  
 STA R 10+98.0 LT

**REHAB. DROP INLETS, CATCH BASINS, OR MANHOLES, CLASS I, II OR III**  
 ROCKINGHAM:  
 STA R 9+29.0 RT  
 STA R 11+51.0 LT  
 STA R 11+94.0 LT  
 STA R 12+12.0 RT

**CHANGING ELEVATION OF SEWER MANHOLES**  
 ROCKINGHAM:  
 STA R 9+26.0 RT  
 STA R 10+77.0 LT  
 STA R 11+17.0 RT

**CAST-IN-PLACE CONCRETE CURB, TYPE B**  
 ROCKINGHAM:  
 STA R 11+44.0 RT

**PORTLAND CEMENT CONCRETE SIDEWALK, 5 INCH**  
 ROCKINGHAM:  
 STA R 11+44.0 LT STA R 12+25.0 RT  
 STA R 11+44.0 RT  
 STA R 9+50.0 RT

**DETECTABLE WARNING SURFACE**  
 ROCKINGHAM:  
 STA R 11+44.0 LT  
 STA R 11+44.0 RT

**ADJUST ELEVATION OF VALVE BOX**  
 ROCKINGHAM:  
 STA R 11+4.0 LT

**SIGN LEGEND**  
 R = REMOVE  
 S = SALVAGE  
 N = NEW  
 RET = RETAIN  
 B-B = BACK TO BACK  
 EXISTING = \_\_\_\_\_  
 NEW = \_\_\_\_\_  
 R = RETURN TO TOWN OF ROCKINGHAM

**NOT TO SCALE**  
**ROCKINGHAM PROJECT LAYOUT SHEET #3**

PROJECT NAME: CHESTER-SPRINGFIELD-ROCKINGHAM-WINDSOR  
 PROJECT NUMBER: STP 2952(1)  
 FILE NAME: z13c518bdr\_seg03.dgn  
 PROJECT LEADER: D. GOZALKOWSKI  
 DESIGNED BY: A. HAWKINS  
 PLOT DATE: 3/27/2015  
 DRAWN BY: A. KIRBY  
 CHECKED BY: J. SHIELDS  
 SHEET 181 OF 309