



DURABLE 4 INCH WHITE LINE, TYPE A TAPE AND  
 TEMPORARY 4 INCH WHITE LINE, PAINT  
 (ALL LINES WILL INCLUDE EDGE LINE BREAKS AND RADIUS FOR  
 TOWN HIGHWAYS)  
 ROCKINGHAM:  
 STA R 15+50.00 - STA R 19+50.00 EDGE LINE LT & RT

DURABLE 4 INCH YELLOW LINE, TYPE A TAPE AND  
 TEMPORARY 4 INCH YELLOW LINE, PAINT  
 (ALL LINES WILL INCLUDE C/L LINE BREAKS FOR TOWN HIGHWAYS)  
 S = SOLID, D = DASHED  
 ROCKINGHAM:  
 STA R 15+50.00 - STA R 19+50.00

LT C RT  
 S - S

REMOVING SIGNS  
 AS SHOWN - 14  
 ERECTING SALVAGED SIGNS  
 AS SHOWN - 4

DURABLE 8 INCH WHITE LINE, TYPE A TAPE  
 ROCKINGHAM:  
 STA R 15+80.00 - STA R 15+92.00 LT, FIRE HYDRANT, NO PARKING

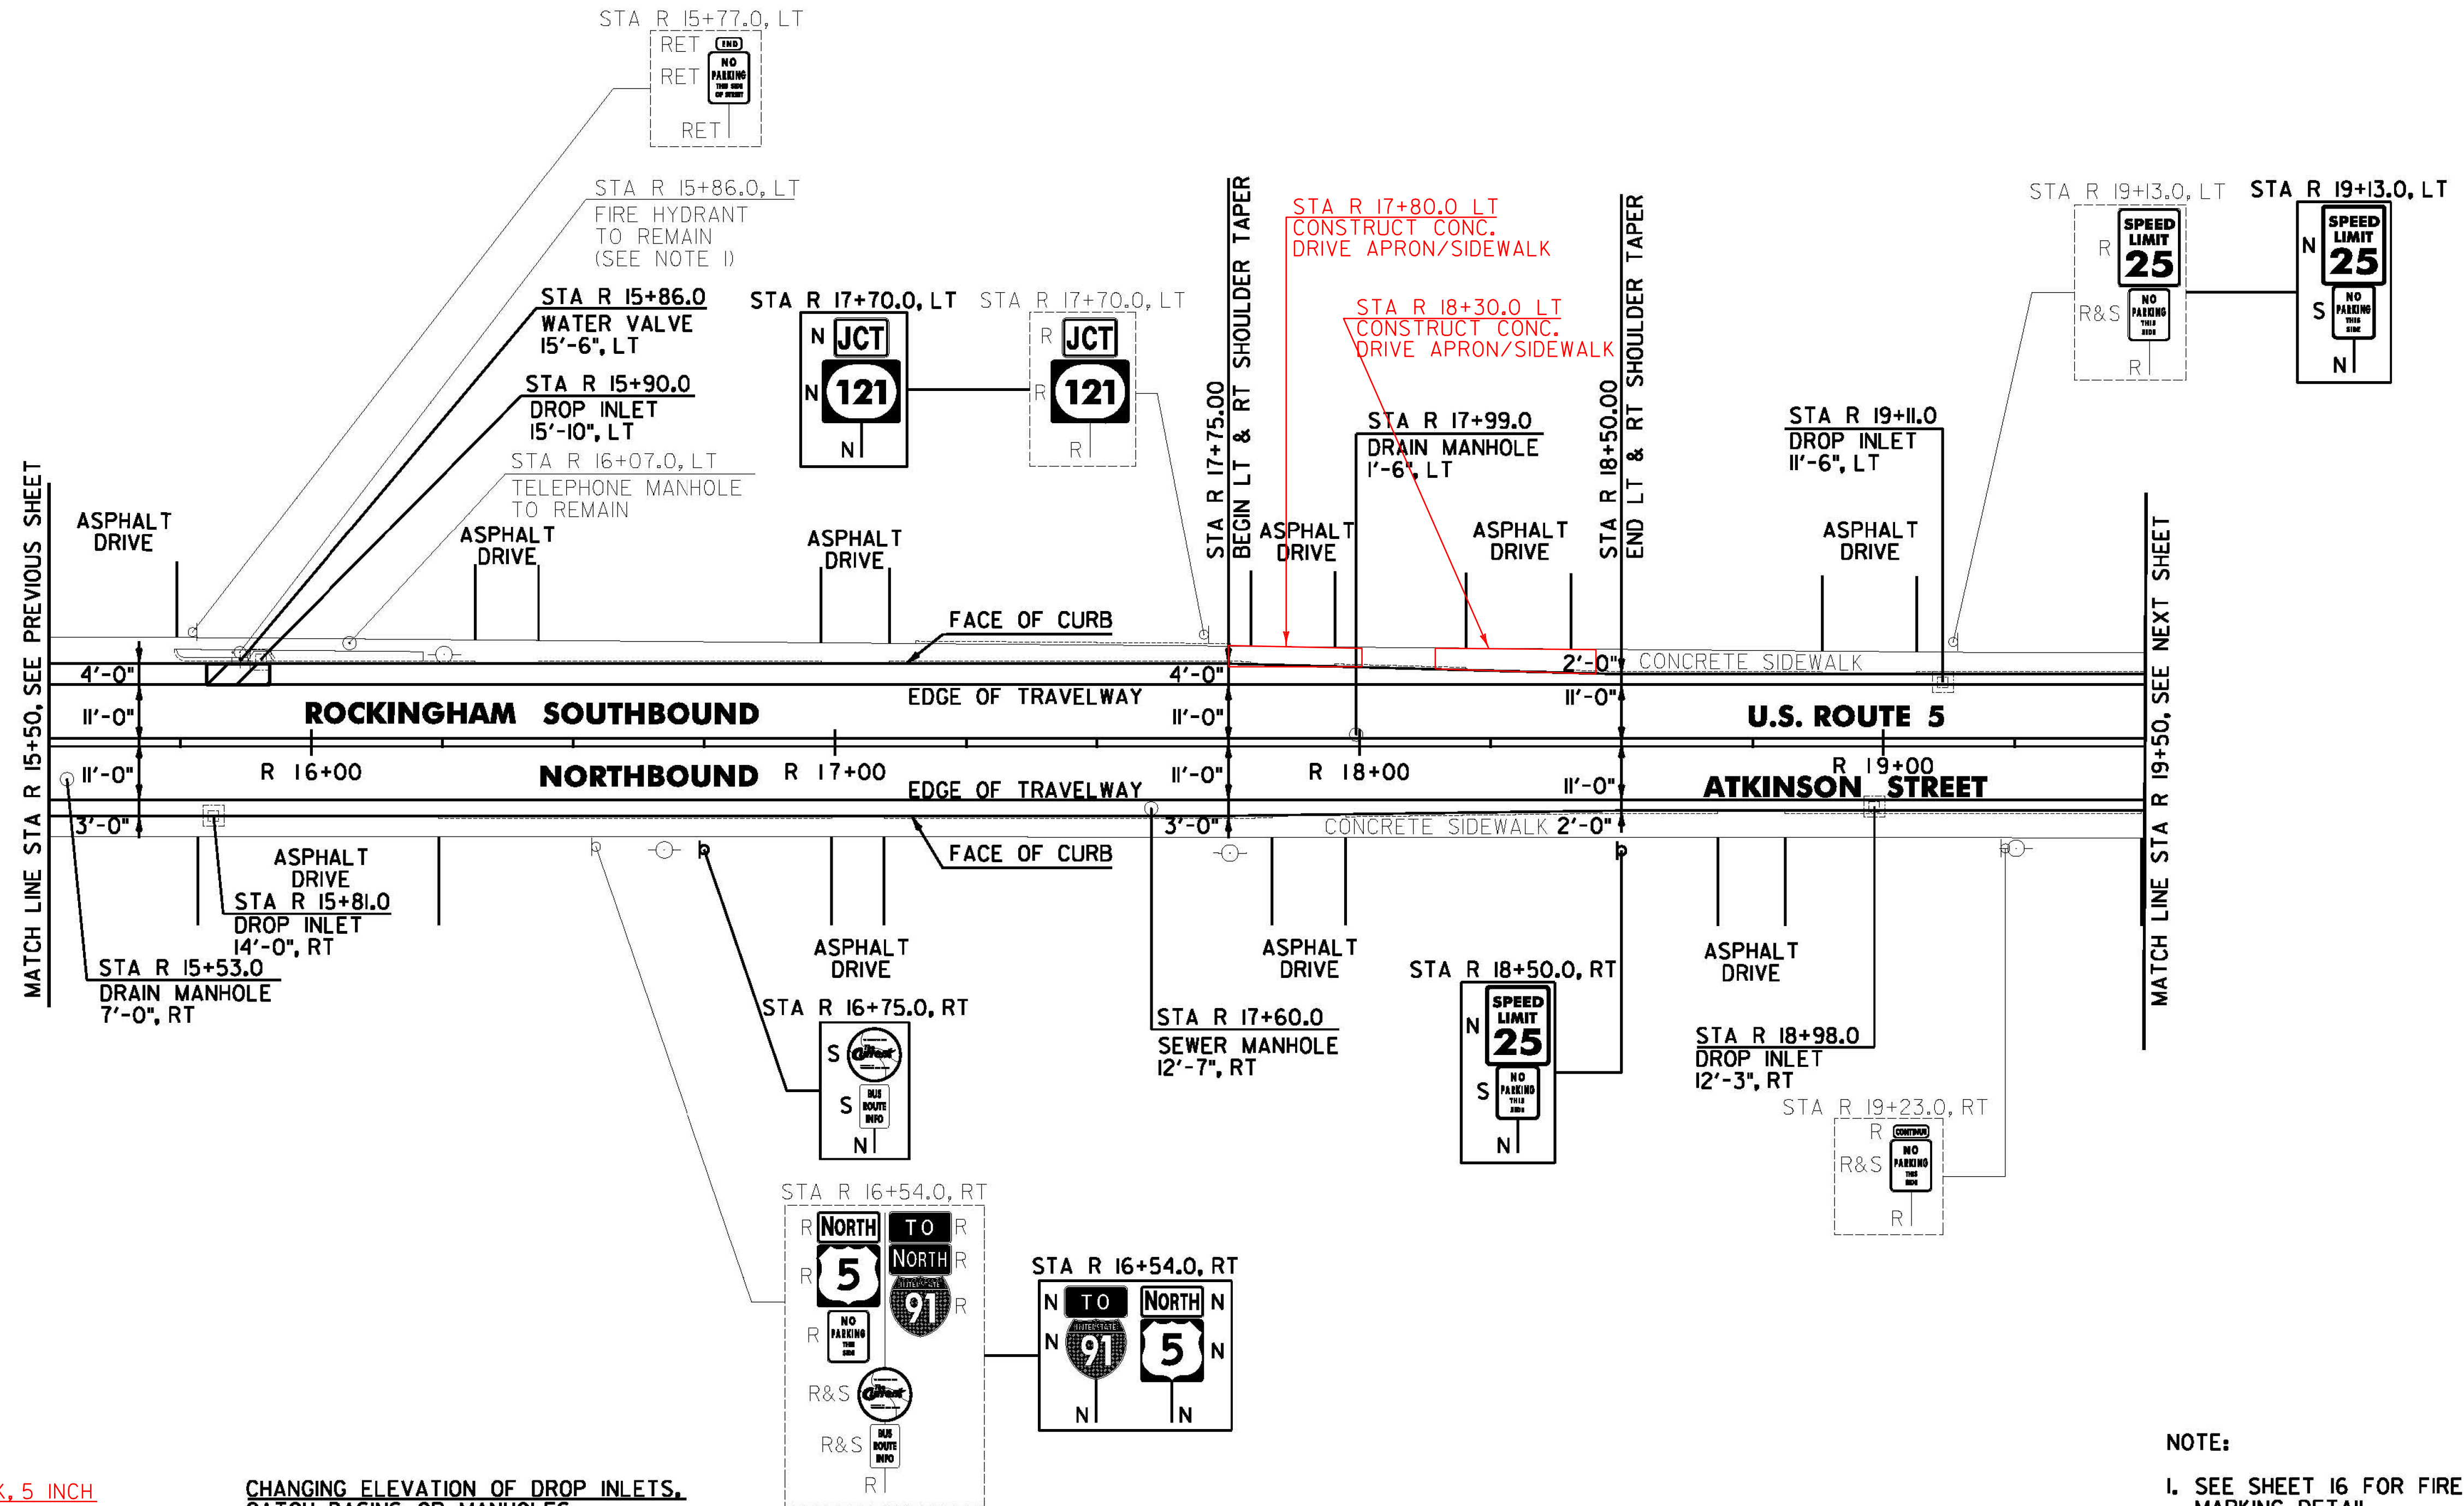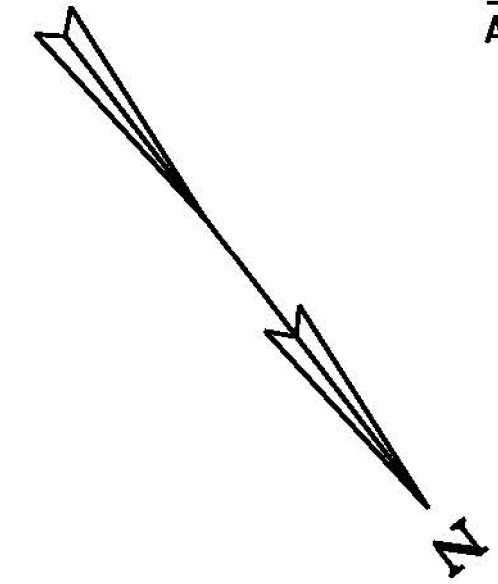

PORTLAND CEMENT CONCRETE SIDEWALK, 5 INCH  
 ROCKINGHAM  
 STA R 17+80.0 LT  
 STA R 18+30.0 LT

CHANGING ELEVATION OF DROP INLETS,  
 CATCH BASINS, OR MANHOLES  
 ROCKINGHAM:  
 STA R 15+53.0 RT  
 STA R 17+99.0 LT

REHAB DROP INLETS, CATCH BASINS,  
 OR MANHOLES, CLASS I, II OR III  
 ROCKINGHAM:  
 STA R 15+81.0 RT  
 STA R 15+90.0 LT  
 STA R 18+98.0 RT  
 STA R 19+11.0 LT

CHANGING ELEVATION OF SEWER MANHOLES  
 ROCKINGHAM:  
 STA R 17+60.0 RT  
 ADJUST ELEVATION OF VALVE BOX  
 ROCKINGHAM:  
 STA R 15+86.0 LT

**SIGN LEGEND**  
 R = REMOVE  
 S = SALVAGE  
 N = NEW  
 RET = RETAIN  
 B-B = BACK TO BACK  
 EXISTING = \_\_\_\_\_  
 NEW = \_\_\_\_\_  
 R = RETURN TO TOWN  
 OF ROCKINGHAM

NOT TO SCALE

**ROCKINGHAM  
 PROJECT  
 LAYOUT  
 SHEET #5**

PROJECT NAME: CHESTER-SPRINGFIELD-ROCKINGHAM-WINDSOR  
 PROJECT NUMBER: STP 2952(1)

FILE NAME: z13c518bdr\_seg03.dgn  
 PROJECT LEADER: D. GOZALKOWSKI  
 DESIGNED BY: A. HAWKINS

PLOT DATE: 3/27/2015  
 DRAWN BY: A. KIRBY  
 CHECKED BY: J. SHIELDS  
 SHEET 183 OF 309

NOTE:  
 I. SEE SHEET 16 FOR FIRE HYDRANT PAVEMENT  
 MARKING DETAIL.