

DURABLE 4 INCH WHITE LINE, TYPE A TAPE AND TEMPORARY 4 INCH WHITE LINE, PAINT
 (ALL LINES WILL INCLUDE EDGE LINE BREAKS AND RADIUS FOR TOWN HIGHWAYS)
 ROCKINGHAM:
 STA R 19+50.00 - STA R 23+50.00 EDGE LINE LT & RT
 STA R 23+23.20 EDGE LINES RT, TH-424

DURABLE 4 INCH YELLOW LINE, TYPE A TAPE AND TEMPORARY 4 INCH YELLOW LINE, PAINT
 (ALL LINES WILL INCLUDE C/L LINE BREAKS FOR TOWN HIGHWAYS)
 S = SOLID, D = DASHED
 ROCKINGHAM:
 STA R 19+50.00 - STA R 23+50.00 LT & RT
 STA R 23+23.20 DOUBLE SOLID RT, TH-424

DURABLE 24 INCH STOP BAR, TYPE A TAPE AND TEMPORARY 24 INCH STOP BAR, PAINT
 ROCKINGHAM:
 STA R 23+23.20 RT, TH-424

DURABLE LETTER OR SYMBOL, TYPE D TAPE
 ROCKINGHAM:
 STA R 23+23.20 RT, TH-424 "S,T,O,P (4 EA)



REMOVING SIGNS
 AS SHOWN - 3

ERECTING SALVAGED SIGNS
 AS SHOWN - 1

DURABLE 8 INCH WHITE LINE, TYPE A TAPE
 ROCKINGHAM:
 STA R 23+36.00 - STA R 23+48.00 LT, FIRE HYDRANT, NO PARKING

TEMPORARY LETTER OR SYMBOL, PAINT
 ROCKINGHAM:
 STA R 23+23.20 RT, TH-424 "S,T,O,P (8 EA)

DURABLE CROSSWALK MARKING, TYPE A TAPE AND TEMPORARY CROSSWALK MARKING, PAINT
 ROCKINGHAM:
 STA R 23+23.20 RT, TH-424

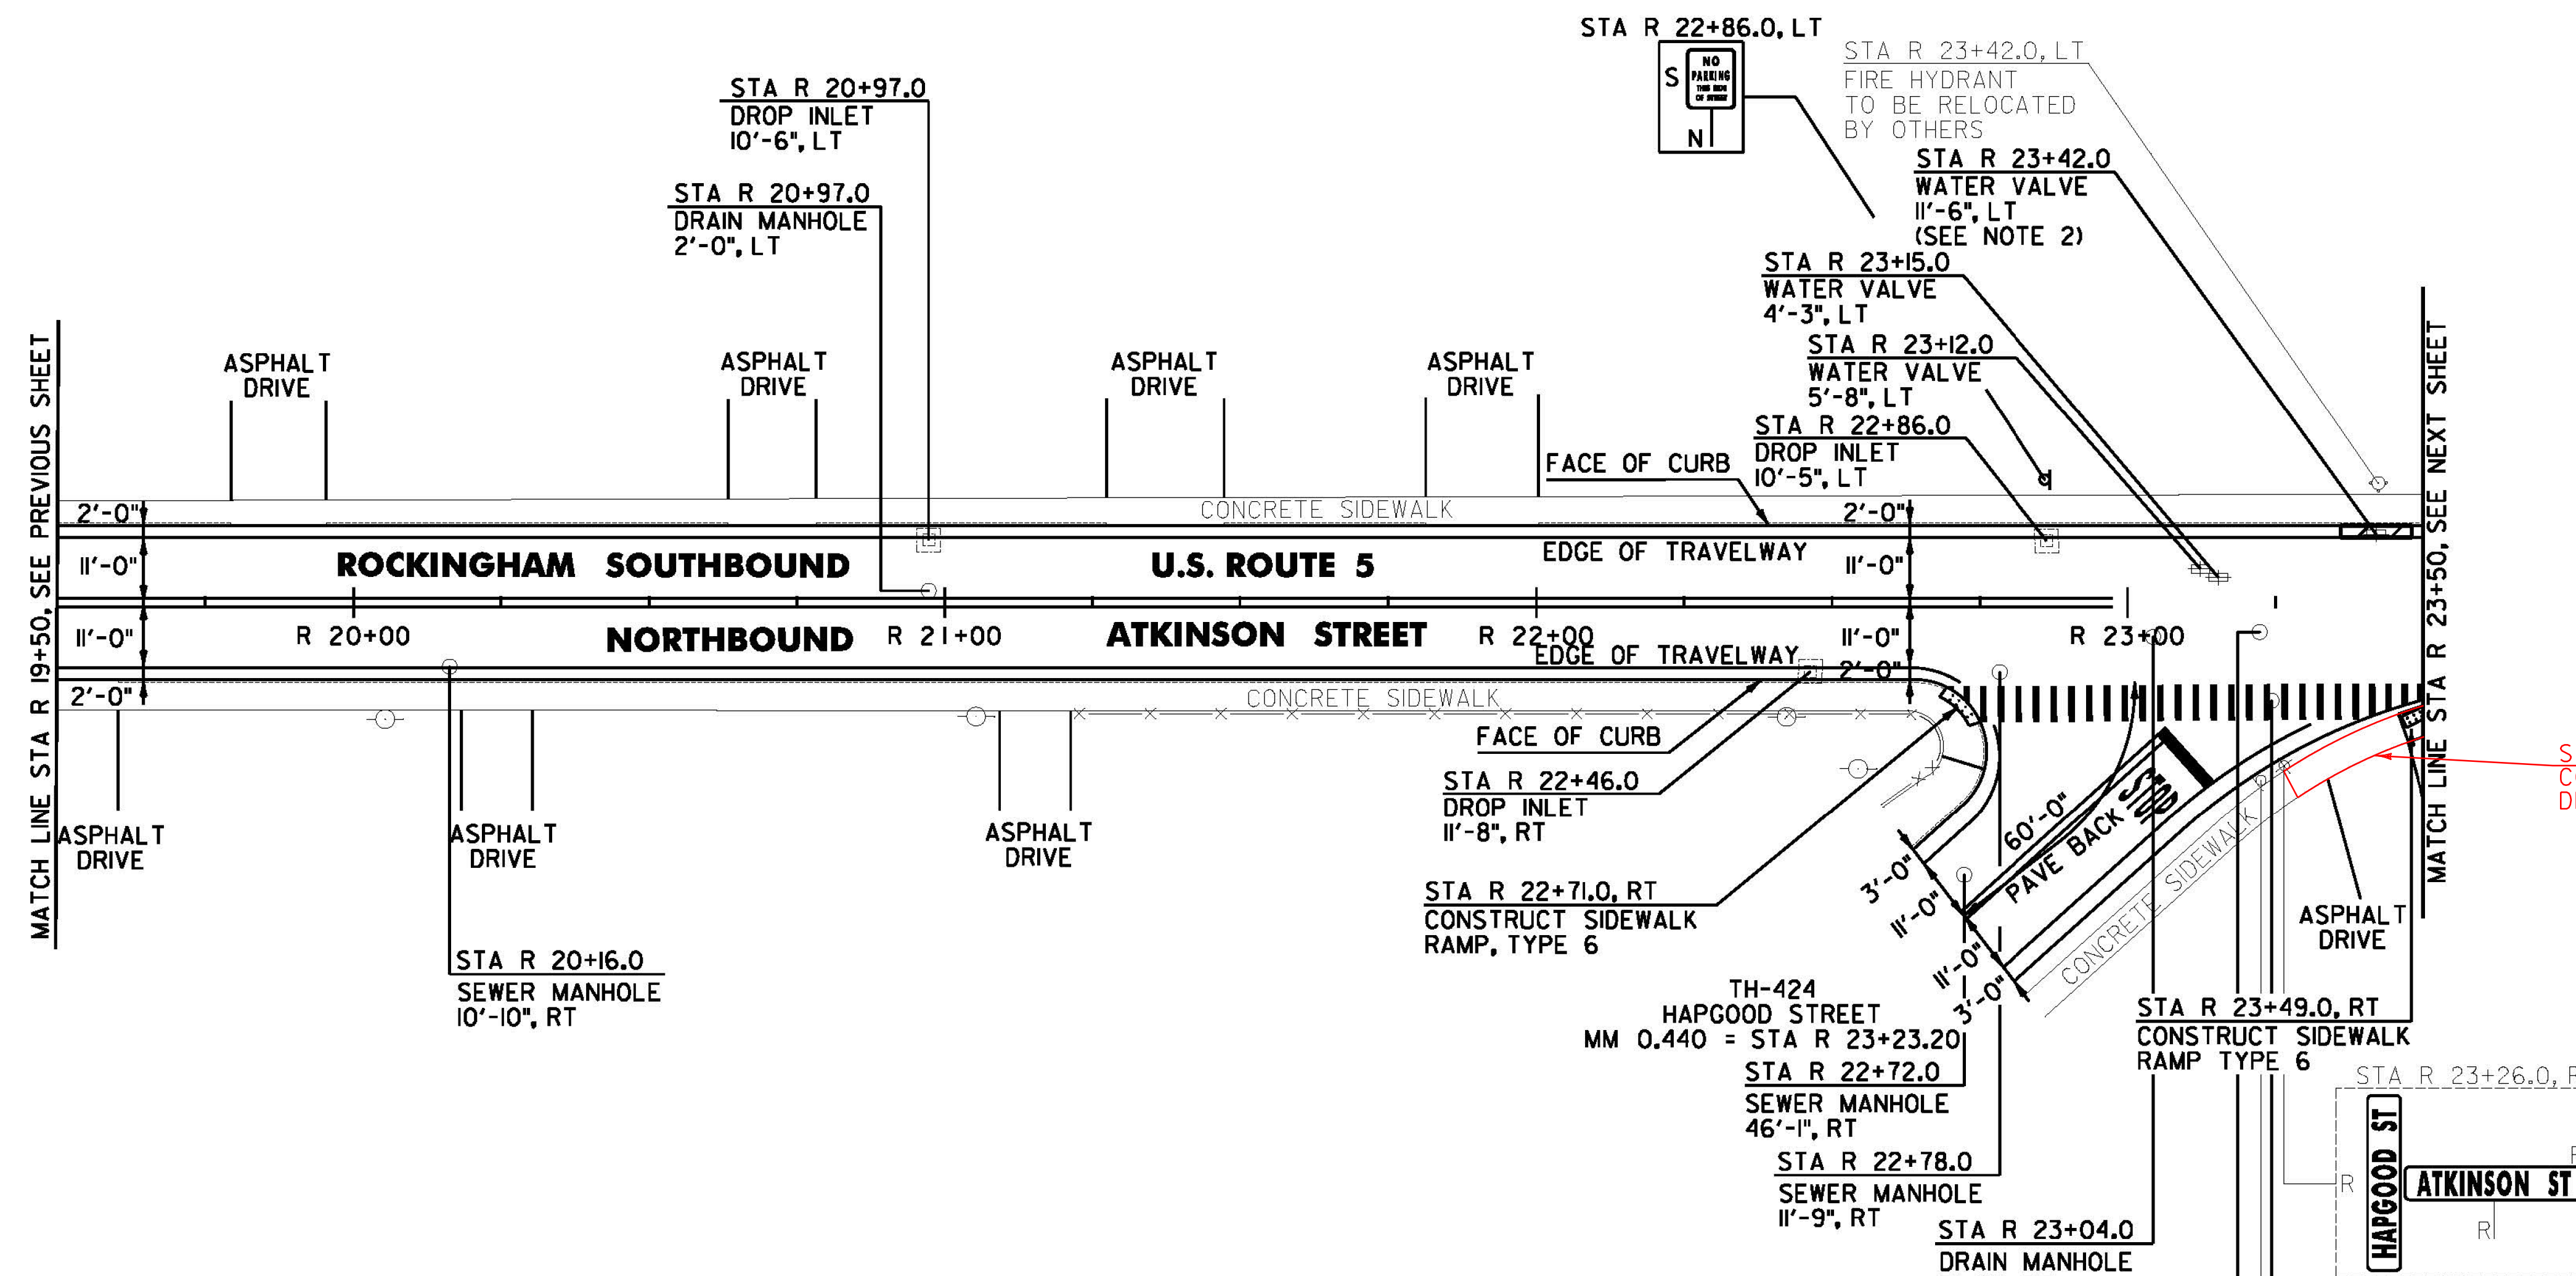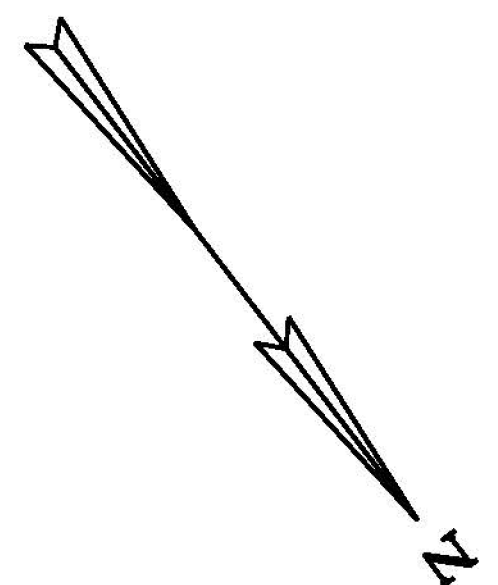

STA R 23+49.0 RT
 CONSTRUCT CONC.
 DRIVE APRON/SIDEWALK

CHANGING ELEVATION OF DROP INLETS, CATCH BASINS, OR MANHOLES
 ROCKINGHAM:
 STA R 20+97.0 LT
 STA R 23+04.0 RT
 STA R 23+22.0 RT
 STA R 23+24.0 RT


REHAB. DROP INLETS, CATCH BASINS, OR MANHOLES, CLASS I, II OR III
 ROCKINGHAM:
 STA R 20+97.0 LT
 STA R 22+46.0 RT
 STA R 22+86.0 LT

CHANGING ELEVATION OF SEWER MANHOLES
 ROCKINGHAM:
 STA R 20+16.0 RT
 STA R 22+72.0 RT
 STA R 22+78.0 RT

REMOVING AND RESETTING CURB
 ROCKINGHAM:
 STA R 22+71.0 RT
 STA R 23+49.0 RT

PORTLAND CEMENT CONCRETE SIDEWALK, 5 INCH
 ROCKINGHAM:
 STA R 22+71.0 RT
 STA R 23+49.0 RT
 STA R 23+49.0 RT DRIVE APRON
DETECTABLE WARNING SURFACE
 ROCKINGHAM:
 STA R 22+71.0 RT
 STA R 23+49.0 RT

ADJUST ELEVATION OF VALVE BOX
 ROCKINGHAM:
 STA R 23+12.0 LT
 STA R 23+15.0 LT
 STA R 23+42.0 LT

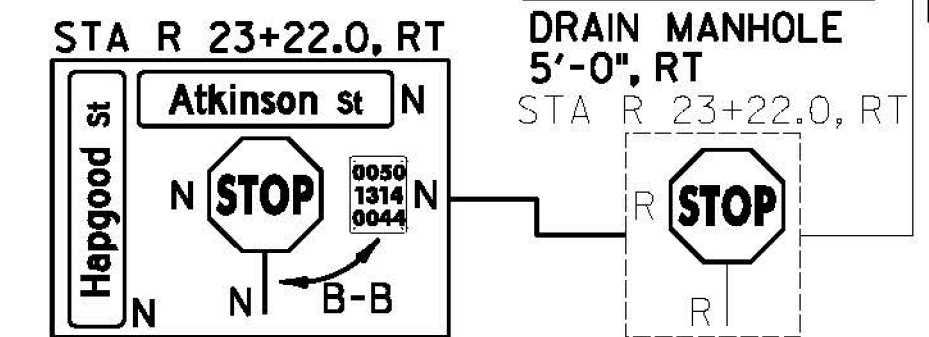

SIGN LEGEND
 R = REMOVE
 S = SALVAGE
 N = NEW
 RET = RETAIN
 B-B = BACK TO BACK
 EXISTING =
 NEW =
 R = RETURN TO TOWN OF ROCKINGHAM

NOT TO SCALE
ROCKINGHAM PROJECT LAYOUT SHEET #6

NOTES:

- SEE SHEET 16 FOR FIRE HYDRANT PAVEMENT MARKING DETAIL.
- WATER VALVE TO BE INSTALLED AS PART OF THE BELLOWS FALLS WATER MAIN IMPROVEMENTS PROJECT.

PROJECT NAME: CHESTER-SPRINGFIELD-ROCKINGHAM-WINDSOR
 PROJECT NUMBER: STP 2952(1)
 FILE NAME: z13c518bdr_seg03.dgn
 PROJECT LEADER: D. GOZALKOWSKI
 DESIGNED BY: A. HAWKINS

PLOT DATE: 3/27/2015
 DRAWN BY: A. KIRBY
 CHECKED BY: J. SHIELDS
 SHEET 184 OF 309