

**DURABLE 4 INCH WHITE LINE, TYPE A TAPE AND TEMPORARY 4 INCH WHITE LINE, PAINT**  
 (ALL LINES WILL INCLUDE EDGE LINE BREAKS AND RADIUS FOR TOWN HIGHWAYS)  
 ROCKINGHAM:  
 STA R 31+25.00 - STA R 35+25.00 EDGE LINE LT & RT  
 STA R 33+58.08 EDGE LINES LT, TH-374

**DURABLE 8 INCH WHITE LINE, TYPE A TAPE**  
 ROCKINGHAM:  
 STA R 33+85.00 - STA R 33+97.00 LT, FIRE HYDRANT, NO PARKING

**DURABLE 4 INCH YELLOW LINE, TYPE A TAPE AND TEMPORARY 4 INCH YELLOW LINE, PAINT**  
 (ALL LINES WILL INCLUDE C/L LINE BREAKS FOR TOWN HIGHWAYS)  
 S = SOLID, D = DASHED  
 ROCKINGHAM:  
 STA R 31+25.00 - STA R 35+25.00  
 STA R 33+58.08 DOUBLE SOLID LT, TH-374



**DURABLE 24 INCH STOP BAR, TYPE A TAPE AND TEMPORARY 24 INCH STOP BAR, PAINT**  
 ROCKINGHAM:  
 STA R 33+58.08 LT, TH-374

REMOVING SIGNS AS SHOWN - 4

**DURABLE LETTER OR SYMBOL, TYPE D TAPE**  
 ROCKINGHAM:  
 STA R 31+85.00 RT, "S,C,H,O,O,L" (6 EA)  
 STA R 33+58.08 LT, TH-374 "S,T,O,P" (4 EA)

**TEMPORARY LETTER OR SYMBOL, PAINT**  
 ROCKINGHAM:  
 STA R 31+85.00 RT, "S,C,H,O,O,L" (12 EA)  
 STA R 33+58.08 LT, TH-374 "S,T,O,P" (8 EA)

**DURABLE CROSSWALK MARKING, TYPE A TAPE AND TEMPORARY CROSSWALK MARKING, PAINT**  
 ROCKINGHAM:  
 STA R 33+58.08 LT, TH-374

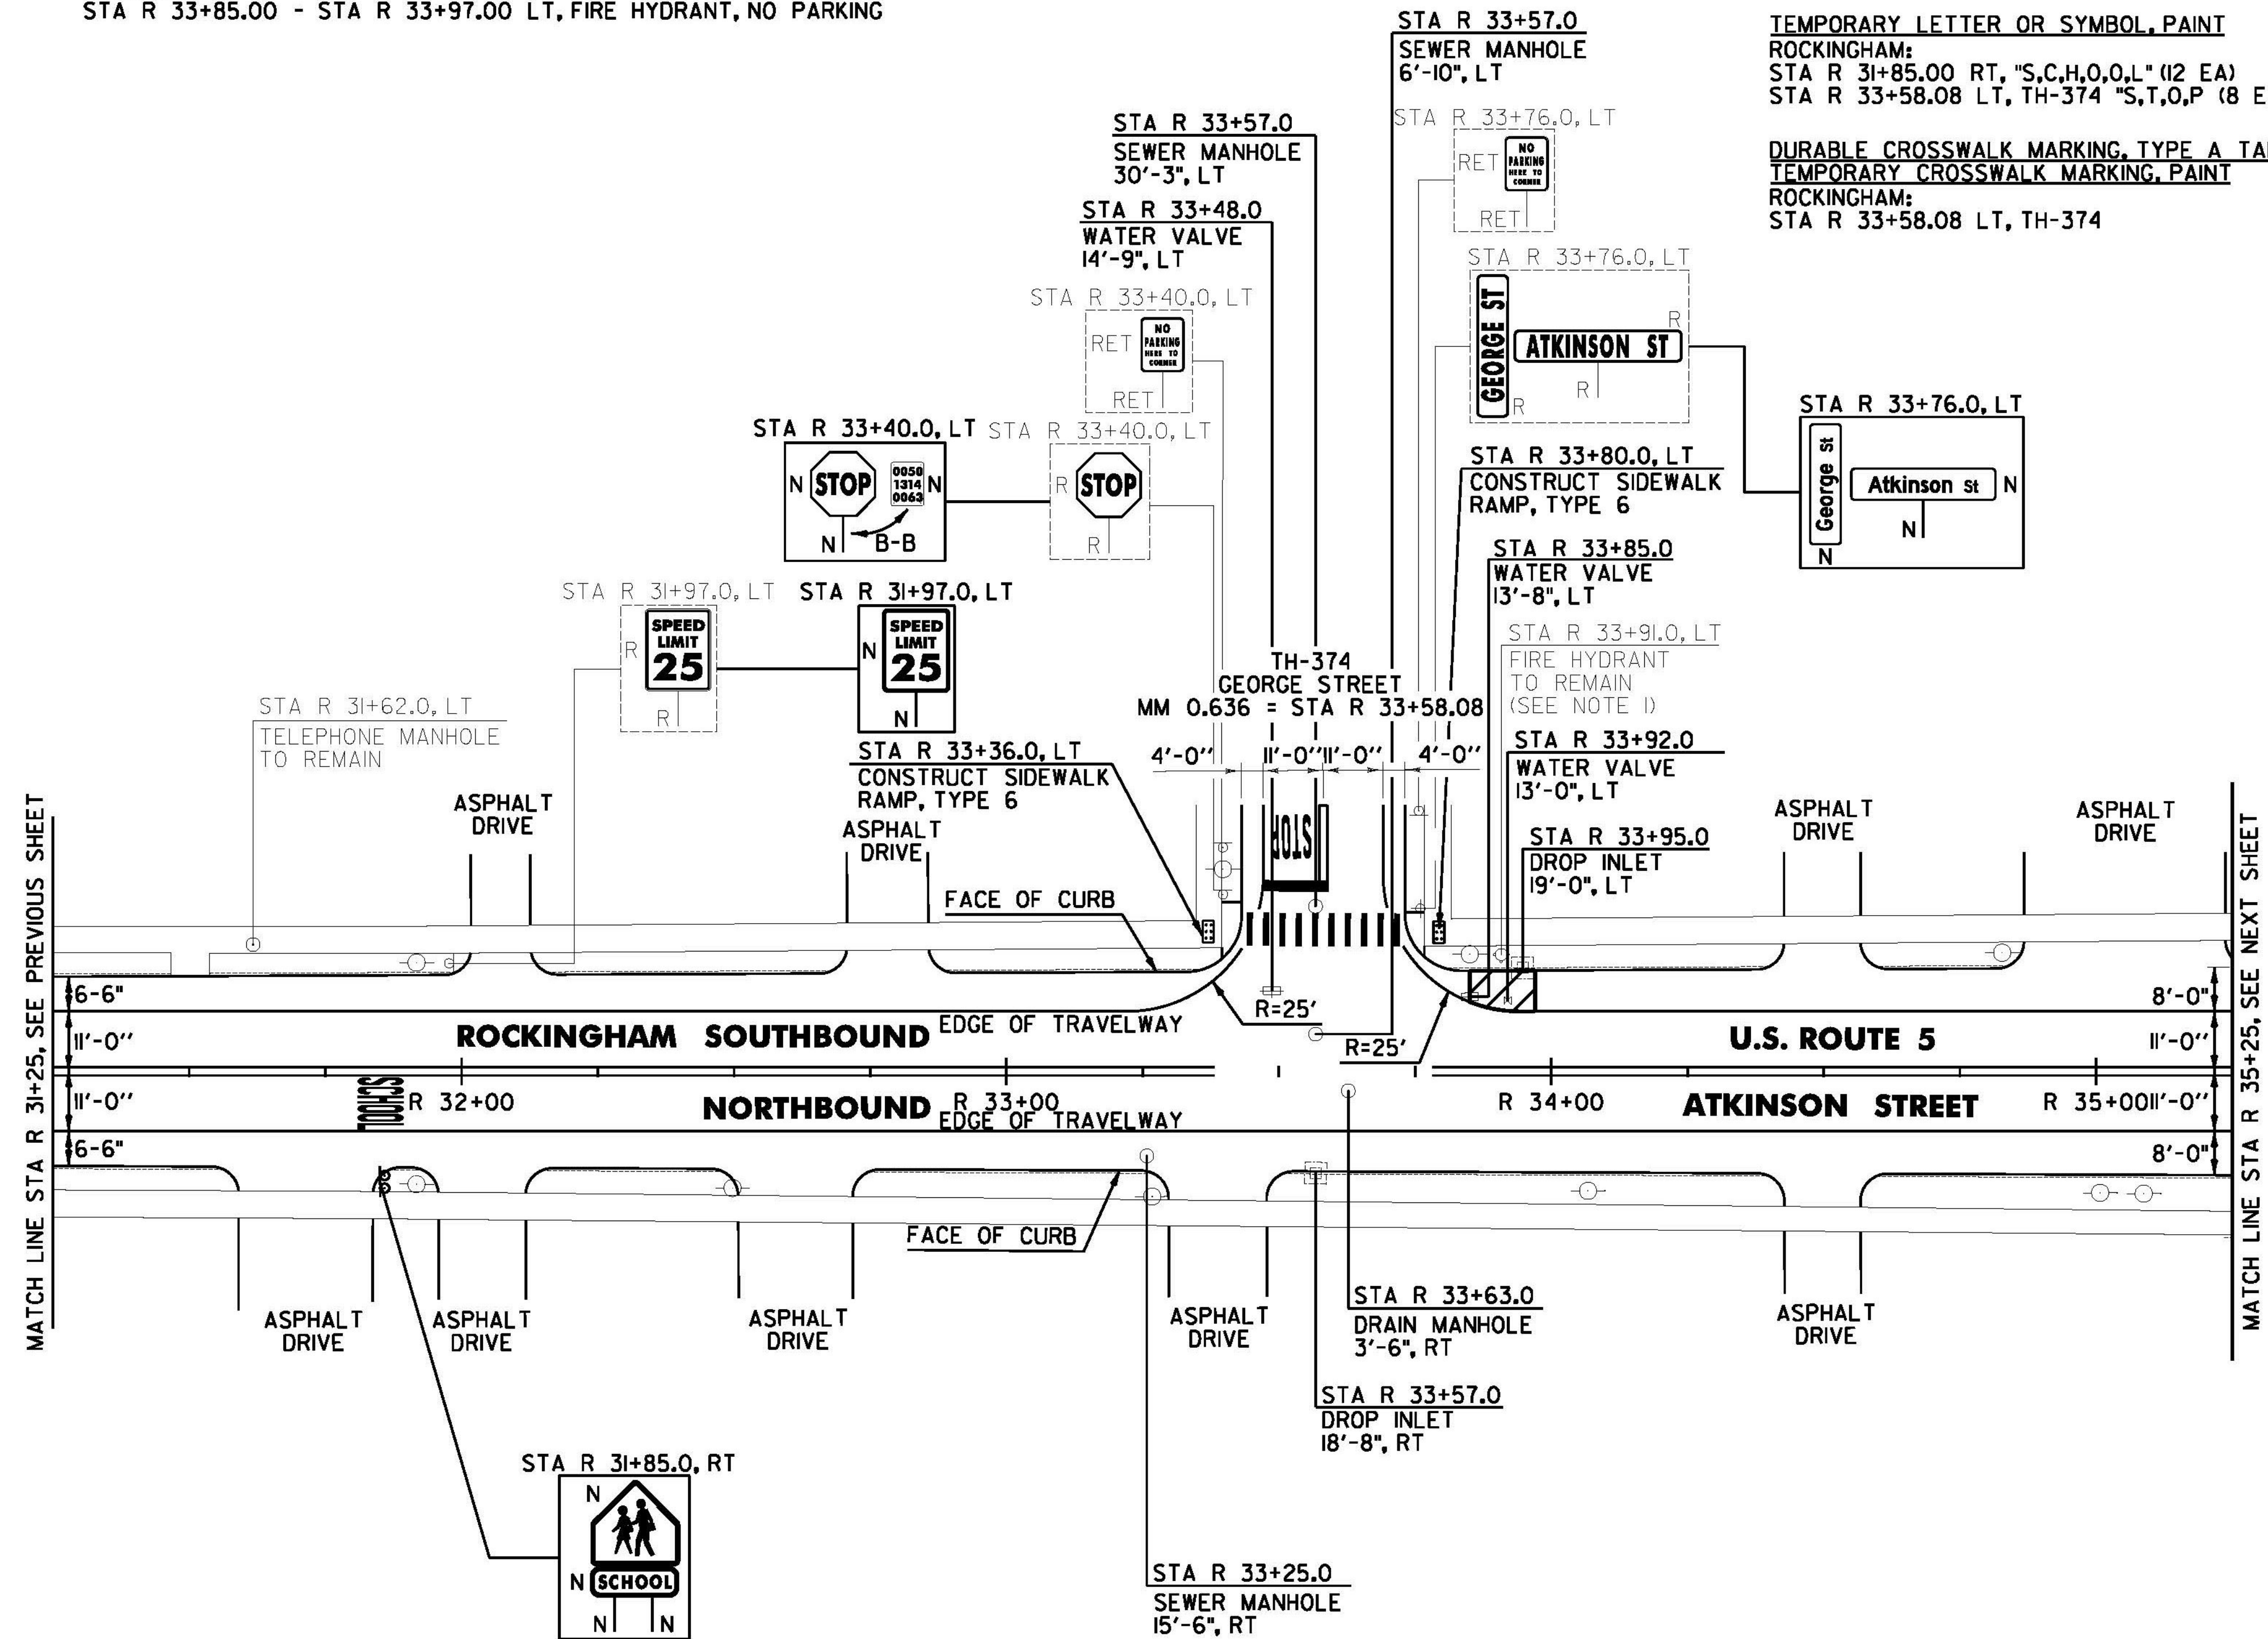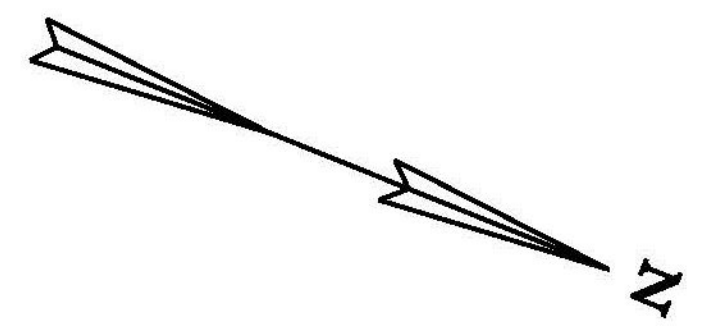

**CHANGING ELEVATION OF DROP INLETS, CATCH BASINS, OR MANHOLES**  
 ROCKINGHAM:  
 STA R 33+63.0 RT

**REHAB. DROP INLETS, CATCH BASINS, OR MANHOLES, CLASS I, II OR III**  
 ROCKINGHAM:  
 STA R 33+57.0 RT  
 STA R 33+95.0 LT

**CHANGING ELEVATION OF SEWER MANHOLES**  
 ROCKINGHAM:  
 STA R 33+25.0 RT  
 STA R 33+57.0 LT  
 STA R 33+57.0 LT

**PORTLAND CEMENT CONCRETE SIDEWALK, 5 INCH**  
 ROCKINGHAM:  
 STA R 33+36.0 LT  
 STA R 33+80.0 LT

**DETECTABLE WARNING SURFACE**  
 ROCKINGHAM:  
 STA R 33+36.0 LT  
 STA R 33+80.0 LT

**ADJUST ELEVATION OF VALVE BOX**  
 ROCKINGHAM:  
 STA R 33+48.0 LT  
 STA R 33+85.0 LT  
 STA R 33+92.0 LT

NOTE:  
 I. SEE SHEET 16 FOR FIRE HYDRANT PAVEMENT MARKING DETAIL.

**SIGN LEGEND**  
 R = REMOVE  
 S = SALVAGE  
 N = NEW  
 RET = RETAIN  
 B-B = BACK TO BACK  
 EXISTING = \_\_\_\_\_  
 NEW = \_\_\_\_\_  
 R = RETURN TO TOWN OF ROCKINGHAM

**NOT TO SCALE**  
**ROCKINGHAM PROJECT LAYOUT SHEET #9**

PROJECT NAME: CHESTER-SPRINGFIELD-ROCKINGHAM-WINDSOR	PLOT DATE: 3/27/2015
PROJECT NUMBER: STP 295210	DRAWN BY: A. KIRBY
FILE NAME: z13c518bdr_seg03.dgn	CHECKED BY: J. SHIELDS
DESIGNED BY: A. HAWKINS	SHEET 187 OF 309