

DURABLE 4 INCH WHITE LINE, TYPE A TAPE AND TEMPORARY 4 INCH WHITE LINE, PAINT
 (ALL LINES WILL INCLUDE EDGE LINE BREAKS AND RADIUS FOR TOWN HIGHWAYS)
 ROCKINGHAM:
 STA R 43+25.00 - STA R 47+25.00 EDGE LINE LT & RT

DURABLE 4 INCH YELLOW LINE, TYPE A TAPE AND TEMPORARY 4 INCH YELLOW LINE, PAINT
 (ALL LINES WILL INCLUDE C/L LINE BREAKS FOR TOWN HIGHWAYS)
 S = SOLID, D = DASHED
 ROCKINGHAM:
 STA R 43+25.00 - STA R 47+25.00

LT C RT
 S - S

DURABLE 8 INCH WHITE LINE, TYPE A TAPE
 ROCKINGHAM:
 STA R 44+89.00 - STA R 45+01.00 LT, FIRE HYDRANT, NO PARKING



DURABLE CROSSWALK MARKING, TYPE A TAPE AND TEMPORARY CROSSWALK MARKING, PAINT
 ROCKINGHAM:
 STA R 43+56.0 LT, TH-338
 STA R 45+60.0 LT/RT
 STA R 45+77.76 LT, TH-336

DURABLE LETTER OR SYMBOL, TYPE D TAPE
 ROCKINGHAM:
 STA R 44+53.00 LT, "S,C,H,O,O,L" (6 EA)

TEMPORARY LETTER OR SYMBOL, PAINT
 ROCKINGHAM:
 STA R 44+53.00 LT, "S,C,H,O,O,L" (12 EA)

REMOVING SIGNS
 AS SHOWN - 6

ERECTING SALVAGED SIGNS
 AS SHOWN - 1

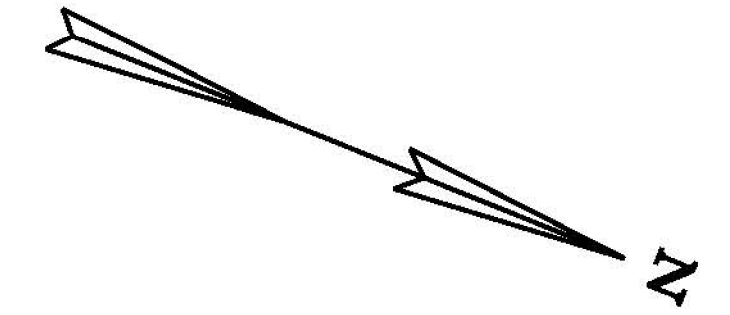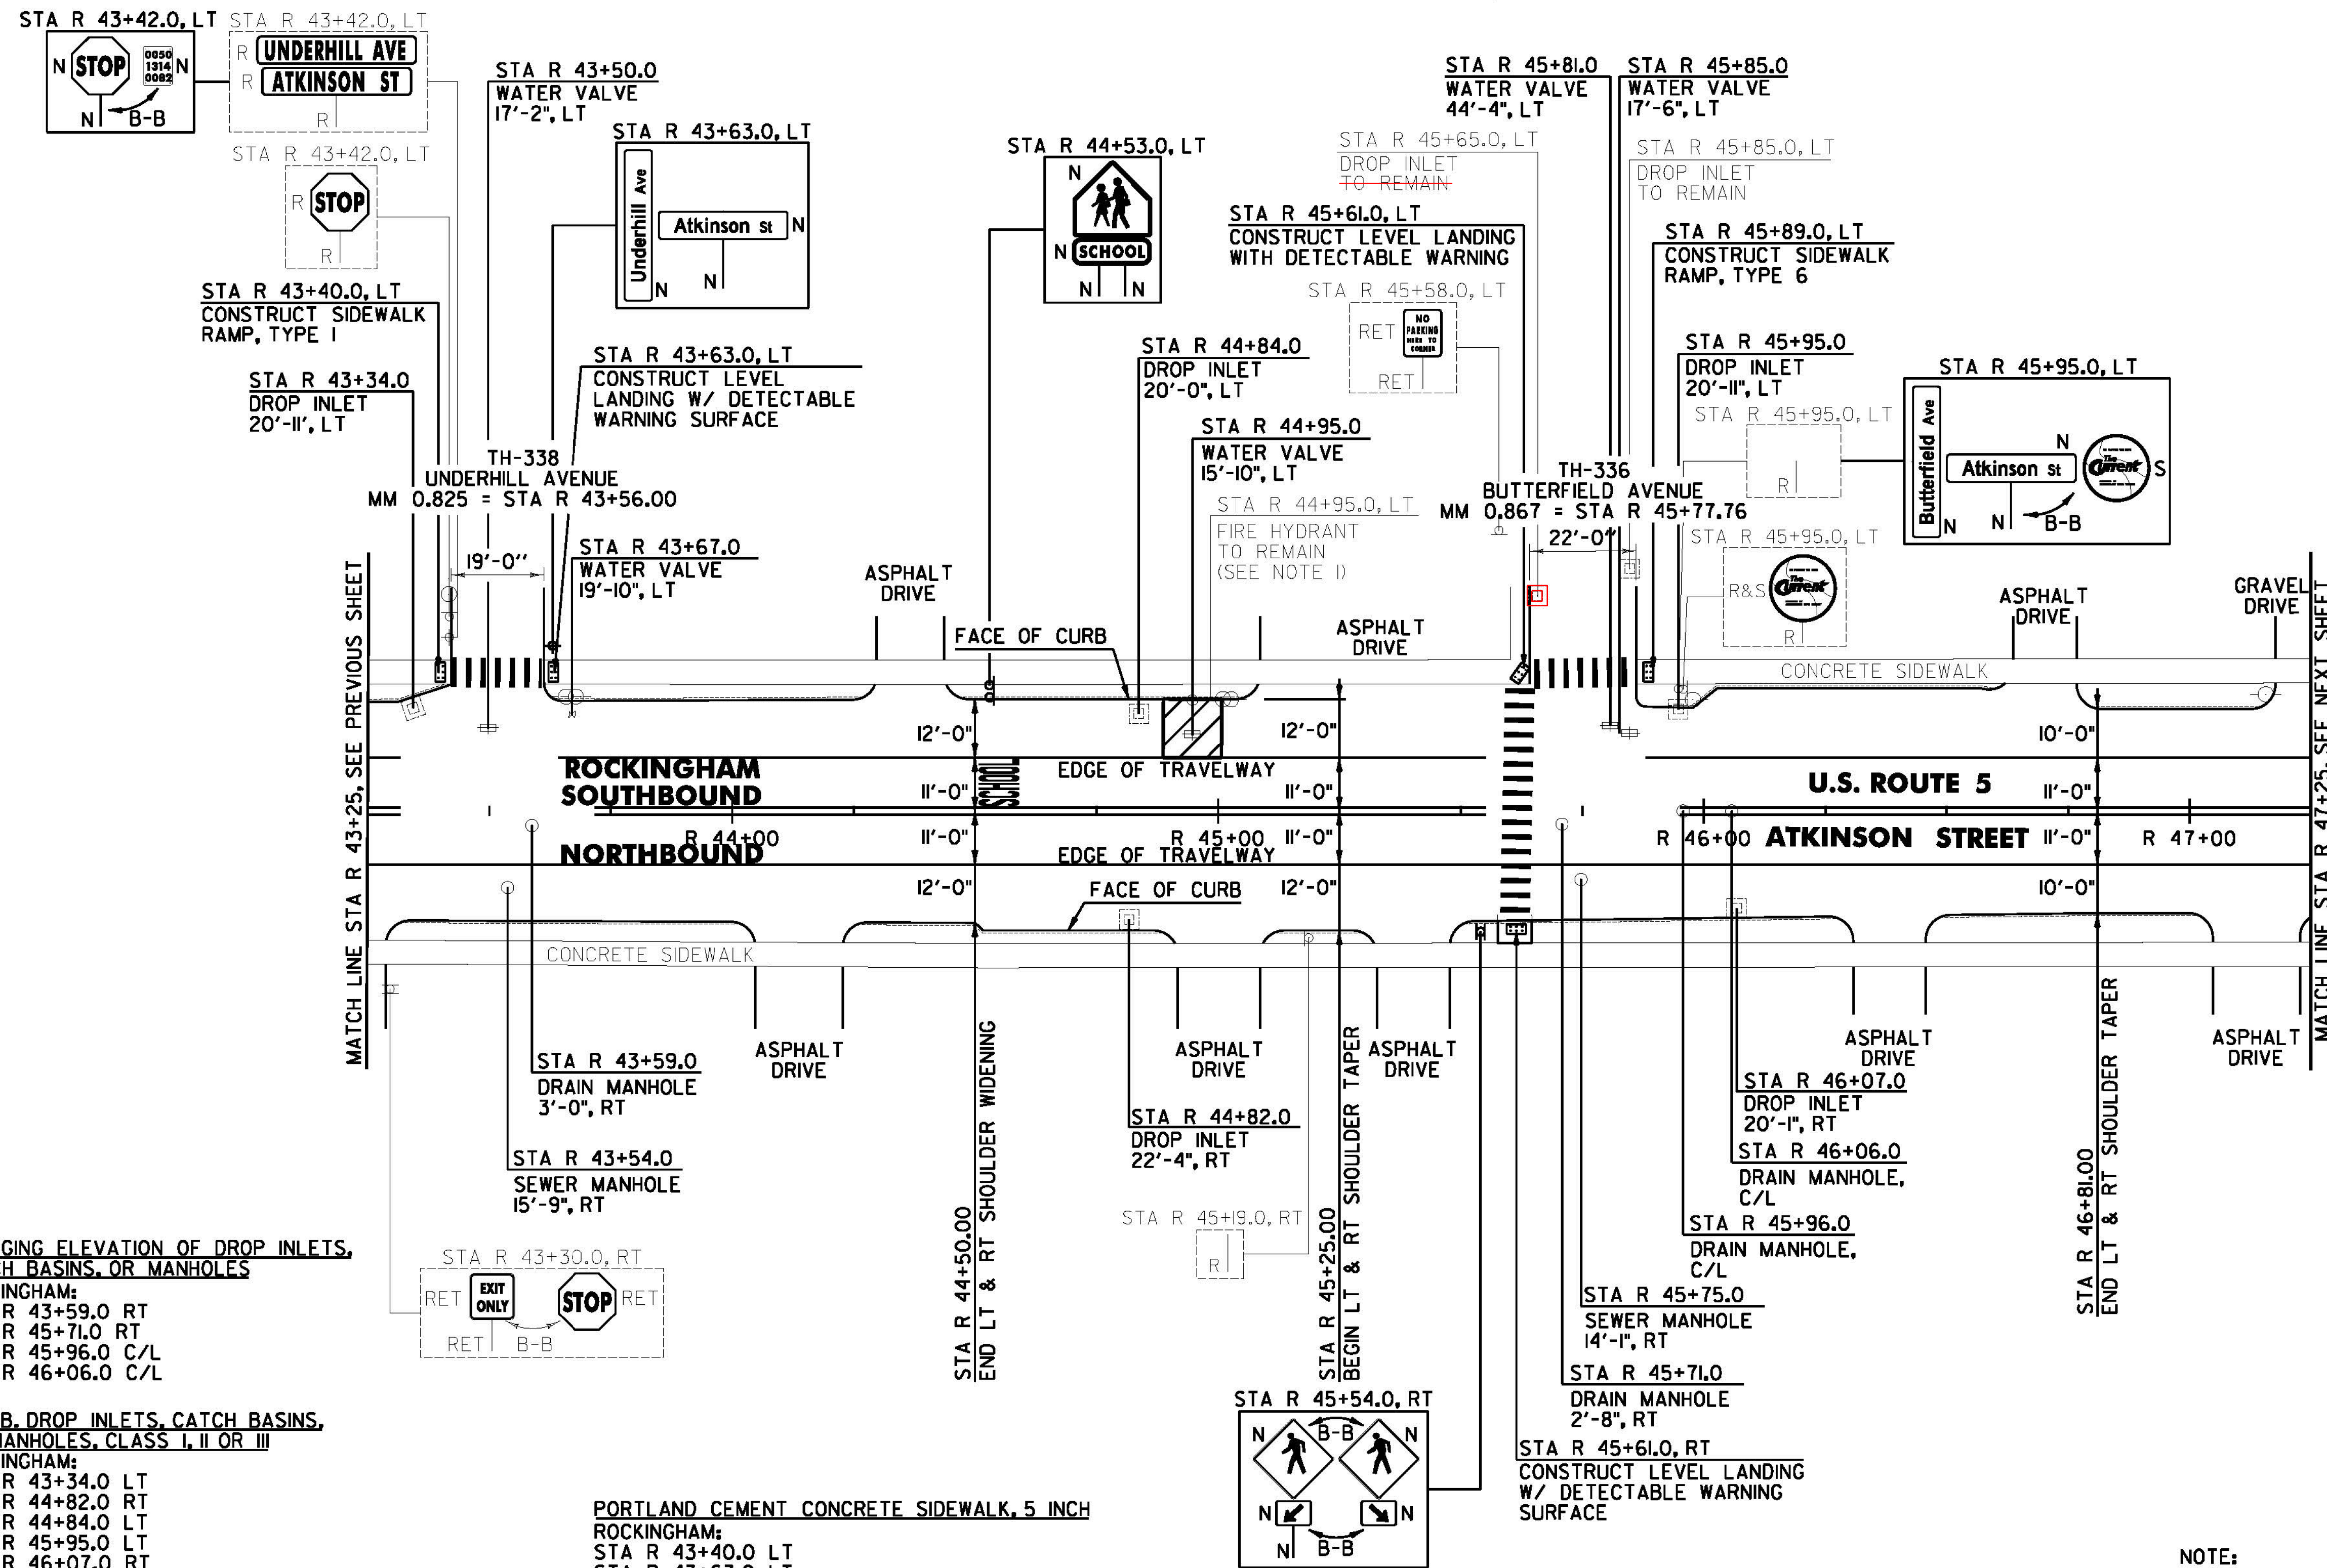

CHANGING ELEVATION OF DROP INLETS, CATCH BASINS, OR MANHOLES
 ROCKINGHAM:
 STA R 43+59.0 RT
 STA R 45+71.0 RT
 STA R 45+96.0 C/L
 STA R 46+06.0 C/L

REHAB. DROP INLETS, CATCH BASINS, OR MANHOLES, CLASS I, II OR III
 ROCKINGHAM:
 STA R 43+34.0 LT
 STA R 44+82.0 RT
 STA R 44+84.0 LT
 STA R 45+95.0 LT
 STA R 46+07.0 RT
 STA R 45+65.0 LT

CHANGING ELEVATION OF SEWER MANHOLES
 ROCKINGHAM:
 STA R 43+54.0 RT
 STA R 45+75.0 RT

REMOVING AND RESETTING CURB
 ROCKINGHAM:
 STA R 43+40.0 LT
 STA R 45+89.0 LT

PORTLAND CEMENT CONCRETE SIDEWALK, 5 INCH
 ROCKINGHAM:
 STA R 43+40.0 LT
 STA R 43+63.0 LT
 STA R 45+61.0 LT
 STA R 45+61.0 RT
 STA R 45+89.0 LT

DETECTABLE WARNING SURFACE
 ROCKINGHAM:
 STA R 43+40.0 LT
 STA R 43+63.0 LT
 STA R 45+61.0 LT
 STA R 45+61.0 RT
 STA R 45+89.0 LT

ADJUST ELEVATION OF VALVE BOX
 ROCKINGHAM:
 STA R 43+50.0 LT
 STA R 43+67.0 LT
 STA R 44+95.0 LT
 STA R 45+81.0 LT
 STA R 45+85.0 LT

SIGN LEGEND
 R = REMOVE
 S = SALVAGE
 N = NEW
 RET = RETAIN
 B-B = BACK TO BACK
 EXISTING = _____
 NEW = _____
 ⊕ = RETURN TO TOWN OF ROCKINGHAM

NOT TO SCALE

ROCKINGHAM PROJECT LAYOUT SHEET #12

NOTE:
 1. SEE SHEET 16 FOR FIRE HYDRANT PAVEMENT MARKING DETAIL.

PROJECT NAME: CHESTER-SPRINGFIELD-ROCKINGHAM-WINDSOR
 PROJECT NUMBER: STP 2952(1)
 FILE NAME: z13c518bdr_seg03.dgn
 PROJECT LEADER: D. GOZALKOWSKI
 DESIGNED BY: A. HAWKINS

PLOT DATE: 3/27/2015
 DRAWN BY: A. KIRBY
 CHECKED BY: J. SHIELDS
 SHEET 190 OF 309