

DURABLE 4 INCH WHITE LINE, TYPE A TAPE AND TEMPORARY 4 INCH WHITE LINE, PAINT
 (ALL LINES WILL INCLUDE EDGE LINE BREAKS AND RADIUS FOR TOWN HIGHWAYS)
 ROCKINGHAM:
 STA R 47+25.00 - STA R 50+75.00 EDGE LINE LT & RT
 STA R 47+94.24 EDGE LINES LT, TH-332


DURABLE 8 INCH WHITE LINE, TYPE A TAPE
 ROCKINGHAM:
 STA R 48+22.00 - STA R 48+34.00 LT, FIRE HYDRANT, NO PARKING

DURABLE 4 INCH YELLOW LINE, TYPE A TAPE AND TEMPORARY 4 INCH YELLOW LINE, PAINT
 (ALL LINES WILL INCLUDE C/L LINE BREAKS FOR TOWN HIGHWAYS)
 S = SOLID, D = DASHED
 ROCKINGHAM:
 STA R 47+25.00 - STA R 50+75.00
 STA R 47+94.24 DOUBLE SOLID LT, TH-332

DURABLE 24 INCH STOP BAR, TYPE A TAPE AND TEMPORARY 24 INCH STOP BAR, PAINT
 ROCKINGHAM:
 STA R 47+94.24 LT, TH-332
DURABLE LETTER OR SYMBOL, TYPE D TAPE
 ROCKINGHAM:
 STA R 47+94.24 LT, TH-332 "S,T,O,P (4 EA)

TEMPORARY LETTER OR SYMBOL, PAINT
 ROCKINGHAM:
 STA R 47+94.24 LT, TH-332 "S,T,O,P (8 EA)
DURABLE CROSSWALK MARKING, TYPE A TAPE AND TEMPORARY CROSSWALK MARKING, PAINT
 ROCKINGHAM:
 STA R 47+93.00 LT/RT
 STA R 47+94.24 LT, TH-332
 STA R 48+20.64 RT, TH-332

REMOVING SIGNS
 AS SHOWN - 8
ERECTING SALVAGED SIGNS
 AS SHOWN - 1

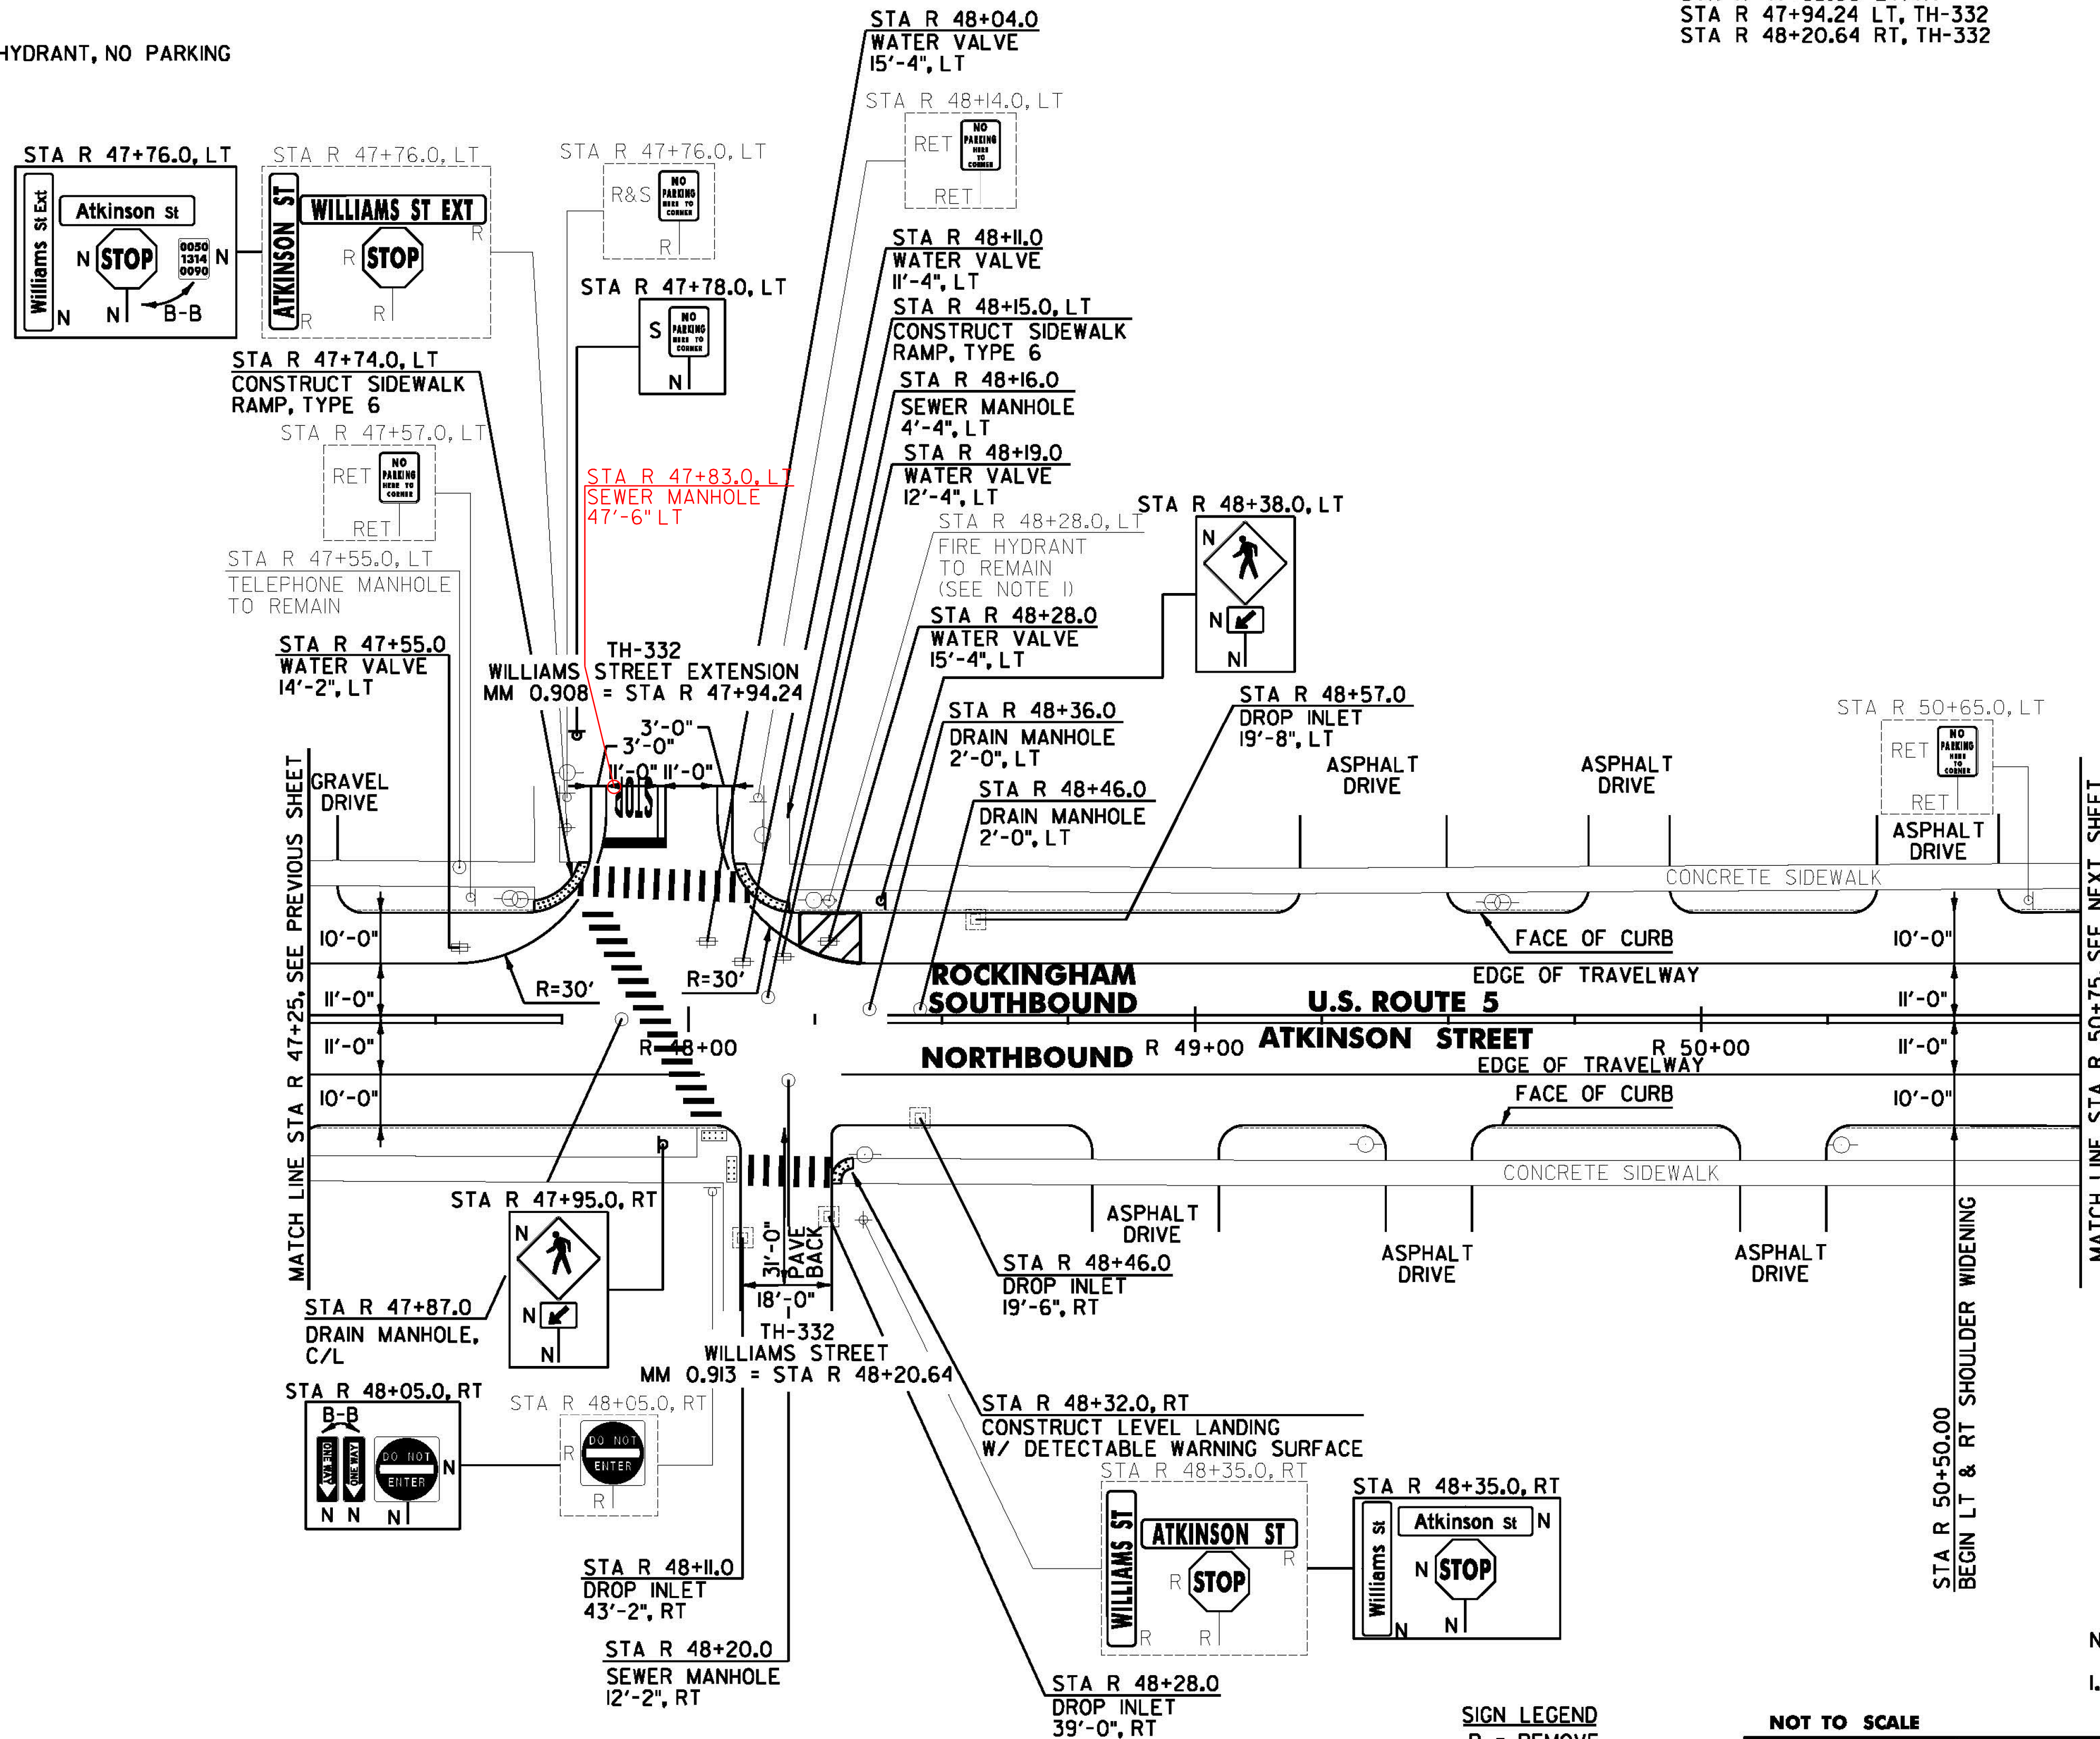

CHANGING ELEVATION OF DROP INLETS, CATCH BASINS, OR MANHOLES

ROCKINGHAM:
 STA R 47+87.0 C/L
 STA R 48+36.0 LT
 STA R 48+46.0 LT
 STA R 48+16.0 LT

REHAB. DROP INLETS, CATCH BASINS, OR MANHOLES, CLASS I, II OR III

ROCKINGHAM:
 STA R 48+11.0 RT
 STA R 48+28.0 RT
 STA R 48+46.0 RT
 STA R 48+57.0 LT

CHANGING ELEVATION OF SEWER MANHOLES

ROCKINGHAM:
~~STA R 48+16.0 LT~~
 STA R 48+20.0 RT
 STA R 47+83.0 LT

PORTLAND CEMENT CONCRETE SIDEWALK, 5 INCH

ROCKINGHAM:
 STA R 47+74.0 LT
 STA R 48+15.0 LT
 STA R 48+32.0 RT

DETECTABLE WARNING SURFACE

ROCKINGHAM:
 STA R 47+74.0 LT
 STA R 48+15.0 LT
 STA R 48+32.0 RT

ADJUST ELEVATION OF VALVE BOX

ROCKINGHAM:
 STA R 47+55.0 LT
 STA R 48+04.0 LT
 STA R 48+11.0 LT
 STA R 48+19.0 LT
 STA R 48+28.0 LT

SIGN LEGEND

R = REMOVE
 S = SALVAGE
 N = NEW
 RET = RETAIN
 B-B = BACK TO BACK
 EXISTING = _____
 NEW = _____
 ⊕ = RETURN TO TOWN OF ROCKINGHAM

NOT TO SCALE

ROCKINGHAM PROJECT LAYOUT SHEET #13

PROJECT NAME: CHESTER-SPRINGFIELD-ROCKINGHAM-WINDSOR
 PROJECT NUMBER: STP 2952(1)

FILE NAME: z13c518bdr_seg03.dgn
 PROJECT LEADER: D. GOZALKOWSKI
 DESIGNED BY: A. HAWKINS

PLOT DATE: 3/27/2015
 DRAWN BY: A. KIRBY
 CHECKED BY: J. SHIELDS
 SHEET 191 OF 309

NOTE:
 I. SEE SHEET 16 FOR FIRE HYDRANT PAVEMENT MARKING DETAIL.

