

DURABLE 4 INCH WHITE LINE, TYPE A TAPE AND TEMPORARY 4 INCH WHITE LINE, PAINT
 (ALL LINES WILL INCLUDE EDGE LINE BREAKS AND RADIUS FOR TOWN HIGHWAYS)
 ROCKINGHAM:
 STA R 58+75.00 - STA R 62+75.00 EDGE LINE LT & RT 59+32.00
 STA R 60+87.84 EDGE LINES LT, TH-332
 STA R 61+12.00 - STA R 62+73.00 DOTTED LANE LINE RT
 STA R 62+73.00 - STA R 62+75.00 SOLID LINE LANE RT

DURABLE 4 INCH YELLOW LINE, TYPE A TAPE AND TEMPORARY 4 INCH YELLOW LINE, PAINT
 (ALL LINES WILL INCLUDE C/L LINE BREAKS FOR TOWN HIGHWAYS)
 S = SOLID, D = DASHED
 ROCKINGHAM:
 STA R 59+45.00 - STA R 60+30.00 LT & RT
 STA R 60+30.00 - STA R 62+75.00 DOUBLE SOLID LT
 STA R 60+87.84 DOUBLE SOLID LT, TH-332


DURABLE 24 INCH STOP BAR, TYPE A TAPE AND TEMPORARY 24 INCH STOP BAR, PAINT
 ROCKINGHAM:
 STA R 60+87.84 LT, TH-322

DURABLE LETTER OR SYMBOL, TYPE D TAPE
 ROCKINGHAM:
 STA R 60+87.84 LT, TH-322 "S,T,O,P" (4 EA)
TEMPORARY LETTER OR SYMBOL, PAINT
 ROCKINGHAM:
 STA R 60+87.84 LT, TH-322 "S,T,O,P" (8 EA)

REMOVING SIGNS
 AS SHOWN - 20

ERECTING SALVAGED SIGNS
 AS SHOWN - 3

DURABLE CROSSWALK MARKING, TYPE A TAPE AND TEMPORARY CROSSWALK MARKING, PAINT
 ROCKINGHAM:
 STA R 60+87.84 LT, TH-322

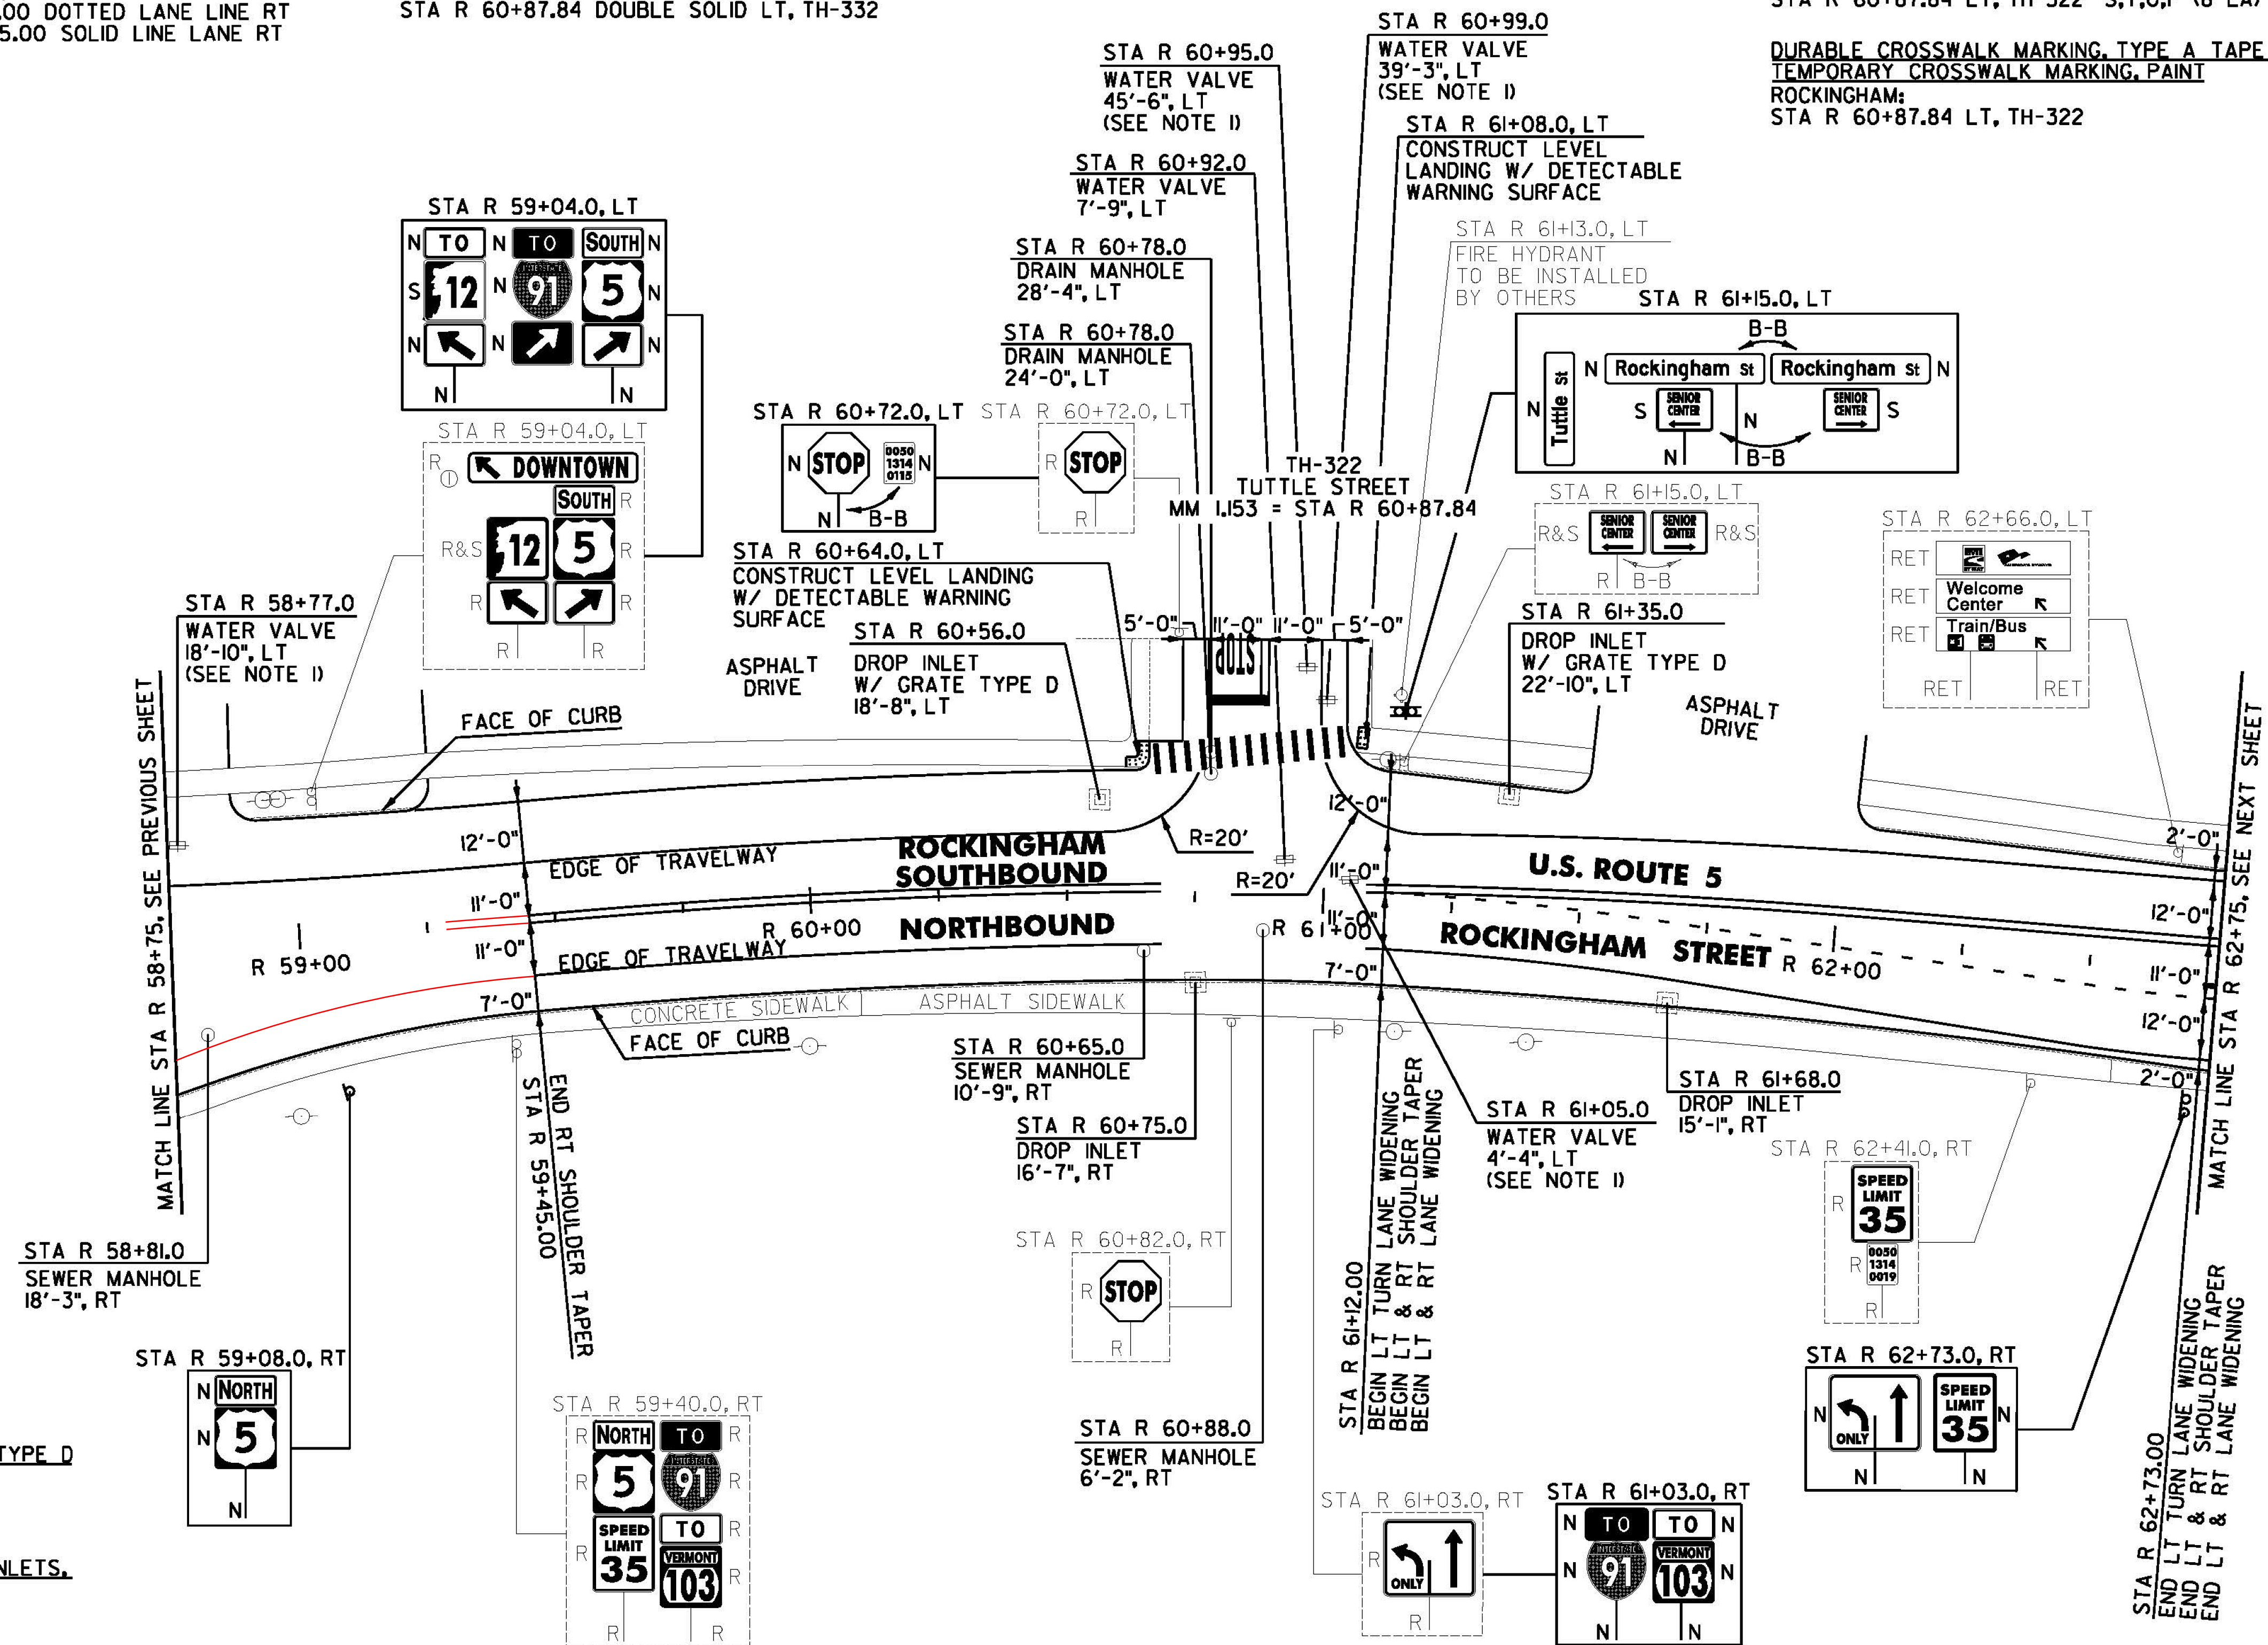

CAST IRON GRATE WITH FRAME, TYPE D
 ROCKINGHAM:
 STA R 60+56.0 LT
 STA R 61+35.0 LT

CHANGING ELEVATION OF DROP INLETS, CATCH BASINS, OR MANHOLES
 ROCKINGHAM:
 STA R 60+78.0 LT
 STA R 60+78.0 LT

REHAB. DROP INLETS, CATCH BASINS, OR MANHOLES, CLASS I, II OR III
 ROCKINGHAM:
 STA R 60+56.0 LT
 STA R 60+75.0 RT
 STA R 61+35.0 LT
 STA R 61+68.0 RT

CHANGING ELEVATION OF SEWER MANHOLES
 ROCKINGHAM:
 STA R 58+81.0 RT
 STA R 60+65.0 RT
 STA R 60+88.0 RT

PORTLAND CEMENT CONCRETE SIDEWALK, 5 INCH
 ROCKINGHAM:
 STA R 60+64.0 LT
 STA R 61+08.0 LT

DETECTABLE WARNING SURFACE
 ROCKINGHAM:
 STA R 60+64.0 LT
 STA R 61+08.0 LT

ADJUST ELEVATION OF VALVE BOX
 ROCKINGHAM:
 STA R 58+77.0 LT
 STA R 60+92.0 LT
 STA R 60+95.0 LT
 STA R 60+99.0 LT
 STA R 61+05.0 LT

SIGN LEGEND
 R = REMOVE
 S = SALVAGE
 N = NEW
 RET = RETAIN
 B-B = BACK TO BACK
 EXISTING = _____
 NEW = _____
 R = RETURN TO TOWN OF ROCKINGHAM

NOT TO SCALE

ROCKINGHAM PROJECT LAYOUT SHEET #16

PROJECT NAME: CHESTER-SPRINGFIELD-ROCKINGHAM-WINDSOR
 PROJECT NUMBER: STP 2952(1)

FILE NAME: z13c51bldr_seg03.dgn
 PROJECT LEADER: D. GOZALKOWSKI
 DESIGNED BY: A. HAWKINS

PLOT DATE: 3/27/2015
 DRAWN BY: A. KIRBY
 CHECKED BY: J. SHIELDS
 SHEET 194 OF 309

NOTE:

I. WATER VALVE TO BE INSTALLED AS PART OF THE BELLOWS FALLS WATER MAIN IMPROVEMENTS PROJECT.