

DURABLE 4 INCH WHITE LINE, TYPE A TAPE AND TEMPORARY 4 INCH WHITE LINE, PAINT
 (ALL LINES WILL INCLUDE EDGE LINE BREAKS AND RADIUS FOR TOWN HIGHWAYS)
 ROCKINGHAM:
 STA R 62+75.00 - STA R 66+75.00 EDGE LINE LT & RT
 STA R 62+75.00 - STA R 66+75.00 SOLID LANE LINE RT
 STA R 63+41.28 EDGE LINES LT, TH-320
 STA R 65+89.44 EDGE LINES LT, TH-318

DURABLE 4 INCH YELLOW LINE, TYPE A TAPE AND TEMPORARY 4 INCH YELLOW LINE, PAINT
 (ALL LINES WILL INCLUDE C/L LINE BREAKS FOR TOWN HIGHWAYS)
 S = SOLID, D = DASHED
 ROCKINGHAM:
 STA R 62+75.00 - STA R 66+75.00 DOUBLE SOLID LT
 STA R 63+41.28 DOUBLE SOLID LT, TH-320
 STA R 65+89.44 DOUBLE SOLID LT, TH-318

DURABLE 24 INCH STOP BAR, TYPE A TAPE AND TEMPORARY 24 INCH STOP BAR, PAINT
 ROCKINGHAM:
 STA R 63+41.28 LT, TH-320
 STA R 65+89.44 LT, TH-318


DURABLE CROSSWALK MARKING, TYPE A TAPE AND TEMPORARY CROSSWALK MARKING, PAINT
 ROCKINGHAM:
 STA R 63+41.28 LT, TH-320
 STA R 63+55.00 LT/RT
 STA R 65+89.44 LT, TH-318

DURABLE LETTER OR SYMBOL, TYPE D TAPE
 ROCKINGHAM:
 STA R 62+77.00 C/L ARROW (1EA)
~~STA R 63+08.00 C/L ARROW (1EA)~~
 STA R 63+41.28 LT, TH-320 "S,T,O,P" (4 EA)
 STA R 63+62.00 C/L ARROW (1EA)
 STA R 64+11.50 C/L "O,N,L,Y" (4 EA)
 STA R 64+61.00 C/L ARROW (1EA)
 STA R 65+05.50 C/L "O,N,L,Y" (4 EA)
 STA R 65+60.00 C/L ARROW (1EA)
 STA R 65+89.44 LT, TH-318 "S,T,O,P" (4 EA)
 STA R 66+14.00 C/L ARROW (1EA)
 STA R 66+64.00 C/L "O,N,L,Y" (4 EA)

DURABLE 8 INCH WHITE LINE, TYPE A TAPE
 ROCKINGHAM:
~~STA R 62+96.00 - STA R 63+08.00 LT, FIRE HYDRANT, NO PARKING~~

TEMPORARY LETTER OR SYMBOL, PAINT
 ROCKINGHAM:
 STA R 62+77.00 C/L ARROW (2 EA)
 STA R 63+08.00 C/L ARROW (2 EA)
 STA R 63+41.28 LT, TH-320 "S,T,O,P" (8 EA)
 STA R 63+62.00 C/L ARROW (2 EA)
 STA R 64+61.00 C/L ARROW (2 EA)
 STA R 65+60.00 C/L ARROW (2 EA)
 STA R 65+89.44 LT, TH-318 "S,T,O,P" (8 EA)
 STA R 66+14.00 C/L ARROW (2 EA)

REMOVING SIGNS AS SHOWN - II

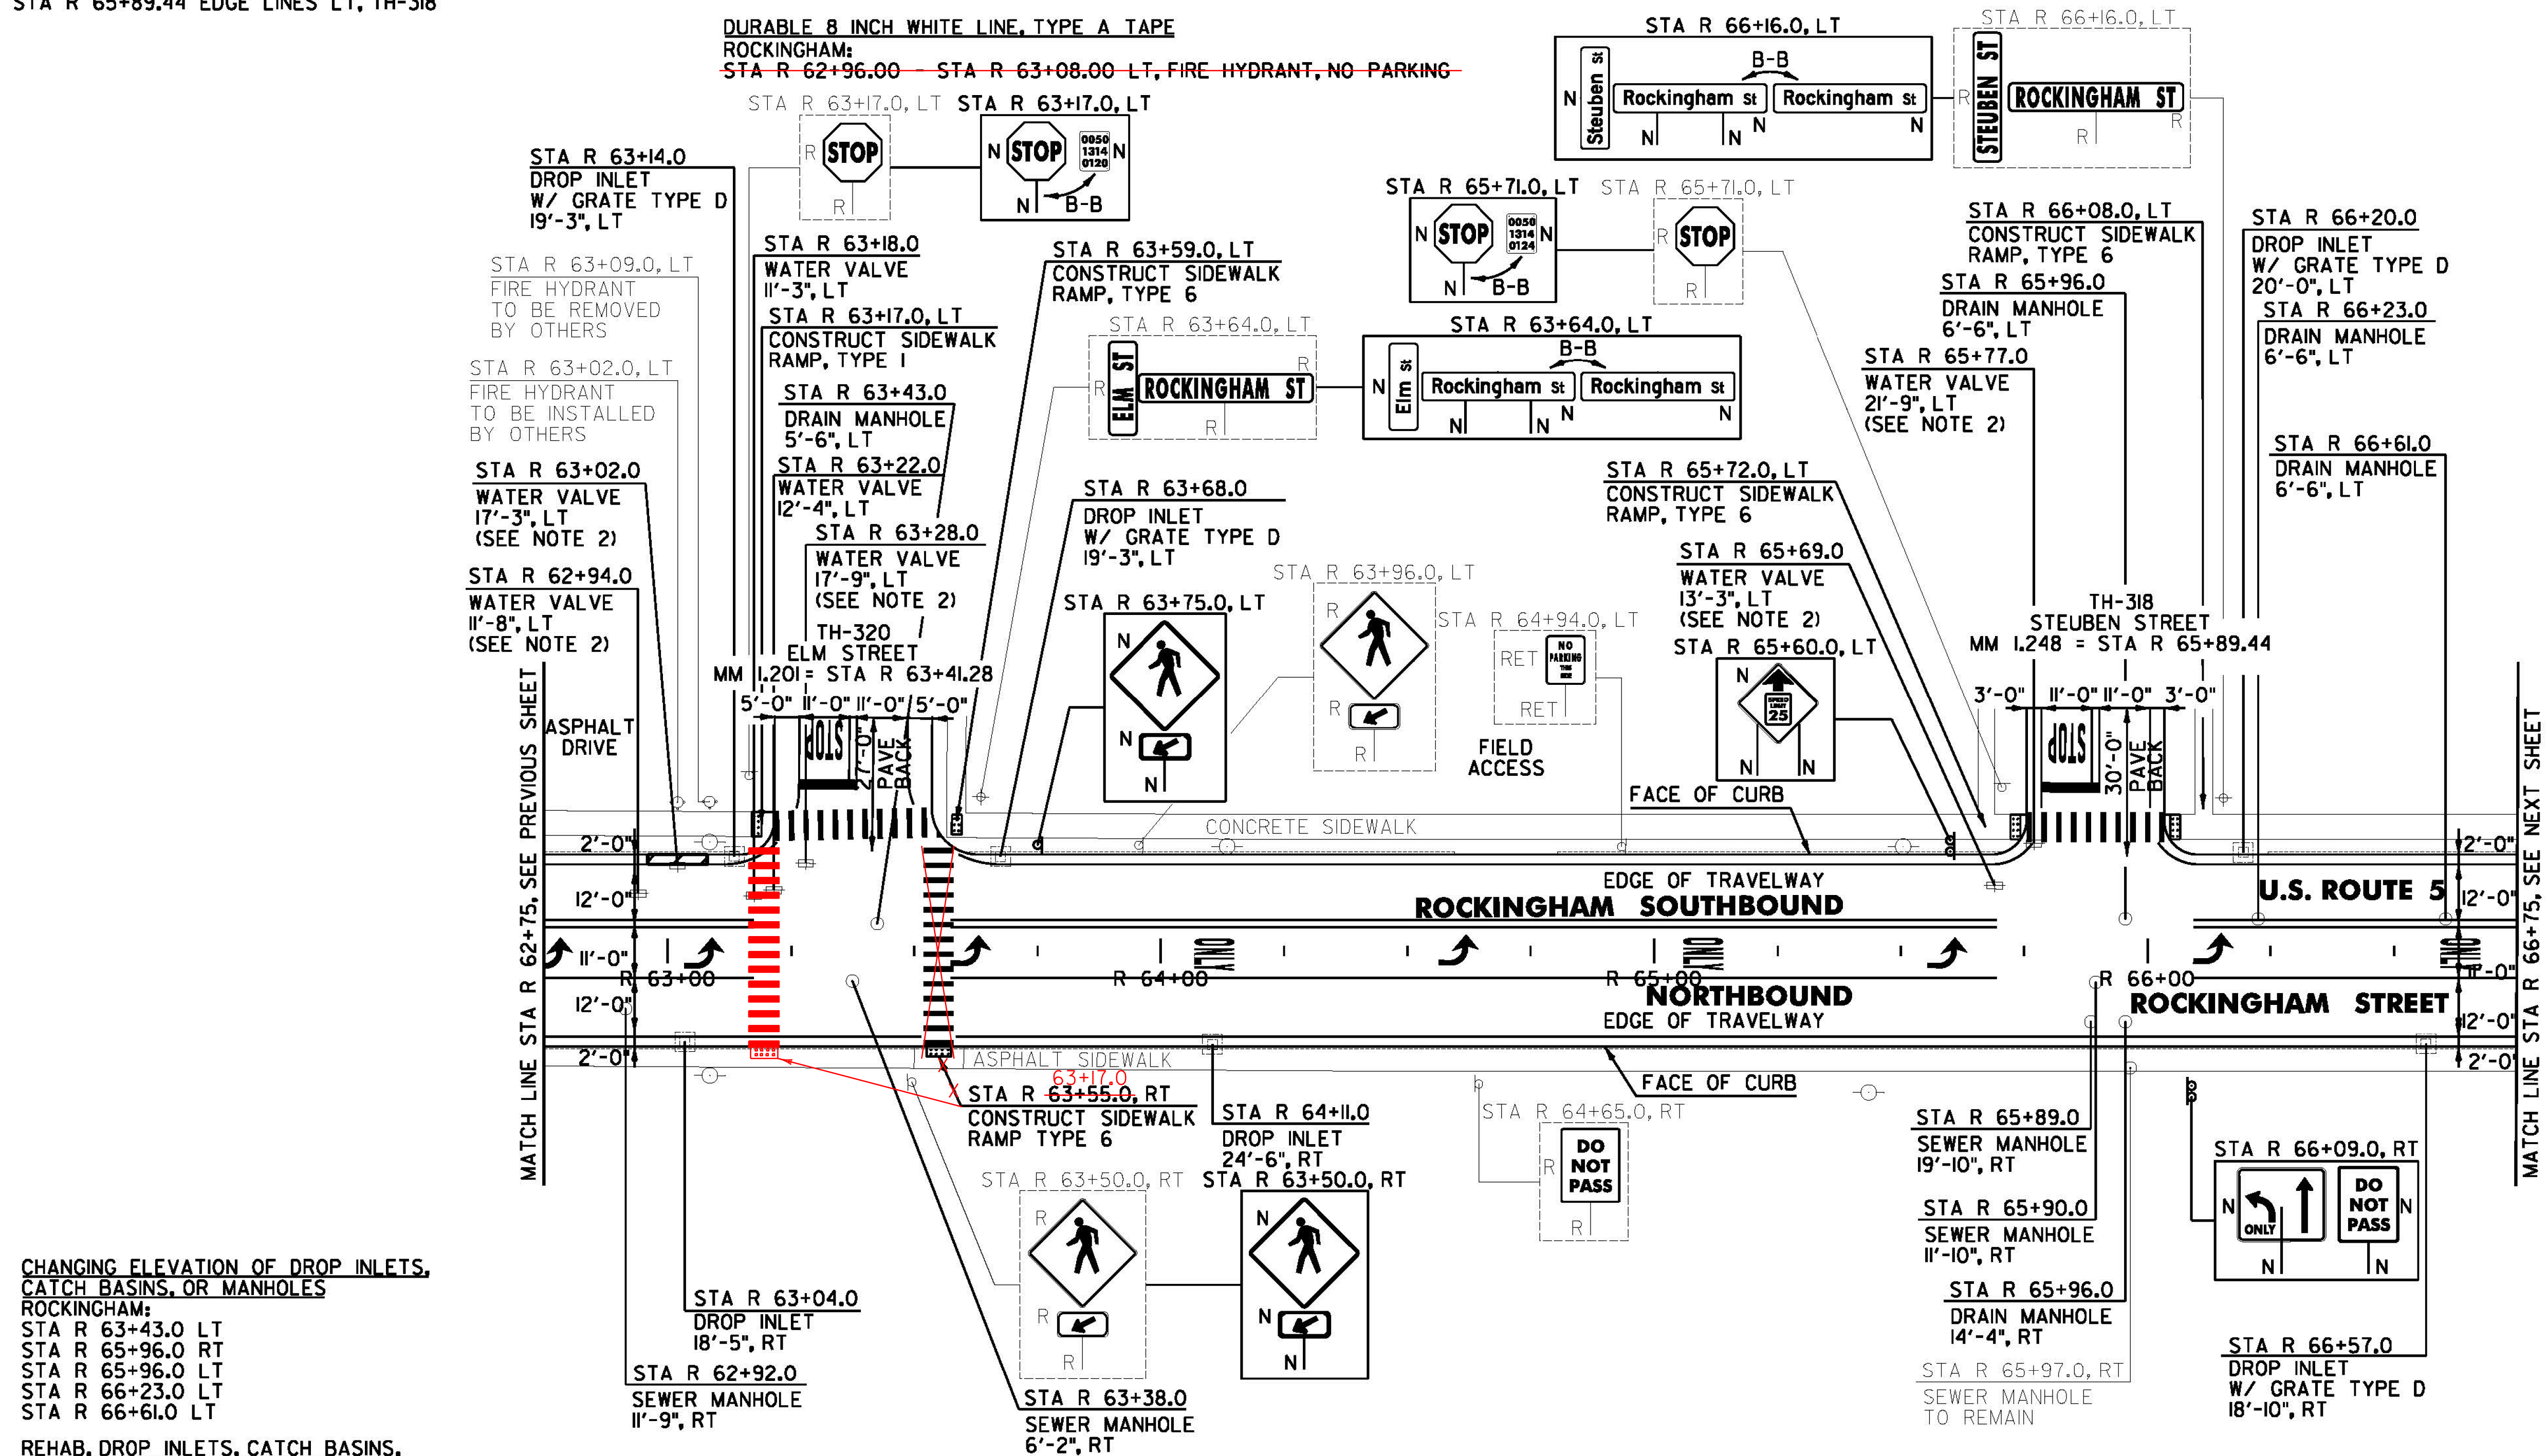

CHANGING ELEVATION OF DROP INLETS, CATCH BASINS, OR MANHOLES
 ROCKINGHAM:
 STA R 63+43.0 LT
 STA R 65+96.0 RT
 STA R 65+96.0 LT
 STA R 66+23.0 LT
 STA R 66+61.0 LT

REHAB. DROP INLETS, CATCH BASINS, OR MANHOLES, CLASS I, II OR III
 ROCKINGHAM:
 STA R 63+04.0 RT
 STA R 63+14.0 LT
 STA R 63+68.0 LT
 STA R 64+11.0 RT
 STA R 66+20.0 LT
 STA R 66+57.0 RT

CHANGING ELEVATION OF SEWER MANHOLES
 ROCKINGHAM:
 STA R 62+92.0 RT
 STA R 63+38.0 RT
 STA R 65+89.0 RT
 STA R 65+90.0 RT

REMOVING AND RESETING CURB
 ROCKINGHAM:
~~STA R 63+55.0 RT~~ STA R 63+17.0 RT

PORTLAND CEMENT CONCRETE SIDEWALK, 5 INCH
 ROCKINGHAM:
 STA R 63+17.0 LT
~~STA R 63+55.0 RT~~ STA R 63+17.0 RT
 STA R 63+59.0 LT
 STA R 65+72.0 LT
 STA R 66+08.0 LT

DETECTABLE WARNING SURFACE
 ROCKINGHAM:
 STA R 63+17.0 LT
~~STA R 63+55.0 RT~~ STA R 63+17.0 RT
 STA R 63+59.0 LT
 STA R 65+72.0 LT
 STA R 66+08.0 LT

CAST IRON GRATE WITH FRAME, TYPE D
 ROCKINGHAM:
 STA R 63+14.0 LT
 STA R 63+68.0 LT
 STA R 66+20.0 LT
 STA R 66+57.0 RT

ADJUST ELEVATION OF VALVE BOX
 ROCKINGHAM:
 STA R 62+94.0 LT
 STA R 63+02.0 LT
 STA R 63+18.0 LT
 STA R 63+22.0 LT
 STA R 63+28.0 LT
 STA R 65+69.0 LT
 STA R 65+77.0 LT

SIGN LEGEND
 R = REMOVE
 S = SALVAGE
 N = NEW
 RET = RETAIN
 B-B = BACK TO BACK
 EXISTING = _____
 NEW = _____
 R = RETURN TO TOWN OF ROCKINGHAM

NOT TO SCALE

ROCKINGHAM PROJECT LAYOUT SHEET #17

NOTES:
 1. SEE SHEET 16 FOR FIRE HYDRANT PAVEMENT MARKING DETAIL.
 2. WATER VALVE TO BE INSTALLED AS PART OF THE BELLOW FALLS WATER MAIN IMPROVEMENTS PROJECT.

PROJECT NAME: CHESTER-SPRINGFIELD-ROCKINGHAM-WINDSOR
 PROJECT NUMBER: STP 2952(II)
 FILE NAME: z13c518bdr_seg03.dgn
 PROJECT LEADER: D. GOZALKOWSKI
 DESIGNED BY: A. HAWKINS

PLOT DATE: 3/27/2015
 DRAWN BY: A. KIRBY
 CHECKED BY: J. SHIELDS
 SHEET 195 OF 309