
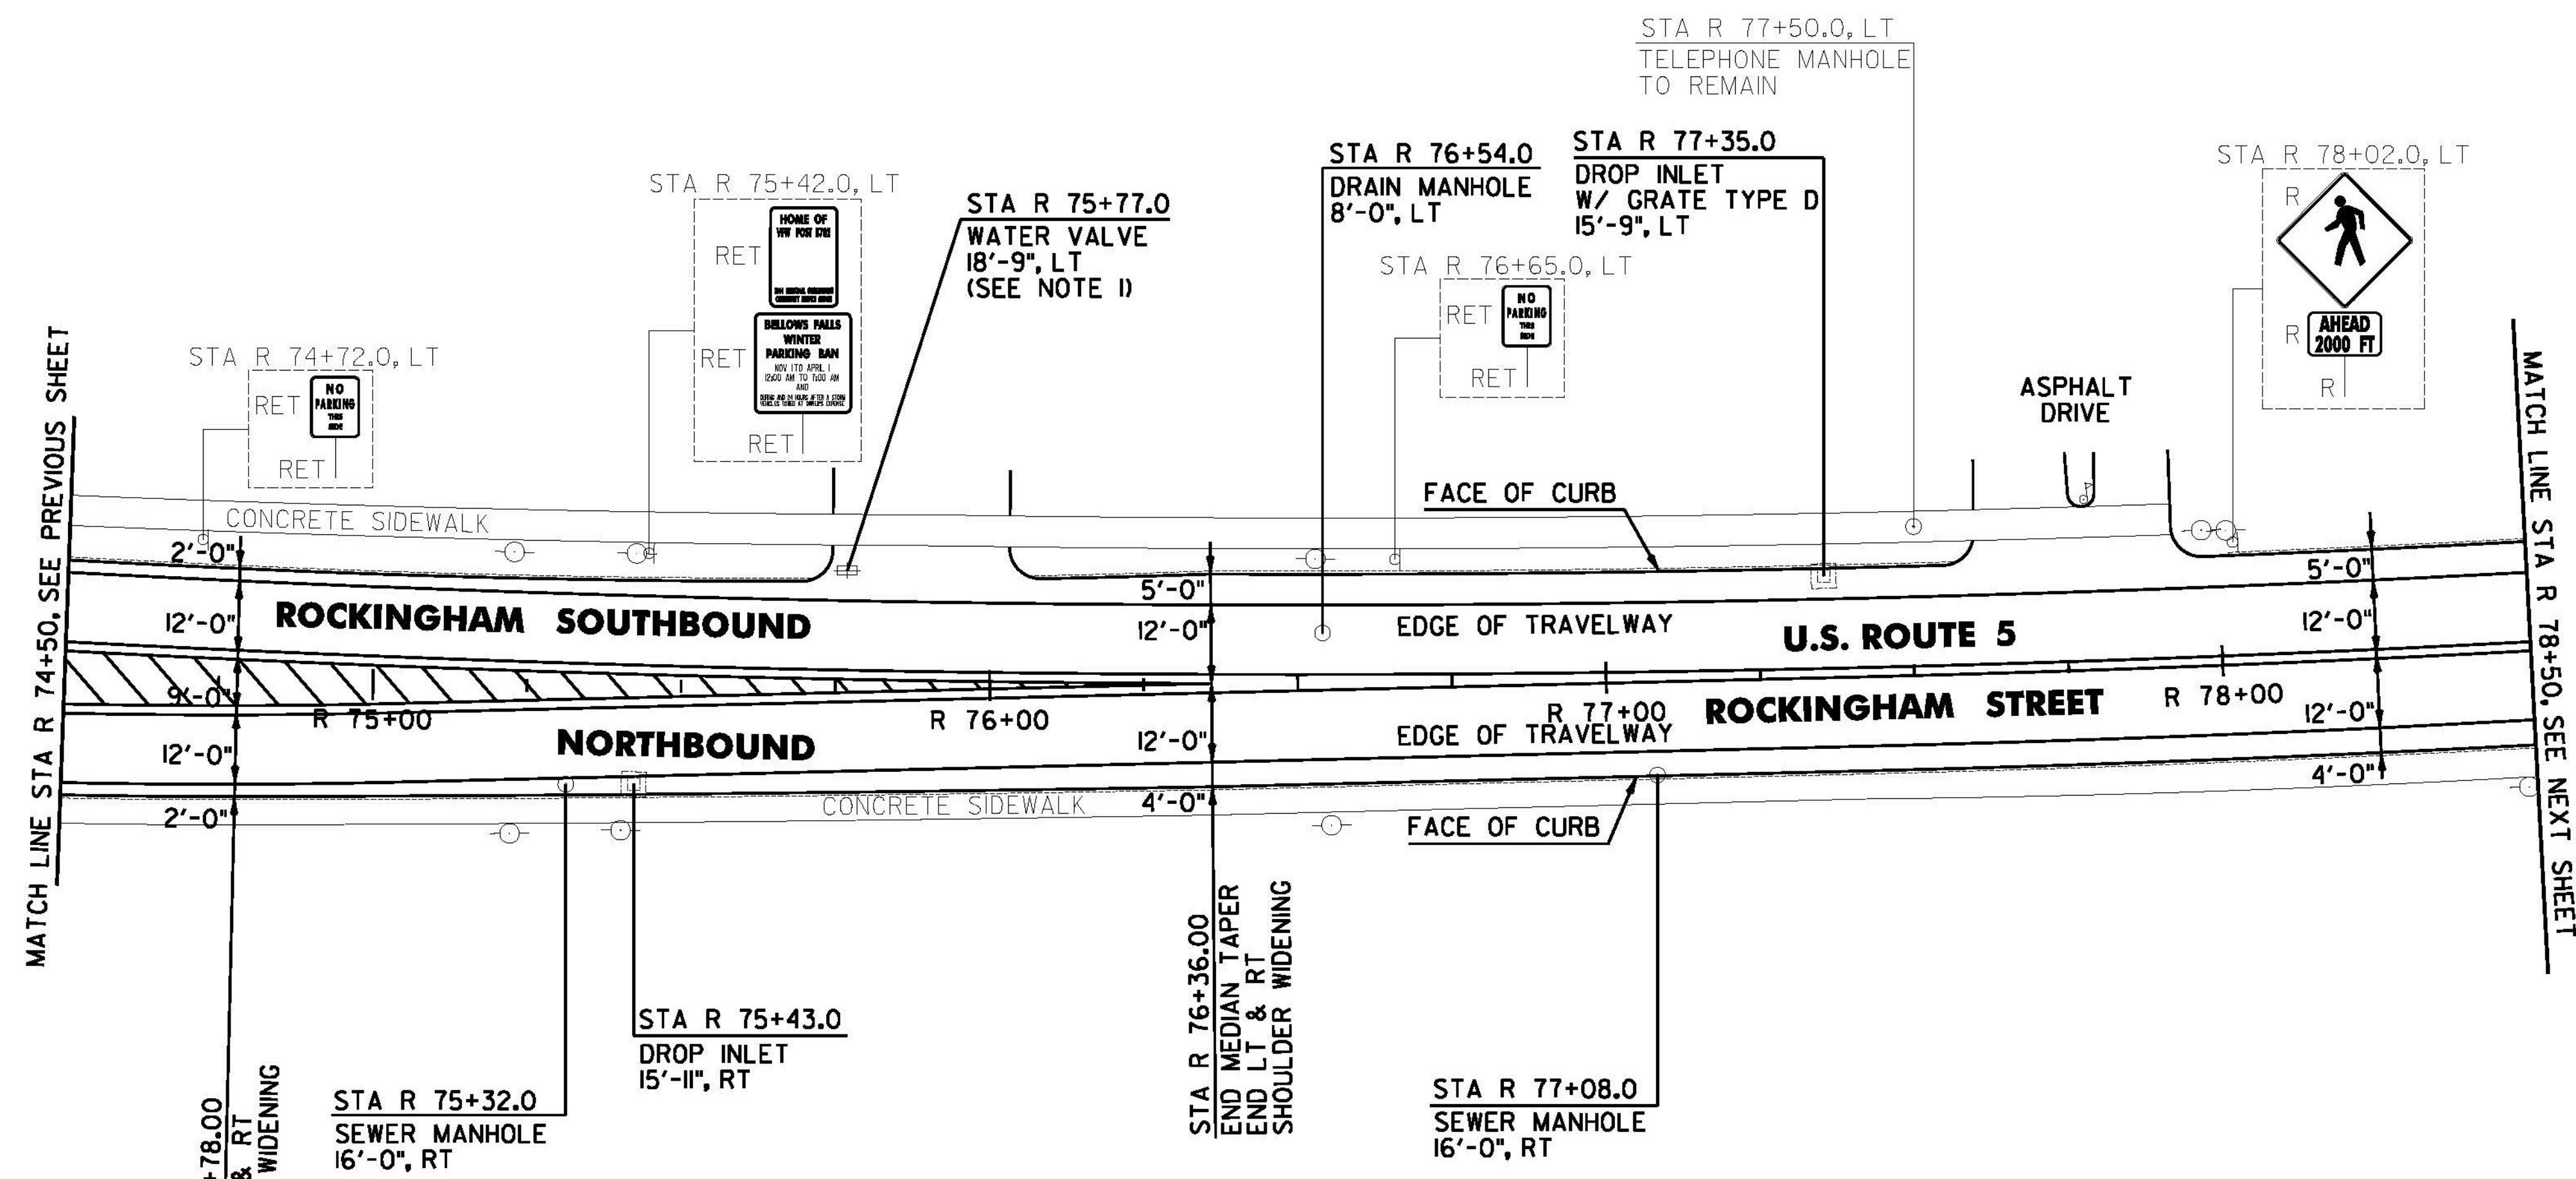


**DURABLE 4 INCH WHITE LINE, TYPE A TAPE AND
TEMPORARY 4 INCH WHITE LINE, PAINT**
(ALL LINES WILL INCLUDE EDGE LINE BREAKS AND RADIUS FOR
TOWN HIGHWAYS)
ROCKINGHAM:
STA R 74+50.00 - STA R 78+50.00 EDGE LINE LT & RT

**DURABLE 4 INCH YELLOW LINE, TYPE A TAPE AND
TEMPORARY 4 INCH YELLOW LINE, PAINT**
(ALL LINES WILL INCLUDE C/L LINE BREAKS FOR TOWN HIGHWAYS)
S = SOLID, D = DASHED
ROCKINGHAM:
STA R 76+36.00 - STA R 78+50.00 LT & RT
STA R 74+50.00 - STA R 76+36.00 DOUBLE SOLID MEDIAN LT/RT

DURABLE 8 INCH YELLOW LINE, TYPE A TAPE
ROCKINGHAM:
STA R 74+50.00 - STA R 76+36.00 HATCHED MEDIAN LT/RT

REMOVING SIGNS
AS SHOWN - 2

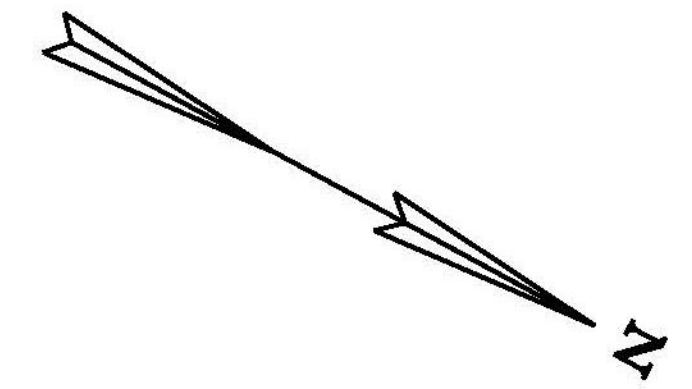

MATCH LINE STA R 74+50, SEE PREVIOUS SHEET

MATCH LINE STA R 78+50, SEE NEXT SHEET

STA R 74+78.00
BEGIN LT & RT
SHOULDER WIDENING

CAST IRON GRATE WITH FRAME, TYPE D
ROCKINGHAM:
STA R 77+35.0 LT

**CHANGING ELEVATION OF DROP INLETS,
CATCH BASINS, OR MANHOLES**
ROCKINGHAM:
STA R 76+54.0 LT

**REHAB. DROP INLETS, CATCH BASINS,
OR MANHOLES, CLASS I, II OR III**
ROCKINGHAM:
STA R 75+43.0 RT
STA R 77+35.0 LT

CHANGING ELEVATION OF SEWER MANHOLES
ROCKINGHAM:
STA R 75+32.0 RT
STA R 77+08.0 RT

ADJUST ELEVATION OF VALVE BOX
ROCKINGHAM:
STA R 75+77.0 LT

SIGN LEGEND
R = REMOVE
S = SALVAGE
N = NEW
RET = RETAIN
B-B = BACK TO BACK
EXISTING = _____
NEW = _____
R = RETURN TO TOWN
OF ROCKINGHAM

NOTE:
I. WATER VALVE TO BE INSTALLED AS PART OF THE
BELLOWS FALLS WATER MAIN IMPROVEMENTS
PROJECT.

ROCKINGHAM PROJECT LAYOUT SHEET #20	PROJECT NAME: CHESTER-SPRINGFIELD-ROCKINGHAM-WINDSOR	PLOT DATE: 3/27/2015
	PROJECT NUMBER: STP 295210	DRAWN BY: A. KIRBY
	FILE NAME: z13c518bdr_seg03.dgn PROJECT LEADER: D. GOZALKOWSKI DESIGNED BY: A. HAWKINS	CHECKED BY: J. SHIELDS SHEET 198 OF 309