




PEDESTRIAN SIGNAL HEADS

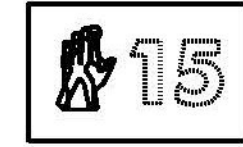

FACES P1, P2

ITEM 900.620 SPECIAL PROVISION
(PEDESTRIAN SIGNAL HEADS, COUNTDOWN)
(U.S. ROUTE 5 @ OLD TERRACE)

DESCRIPTION		QUANTITY	UNIT
16"x18" LED PEDESTRIAN HEAD WITH VISOR & MOUNTING HARDWARE (HAND/MAN SYMBOLS WITH COUNTDOWN TIMER)	SIDE MOUNT	4	EA
AUDIBLE PEDESTRIAN SIGNAL AND SIGN		4	EA

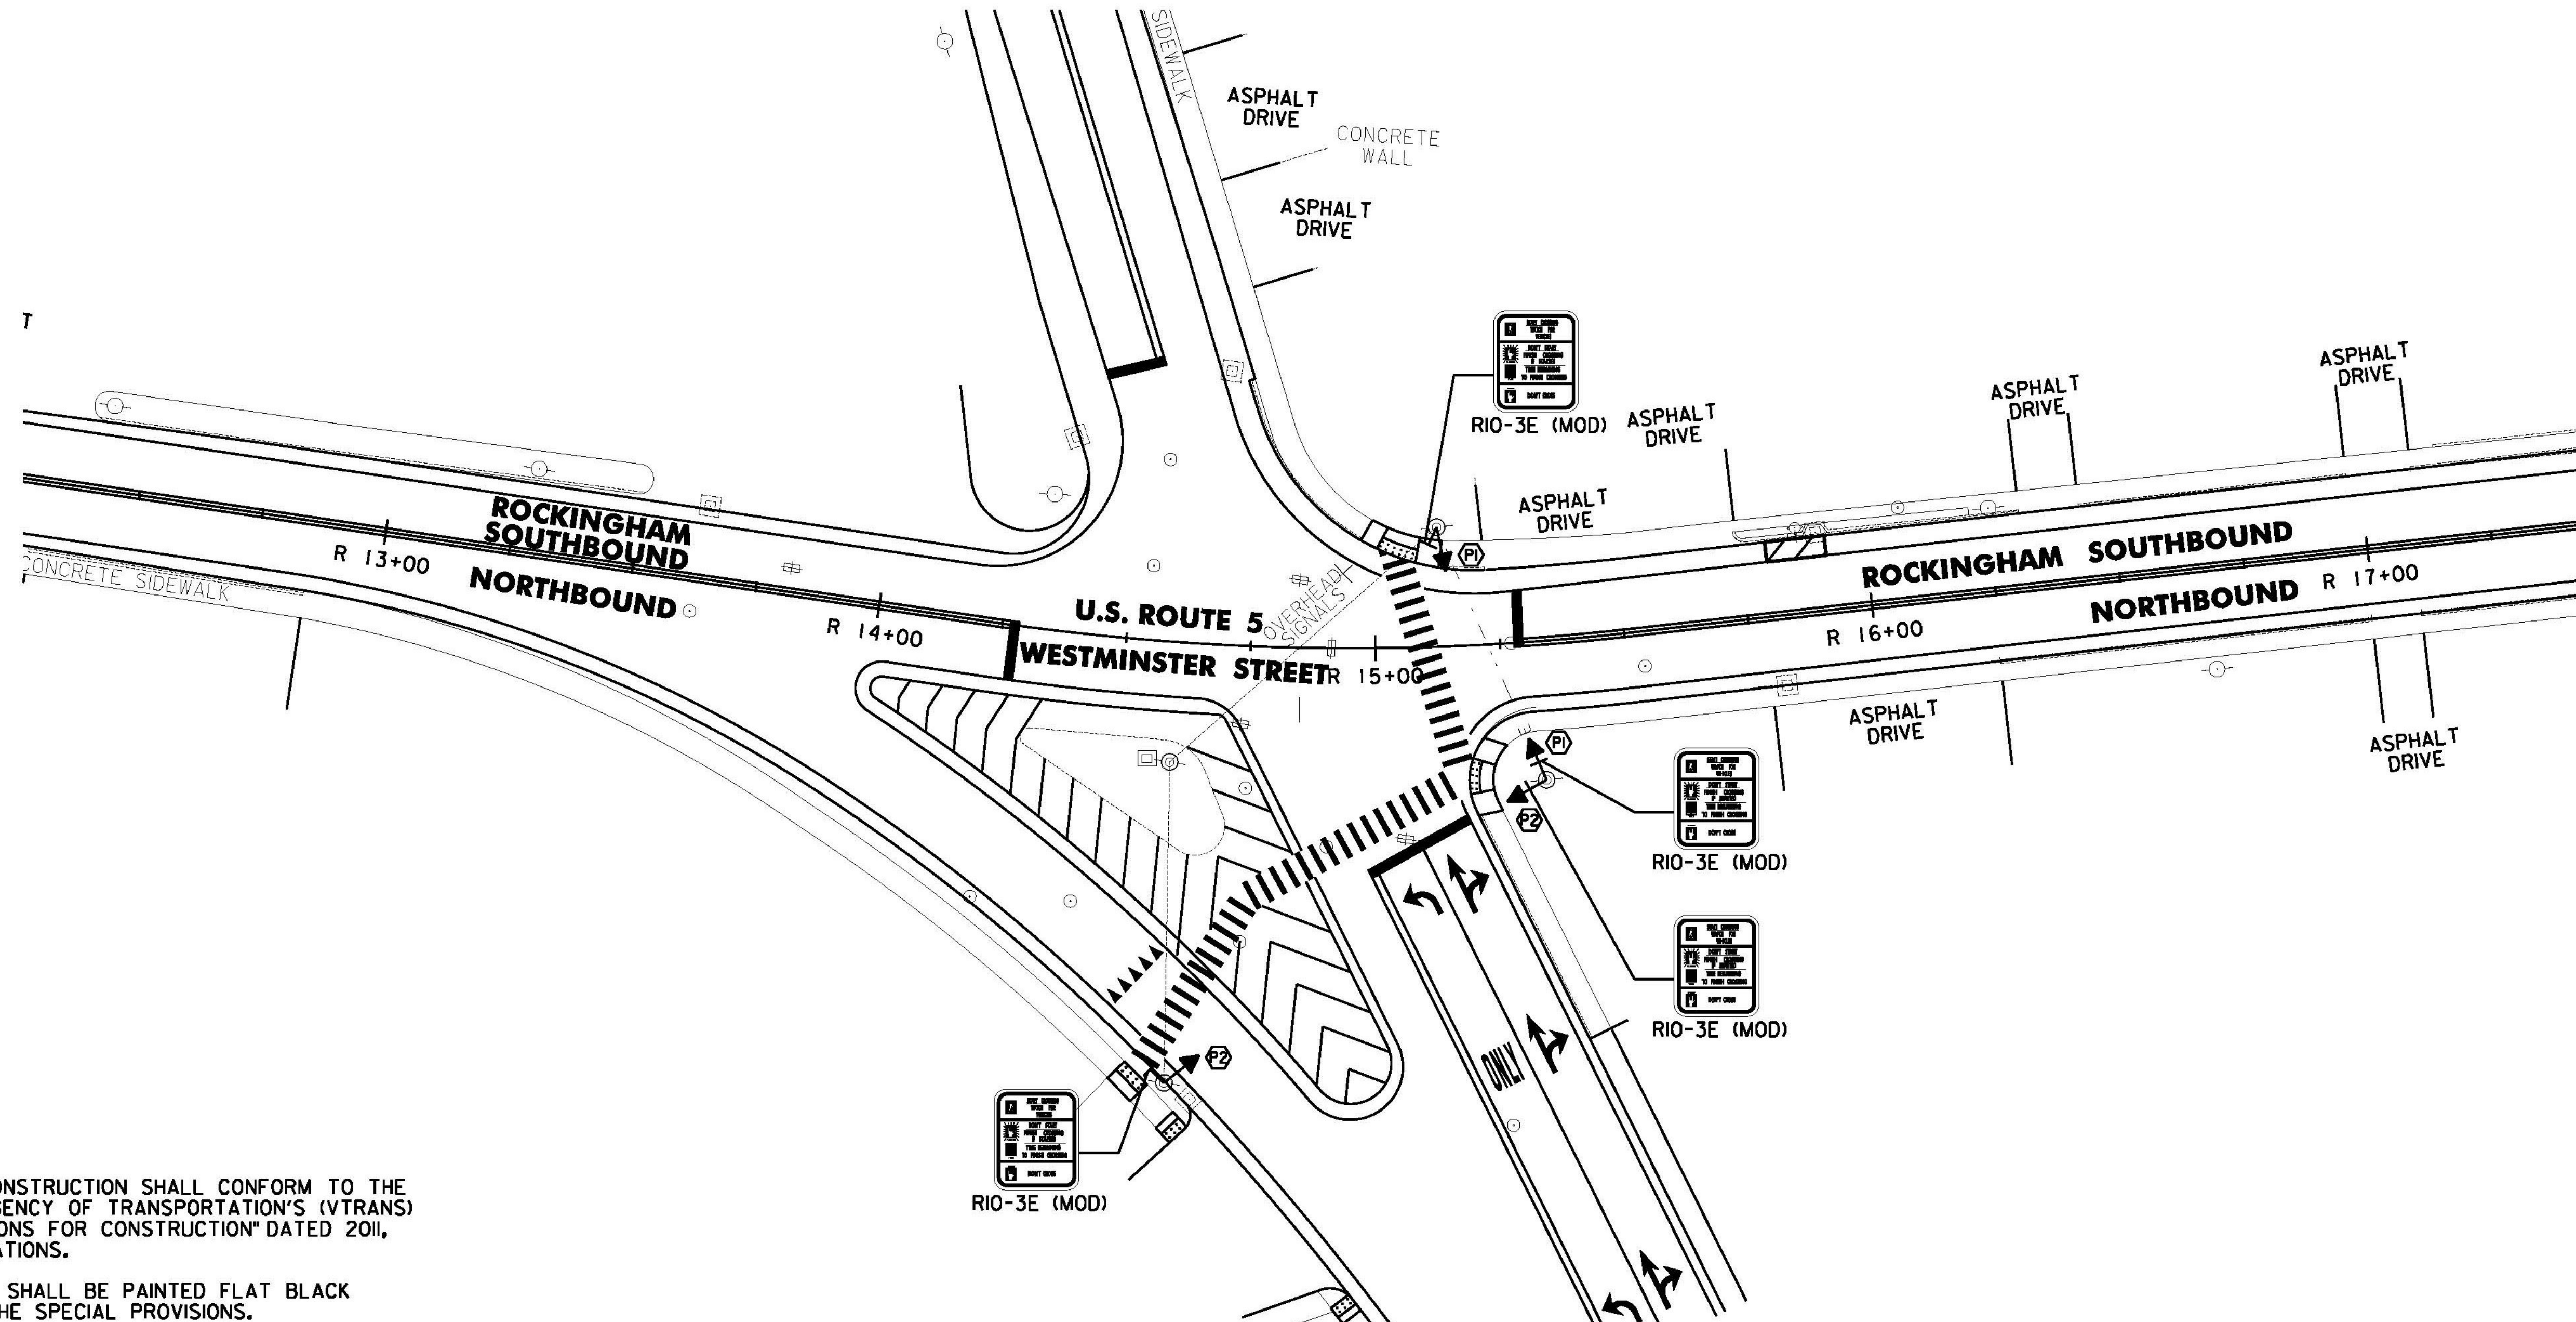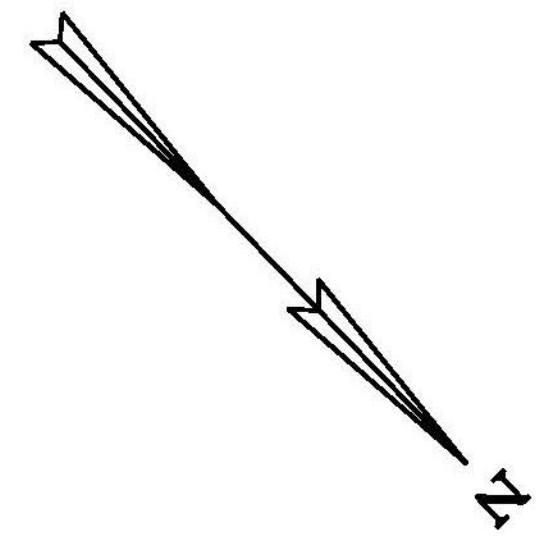

NOTES:

1. ALL MATERIALS AND CONSTRUCTION SHALL CONFORM TO THE STATE OF VERMONT AGENCY OF TRANSPORTATION'S (VTRANS) "STANDARD SPECIFICATIONS FOR CONSTRUCTION" DATED 2011, WITH CURRENT MODIFICATIONS.
2. ALL SIGNAL EQUIPMENT SHALL BE PAINTED FLAT BLACK IN ACCORDANCE WITH THE SPECIAL PROVISIONS.
3. A UNIFORMED TRAFFIC OFFICER WITH A BLUE LIGHT SHALL BE PRESENT DURING ALL LANE CLOSURES.
4. ALL ELECTRICAL WIRING SHALL BE PERFORMED BY A LICENSED ELECTRICIAN AND OVERSEEN BY A MASTER ELECTRICIAN.
5. DISCONNECT WIRING TO EXISTING PEDESTRIAN SIGNAL HEADS. THE EXISTING PEDESTRIAN SIGNAL HEADS SHALL BE REMOVED AND RETURNED TO THE TOWN OF ROCKINGHAM. THE PROPOSED PEDESTRIAN SIGNAL HEADS SHALL BE INSTALLED ON EXISTING POLES. EXISTING WIRING SHALL BE CONNECTED TO THE NEW PEDESTRIAN SIGNALS AND AUDIBLE PEDESTRIAN SIGNAL.

LEGEND	
DESCRIPTION	
	EXISTING ANTENNA & PREEMPTION LIGHT
	EXISTING CONDUIT
	EXISTING JUNCTION BOX
	EXISTING CONTROLLER CABINET
	EXISTING SIGNAL POLE
	PROPOSED VEHICLE DETECTION AREA
	PROPOSED VEHICLE DETECTOR
	EXISTING SIGNAL
	PROPOSED SIGNAL

NOT TO SCALE
**ROCKINGHAM
TRAFFIC
SIGNAL
PLAN
SHEET**

PROJECT NAME: CHESTER-SPRINGFIELD-ROCKINGHAM-WINDSOR	PLOT DATE: 3/27/2015
PROJECT NUMBER: STP 295210	DRAWN BY: A. KIRBY
FILE NAME: z13c518bdr_vd.dgn	CHECKED BY: D. KAHLBAUGH
PROJECT LEADER: D. GOZALKOWSKI	SHEET 222 OF 309
DESIGNED BY: S. BOWMAN	