



LOCATION				FEET OF DITCHING			MISC. ITEMS				REMARKS	LOCATION				FEET OF DITCHING			MISC. ITEMS			REMARKS
SITE	STATION	STATION	POS.	PERCENT GRADE			STONE FILL, TYPE I	SEED	TEMP. EROS. MATT.	GEO. UNDER STONE FILL		SITE	STATION	STATION	POS.	PERCENT GRADE			STONE FILL, TYPE I	SEED	TEMP. EROS. MATT.	
				0-2.5	2.5-10	>10										0-2.5	2.5-10	>10				
VT. ROUTE 44							CY	LB	SY	SY								CY	LB	SY		
WINDSOR:																						
1	W 83+85	W 86+79	RT		294		44															
	84+55	88+05			350		82.96															
2	W 87+36	W 87+85	RT		49		8															
	89+22	89+80			58		9.03															
3	W 92+85	W 95+79	RT		294		44															
4	W 96+12	W 101+91	RT		579		86															
	W 103+50	W 103+74	RT		24		4.66															
5	W 105+07	W 109+72	RT		465		69															
6	W 115+80	W 118+33	RT		253		38															
	117+40				93		17.88															
7	W 154+00	W 159+00	LT	500					222													
	W 185+40	W 186+00	RT		60		79.38															
ROUNDING:					16		11		8													
TOTALS:					1950		300		230													
							193.91															

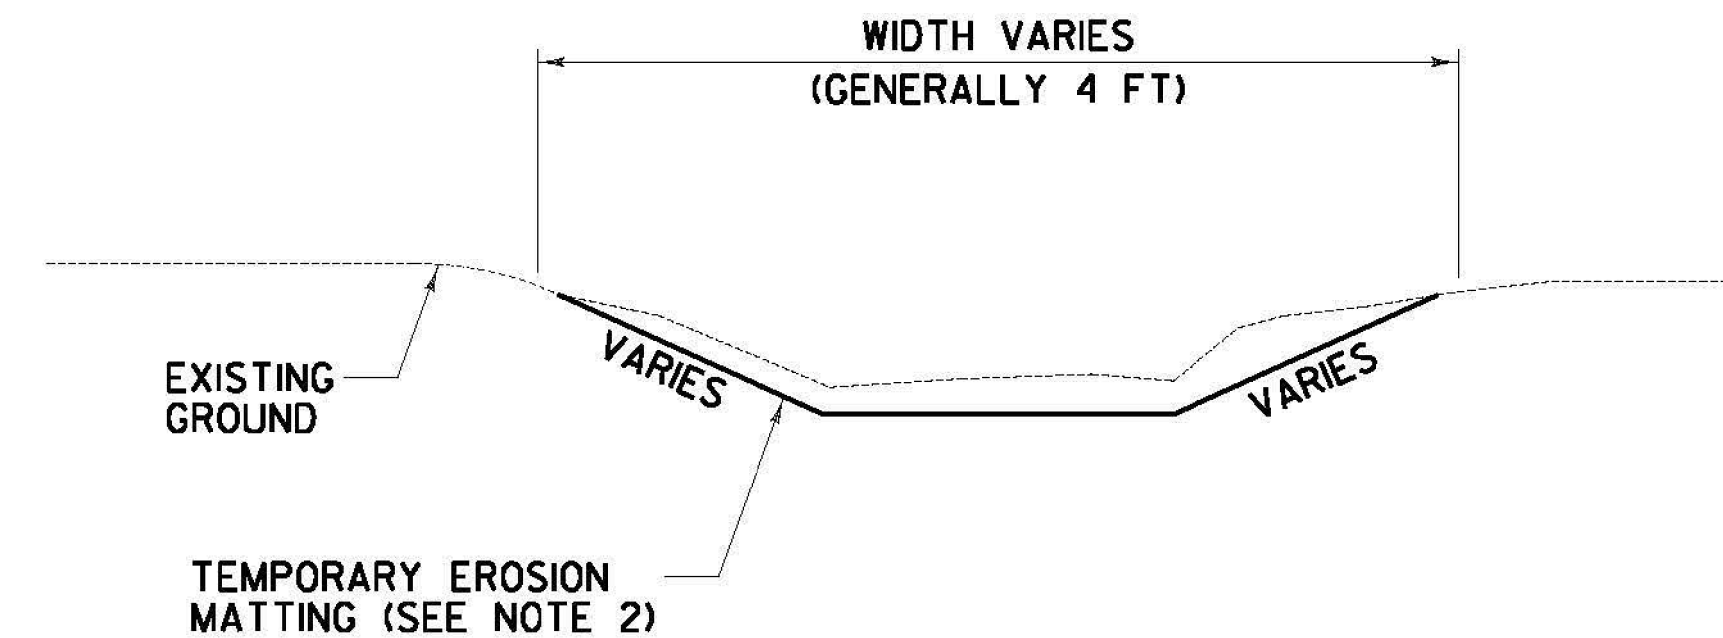

DITCH DETAIL

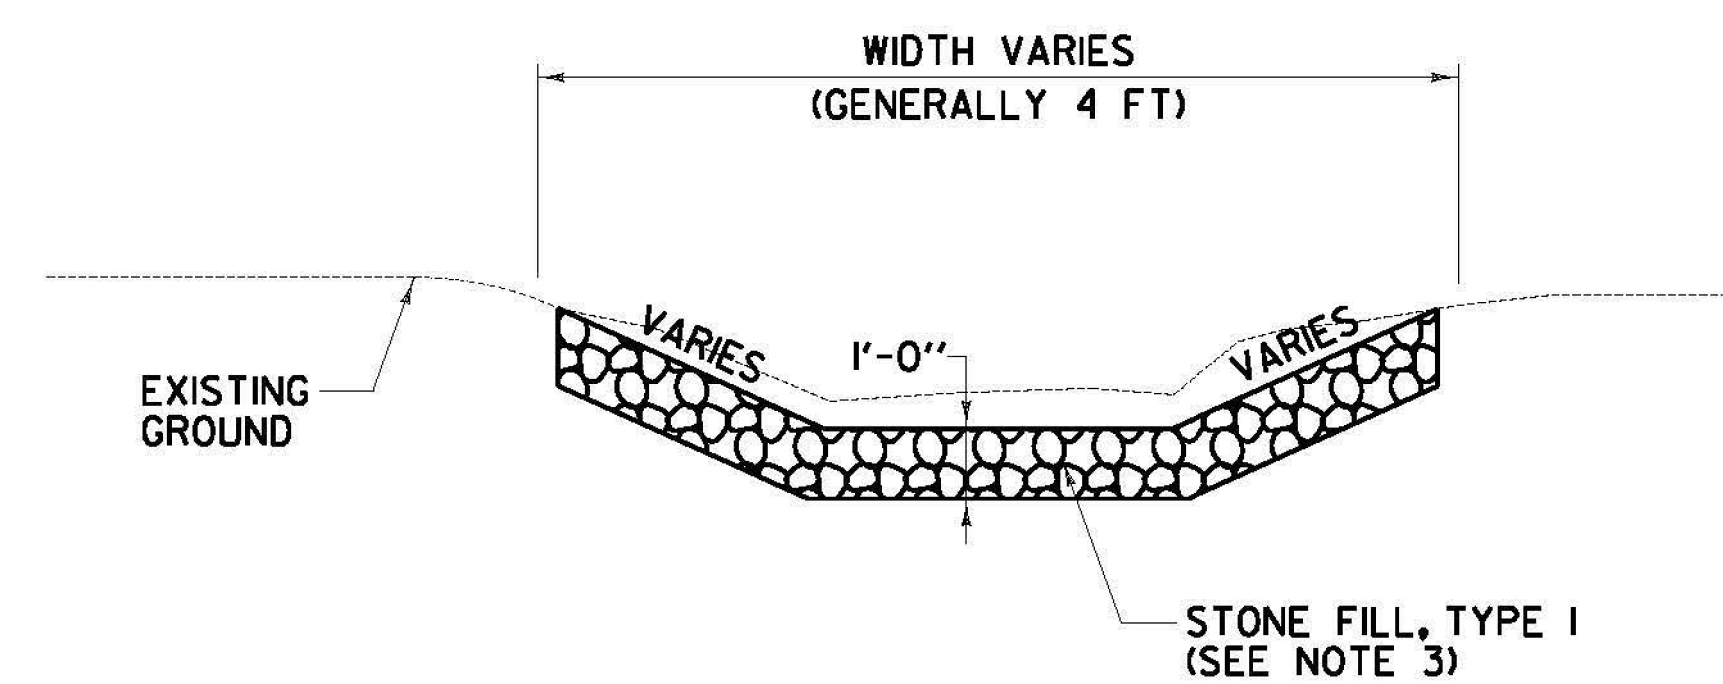

STONE DITCH DETAIL

NOTES:

- PIPE INLET AND OUTLET AREAS AND DITCH CLEANING THROUGHOUT THE PROJECT SHALL BE PERFORMED AT LOCATIONS IDENTIFIED ON THIS SHEET AND AS DIRECTED BY THE ENGINEER. PAYMENT WILL BE MADE UNDER THE APPLICABLE EQUIPMENT RENTAL ITEM(S).
- ESTIMATED QUANTITIES OF TEMPORARY EROSION MATTING AND SEED HAVE BEEN INCLUDED AS NEEDED OR AS DIRECTED BY THE ENGINEER.
- ESTIMATED QUANTITIES OF STONE FILL TYPE I HAVE BEEN INCLUDED AS NEEDED. STONE FILL TYPE I SHALL BE USED IN ALL DITCHES WITH A GRADE BETWEEN 2.5 AND 10 PERCENT OR AS DIRECTED BY THE ENGINEER.

WINDSOR DITCH CLEANING DETAIL SHEET	PROJECT NAME: CHESTER-SPRINGFIELD-ROCKINGHAM-WINDSOR
	PROJECT NUMBER: STP 2952(1)
	FILE NAME: z13c518dcd.dgn
PROJECT LEADER: D. GOZALKOWSKI	PLOT DATE: 3/27/2015
DESIGNED BY: A. HAWKINS	DRAWN BY: A. KIRBY
	CHECKED BY: J. SHIELDS
	SHEET 236 OF 309