

DURABLE 24 INCH STOP BAR, TYPE A TAPE AND TEMPORARY 24 INCH STOP BAR, PAINT
WINDSOR:
 STA W 196+36.32 RT, TH-33

DURABLE LETTER OR SYMBOL, TYPE D TAPE
WINDSOR:
 STA W 195+85.00 RT, HANDICAP SYMBOL (1 EA)
 STA W 195+87.00 LT, HANDICAP SYMBOL (1 EA)
 STA W 196+36.32 RT, TH-33 "S,T,O,P" (4 EA)

TEMPORARY LETTER OR SYMBOL, PAINT
WINDSOR:
 STA W 196+36.32 RT, TH-33 "S,T,O,P" (8 EA)

DURABLE CROSSWALK MARKING, TYPE A TAPE AND TEMPORARY CROSSWALK MARKING, PAINT
WINDSOR:
 STA W 196+36.32 RT, TH-33
 STA W 196+63.00 LT/RT
 STA W 197+64.00 LT/RT

DURABLE 4 INCH WHITE LINE, TYPE A TAPE AND TEMPORARY 4 INCH WHITE LINE, PAINT
 (ALL LINES WILL INCLUDE EDGE LINE BREAKS AND RADIUS FOR TOWN HIGHWAYS)
WINDSOR:
 STA W 195+75.00 - STA W 196+64.00 LT, PARKING SPACES
 STA W 195+75.00 - STA W 196+18.00 RT, PARKING SPACES
 STA W 196+36.32 EDGE LINES RT, TH-33
 STA W 196+62.00 - STA W 197+69.00 RT, PARKING SPACES
 STA W 196+72.00 - STA W 197+26.00 LT, PARKING SPACES
 STA W 197+58.00 - STA W 198+83.00 LT, PARKING SPACES
 STA W 197+77.00 - STA W 198+69.00 RT, PARKING SPACES
 STA W 199+24.00 - STA W 200+39.00 LT, PARKING SPACES
 STA W 199+34.00 - STA W 199+86.00 RT, PARKING SPACES
 STA W 200+34.00 - STA W 200+75.00 RT, PARKING SPACES
 STA W 200+59.00 - STA W 200+75.00 LT, PARKING SPACES



DURABLE 8 INCH YELLOW LINE, TYPE A TAPE
WINDSOR:
 STA W 195+75.00 - STA W 196+22.00 HATCHED MEDIAN LT/RT

DURABLE 8 INCH WHITE LINE, TYPE A TAPE
WINDSOR:
 STA W 195+75.00 - STA W 195+77.00 LT, NO PARKING
 STA W 195+98.00 - STA W 196+18.00 RT, NO PARKING
 STA W 196+43.00 - STA W 196+64.00 LT, NO PARKING
 STA W 196+62.00 - STA W 196+83.00 RT, NO PARKING
 STA W 196+72.00 - STA W 196+92.00 LT, NO PARKING
 STA W 197+18.00 - STA W 197+26.00 LT, NO PARKING
 STA W 197+49.00 - STA W 197+69.00 RT, NO PARKING
 STA W 197+58.00 - STA W 197+62.00 LT, NO PARKING
 STA W 197+77.00 - STA W 197+96.00 RT, NO PARKING
 STA W 198+61.00 - STA W 198+69.00 RT, NO PARKING
 STA W 198+77.00 - STA W 198+83.00 LT, NO PARKING
 STA W 199+24.00 - STA W 199+32.00 LT, NO PARKING
 STA W 199+34.00 - STA W 199+40.00 RT, NO PARKING
 STA W 199+58.00 - STA W 199+70.00 LT, FIRE HYDRANT, NO PARKING
 STA W 199+80.00 - STA W 199+86.00 RT, NO PARKING
 STA W 200+34.00 - STA W 200+39.00 LT, NO PARKING
 STA W 200+34.00 - STA W 200+45.00 RT, NO PARKING
 STA W 200+59.00 - STA W 200+65.00 LT, NO PARKING
 STA W 200+71.00 - STA W 200+75.00 RT, NO PARKING

DURABLE 4 INCH YELLOW LINE, TYPE A TAPE AND TEMPORARY 4 INCH YELLOW LINE, PAINT
 (ALL LINES WILL INCLUDE C/L BREAKS FOR TOWN HIGHWAYS)
 S=SOLID D=DASHED
WINDSOR:
 STA W 196+67.00 - STA W 200+75.00
 STA W 195+75.00 - STA W 196+22.00 DOUBLE SOLID MEDIAN LT/RT
 STA W 196+36.32 DOUBLE SOLID RT, TH-33

ERECTING SALVAGED SIGNS
 AS SHOWN - 2

REMOVING SIGNS
 AS SHOWN - 3

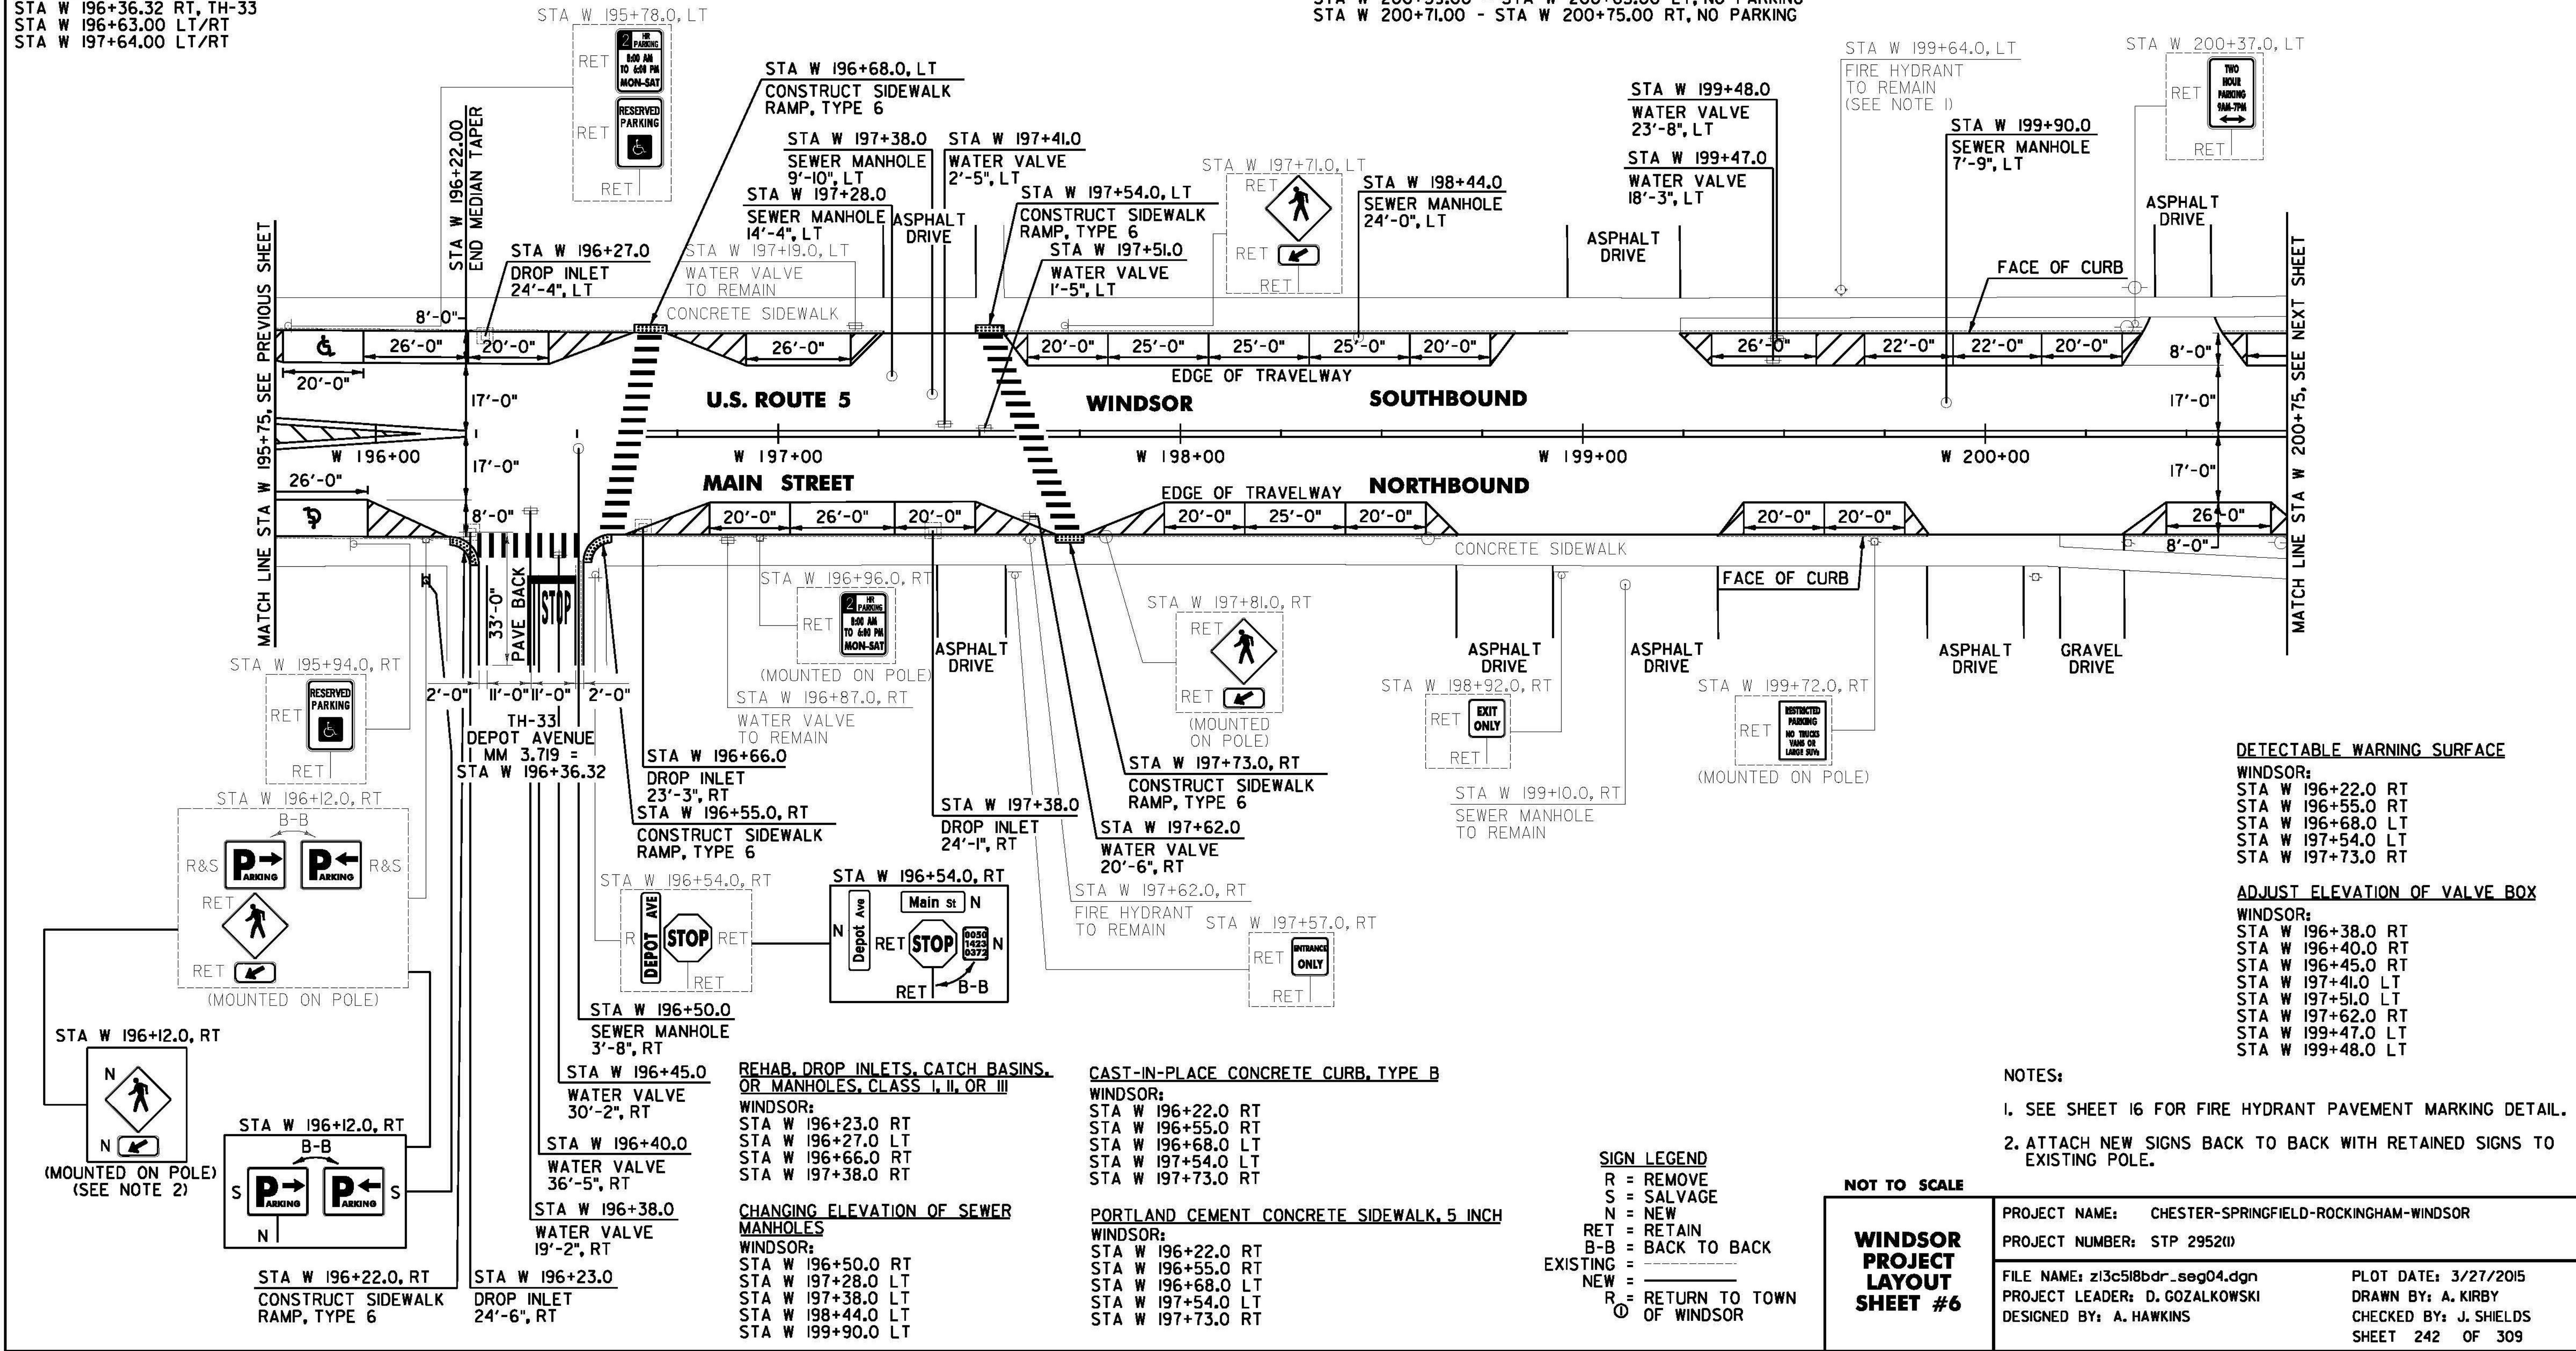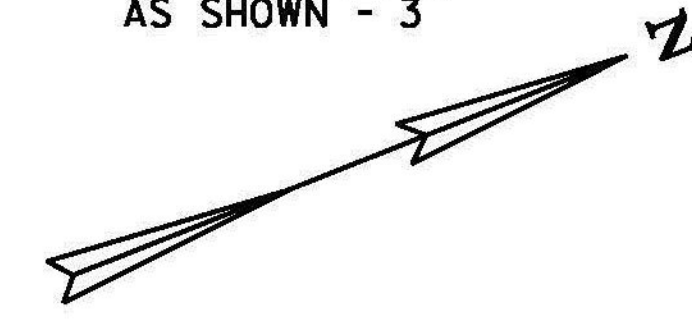

DETECTABLE WARNING SURFACE
WINDSOR:
 STA W 196+22.0 RT
 STA W 196+55.0 RT
 STA W 196+68.0 LT
 STA W 197+54.0 LT
 STA W 197+73.0 RT

ADJUST ELEVATION OF VALVE BOX
WINDSOR:
 STA W 196+38.0 RT
 STA W 196+40.0 RT
 STA W 196+45.0 RT
 STA W 197+41.0 LT
 STA W 197+51.0 LT
 STA W 197+62.0 RT
 STA W 199+47.0 LT
 STA W 199+48.0 LT

NOTES:
 1. SEE SHEET 16 FOR FIRE HYDRANT PAVEMENT MARKING DETAIL.
 2. ATTACH NEW SIGNS BACK TO BACK WITH RETAINED SIGNS TO EXISTING POLE.

SIGN LEGEND
 R = REMOVE
 S = SALVAGE
 N = NEW
 RET = RETAIN
 B-B = BACK TO BACK
 EXISTING = _____
 NEW = _____
 R = RETURN TO TOWN OF WINDSOR

NOT TO SCALE
WINDSOR PROJECT LAYOUT SHEET #6

PROJECT NAME: CHESTER-SPRINGFIELD-ROCKINGHAM-WINDSOR
PROJECT NUMBER: STP 29520
FILE NAME: z13c518bdr_seg04.dgn
PROJECT LEADER: D. GOZALKOWSKI
DESIGNED BY: A. HAWKINS
PLOT DATE: 3/27/2015
DRAWN BY: A. KIRBY
CHECKED BY: J. SHIELDS
SHEET 242 OF 309