
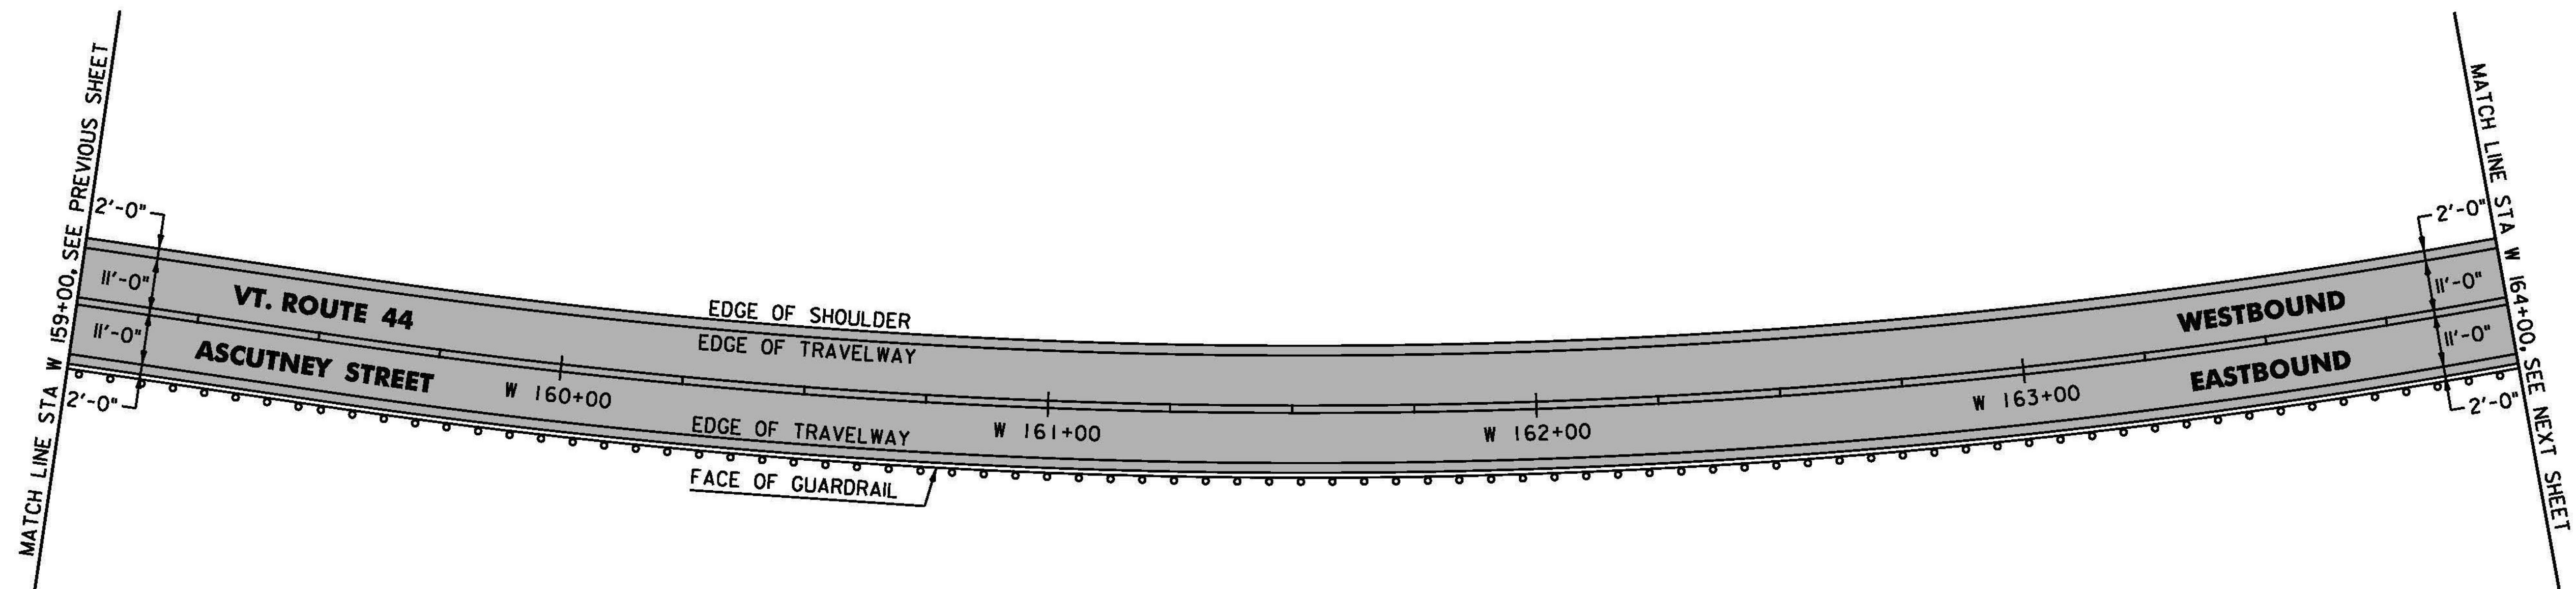


DURABLE 4 INCH WHITE LINE, TYPE A TAPE AND
 TEMPORARY 4 INCH WHITE LINE, PAINT
 (ALL LINES WILL INCLUDE EDGE LINE BREAKS AND RADIUS FOR
 TOWN HIGHWAYS)
 WINDSOR:
 STA W 159+00.00 - STA W 164+00.00 EDGE LINE LT & RT

DURABLE 4 INCH YELLOW LINE, TYPE A TAPE AND
 TEMPORARY 4 INCH YELLOW LINE, PAINT
 (ALL LINES WILL INCLUDE C/L LINE BREAKS FOR TOWN HIGHWAYS)
 S = SOLID, D = DASHED
 WINDSOR:
 STA W 159+00.00 - STA W 164+00.00 LT C RT
 S - S

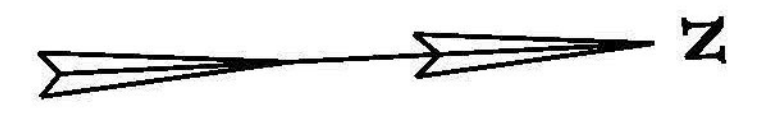

STEEL BEAM GUARDRAIL, GALVANIZED
 WINDSOR:
 STA W 159+00.0 - STA W 164+00.0 RT

REMOVAL AND DISPOSAL OF GUARDRAIL
 WINDSOR:
 STA W 159+00.0 - STA W 164+00.0 RT

LEGEND

 OVERLAY AREA

NOT TO SCALE

**WINDSOR
 PROJECT
 LAYOUT
 SHEET #25**

PROJECT NAME: CHESTER-SPRINGFIELD-ROCKINGHAM-WINDSOR
 PROJECT NUMBER: STP 295200

FILE NAME: z13c518bdr_seg04.dgn
 PROJECT LEADER: D. GOZALKOWSKI
 DESIGNED BY: A. HAWKINS

PLOT DATE: 3/27/2015
 DRAWN BY: A. KIRBY
 CHECKED BY: J. SHIELDS
 SHEET 261 OF 309