
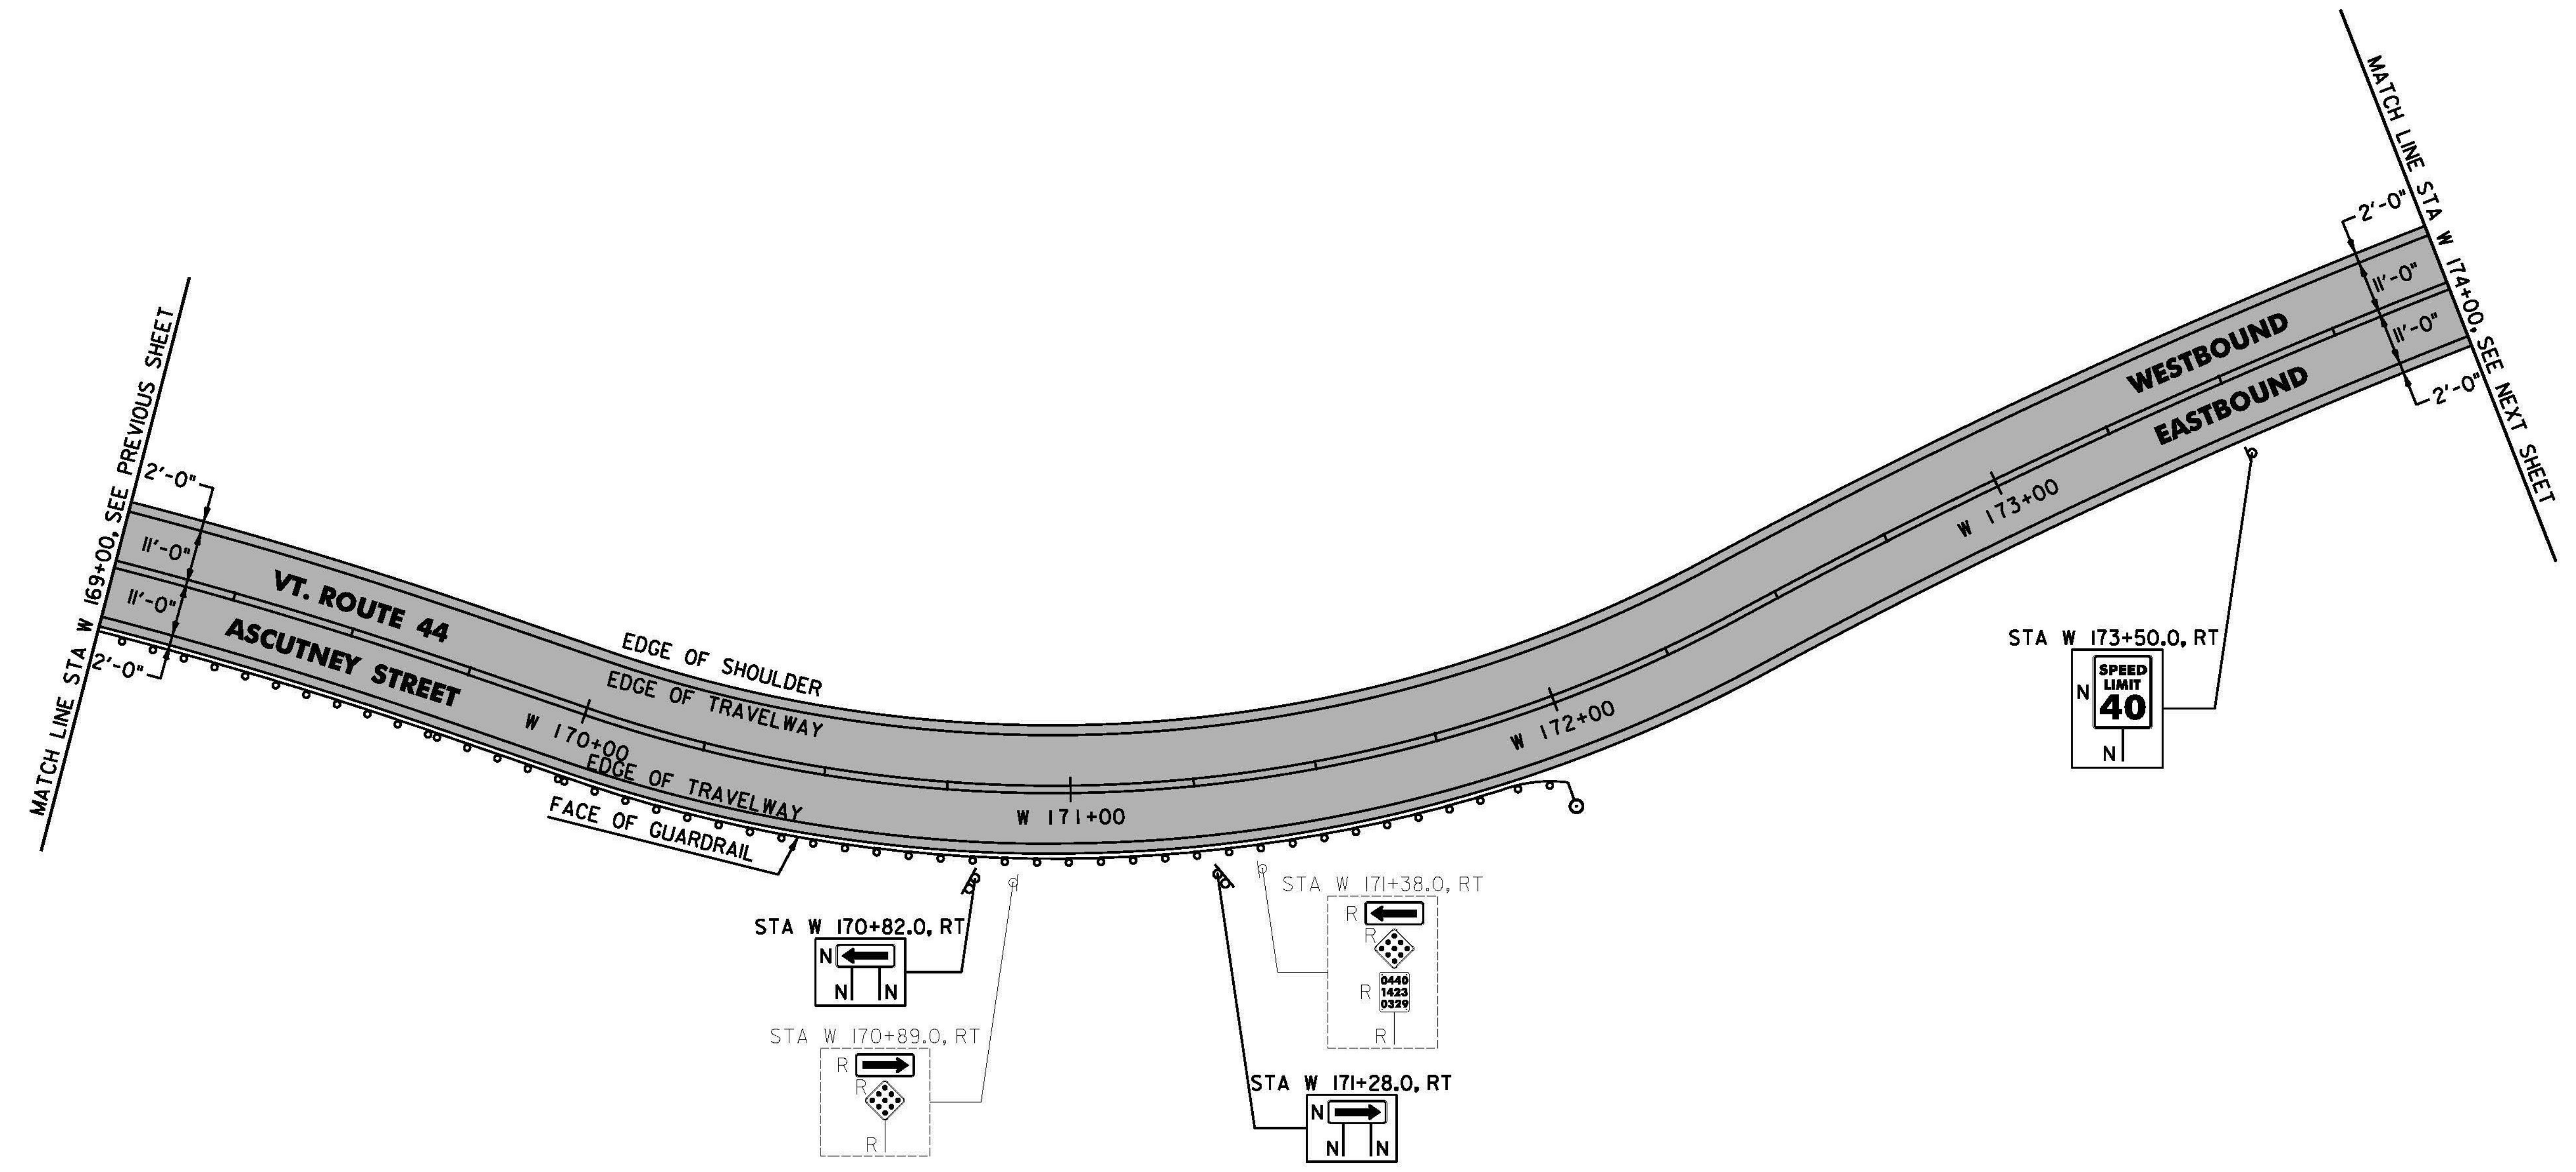


DURABLE 4 INCH WHITE LINE, TYPE A TAPE AND  
 TEMPORARY 4 INCH WHITE LINE, PAINT  
 (ALL LINES WILL INCLUDE EDGE LINE BREAKS AND RADIUS FOR  
 TOWN HIGHWAYS)  
 WINDSOR:  
 STA W 169+00.00 - STA W 174+00.00 EDGE LINE LT & RT

DURABLE 4 INCH YELLOW LINE, TYPE A TAPE AND  
 TEMPORARY 4 INCH YELLOW LINE, PAINT  
 (ALL LINES WILL INCLUDE C/L LINE BREAKS FOR TOWN HIGHWAYS)  
 S = SOLID, D = DASHED  
 WINDSOR:  
 STA W 169+00.00 - STA W 174+00.00 LT C RT  
 S - S

REMOVING SIGNS  
 AS SHOWN - 5

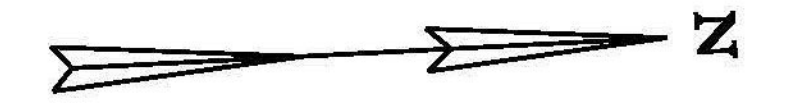

STEEL BEAM GUARDRAIL, GALVANIZED  
 WINDSOR:  
 STA W 169+00.0 - STA W 171+97.0 RT  
 REMOVAL AND DISPOSAL OF GUARDRAIL  
 WINDSOR:  
 STA W 169+00.0 - STA W 171+90.0 RT

ANCHOR FOR STEEL BEAM RAIL  
 WINDSOR:  
 STA W 171+90.5 RT  
 DELINEATOR WITH STEEL POST  
 WINDSOR:  
 STA W 171+97.0 RT

LEGEND  
 [Grey Box] OVERLAY AREA

SIGN LEGEND  
 R = REMOVE  
 S = SALVAGE  
 N = NEW  
 RET = RETAIN  
 B-B = BACK TO BACK  
 EXISTING = \_\_\_\_\_  
 NEW = \_\_\_\_\_  
 R = RETURN TO TOWN  
 OF WINDSOR

NOT TO SCALE  
**WINDSOR  
 PROJECT  
 LAYOUT  
 SHEET #27**

PROJECT NAME: CHESTER-SPRINGFIELD-ROCKINGHAM-WINDSOR	PLOT DATE: 3/27/2015
PROJECT NUMBER: STP 295210	DRAWN BY: A. KIRBY
FILE NAME: z13c5i8bdr_seg04.dgn	CHECKED BY: J. SHIELDS
PROJECT LEADER: D. GOZALKOWSKI	SHEET 263 OF 309
DESIGNED BY: A. HAWKINS	