
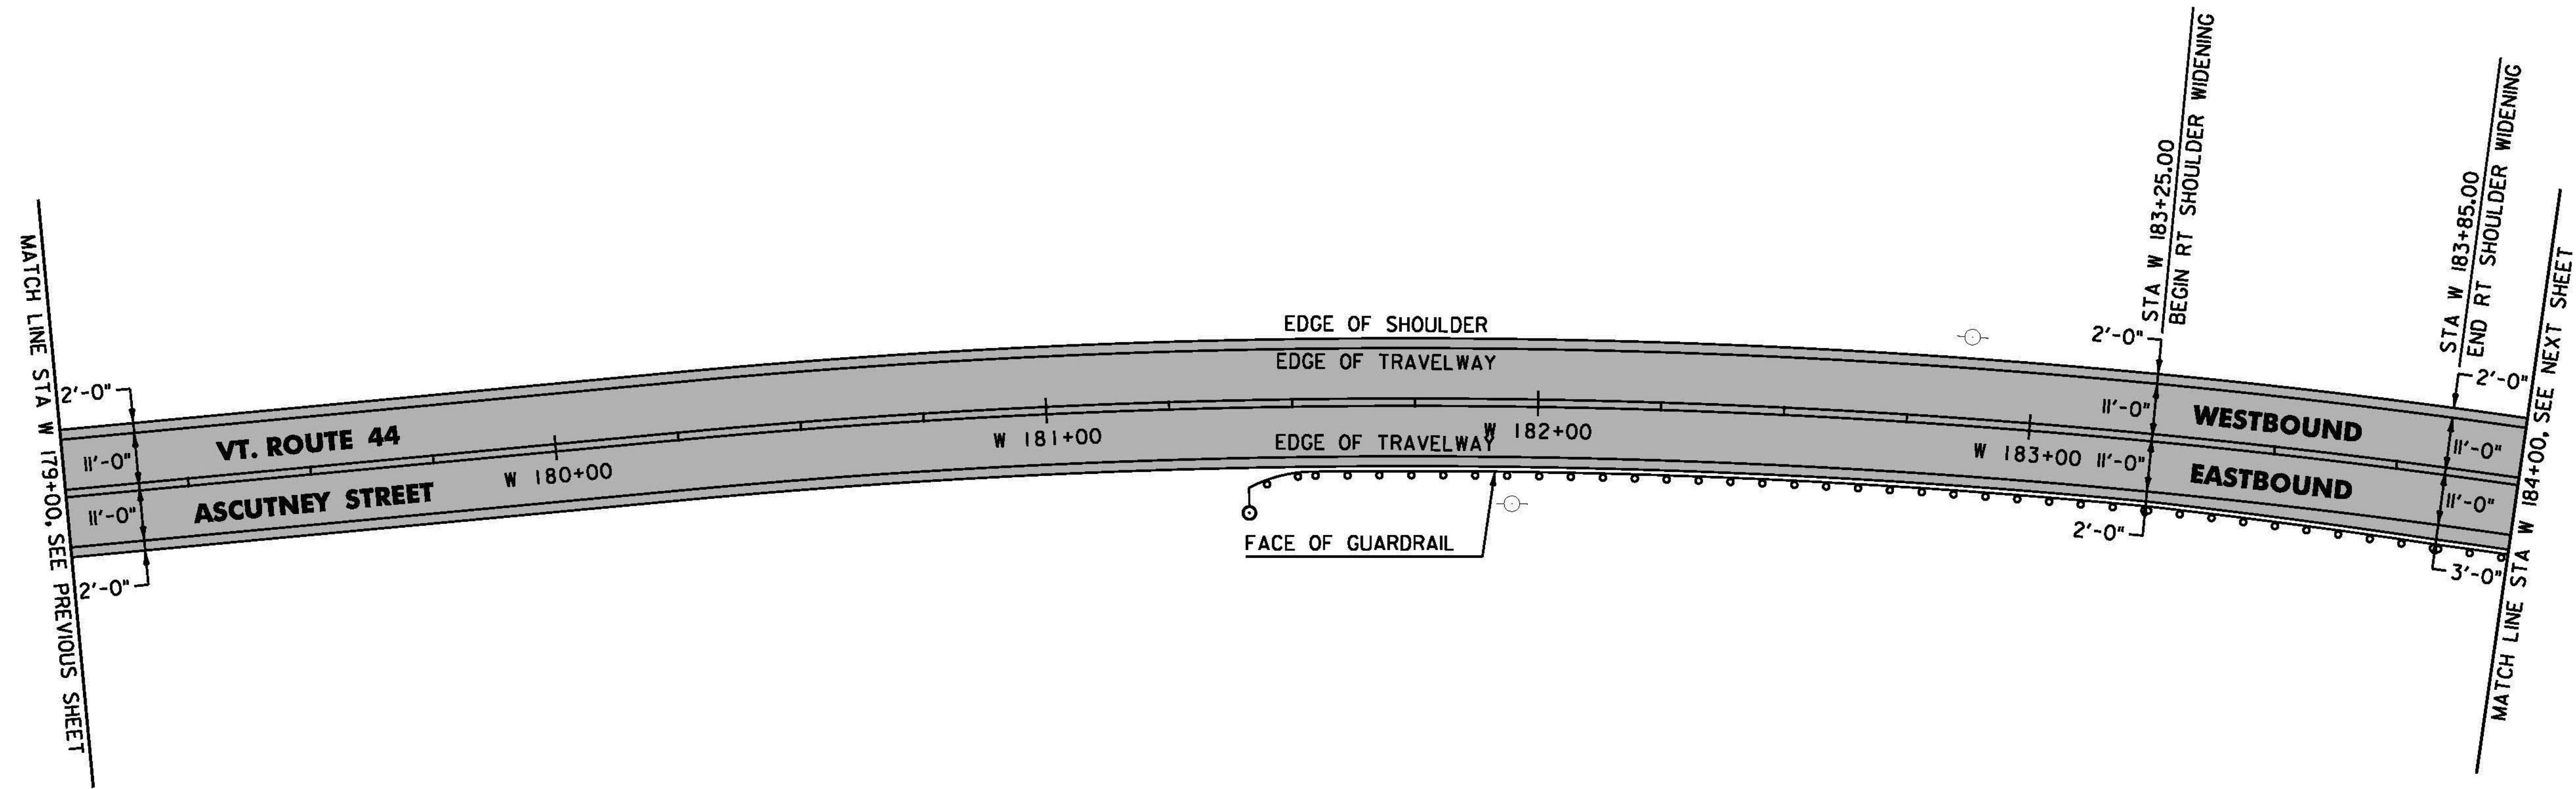


DURABLE 4 INCH WHITE LINE, TYPE A TAPE AND
 TEMPORARY 4 INCH WHITE LINE, PAINT
 (ALL LINES WILL INCLUDE EDGE LINE BREAKS AND RADIUS FOR
 TOWN HIGHWAYS)
 WINDSOR:
 STA W 179+00.00 - STA W 184+00.00 EDGE LINE LT & RT

DURABLE 4 INCH YELLOW LINE, TYPE A TAPE AND
 TEMPORARY 4 INCH YELLOW LINE, PAINT
 (ALL LINES WILL INCLUDE C/L LINE BREAKS FOR TOWN HIGHWAYS)
 S = SOLID, D = DASHED
 WINDSOR:
 STA W 179+00.00 - STA W 184+00.00 LT & RT
 S S

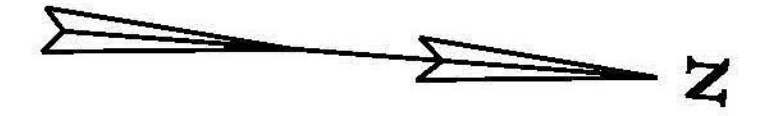

STEEL BEAM GUARDRAIL, GALVANIZED W/8 FEET POSTS
 WINDSOR:
 STA W 181+41.0 - STA W 184+00.0 RT

REMOVAL AND DISPOSAL OF GUARDRAIL
 WINDSOR:
 STA W 181+46.0 - STA W 184+00.0 RT

ANCHOR FOR STEEL BEAM RAIL
 WINDSOR:
 STA W 181+47.5 RT

DELINEATOR WITH STEEL POST
 WINDSOR:
 STA W 181+41.0 RT

LEGEND

 OVERLAY AREA

NOT TO SCALE

**WINDSOR
 PROJECT
 LAYOUT
 SHEET #29**

PROJECT NAME: CHESTER-SPRINGFIELD-ROCKINGHAM-WINDSOR
 PROJECT NUMBER: STP 29520)

FILE NAME: z13c518bdr_seg04.dgn
 PROJECT LEADER: D. GOZALKOWSKI
 DESIGNED BY: A. HAWKINS

PLOT DATE: 3/27/2015
 DRAWN BY: A. KIRBY
 CHECKED BY: J. SHIELDS
 SHEET 265 OF 309