
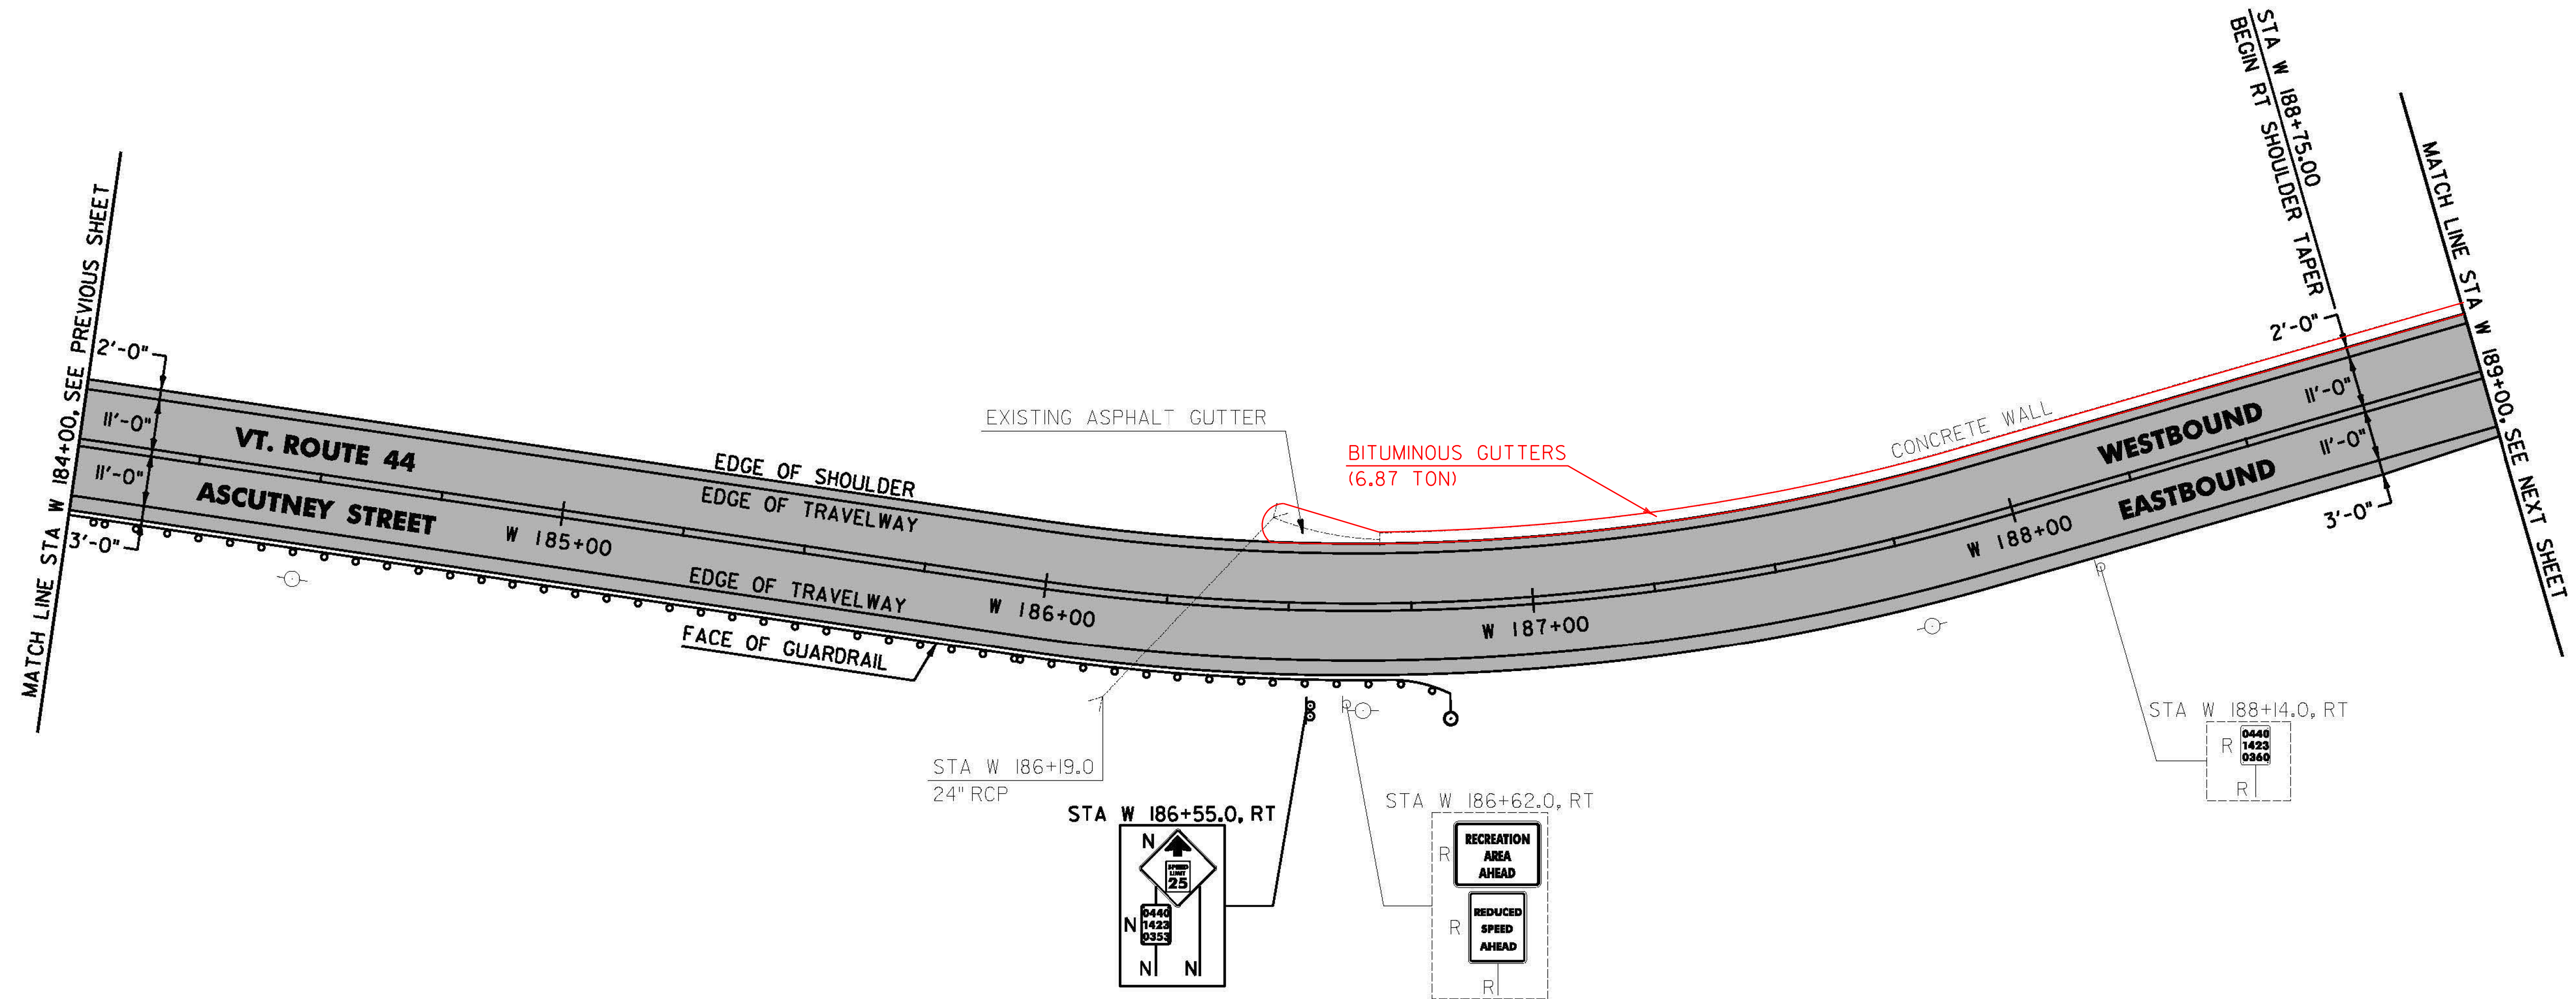


DURABLE 4 INCH WHITE LINE, TYPE A TAPE AND
 TEMPORARY 4 INCH WHITE LINE, PAINT
 (ALL LINES WILL INCLUDE EDGE LINE BREAKS AND RADIUS FOR
 TOWN HIGHWAYS)
 WINDSOR:
 STA W 184+00.00 - STA W 189+00.00 EDGE LINE LT & RT

DURABLE 4 INCH YELLOW LINE, TYPE A TAPE AND
 TEMPORARY 4 INCH YELLOW LINE, PAINT
 (ALL LINES WILL INCLUDE C/L LINE BREAKS FOR TOWN HIGHWAYS)
 S = SOLID, D = DASHED
 WINDSOR:
 STA W 184+00.00 - STA W 189+00.00 LT C RT
 S S S

REMOVING SIGNS
 AS SHOWN - 3

STONE FILL, TYPE I
 STA W 185+40.0 - W 186+00.0 RT (79.38 CY)

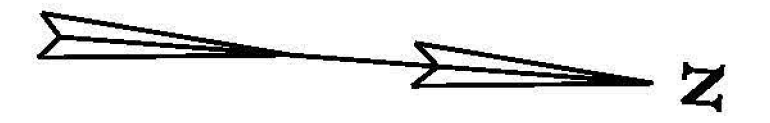

STEEL BEAM GUARDRAIL, GALVANIZED W/8 FEET POSTS
 WINDSOR:
 STA W 184+00.0 - STA W 186+82.5 RT
 REMOVAL AND DISPOSAL OF GUARDRAIL
 WINDSOR:
 STA W 184+00.0 - STA W 186+78.0 RT

ANCHOR FOR STEEL BEAM RAIL
 WINDSOR:
 STA W 186+76.0 RT
 DELINEATOR WITH STEEL POST
 WINDSOR:
 STA W 186+82.5 RT

LEGEND
 OVERLAY AREA

SIGN LEGEND
 R = REMOVE
 S = SALVAGE
 N = NEW
 RET = RETAIN
 B-B = BACK TO BACK
 EXISTING =
 NEW =
 R = RETURN TO TOWN
 ⊕ OF WINDSOR

NOT TO SCALE

**WINDSOR
 PROJECT
 LAYOUT
 SHEET #30**

PROJECT NAME: CHESTER-SPRINGFIELD-ROCKINGHAM-WINDSOR
 PROJECT NUMBER: STP 2952(1)
 FILE NAME: z13c518bdr_seg04.dgn
 PROJECT LEADER: D. GOZALKOWSKI
 DESIGNED BY: A. HAWKINS
 PLOT DATE: 3/27/2015
 DRAWN BY: A. KIRBY
 CHECKED BY: J. SHIELDS
 SHEET 266 OF 309