

DURABLE 4 INCH WHITE LINE, TYPE A TAPE AND TEMPORARY 4 INCH WHITE LINE, PAINT
 (ALL LINES WILL INCLUDE EDGE LINE BREAKS AND RADIUS FOR TOWN HIGHWAYS)
 WINDSOR:
 STA W 214+00.00 - STA W 219+00.00 EDGE LINE LT & RT
 STA W 216+48.00 EDGE LINES RT, TH-59

DURABLE 4 INCH YELLOW LINE, TYPE A TAPE AND TEMPORARY 4 INCH YELLOW LINE, PAINT
 (ALL LINES WILL INCLUDE C/L LINE BREAKS FOR TOWN HIGHWAYS)
 S = SOLID, D = DASHED
 WINDSOR:
 STA W 214+00.00 - STA W 219+00.00
 STA W 216+48.00 DOUBLE SOLID RT, TH-59



DURABLE 8 INCH WHITE LINE, TYPE A TAPE
 WINDSOR:
 STA W 216+56.0 - STA W 216+68.0 RT, FIRE HYDRANT, NO PARKING

DURABLE 24 INCH STOP BAR, TYPE A TAPE AND TEMPORARY 24 INCH STOP BAR, PAINT
 WINDSOR:
 STA W 216+48.00 RT, TH-59

DURABLE LETTER OR SYMBOL, TYPE D TAPE
 WINDSOR:
 STA W 216+48.00 RT, TH-59 "S,T,O,P" (4 EA)

TEMPORARY LETTER OR SYMBOL, PAINT
 WINDSOR:
 STA W 216+48.00 RT, TH-59 "S,T,O,P" (8 EA)

REMOVING SIGNS AS SHOWN - 5

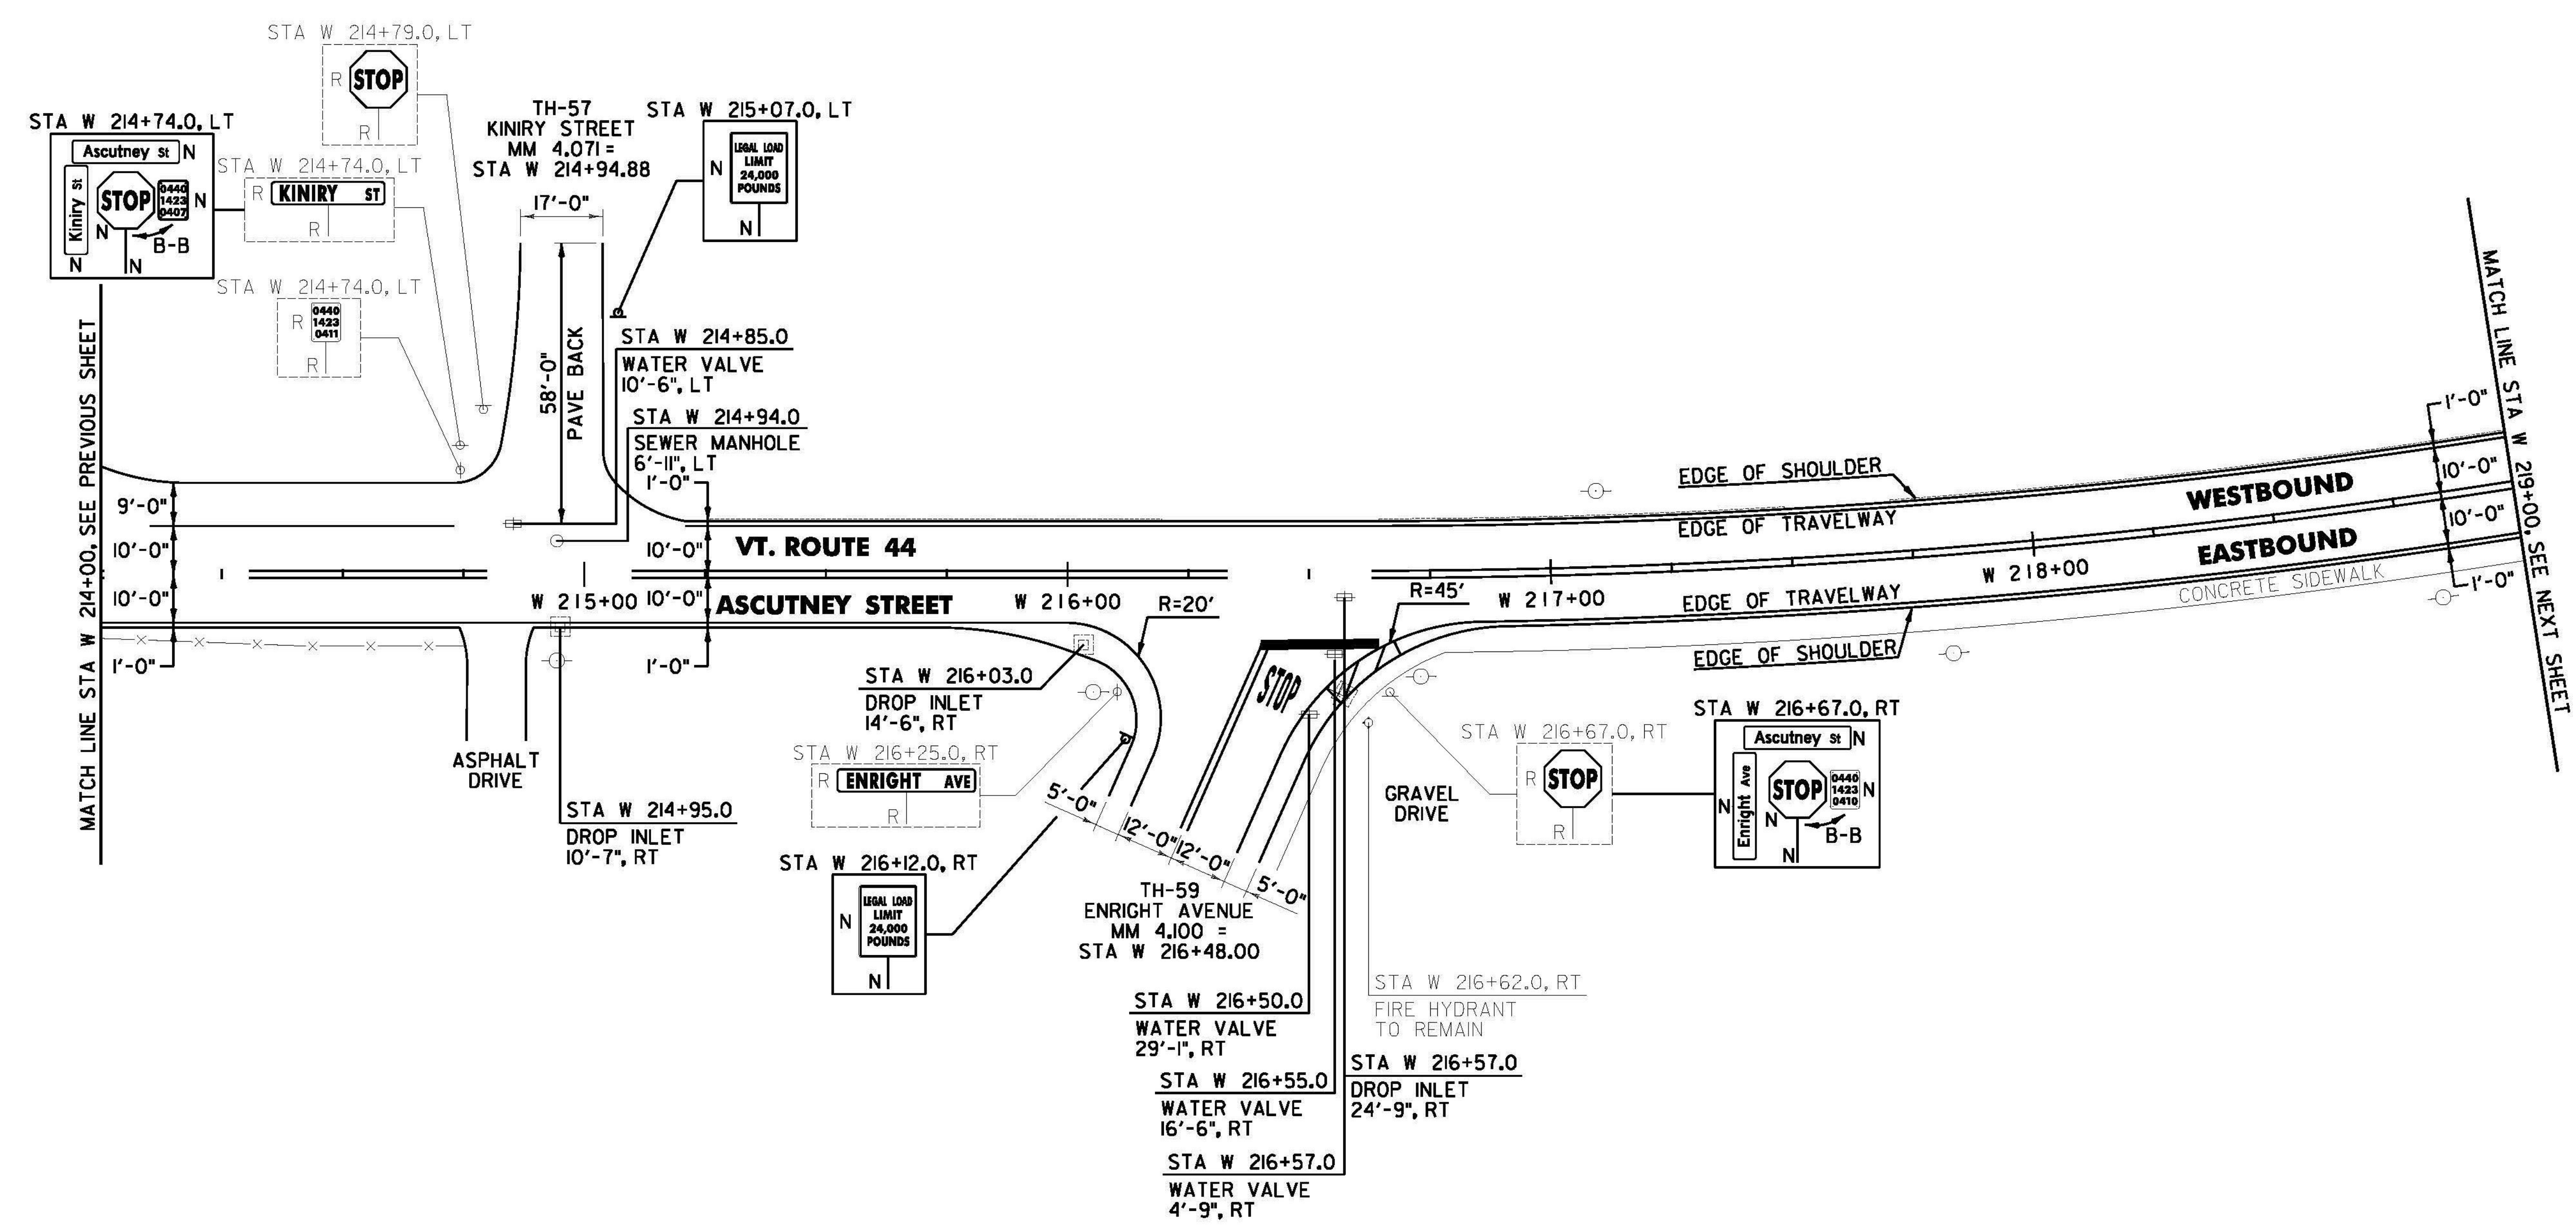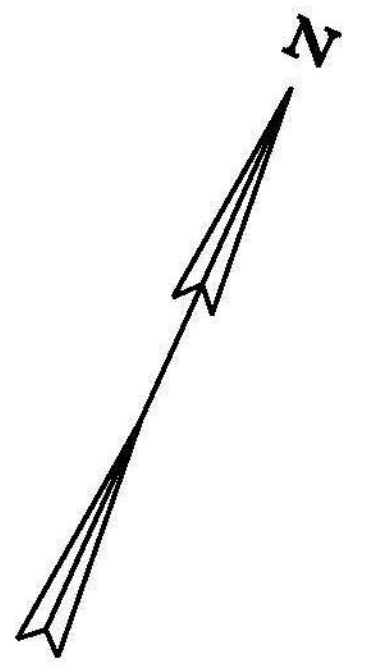

REHAB. DROP INLETS, CATCH BASINS, OR MANHOLES, CLASS I, II, OR III
 WINDSOR:
 STA W 214+95.0 RT
 STA W 216+03.0 RT
 STA W 216+57.0 RT

CHANGING ELEVATION OF SEWER MANHOLES
 WINDSOR:
 STA W 214+94.0 LT

ADJUST ELEVATION OF VALVE BOX
 WINDSOR:
 STA W 214+85.0 LT
 STA W 216+50.0 RT
 STA W 216+55.0 RT
 STA W 216+57.0 RT

SIGN LEGEND
 R = REMOVE
 S = SALVAGE
 N = NEW
 RET = RETAIN
 B-B = BACK TO BACK
 EXISTING = _____
 NEW = _____
 R = RETURN TO TOWN OF WINDSOR

NOTE:

1. SEE SHEET 16 FOR FIRE HYDRANT PAVEMENT MARKING DETAIL.

NOT TO SCALE
WINDSOR PROJECT LAYOUT SHEET #36

PROJECT NAME: CHESTER-SPRINGFIELD-ROCKINGHAM-WINDSOR	PLOT DATE: 3/27/2015
PROJECT NUMBER: STP 2952(1)	DRAWN BY: A. KIRBY
FILE NAME: z13c518bdr_seg04.dgn	CHECKED BY: J. SHIELDS
PROJECT LEADER: D. GOZALKOWSKI	SHEET 272 OF 309
DESIGNED BY: A. HAWKINS	