

DURABLE 4 INCH WHITE LINE, TYPE A TAPE AND TEMPORARY 4 INCH WHITE LINE, PAINT
 (ALL LINES WILL INCLUDE EDGE LINE BREAKS AND RADIUS FOR TOWN HIGHWAYS)
 WINDSOR:
 STA W 234+00.00 - STA W 239+00.00 EDGE LINE LT & RT
 STA W 234+69.60 EDGE LINES LT, TH-5
 STA W 237+07.20 EDGE LINES LT, TH-27

DURABLE 4 INCH YELLOW LINE, TYPE A TAPE AND TEMPORARY 4 INCH YELLOW LINE, PAINT
 (ALL LINES WILL INCLUDE C/L LINE BREAKS FOR TOWN HIGHWAYS)
 S = SOLID, D = DASHED
 WINDSOR:
 STA W 234+00.00 - STA W 239+00.00 LT & RT
 STA W 234+69.60 DOUBLE SOLID LT, TH-5
 STA W 237+07.20 DOUBLE SOLID LT, TH-27

DURABLE 24 INCH STOP BAR, TYPE A TAPE AND TEMPORARY 24 INCH STOP BAR, PAINT
 WINDSOR:
 STA W 234+69.60 LT, TH-5
 STA W 237+07.20 LT, TH-27



DURABLE LETTER OR SYMBOL, TYPE D TAPE
 WINDSOR:
 STA W 234+69.60 LT, TH-5 "S,T,O,P (4 EA)
 STA W 237+07.20 LT, TH-27 "S,T,O,P (4 EA)

TEMPORARY LETTER OR SYMBOL, PAINT
 WINDSOR:
 STA W 234+69.60 LT, TH-5 "S,T,O,P (8 EA)
 STA W 237+07.20 LT, TH-27 "S,T,O,P (8 EA)

REMOVING SIGNS AS SHOWN - 22

DURABLE 8 INCH WHITE LINE, TYPE A TAPE
 WINDSOR:
 STA W 235+64.00 - STA W 235+82.00 HATCHED GORE AREA LT
 STA W 235+64.00 - STA W 236+69.00 RT, NO PARKING

DURABLE CROSSWALK MARKING, TYPE A TAPE AND TEMPORARY CROSSWALK MARKING, PAINT
 WINDSOR:
 STA W 234+22.08 LT, CEMETERY ROAD

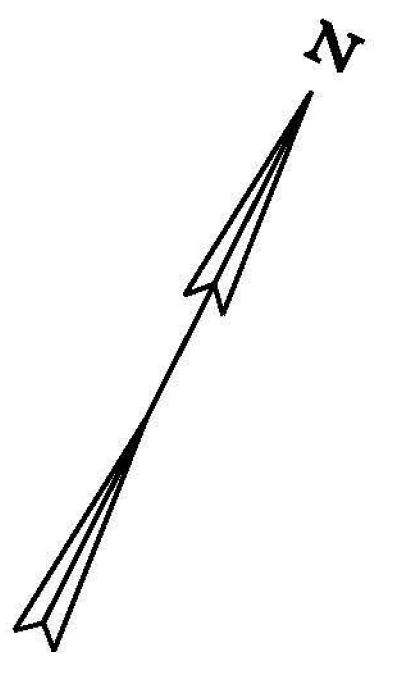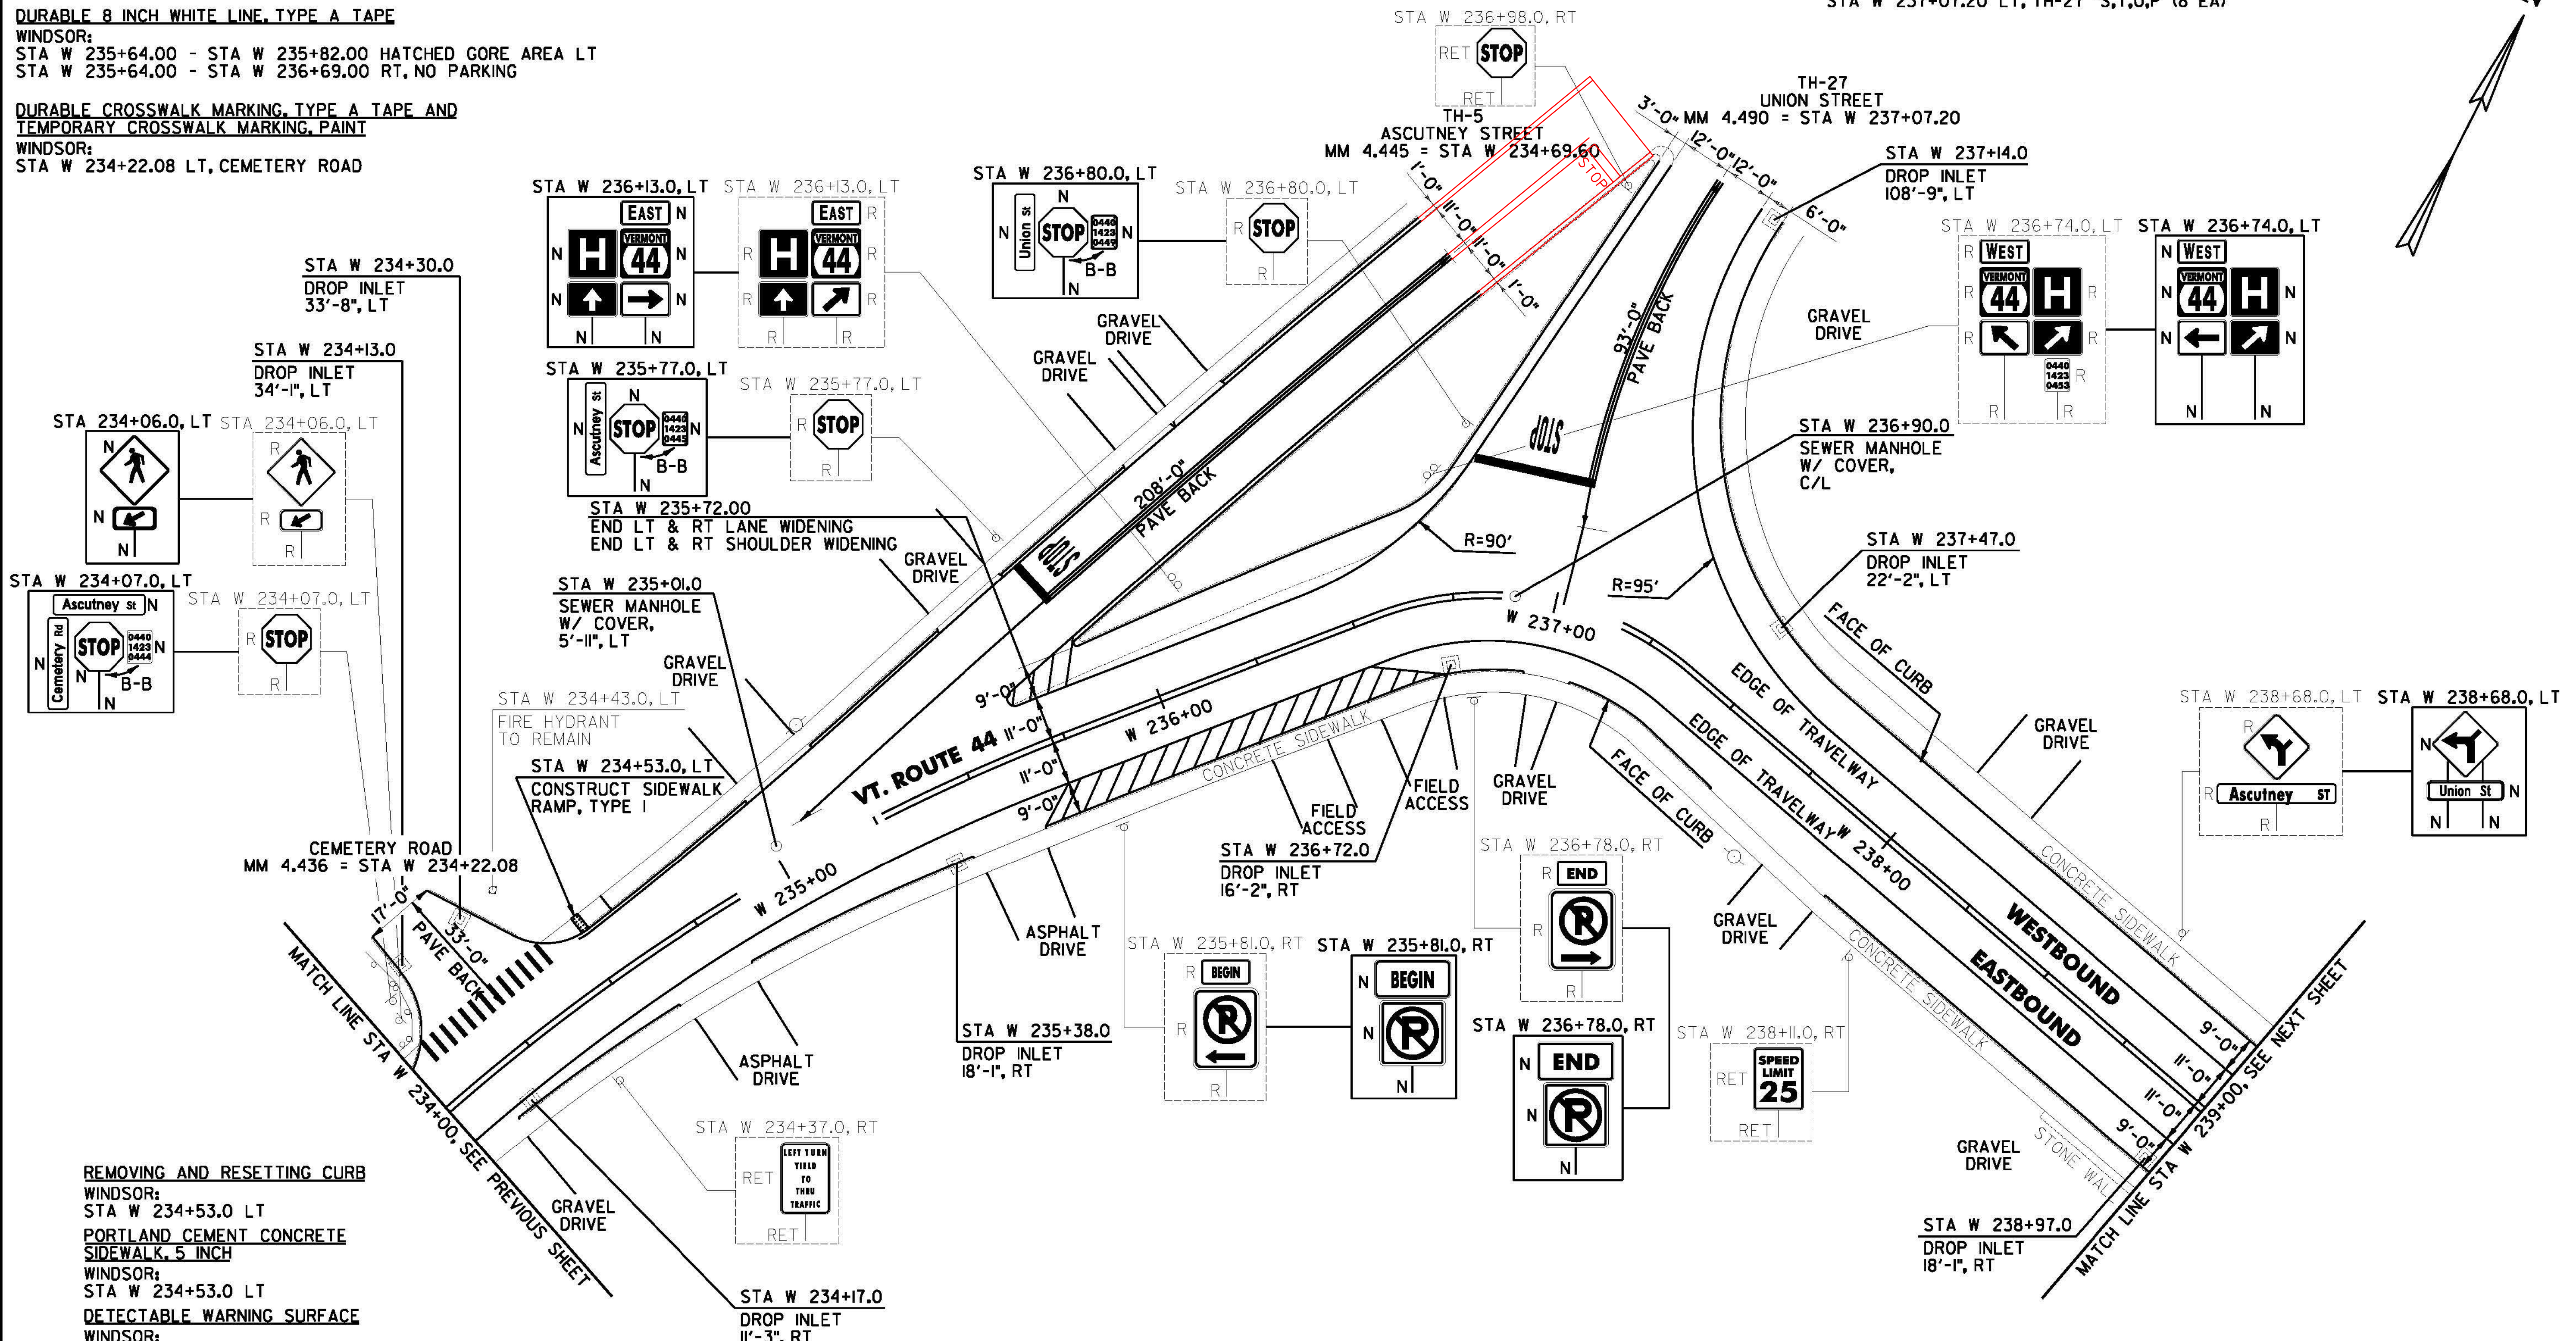

REMOVING AND RESETTING CURB
 WINDSOR:
 STA W 234+53.0 LT
PORTLAND CEMENT CONCRETE SIDEWALK, 5 INCH
 WINDSOR:
 STA W 234+53.0 LT
DETECTABLE WARNING SURFACE
 WINDSOR:
 STA W 234+53.0 LT

REHAB. DROP INLETS, CATCH BASINS, OR MANHOLES, CLASS I, II, OR III
 WINDSOR:
 STA W 234+13.0 LT
 STA W 234+17.0 RT
 STA W 234+30.0 LT
 STA W 235+38.0 RT
 STA W 236+72.0 RT
 STA W 237+14.0 LT
 STA W 237+47.0 LT
 STA W 238+97.0 RT

CHANGING ELEVATION OF SEWER MANHOLES
 WINDSOR:
 STA W 235+01.0 LT
 STA W 236+90.0 C/L

CAST IRON COVER WITH FRAME, SEWER
 WINDSOR:
 STA W 235+01.0 LT
 STA W 236+90.0 C/L

SIGN LEGEND
 R = REMOVE
 S = SALVAGE
 N = NEW
 RET = RETAIN
 B-B = BACK TO BACK
 EXISTING =
 NEW =
 R = RETURN TO TOWN OF WINDSOR

NOT TO SCALE

WINDSOR PROJECT LAYOUT SHEET #40

PROJECT NAME: CHESTER-SPRINGFIELD-ROCKINGHAM-WINDSOR
 PROJECT NUMBER: STP 2952(1)

FILE NAME: z13c518bdr_seg04.dgn
 PROJECT LEADER: D. GOZALKOWSKI
 DESIGNED BY: A. HAWKINS

PLOT DATE: 3/27/2015
 DRAWN BY: A. KIRBY
 CHECKED BY: J. SHIELDS
 SHEET 276 OF 309