



DURABLE 4 INCH WHITE LINE, TYPE A TAPE AND TEMPORARY 4 INCH WHITE LINE, PAINT  
 (ALL LINES WILL INCLUDE EDGE LINE BREAKS AND RADIUS FOR TOWN HIGHWAYS)  
 WINDSOR:  
 STA W 244+00.00 - STA W 249+00.00 EDGE LINE RT  
 STA W 244+00.00 - STA W 246+45.00 EDGE LINE LT  
 STA W 246+36.48 EDGE LINES RT, TH-49  
 STA W 246+53.00 - STA W 249+00.00 EDGE LINE LT

DURABLE 4 INCH YELLOW LINE, TYPE A TAPE AND TEMPORARY 4 INCH YELLOW LINE, PAINT  
 (ALL LINES WILL INCLUDE C/L BREAKS FOR TOWN HIGHWAYS)  
 S=SOLID D=DASHED  
 WINDSOR:  
 STA W 244+00.00 - STA W 249+00.00 LT S C RT  
 STA W 246+36.48 DOUBLE SOLID RT, TH-49 S - S

DURABLE 24 INCH STOP BAR, TYPE A TAPE AND TEMPORARY 24 INCH STOP BAR, PAINT  
 WINDSOR:  
 STA W 246+36.48 RT, TH-49  
 DURABLE LETTER OR SYMBOL, TYPE D TAPE  
 WINDSOR:  
 STA W 246+36.48 RT, TH-49 \*S,T,O,P (4 EA)  
 TEMPORARY LETTER OR SYMBOL, PAINT  
 WINDSOR:  
 STA W 246+36.48 RT, TH-49 \*S,T,O,P (8 EA)

DURABLE CROSSWALK MARKING, TYPE A TAPE AND TEMPORARY CROSSWALK MARKING, PAINT  
 WINDSOR:  
 STA W 246+36.48 RT, TH-49  
 STA W 246+49.00 LT/RT  
 DURABLE 8 INCH WHITE LINE, TYPE A TAPE  
 WINDSOR:  
 STA W 245+30.00 - STA W 246+45.00 LT, NO PARKING  
 STA W 245+55.00 - STA W 245+75.00 RT, NO PARKING  
 STA W 246+53.00 - STA W 246+73.00 LT, NO PARKING  
 STA W 248+98.00 - STA W 249+00.00 LT, NO PARKING

REMOVING SIGNS AS SHOWN - 10

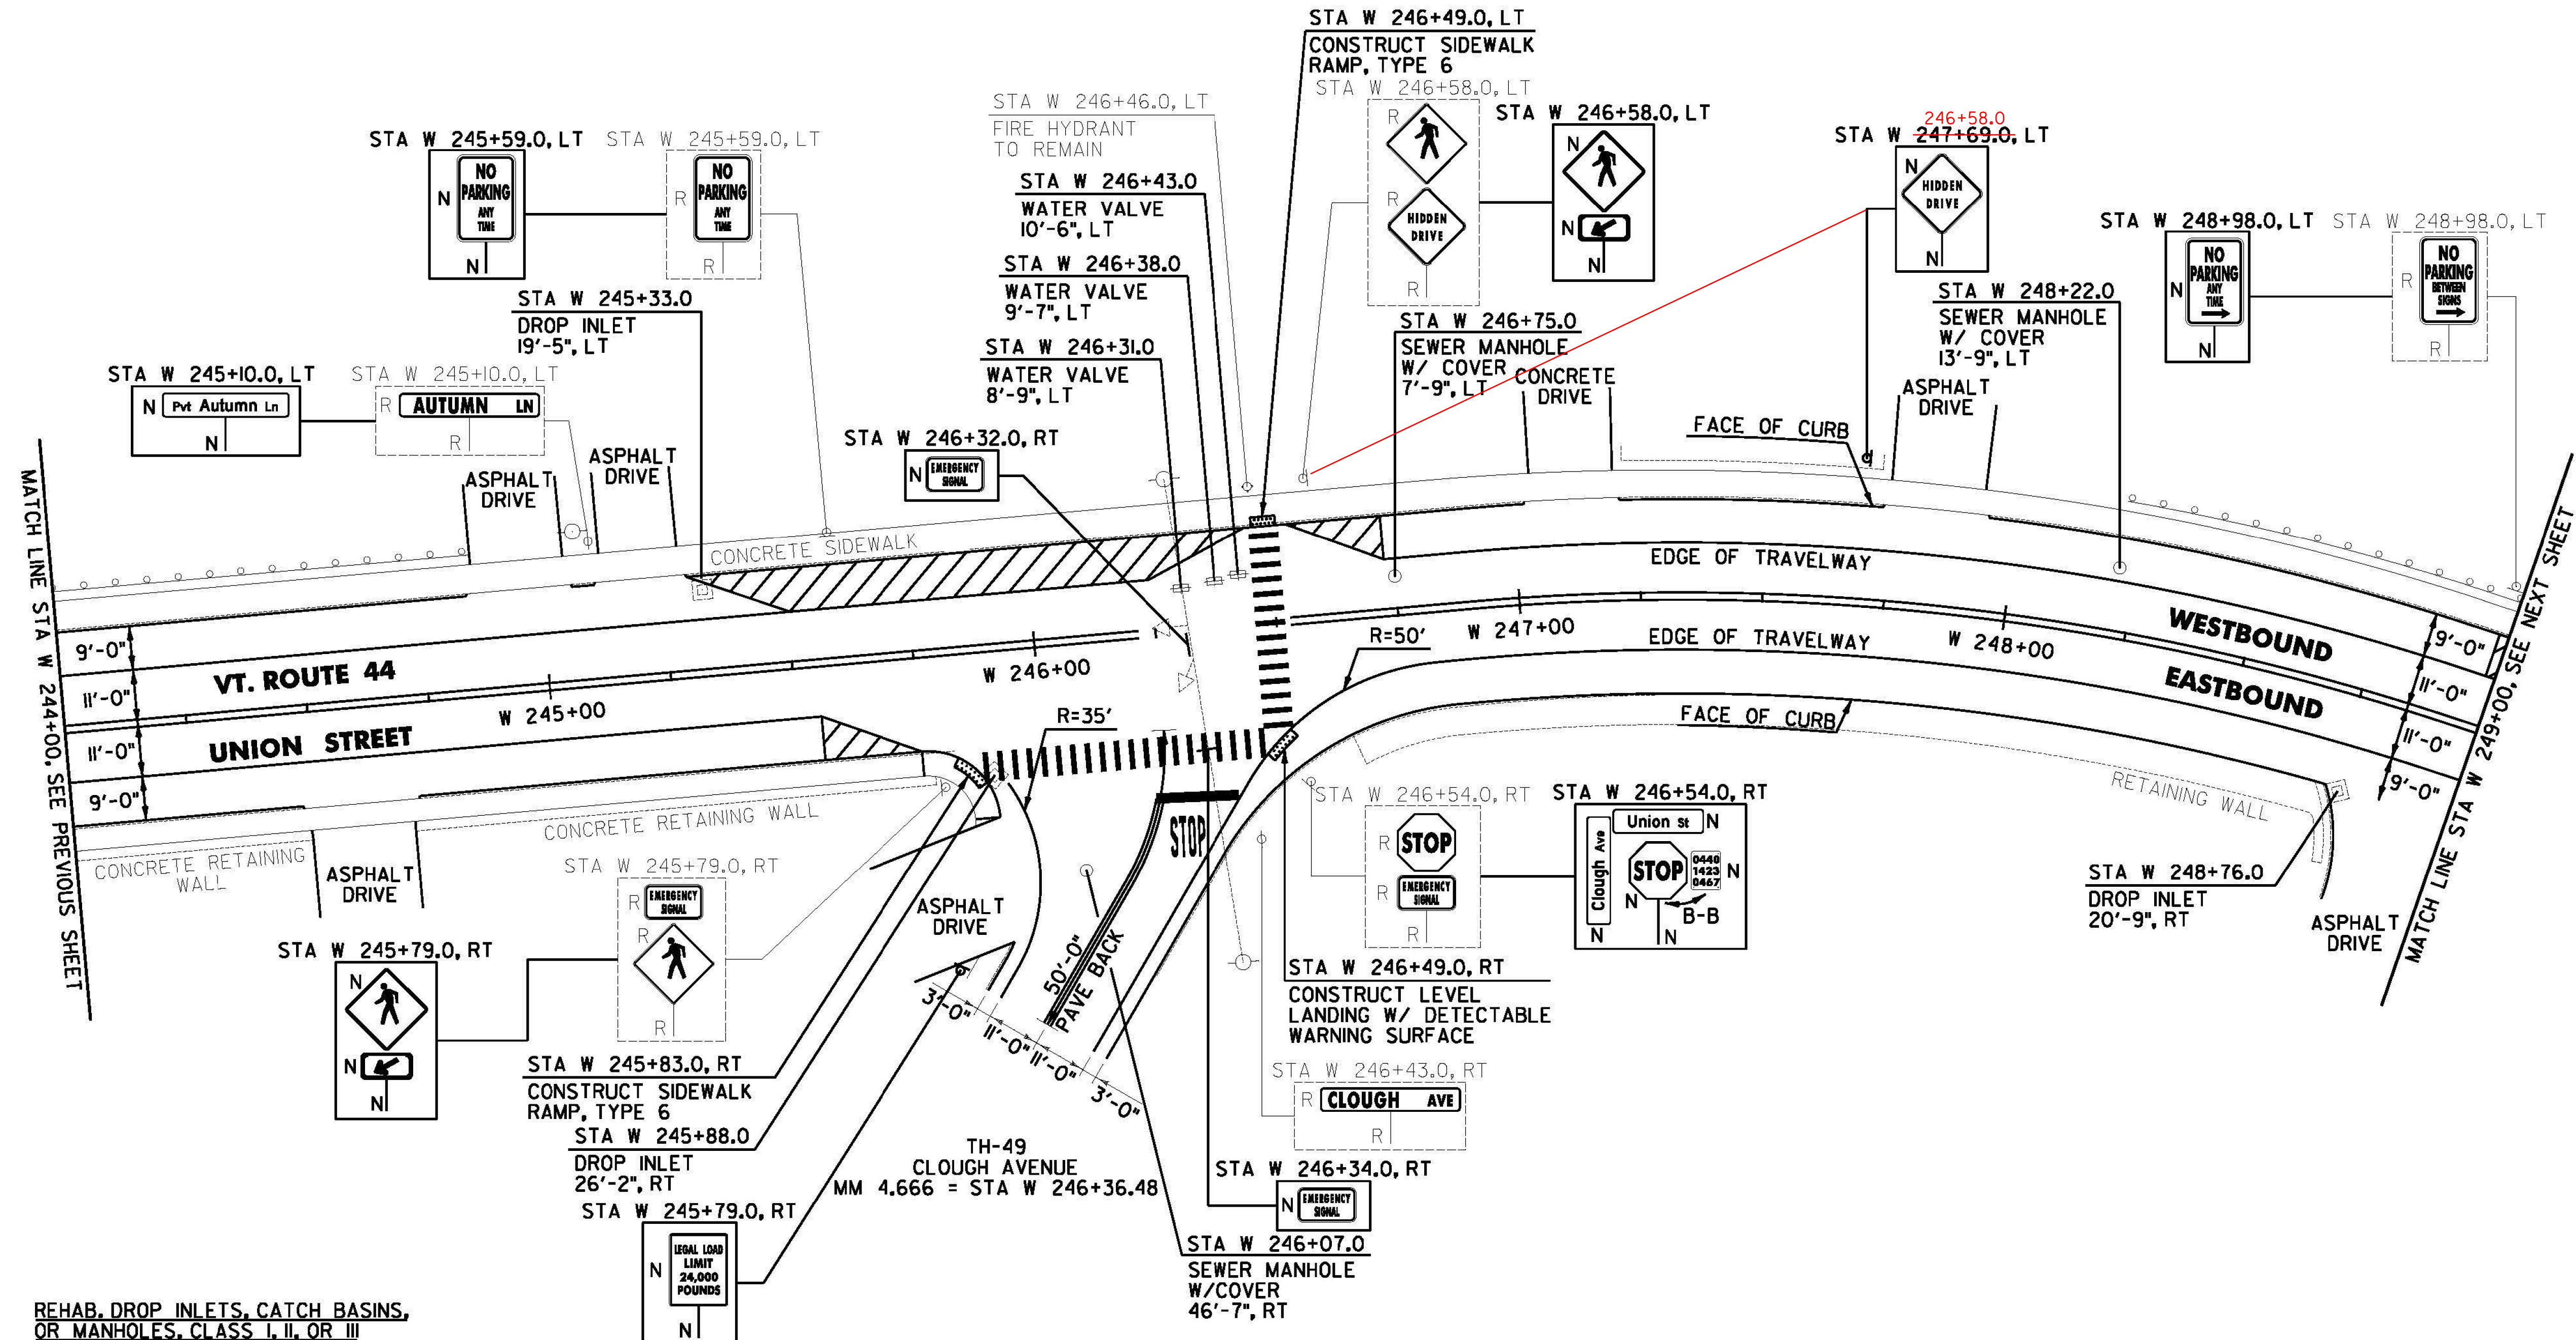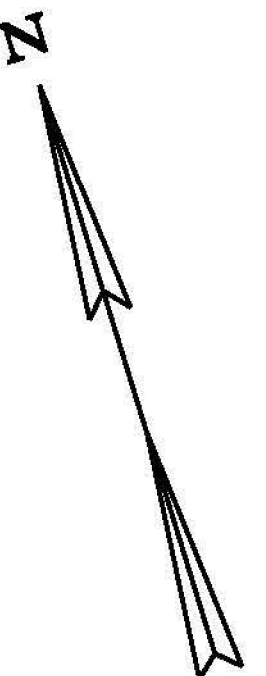

REHAB. DROP INLETS, CATCH BASINS, OR MANHOLES, CLASS I, II, OR III  
 WINDSOR:  
 STA W 245+33.0 LT  
 STA W 245+88.0 RT  
 STA W 248+76.0 RT

CHANGING ELEVATION OF SEWER MANHOLES  
 WINDSOR:  
 STA W 246+07.0 RT  
 STA W 246+75.0 LT  
 STA W 248+22.0 LT

CAST IRON COVER WITH FRAME, SEWER  
 WINDSOR:  
 STA W 246+07.0 RT  
 STA W 246+75.0 LT  
 STA W 248+22.0 LT

REMOVING AND RESETTING CURB  
 WINDSOR:  
 STA W 245+83.0 RT  
 STA W 246+49.0 LT

PORTLAND CEMENT CONCRETE SIDEWALK, 5 INCH  
 WINDSOR:  
 STA W 245+83.0 RT  
 STA W 246+49.0 LT  
 STA W 246+49.0 RT

DETECTABLE WARNING SURFACE  
 WINDSOR:  
 STA W 245+83.0 RT  
 STA W 246+49.0 LT  
 STA W 246+49.0 RT

ADJUST ELEVATION OF VALVE BOX  
 WINDSOR:  
 STA W 246+31.0 LT  
 STA W 246+38.0 LT  
 STA W 246+43.0 LT

SIGN LEGEND  
 R = REMOVE  
 S = SALVAGE  
 N = NEW  
 RET = RETAIN  
 B-B = BACK TO BACK  
 EXISTING = \_\_\_\_\_  
 NEW = \_\_\_\_\_  
 R = RETURN TO TOWN OF WINDSOR

NOT TO SCALE

**WINDSOR PROJECT LAYOUT SHEET #42**

PROJECT NAME: CHESTER-SPRINGFIELD-ROCKINGHAM-WINDSOR  
 PROJECT NUMBER: STP 2952(1)  
 FILE NAME: z13c51bdr\_seg04.dgn  
 PROJECT LEADER: D. GOZALKOWSKI  
 DESIGNED BY: A. HAWKINS  
 PLOT DATE: 3/27/2015  
 DRAWN BY: A. KIRBY  
 CHECKED BY: J. SHIELDS  
 SHEET 278 OF 309