

DURABLE 4 INCH WHITE LINE, TYPE A TAPE AND TEMPORARY 4 INCH WHITE LINE, PAINT
 (ALL LINES WILL INCLUDE EDGE LINE BREAKS AND RADIUS FOR TOWN HIGHWAYS)
 WINDSOR:
 STA W 249+00.00 - STA W 250+14.00 LT, NO PARKING EDGE LINE
 STA W 249+00.00 - STA W 251+36.00 EDGE LINE RT
 STA W 250+37.76 EDGE LINES LT, TH-76
 STA W 250+61.00 - STA W 251+36.00 LT, NO PARKING EDGE LINE
 STA W 251+44.00 - STA W 252+64.00 LT, NO PARKING EDGE LINE
 STA W 251+44.00 - STA W 254+00.00 EDGE LINE RT
 STA W 252+64.00 - STA W 254+00.00 EDGE LINE LT

DURABLE 4 INCH YELLOW LINE, TYPE A TAPE AND TEMPORARY 4 INCH YELLOW LINE, PAINT
 (ALL LINES WILL INCLUDE C/L BREAKS FOR TOWN HIGHWAYS)
 S=SOLID D=DASHED
 WINDSOR:
 STA W 249+00.00 - STA W 254+00.00 LT C RT
 STA W 250+37.76 DOUBLE SOLID LT, TH-76



DURABLE 8 INCH WHITE LINE, TYPE A TAPE
 WINDSOR:
 STA W 249+00.00 - STA W 250+14.00 LT, NO PARKING
 STA W 249+59.00 - STA W 249+71.00 RT, FIRE HYDRANT, NO PARKING
 STA W 250+61.00 - STA W 251+36.00 LT, NO PARKING
 STA W 251+44.00 - STA W 252+64.00 LT, NO PARKING
 STA W 252+83.00 - STA W 252+95.00 RT, FIRE HYDRANT, NO PARKING

DURABLE 24 INCH STOP BAR, TYPE A TAPE AND TEMPORARY 24 INCH STOP BAR, PAINT
 WINDSOR:
 STA W 250+37.76 LT, TH-76

DURABLE LETTER OR SYMBOL, TYPE D TAPE
 WINDSOR:
 STA W 250+37.76 LT, TH-76 "S,T,O,P" (4 EA)
TEMPORARY LETTER OR SYMBOL, PAINT
 WINDSOR:
 STA W 250+37.76 LT, TH-76 "S,T,O,P" (8 EA)

DURABLE CROSSWALK MARKING, TYPE A TAPE AND TEMPORARY CROSSWALK MARKING, PAINT
 WINDSOR:
 STA W 250+37.76 LT, TH-76
 STA W 251+40.00 LT/RT

REMOVING SIGNS AS SHOWN - 7

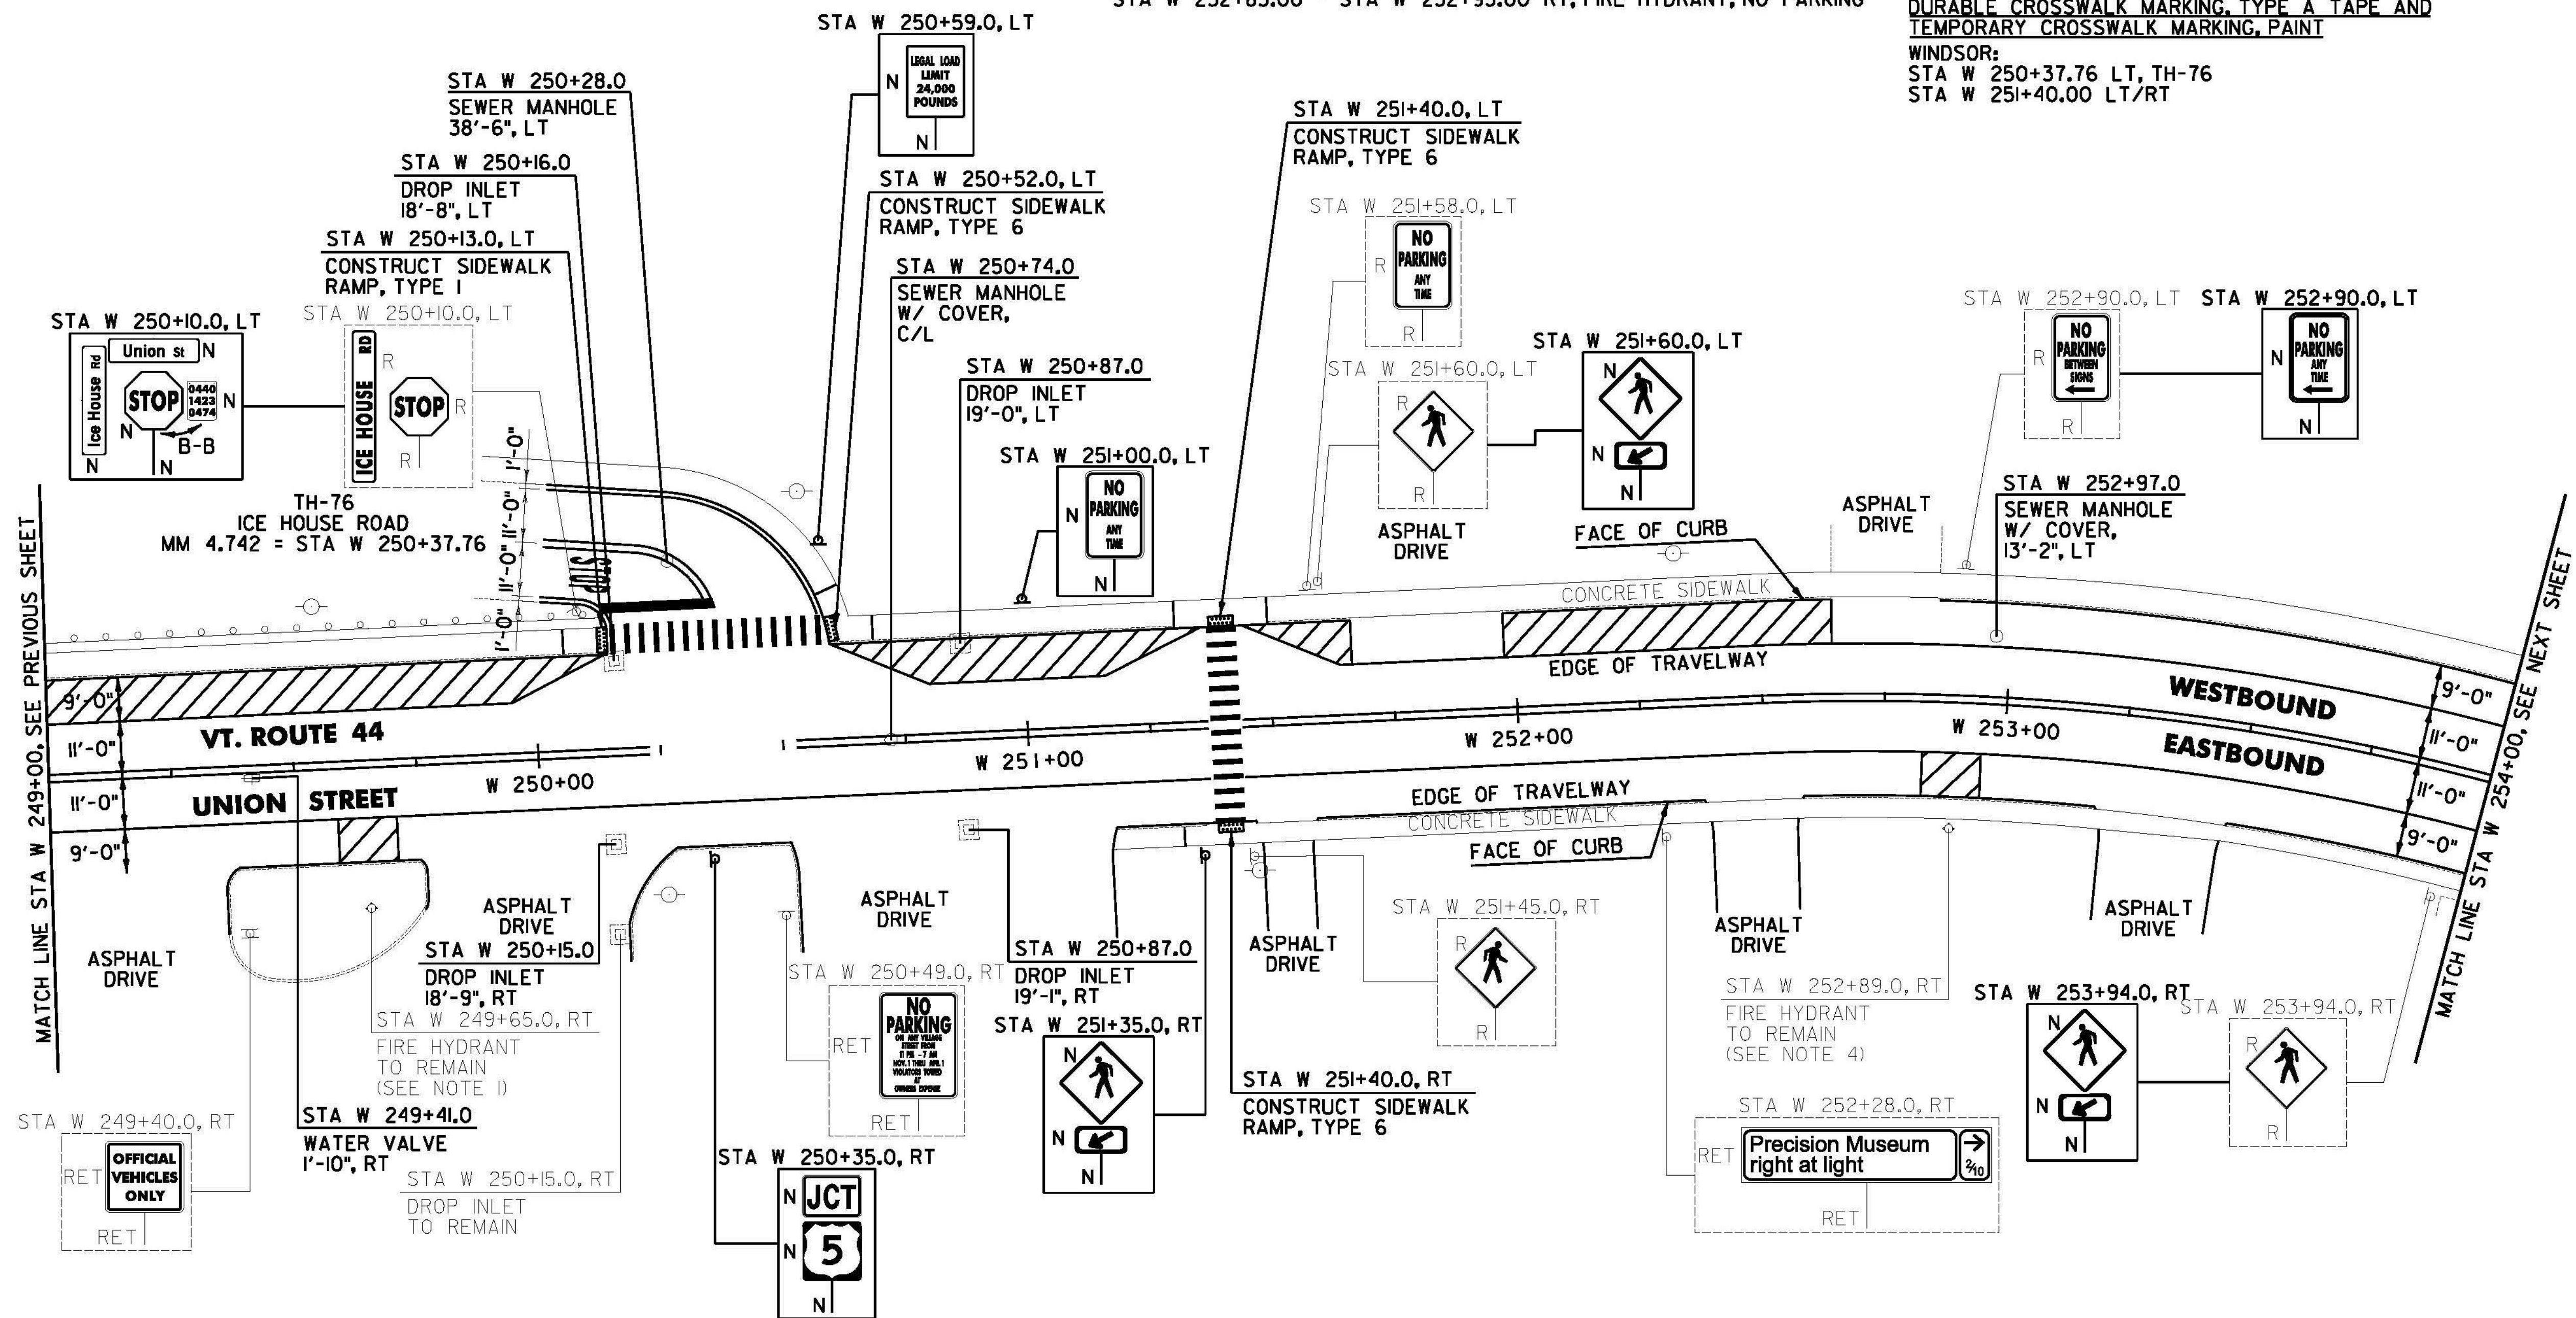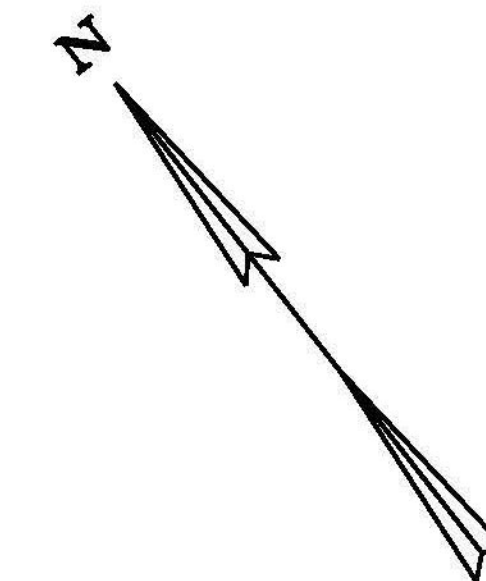

REHAB. DROP INLETS, CATCH BASINS, OR MANHOLES, CLASS I, II, OR III
 WINDSOR:
 STA W 250+15.0 RT
 STA W 250+16.0 LT
 STA W 250+87.0 LT
 STA W 250+87.0 RT

CHANGING ELEVATION OF SEWER MANHOLES
 WINDSOR:
 STA W 250+28.0 LT
 STA W 250+74.0 C/L
 STA W 252+97.0 LT

PORTLAND CEMENT CONCRETE SIDEWALK, 5 INCH
 WINDSOR:
 STA W 250+13.0 LT
 STA W 250+52.0 LT
 STA W 251+40.0 RT
 STA W 251+40.0 LT

DETECTABLE WARNING SURFACE
 WINDSOR:
 STA W 250+13.0 LT
 STA W 250+52.0 LT
 STA W 251+40.0 RT
 STA W 251+40.0 LT

CAST IRON COVER WITH FRAME, SEWER
 WINDSOR:
 STA W 250+74.0 C/L
 STA W 252+97.0 LT

ADJUST ELEVATION OF VALVE BOX
 WINDSOR:
 STA W 249+41.0 RT

REMOVING AND RESETTING CURB
 WINDSOR:
 STA W 250+13.0 LT
 STA W 250+52.0 LT
 STA W 251+40.0 RT
 STA W 251+40.0 LT

SIGN LEGEND
 R = REMOVE
 S = SALVAGE
 N = NEW
 RET = RETAIN
 B-B = BACK TO BACK
 EXISTING = _____
 NEW = _____
 R = RETURN TO TOWN OF WINDSOR

NOTE:
 I. SEE SHEET 16 FOR FIRE HYDRANT PAVEMENT MARKING DETAIL.

NOT TO SCALE
WINDSOR PROJECT LAYOUT SHEET #43

PROJECT NAME: CHESTER-SPRINGFIELD-ROCKINGHAM-WINDSOR	PLOT DATE: 3/27/2015
PROJECT NUMBER: STP 29520	DRAWN BY: A. KIRBY
FILE NAME: z13c518bdr_seg04.dgn	DESIGNED BY: A. HAWKINS
PROJECT LEADER: D. GOZALKOWSKI	CHECKED BY: J. SHIELDS
SHEET 279 OF 309	