


STATE OF VERMONT AGENCY OF TRANSPORTATION

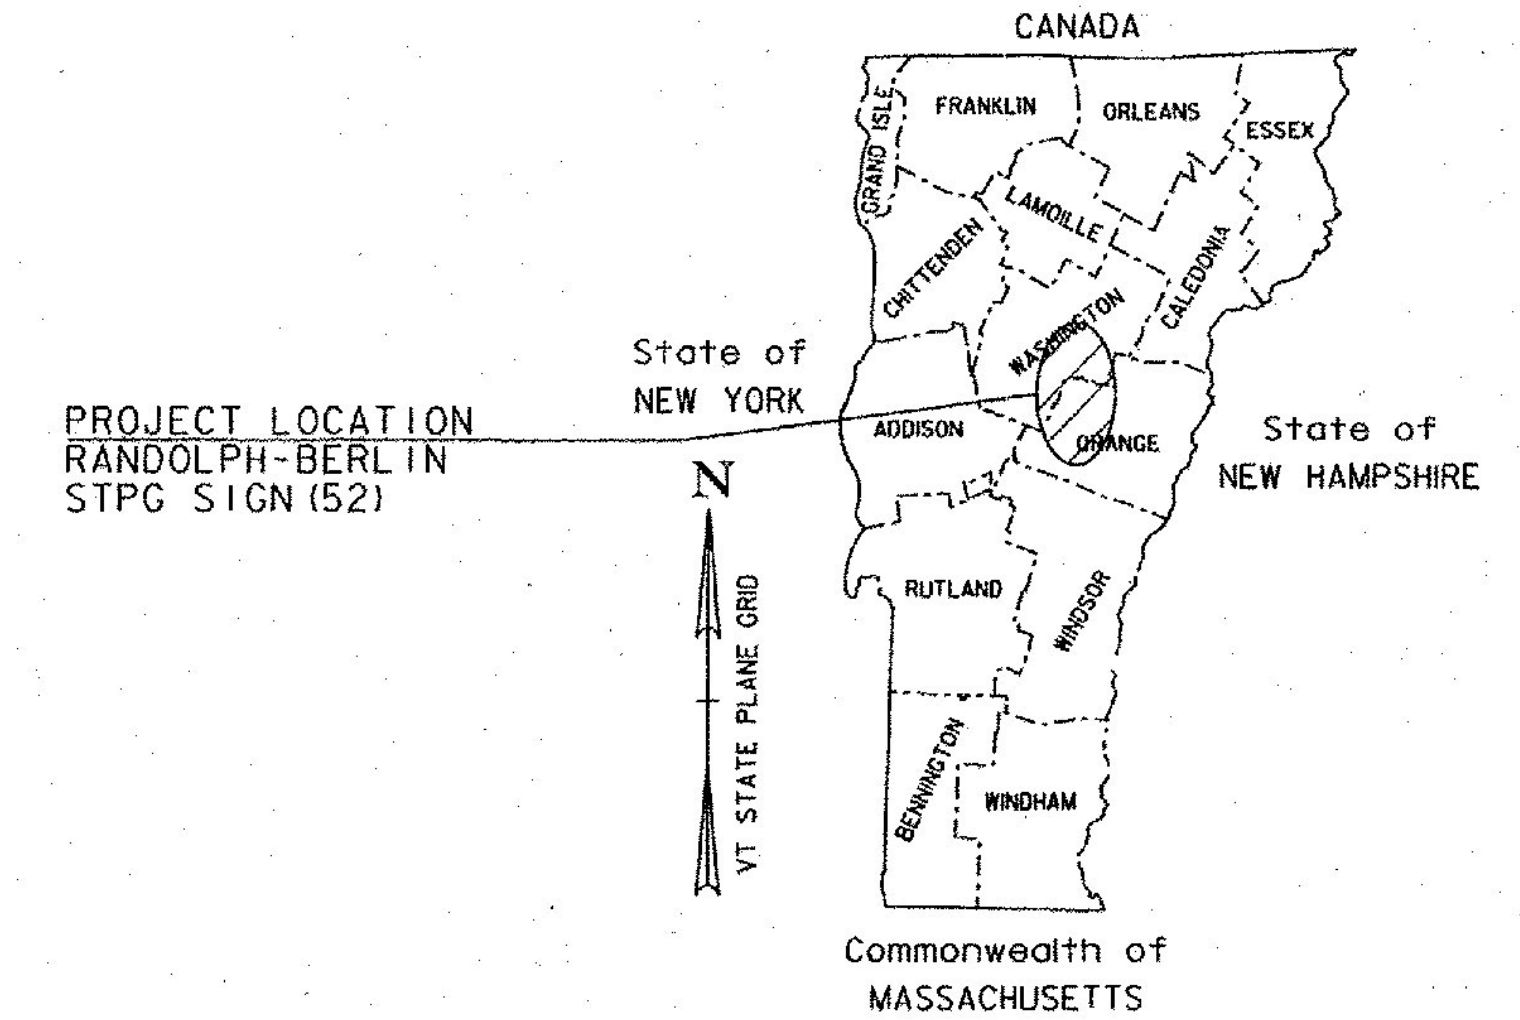



RECORD PLANS	
CONTRACTOR:	L&D SAFETY MARKINGS CORP. BERLIN, VT
RESIDENT ENGINEER:	PAUL PERRY
CONSTRUCTION BEGAN:	OCTOBER 22, 2015
CONSTRUCTION COMPLETE:	MARCH 11, 2016
RECORD PLANS BY:	PAUL PERRY & KEVIN KING
I HEREBY CERTIFY THAT ALL THE CONSTRUCTION REQUIRED BY THIS SET OF DRAWINGS HAS BEEN ACCOMPLISHED AS INDICATED HEREIN.	
BY <i>Paul V. Perry</i>	RESIDENT ENGINEER
DATE <i>2/14/17</i>	
NOTE: Any further information concerning final quantities, amounts or other details relative to this project may be found at Central Files in the electronic archives.	

PROPOSED IMPROVEMENT TOWNS OF RANDOLPH, BRAINTREE, BROOKFIELD, ROXBURY, NORTHFIELD, AND BERLIN COUNTIES OF ORANGE AND WASHINGTON VT ROUTE 12 (MAJOR COLLECTOR)

BEGINNING IN THE TOWN OF RANDOLPH AT THE NORTHERN STATE HIGHWAY LIMITS AT MILE MARKER 3.070 AND EXTENDING NORTHERLY ALONG VT ROUTE 12 FOR 15.313 MILES THROUGH THE TOWNS OF RANDOLPH, BRAINTREE, BROOKFIELD, ROXBURY, AND NORTHFIELD TO A STOPPING POINT AT THE SOUTHERN STATE HIGHWAY LIMITS OF NORTHFIELD AT MILE MARKER 3.060; RESUMING IN THE TOWN OF NORTHFIELD AT THE NORTHERN STATE HIGHWAY LIMITS AT MILE MARKER 4.850 AND EXTENDING NORTHERLY 8.102 MILES THROUGH THE TOWNS OF NORTHFIELD AND BERLIN AND ENDING AT THE BERLIN-MONTPELIER TOWN LINE.

LENGTH OF PROJECT = 23.415 MILES (SEE SUMMARY BELOW)

WORK TO BE PERFORMED UNDER THIS PROJECT INCLUDES THE REMOVAL OF EXISTING SIGNS AND POSTS AND THE INSTALLATION OF NEW SIGNS AND SIGN POSTS AND OTHER HIGHWAY RELATED ITEMS.

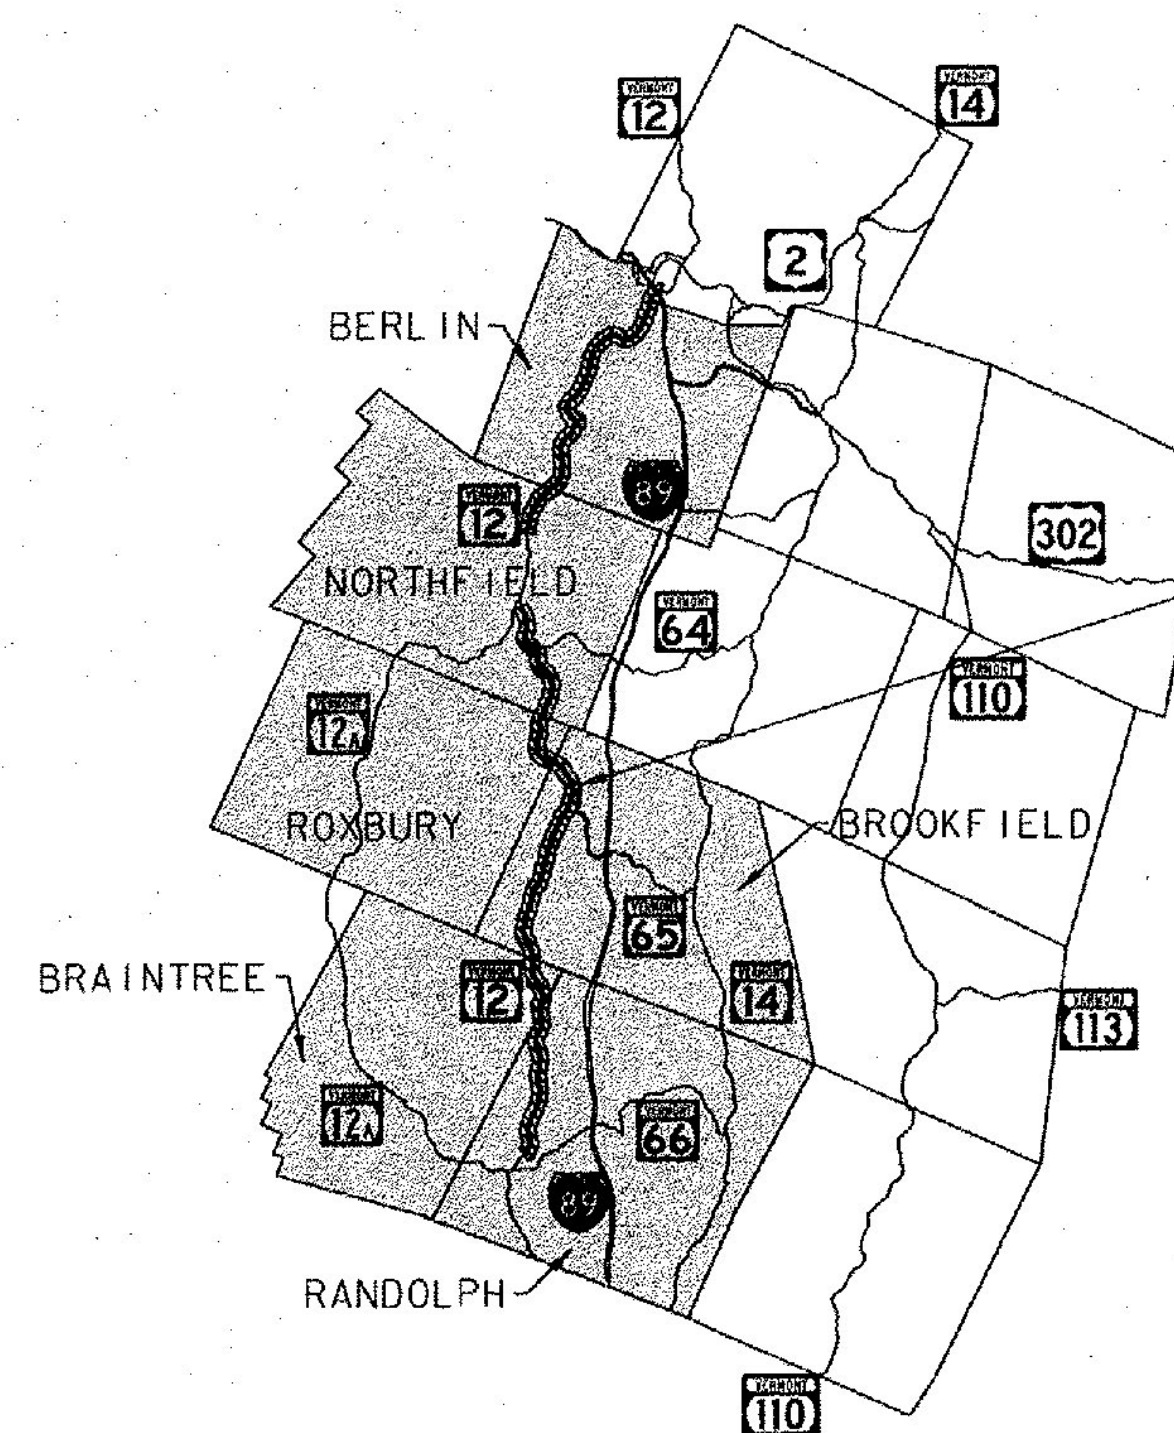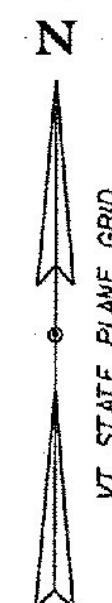


VT ROUTE 12 PROJECT LOCATIONS:

RANDOLPH MM 3.070 - 6.758	= 3.688 MILES
BRAINTREE MM 0.000 - 1.556	= 1.556 MILES
BROOKFIELD MM 0.000 - 5.525	= 5.525 MILES
ROXBURY MM 0.000 - 1.484	= 1.484 MILES
NORTHFIELD MM 0.000 - 3.060	= 3.060 MILES
NORTHFIELD MM 4.850 - 6.262	= 1.412 MILES
BERLIN MM 0.000 - 6.690	= 6.690 MILES
TOTAL = 23.415 MILES	

CONSTRUCTION IS TO BE CARRIED ON IN ACCORDANCE WITH THESE PLANS AND THE STANDARD SPECIFICATIONS FOR CONSTRUCTION DATED 2011, AS APPROVED BY THE FEDERAL HIGHWAY ADMINISTRATION ON JULY 20, 2011 FOR USE ON THIS PROJECT, INCLUDING ALL SUBSEQUENT REVISIONS AND SUCH REVISED SPECIFICATIONS AND SPECIAL PROVISIONS AS ARE INCORPORATED IN THESE PLANS.

QUALITY ASSURANCE PROGRAM : LEVEL 3
SURVEYED BY : N/A
SURVEYED DATE : N/A
DATUM
VERTICAL : N/A
HORIZONTAL : N/A

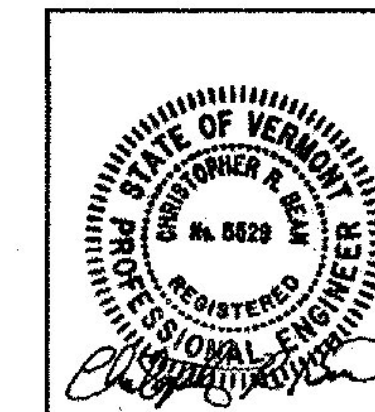

540 Commercial Street
Manchester, NH 03101
(603) 668-8223
www.cldengineers.com

DIRECTOR OF PROJECT DELIVERY
APPROVED <i>[Signature]</i> DATE <i>5/20/2015</i>
PROJECT MANAGER : PATTI COBURN, P.E.
PROJECT NAME : RANDOLPH-BERLIN
PROJECT NUMBER : STPG SIGN (52)
SHEET 1 OF 105 SHEETS

NOT TO SCALE