




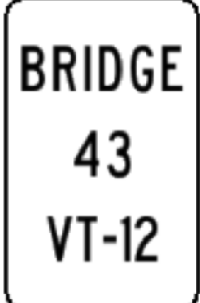

DIRECTION	MILEPOINT	LOCATION CODE (SHEET 3)	SIGN CODE	WIDTH (IN)	HEIGHT (IN)	SHEETING REMARKS	SIGN LEGEND	NEW SIGNS		EXISTING SIGNS				EXIST POST		NUMBER OF NEW POSTS	SQUARE STEEL (IN)			TUBULAR STEEL Ø (IN)				SIGN FRAME REQUIRED	REMARKS	SIGN DETAIL LOCATION			
								"A"	"B"	RETAIN	SALVAGE FROM	SALVAGE TO	REMOVE	RETAIN	REMOVE		1.75	2.00	2.50	FOUNDATION	3.00	3.50	4.00			5.00	SHSM	PROJECT SHEET #	STANDARD SHEET #
																	(LB / FT)				(LB / FT)								
NB RANDOLPH VT 12							FY-FLUORESCENT YELLOW FYG-FLUORESCENT YELLOW GREEN																"SHSM"-STANDARD HIGHWAY SIGNS AND MARKINGS BOOK						
NB	3.055	A	VR-039	24	18		STATE HIGHWAY BEGINS			1															THINNING & TRIMMING				
		A	R2-1	24	30		SPEED LIMIT 40			1																			
NB	3.056	A	VD-701	6	8		BRIDGE 44 VT 12					1													REMOVE INACURATE SIGN				
NB	3.070	A	VD-701	6	10			0.42						4'	4'-10"													T-42	
NB	3.124	A	VW-054R	30	30		HIDDEN DRIVE RIGHT					1																	
NB	3.148	A	VW-054R	30	30			6.25						4'	10'-0"											THINNING & TRIMMING			E-154
NB	3.260	A	VW1-1M	30	30		MODIFIED LEFT TURN					1																	
		A	W13-1P	18	18		30 M.P.H. (PLAQUE)					1																	
NB	3.290	A	W1-1MdL	36	36			9.00						8'	10'-8" 10'-5"										INSTALL ASSEMBLY 160 FT ± NORTH OF EXISTING SIGN AT MP 3.260			7	
		A	W13-1P	18	18			2.25																	INSTALL ON LEFT POST		X		
NB	3.353	AB	D-3	30	6		WINDOVER RD					1													WINDOVER RD (TH-6)				
		AB	D3-1	51	12			4.25						8'	8'-11" 8'-9"										INSTALL INDEPENDENTLY ON TWO POSTS ON THE LEGAL LOAD SIDE OF THE INTERSECTION			10	
SIGN SUMMARY SHEET							SHEET TOTALS	22.17	0.00	2	0	0	5	0	0	6	77'-7" 85.0	0	0.0	0.0	0.0	0.0			PROJECT NAME: RANDOLPH-BERLIN				
VERMONT AGENCY OF TRANSPORTATION							TOWN DIRECTIONAL TOTALS	177.4	0.0	2	0	0	36	0	0	31	425.0	2							PROJECT NUMBER: STPG SIGN(52)				
																								FILE NAME: z13c626tsrandolph NB					
																								PLOT DATE: 5/12/2015					
																								PROJECT MANAGER: C. BEAN					
																								DRAWN BY: S. GOODWIN					
																								DESIGNED BY: S. GOODWIN					
																								CHECKED BY: D. MUNRO					
																									RANDOLPH VT-12 NORTHBOUND 1				
																									SHEET 12 OF 105				