


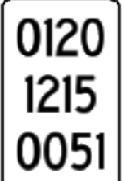
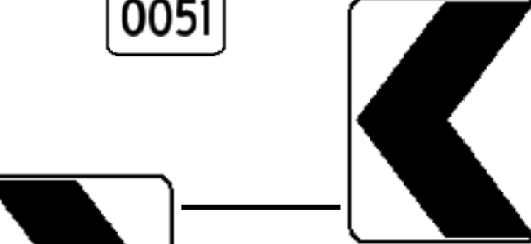

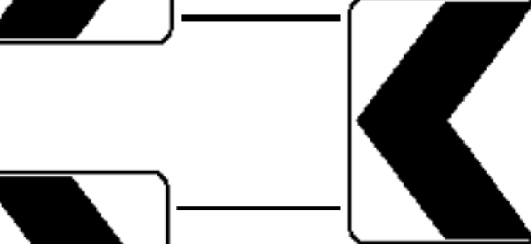





DIRECTION	MILEPOINT	LOCATION CODE (SHEET 3)	SIGN CODE	WIDTH (IN)	HEIGHT (IN)	SHEETING REMARKS	SIGN LEGEND	NEW SIGNS		EXISTING SIGNS				EXIST POST		NUMBER OF NEW POSTS	SQUARE STEEL (IN)			TUBULAR STEEL Ø (IN)				SIGN FRAME REQUIRED	REMARKS	SIGN DETAIL LOCATION			
								"A"	"B"	RETAIN	SALVAGE FROM	SALVAGE TO	REMOVE	RETAIN	REMOVE		1.75	2.00	2.50	FOUNDATION	3.00	3.50	4.00			5.00	SHSM	PROJECT SHEET #	STANDARD SHEET #
																	(LB / FT)				(LB / FT)								
<b>SB ROXBURY VT 12</b>							FY-FLUORESCENT YELLOW FYG-FLUORESCENT YELLOW GREEN																"SHSM"-STANDARD HIGHWAY SIGNS AND MARKINGS BOOK						
SB	0.509	G	VR-017	24	30																								
		G	VR-017	24	30																					E-141			
SB	0.503	H	R1-1	30	30		STOP																						
		G	VD-700	6	8		MILE MARKER 0120 / 1215 / 0051																						
		EF	D3-1	36	12		  																			10			
		H	R1-1	30	30																			X					
		G	VD-700	6	10																					T-44			
SB	0.500	F	W1-8L	18	24																								
SB	0.500	E	W1-8R	18	24																								
SB	0.478	F	W1-8L	18	24																								
SB	0.478	E	W1-8R	18	24																								
SB	0.462	F	W1-6L	48	24		LARGE ARROW LEFT																						
SB	0.455	F	W1-8L	18	24																								
SB	0.455	E	W1-8R	18	24																								
<b>SIGN SUMMARY SHEET</b>							SHEET TOTALS				32.67	0.00	0	0	0	4	0	0	8	105'-5" 120.0	0	0.0	0.0	0.0	0.0	PROJECT NAME: <b>RANDOLPH-BERLIN</b> PROJECT NUMBER: <b>STPG SIGN(52)</b>			
VERMONT AGENCY OF TRANSPORTATION							TOWN DIRECTIONAL TOTALS				124.0	0.0	1	0	0	18	0	0	26	390.0	0	0.0				FILE NAME: <b>z13c626tsroxburv SB</b> PLOT DATE: <b>5/12/2015</b> PROJECT MANAGER: <b>C. BEAN</b> DRAWN BY: <b>S. GOODWIN</b> DESIGNED BY: <b>S. GOODWIN</b> CHECKED BY: <b>D. MUNRO</b> ROXBURY VT-12 SOUTHBOUND 2 SHEET <b>50</b> OF <b>105</b>			