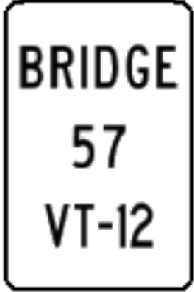
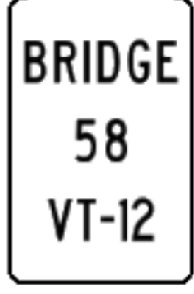

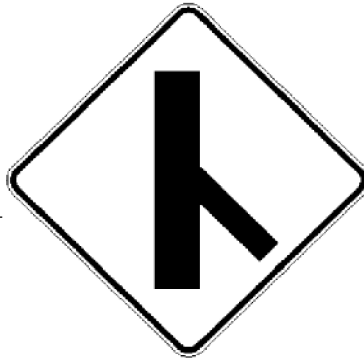





DIRECTION	MILEPOINT	LOCATION CODE (SHEET 3)	SIGN CODE	WIDTH (IN)	HEIGHT (IN)	SHEETING REMARKS	SIGN LEGEND	NEW SIGNS		EXISTING SIGNS				EXIST POST		NUMBER OF NEW POSTS	SQUARE STEEL (IN)			TUBULAR STEEL Ø (IN)				SIGN FRAME REQUIRED	REMARKS	SIGN DETAIL LOCATION			
								"A"	"B"	RETAIN	SALVAGE FROM	SALVAGE TO	REMOVE	RETAIN	REMOVE		1.75	2.00	2.50	FOUNDATION	3.00	3.50	4.00			5.00	SHSM	PROJECT SHEET #	STANDARD SHEET #
																	(LB / FT)				(LB / FT)								
NB NORTHFIELD VT 12							FY-FLUORESCENT YELLOW FYG-FLUORESCENT YELLOW GREEN																"SHSM"-STANDARD HIGHWAY SIGNS AND MARKINGS BOOK						
NB	1.445	A	VD-701	6	8																								
		A	VD-701	6	10			0.42																				T-42	
NB	1.469	A	VD-701	6	8																								
		A	VD-701	6	10			0.42																				T-42	
NB	1.557	A	R2-1	24	30																								
		A	R2-1	24	30			5.00																				X	
NB	1.617	A	W1-10	30	30		MODIFIED RIGHT CURVE																						
		A	W16-8P	24	18		OLD MILL HILL																						
		C	VD-700	6	10		MILE MARKER 0120 / 1213 / 0161																						
		A	W2-3MR	30	30			6.25																				7	
		A	W16-8P	30	8			1.67																				7	
NB	1.703	C	R2-1	18	24		SPEED LIMIT 30																					OLD MILL HILL (TH-110)	
		C	VR-017	24	30			5.00																				INSTALL NEW SIGNS AT SAME LOCATION AS SL30 ON OLD MILL HILL	
		C	R2-1	24	30			5.00																				X	
SIGN SUMMARY SHEET							SHEET TOTALS				23.76	0.00	0	0	0	7	0	0	5	63'-0" 65.0	0	0.0	0.0	0.0	0.0	PROJECT NAME: RANDOLPH-BERLIN PROJECT NUMBER: STPG SIGN(52)			
VERMONT AGENCY OF TRANSPORTATION							TOWN DIRECTIONAL TOTALS				439.4	0.0	27	0	0	95	0	0	79	1160.0	0	0.0				FILE NAME: z13c626tssnorthfield NB PLOT DATE: 5/12/2015 PROJECT MANAGER: C. BEAN DRAWN BY: S. GOODWIN DESIGNED BY: S. GOODWIN CHECKED: D. MUNRO NORTHFIELD VT-12 NORTHBOUND 4 SHEET 56 OF 105			